

# APPLICATION

A 16203

P \_\_\_\_\_

SEWAGE DISPOSAL TESTING

MARYLAND STATE DEPARTMENT OF HEALTH

HOWARD COUNTY

ELLICOTT CITY

DISTRICT 5

DATE 8/4/71

TO: THE COUNTY HEALTH OFFICER  
ELLICOTT CITY, MARYLAND

I, HEREBY, APPLY FOR THE NECESSARY TESTS IN ORDER TO CONSTRUCT (OR RECONSTRUCT) A SEWAGE DISPOSAL SYSTEM.

PROPERTY OWNER Cabin Hill Corporation

ADDRESS John R. Devereux, III, Box 151, Sharp Rd., PHONE \_\_\_\_\_  
Glenwood, Md.

PROPERTY LOCATION:

SUBDIVISION Cabin Hill LOT NO. 12, Blk. B

ROAD AND DESCRIPTION Street 2

OCCUPANT \_\_\_\_\_ PHONE \_\_\_\_\_

PERSON TO CONSTRUCT SYSTEM \_\_\_\_\_

ADDRESS \_\_\_\_\_ PHONE \_\_\_\_\_

SIZE OF LOT 41,400 sq. ft. TYPE BLDG. 3 or 4  
NUMBER OF BEDROOMS

IF NOT SINGLE RESIDENCE DESCRIBE \_\_\_\_\_

SIGNATURE OF APPLICANT /s/ John R. Devereux, III

APPROVED BY \_\_\_\_\_ FOR \_\_\_\_\_ (KIND OF SYSTEM) DATE \_\_\_\_\_


REJECTED BY \_\_\_\_\_ FOR \_\_\_\_\_ (KIND OF SYSTEM) DATE \_\_\_\_\_

HOLD PENDING FURTHER TESTS \_\_\_\_\_ DATE \_\_\_\_\_

REASONS FOR REJECTION OR HOLDING \_\_\_\_\_

## THIS IS NOT A PERMIT

# APPLICATION

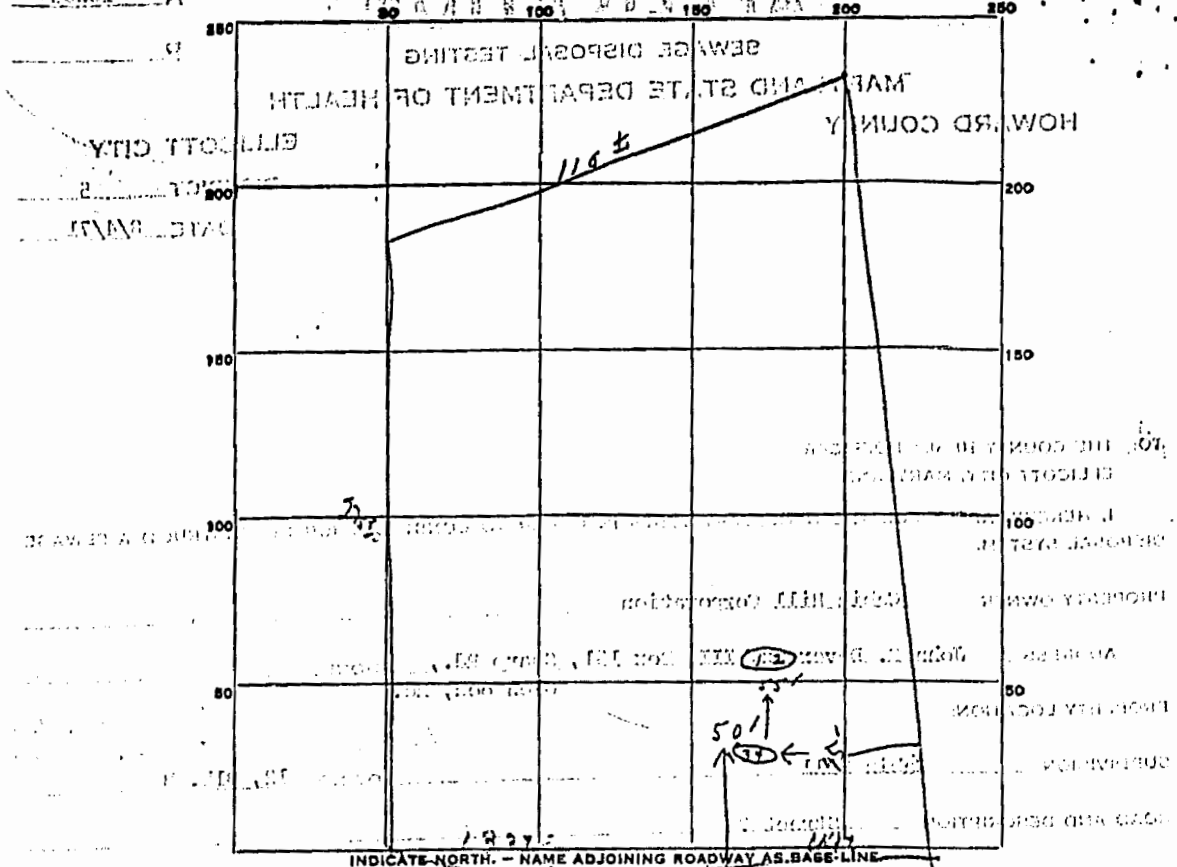

INDICATE NORTH - NAME ADJOINING ROADWAY AS BASE LINE

DATE	TEST NO.	DEPTH	PRE-WET		TEST - 1" DROP		TIME	
			START	STOP	START	STOP		
8/5/71	1	4'	10 50	10 58	10 58	11 09	11 min	
8/5/71	2	11'	10 50	10 52	10 52	10 54	2 min	
8/5/71	3	4'	10 54	10 59	10 57	11 02	5 min	
8/5/71	4	11'	10 52	10 57	10 57	11 00	3 min	

*avg. 6 min.  
under 3 1/2 ft.*

SOIL AUGER FINDING \_\_\_\_\_

TESTED BY B.S.

REMARKS \_\_\_\_\_

