

11/10/72

PERMIT

P 17569

A 16203

SEWAGE DISPOSAL SYSTEM

MARYLAND STATE DEPARTMENT OF HEALTH

HOWARD COUNTY

ELLICOTT CITY

DISTRICT 5th

DATE 10/18/72

INDEXED

Jack Fyock

IS PERMITTED TO INSTALL ALTER

ADDRESS Ten Oaks Road, Glenolr, Maryland

PHONE 286-2939

A SEWAGE DISPOSAL SYSTEM LOCATED AT

SUBDIVISION Cabin Hill

ROAD Kontbury Drive

LOT 2, Blk. B

PROPERTY OWNER Cabin Hill Corporation - John R. Devereaux, III

ADDRESS Box 151, Sharp Road, Glenwood, Maryland

SPECIFICATIONS 4 bedrooms

DRAIN FIELD DEPTH FEET, BOTTOM AREA SQ. FT.

SEEPAGE PITS ABSORBENT SIDE-WALL AREA SQ. FT.

SEPTIC TANK CAPACITY 1200 GALLONS

FOR GARBAGE GRINDER, INCREASE DISPOSAL AREA 22% & TANK CAPACITY 50%.

OTHER DRY WELL - 100 sq. ft. absorbent sidewall area to begin below the first 3 1/2 ft. of non-absorbent ground. Maximum depth permitted for dry well is 11 ft. below original grade. Place dry well 50 ft. from front lot line and 45 ft. from right sideline as seen when facing lot from front.

NOTE: ALL PIPE FROM HOUSE TO SEPTIC TANK MUST BE CAST IRON.
PERMIT VOID AFTER THREE YEARS.

NOTE: INSTALL STAND PIPE ON SEPTIC TANK AND DRY WELL.

PLANS APPROVED BY Donald W. Monaghan


DATE 8/4/72

FILL SEPTIC TANK AND DISTRIBUTION BOX WITH WATER BEFORE CALLING FOR AN INSPECTION. COVER NO WORK UNTIL INSPECTED AND APPROVED.

NEITHER THE HOWARD COUNTY COMMISSIONERS NOR THE HEALTH DEPARTMENT IS RESPONSIBLE FOR THE SUCCESSFUL OPERATION OF ANY SYSTEM.

BLDG. PERMIT SIGNED AND RETURNED 10/19/72
Serial # - 16203
Swimming pool

A 16203

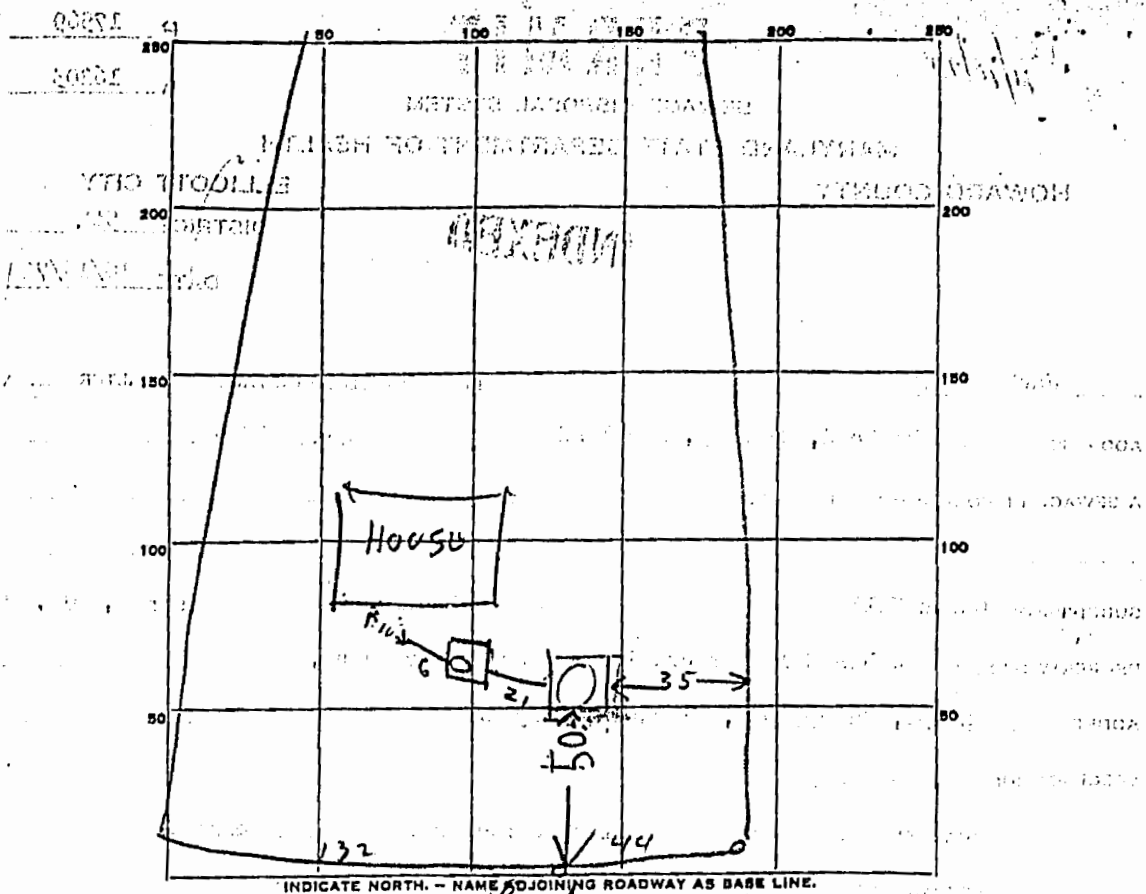

PERMIT CARD _____

SEPTIC TANK, LEVEL or concrete 1250 CLEANOUTS OK

DISTRIBUTION BOX, LEVEL _____

TILE FIELD, DEPTH _____ FT. TRENCH WIDTH _____ FT.

GRAVEL DEPTH _____ IN. TOTAL LENGTH _____ FT.

NUMBER OF TRENCHES _____ TOTAL BOTTOM AREA _____

SEEPAGE PITS, INSIDE DIAMETER 10 FT. DEPTH BELOW INLET 7 FT.

277 NOT COUNTING STONE
 ABSORBENT AREA 470 SQ. FT. COUNTING STONE

REMARKS 11/9/72 Dry Well in lot 30 ft below grade

Channel of Dry Well is 60 FT

4 Bedroom 400 sqft Requirement

Install small piece of cast iron pipe & cover

Well Not yet installed

DATE SYSTEM APPROVED 11/10/72 INSPECTOR Raymond Hodge