

VICINITY MAP


SCALE : 1" = 1200'

GENERAL NOTES:

- THIS AREA DESIGNATES A PRIVATE SEWERAGE EASEMENT OF 10,000 SQUARE FEET AS REQUIRED BY THE MARYLAND STATE DEPARTMENT OF THE ENVIRONMENT FOR INDIVIDUAL SEWERAGE DISPOSAL IMPROVEMENTS OF ANY NATURE IN THIS AREA ARE RESTRICTED UNTIL PUBLIC SEWERAGE IS AVAILABLE. THESE EASEMENTS SHALL BECOME NULL AND VOID UPON CONNECTION TO A PUBLIC SEWERAGE SYSTEM. THE COUNTY HEALTH OFFICER SHALL HAVE THE AUTHORITY TO GRANT ADJUSTMENTS TO THE PRIVATE SEWERAGE EASEMENT. RECORDED OF A MODIFIED SEWERAGE EASEMENT SHALL NOT BE NECESSARY.
- ADJUSTMENTS TO SEPTIC EASEMENT AREA IS NOT PERMITTED WITHOUT ADDITIONAL TESTING.
- THE LOT SHOWN HEREON COMPLIES WITH THE MINIMUM OWNERSHIP WIDTH AND LOT AREA AS REQUIRED BY THE MARYLAND STATE DEPARTMENT OF THE ENVIRONMENT.
- ALL HOUSE SITES SHOWN COMPLY WITH MINIMUM BUILDING RESTRICTION REGULATIONS.
- TOPOGRAPHY SHOWN IN THIS PLAN IS BASED UPON AERIAL TOPOGRAPHY FLOWN BY HARFORD AERIAL SURVEYS IN AUGUST OF 2006 AND SUPPLEMENTED WITH THE 2004 HOWARD COUNTY AERIAL TOPOGRAPHY MAPS FOR THE OFF-SITE AREAS. FIELD RUN TOPOGRAPHY WAS USED TO SUPPLEMENT THE INFORMATION USED IN THE 100 YEAR FLOODPLAIN STUDY.
- THIS PLAT IS BASED ON FIELD RUN MONUMENTED BOUNDARY SURVEY PERFORMED ON OR ABOUT DECEMBER, 2005, BY FISHER, COLLINS & CARTER, INC.
- PLAT REFERENCE 22000 THRU 22990.
- EXISTING WELLS AND/OR SEWERAGE EASEMENTS WITHIN 100 FEET OF THE PROPERTY HAVE BEEN SHOWN FROM ALL REASONABLE EFFORTS.
- THE WELL ON LOT 9 HO-95-2494 HAS BEEN FIELD LOCATED BY FISHER, COLLINS AND CARTER, INC.

SOILS LEGEND		
SOIL	NAME	CLASS
Co	Codorus and Hatboro silt loams, 0 to 3 percent slopes	C
GgA	Glenelg loam, 0 to 3 percent slopes	B
GgB	Glenelg loam, 3 to 8 percent slopes	B
GgC	Glenelg loam, 8 to 15 percent slopes	B
GmB	Glenville silt loam, 3 to 8 percent slopes	C
GmC	Glenville silt loam, 8 to 15 percent slopes	C
GnB	Glenville-Balle silt loams, 0 to 8 percent slopes	C
MAc	Manor loam, 8 to 15 percent slopes	B
MAD	Manor loam, 15 to 25 percent slopes	B

LEGEND	
	EXISTING 2' CONTOURS
	EXISTING 10' CONTOURS
	EXISTING TREE LINE
	SOIL LINES AND TYPES
	DENOTES PROPOSED ALT WELL
	DENOTES FAILED PERC
	DENOTES PASSED PERC
	DENOTES PROPOSED HOUSE
	DENOTES 25% AND GREATER SLOPE
	DENOTES 1500 SQ.FT. ALTERNATE WELL SITE
	EXISTING CENTERLINE STREAM
	STREAM BUFFER (75')
	EXISTING APPROVED PRIVATE SEWERAGE EASEMENTS
	DENOTES PERC AREA TO BE REMOVED
	DENOTES EXISTING ALT WELL

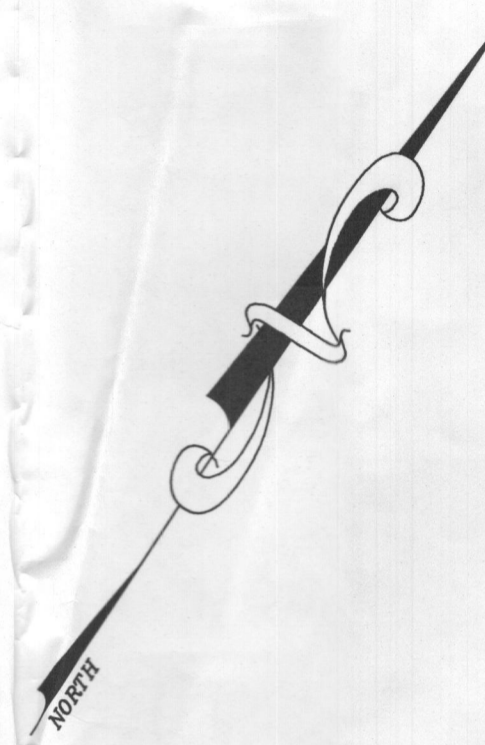

Superseded By Signed 8/9/19

PERC CERTIFICATION
 I certify that the locations shown on this plat are field locations done under my direct supervision and are correct in accordance with my professional knowledge and belief.
 Signature of Professional Land Surveyor: *Frank J. Manalansan II* Date: *3/25/19*
 Frank J. Manalansan II, Professional Land Surveyor, No. 21476 Expires 07/14/19

APPROVED FOR PRIVATE WATER AND PRIVATE SEWERAGE SYSTEMS,
 HOWARD COUNTY HEALTH DEPARTMENT.
 Signature of County Health Officer: *Maura Roseman* Date: *4/5/2019*
 COUNTY HEALTH OFFICER

THE PURPOSE OF THIS PLAN IS TO REVISE THE EXISTING PERC AREA ON LOT 9 AND REMOVE THE WELL BOX AND ADD 2 ALT. WELLS.

AMENDED
 PERC CERTIFICATION PLAT
 LOT 9
Dustin's Golden Fields

KAYLADINE LANE
 ZONING: RR-DEO
 GRID: 2 PARCELS: 103 & 184
 TAX MAP #46
 FIFTH ELECTION DISTRICT
 SCALE: 1"=100' SHEET 1 OF 1 DATE: MARCH 25, 2019
 HOWARD COUNTY, MARYLAND

OWNER AND DEVELOPER
 PATRICK C OGUEROFOR
 8603 CROOKED TREE LN
 LAUREL MD 20724