

Record Detail \* (This section is required.)

Permit Type: Building/Residential/Misc/Tanks  
 Permit Number: B23000588  
 Opened Date: 02/23/2023

Description of Work  
 SFD/ Install (1) 500 gallon underground propane tank

[check spelling](#)

Address \* (This section is required.)

*Approved 3/7/23*  
*[Signature]*

Search Reset Clear Get Parcel & Owner

Street #: 4821 Street Name: MANOR Street Type: LN  
 Unit Type: --Select-- Unit #: X Coordinate: -76.88416 Y Coordinate: 39.23836  
 City: ELLICOTT CITY State: MD Zip Code: 21042 Primary: Yes

Parcel \* (This section is required.)

Search Reset Clear Get Address & Owner

GIS ID #: 886975 Parcel: Parcel Area: 8.58 Land Value: 268700 Improved Value: 586100 Exemption Value: 317400 Plan Area: RURAL

Legal Description  
 IMPSLOT 1 8.589 A[ ]4821 MANOR LN[ ]ELLICOTT CITY

[check spelling](#)

Block: Plan Area Section Grid SDP No. Record Plat No. Owner Occupied Historic District Registry No. Building No.

Lot: Census Tract: 602303 Council Dist: 5

State Tax Id: 1402290944 Area: Zoning District: RC-DEO Final Plan No. WS Contract No. Year Built: 1985 Stat Area: 2-08B

Subdivision Name: Tax Map: 29 ADC Map: 4934-J2 WP File No. FDP No. Primary: Yes

Historic District:  Yes  No Flood Plain:  Yes  No

Owner \* (This section is required.)

Search Reset Clear

Name \*: TRUBY T JAMES  
 Address Line 1: 4821 MANOR LN

Address Line 2

Address Line 3

Mail City  
ELLCOTT CITY  
Phone  
443-271-0390  
E-mail

Mail State MD  
Mail Zip Code 21042  
Primary Yes

Cell Number

Fax Number

Professionals (This section is not required.)

License # \* 20100079809  
License Type \* Propane Gs  
Primary Yes  
Business Name MID ATLANTIC COOPERATIVE SOLUTIONS DBA AERO ENERGY  
First Name 3ICHARD Middle Name THOMAS Last Name JARCY  
Address Line 1 230 LINCOLN WAY EAST  
Address Line 2  
City NEW OXFORD State PA ZIP Code 17350-0000  
Phone 1 2406744592 Phone 2 Fax  
E-mail R.JARCY@AEROENERGY.COM

Applicant (This section is not required.)

Search As Owner As Lic. Prof As Contact

Type \* Applicant  
Relationship Applicant  
Primary Yes  
First Name steve MI Last Name dannenfeldt  
Full Name steve dannenfeldt  
Organization Name Aero Energy  
Street Address 230 lincoln way East  
Address Line 2  
City New Oxford State PA Zip Code 17350  
Phone 717-577-5923 Cell Fax  
E-mail \* sdannenfeldt@aeroenergy.com


Addtl Info

Est Construction Cost \* 6500  
Housing Units \* 0  
Number of Buildings \* 0  
Public Owned No  
Construction Type 329 - Structures Other Than Buildings (Retaining Walls/Tents)

TANK INFORMATION

RESIDENTIAL TANK INFORMATION

Capital Project-No Fee \* Capital Project Number Fee Exempt \* Roadside Tree Project Permit \* Roadside Tree Permit #  
Existing Use \* SFD  
Number of Tanks Installed \* 1  
Number of Tanks Removed \* 0  
Water Supply Sewage Disposal Expiration Date Relocate Existing Tank \*

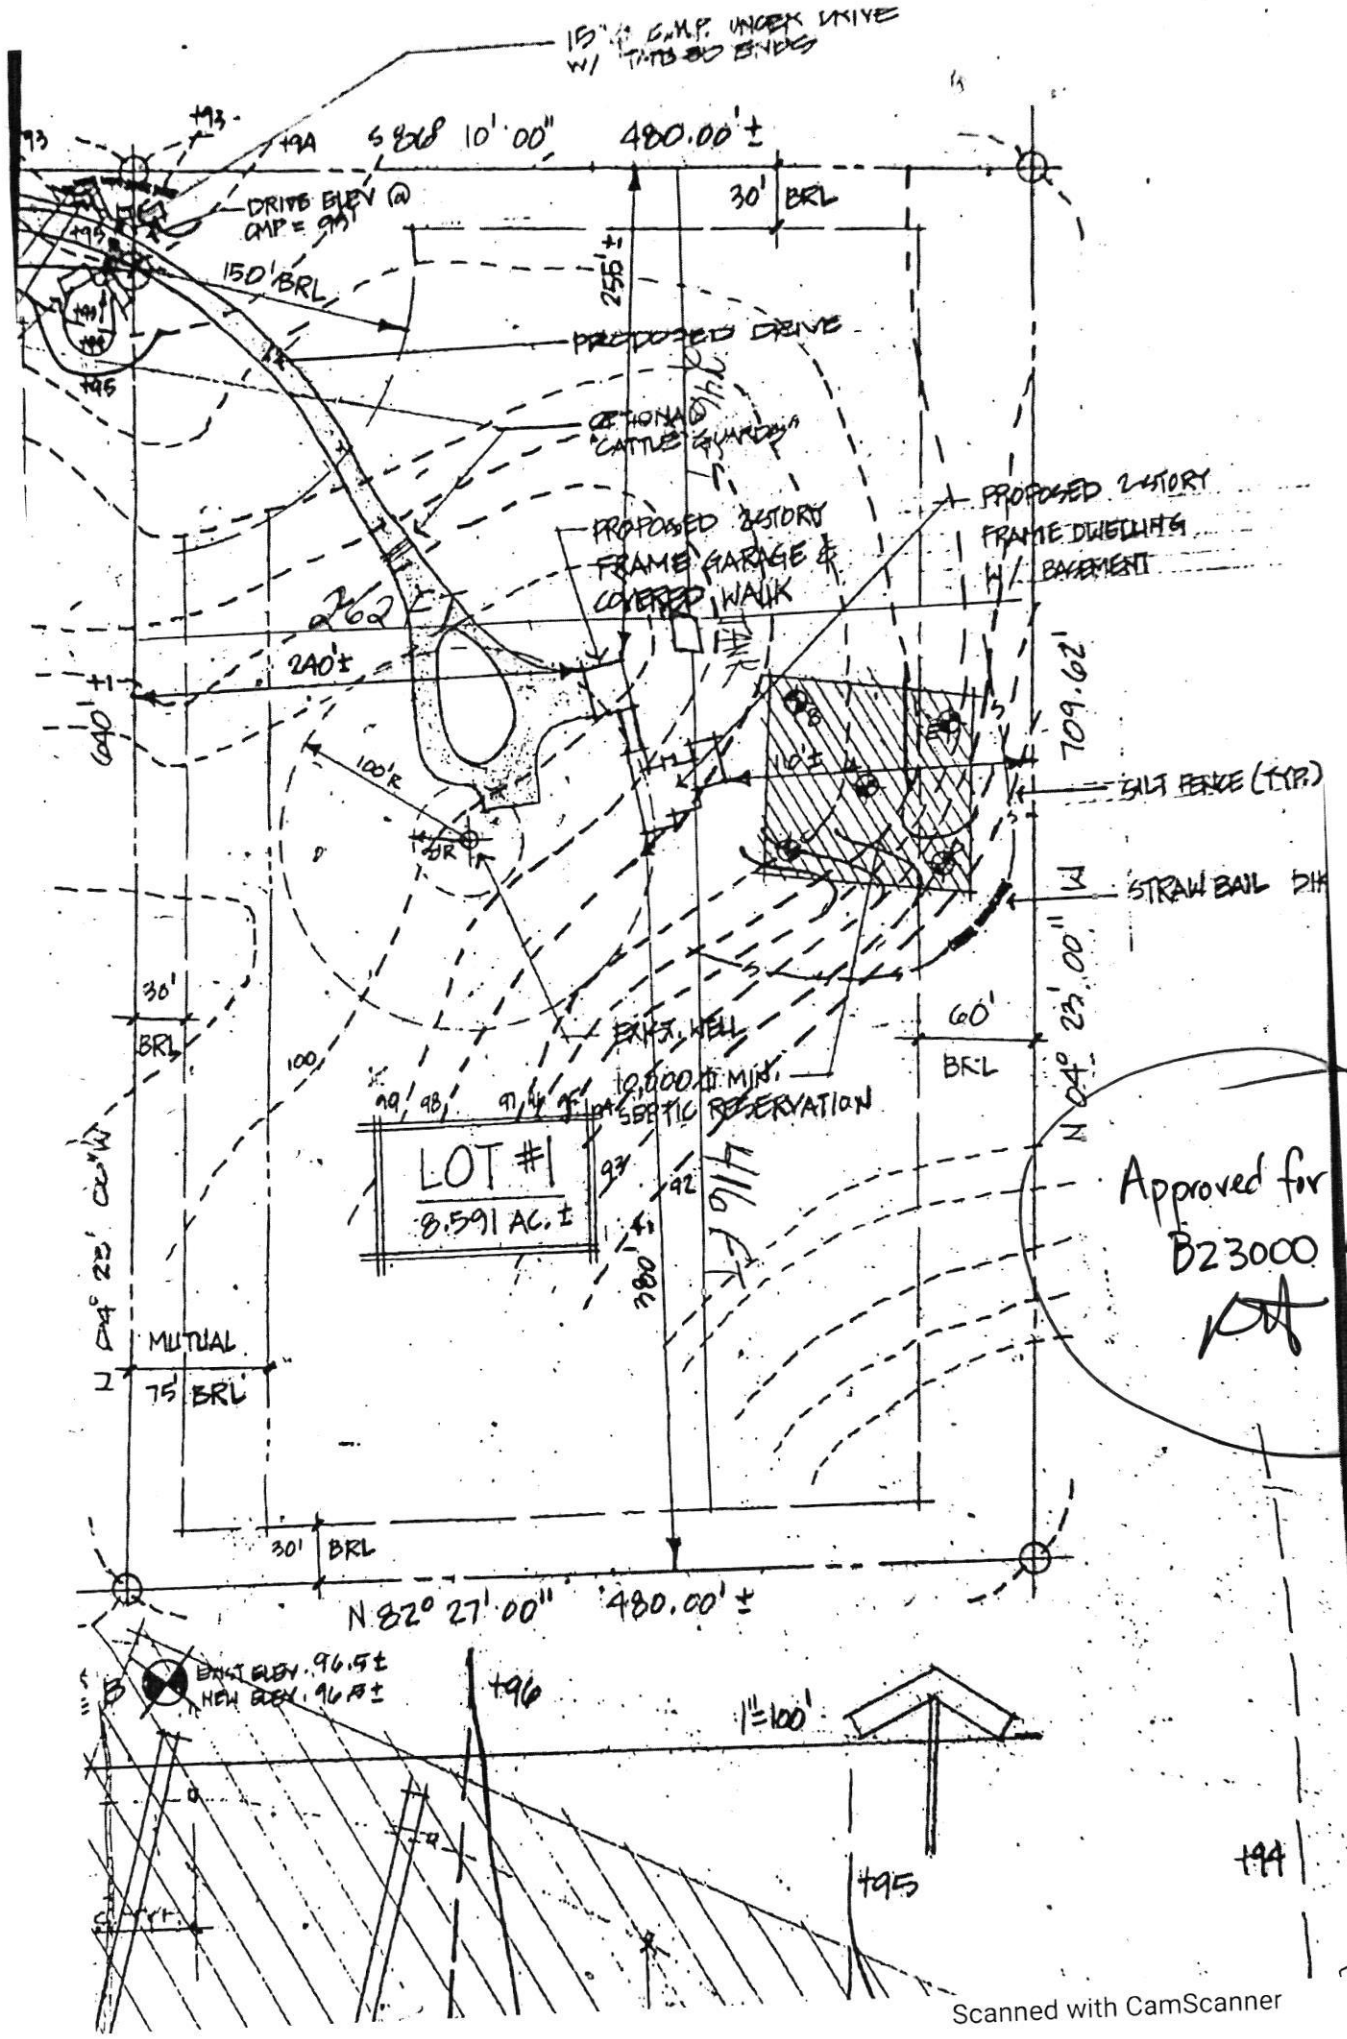

Approved for LP tank  
 B23000 588  
 3/7/23