

Approved 2/16/22

-HO

Menu Save Reset Cancel Help

Record Detail \* (This section is required.)

Permit Type	Permit Number	Opened Date
Building/Residential/Misc/Porch	B21002114	05/27/2021
Description of Work		
SFD/ CONSTRUCT 45 X 8 FRONT STONE PORCH		

check spelling

Address \* (This section is required.)

Search Reset Clear Get Parcel & Owner

Street #	Street Name	Street Type	
759	LONG CORNER	RD	
Unit Type	Unit #	X Coordinate	Y Coordinate
--Select--		77.13331	39.34855
City	State	Zip Code	Primary
MOUNT AIRY	MD	21771	Yes

Parcel \* (This section is required.)

Search Reset Clear Get Address & Owner

GIS ID *	Parcel	Parcel Area	Land Value	Improved Value	Exemption Value	Plan Area
829919	40	2.19	211900	302700	90800	RURAL
Legal Description						
IMPS2.1938 A[ J759 LONG CORNER RD[ JHARDY RD						

check spelling

Block	Lot	Census Tract	Council Dist	Inspection Dist	Supervisor Dist	Map #	DAP Zone
		804001	5				
Plan Area	State Tax Id	Subdivision Name					
	1404316576						
Section	Area	Tax Map					
		6					
Grid	Zoning District	ADC Map					
6-6	RC-DEO	4690-J5					
SDP No.	Final Plan No.	WP File No.					
Record Plat No.	WS Contract No.	FDP No.	Primary				
			No				
Owner Occupied	Year Built	Historic District					
<input type="radio"/> Yes <input type="radio"/> No	1951	<input type="radio"/> Yes <input checked="" type="radio"/> No					
Historic District Registry No.	Stat Area	Flood Plain					
	4-04	<input type="radio"/> Yes <input checked="" type="radio"/> No					
Building No							

Owner \* (This section is required.)

Search Reset Clear

Name *		
ANTONIO L DASILVA		
Address Line 1		
759 LONG CORNER RD		
Address Line 2		
Address Line 3		
Mail City	Mail State	Mail Zip Code
MOUNT AIRY	MD	21771
Phone	Primary	
3013783760	Yes	
E-mail		
LEWS@LDDASILVA.COM		
Cell Number	Fax Number	

Professionals (This section is not required.)

Search    Reset    Clear

License # *	Business Name		
08050127819	LD DASILVA INC		
License Type *	First Name	Middle Name	Last Name
MHIC Co <input checked="" type="checkbox"/>	ANTONIO		DASILVA
Primary	Address Line 1		
Yes <input checked="" type="checkbox"/>	5910 ALMANDREN DRIVE		
	Address Line 2		
	City	State	ZIP Code
	MT. AIRY	MD	21771-0000
	Phone 1	Phone 2	Fax
	3013783760		0000000000
	E-mail		
	LEWS@LDDASILVA.COM		

Applicant (This section is not required.)

Search    As Owner    As Lic. Prof    As Contact

Type *	First Name	MI	Last Name
Applicant <input checked="" type="checkbox"/>	ANTONIO	L	DASILVA
Relationship	Full Name		
Applicant <input checked="" type="checkbox"/>	ANTONIO L DASILVA		
Primary	Organization Name		
Yes <input checked="" type="checkbox"/>	LD DASILVA INC		
	Street Address		
	759 LONG CORNER RD		
	Address Line 2		
	City	State	Zip Code
	MOUNT AIRY	MD	21771
	Phone	Cell	Fax
	3013783760		
	E-mail *		
	LEWS@LDDASILVA.COM		

Addtl Info

Est Construction Cost *	Housing Units *	Number of Buildings *	Public Owned
20000	0	0	No <input checked="" type="checkbox"/>
Construction Type			
101 - Single Family Houses Detached <input checked="" type="checkbox"/>			

PORCH INFORMATION

PORCH INFORMATION

Capital Project-No Fee *	Capital Project Number	Fee Exempt *	Roadside Tree Project Permit *	Roadside Tree Project Permit #
<input type="radio"/> Yes <input checked="" type="radio"/> No		<input type="radio"/> Yes <input checked="" type="radio"/> No	<input type="radio"/> Yes <input checked="" type="radio"/> No	
Existing Use *	Type of Porch *	Type of Porch Foundation *	Total Square Footage *	
SFD <input checked="" type="checkbox"/>	Open Porch <input checked="" type="checkbox"/>	New Slab <input checked="" type="checkbox"/>	360 SQFT	
Water Supply	Sewage Disposal	Expiration Date		
Private <input checked="" type="checkbox"/>	Private <input checked="" type="checkbox"/>	12/29/2021 <input checked="" type="checkbox"/>		

PAYMENT INFORMATION


Check 1	Payee 1	Check 2	Payee 2	SAP Doc No	SAP Entered

Submit    Cancel

PROPOSED FRONT PORCH  
PLAN

PLAT NO  
SEPTIC FIELD PLAN

ANTONIO L. DASILVA  
759 LONG CORNER RD.  
MT. AIRY, MD 21771

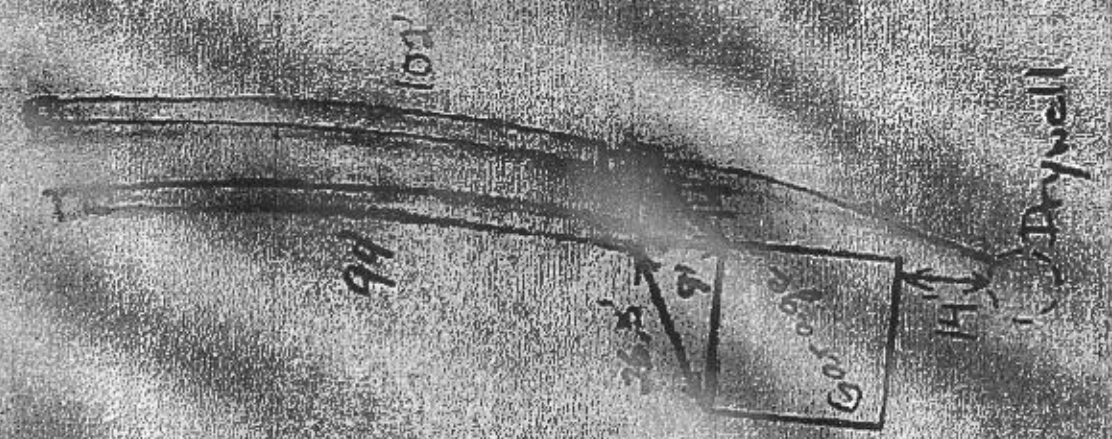

250'

Proposed Porch

