

Menu Save Reset Cancel Help

Record Detail (This section is required.)

Permit Type: Building/Residential/Misc/Tanks
 Permit Number: B22000421
 Opened Date: 02/13/2022

Description of Work
 SFD//INSTALL (1) 1000 GAL UNDERGROUND PROPANE TANK ON SIDE OF SFD

[check spelling](#)

Address (This section is required.)

Search Reset Clear Get Parcel & Owner

Street # 13610 Street Name MEADOW GLENN Street Type --Select--

Unit Type --Select-- Unit # 1 X Coordinate -76.98886 Y Coordinate 39.21588

City CLARKSVILLE State MD Zip Code 21029 Primary Yes

Approved 2/14/22
[Signature]

Parcel (This section is required.)

Search Reset Clear Get Address & Owner

GIS ID	Parcel	Parcel Area	Land Value	Improved Value	Exemption Value	Plan Area
870446	1	3.01	285000	607100	322100	RURAL

Legal Description
 IMPLOT 18 3.0187 A[]13610 MEADOW GLENN[]DUNFRETEN ESTATES

[check spelling](#)

Block	Lot	Census Tract	Council Dist	Inspection Dist	Supervisor Dist	Map #	DAP Zone
	18	605101	5				

Plan Area: State Tax Id 1405392993 Subdivision Name

Section: Area Tax Map 34

Grid: Zoning District RR-DEO ADC Map 4933-B6

SDP No. Final Plan No. WP File No.

Record Plat No. 5403 WS Contract No. FDP No. Primary Yes

Owner Occupied: Year Built 1985 Historic District No

Historic District Registry No. Stat Area 5-04A Flood Plain No

Building No

HD. Edward White

Owner (This section is required.)

Search Reset Clear

Name: WHITE EDWARD P

Address Line 1: 13610 MEADOW GLENN

Address Line 2

Address Line 3

Mail City: CLARKSVILLE Mail State: MD Mail Zip Code: 21029

Phone: 301-725-3232 Primary Yes

E-mail

Cell Number Fax Number

Professionals (This section is not required.)

Search Reset Clear

License # *	Business Name		
103851	HJ POIST		
License Type *	First Name	Middle Name	Last Name
Propane Gs	SEAN		UNDERWOOD
Primary	Address Line 1		
Yes	360 MAIN STREET		
	Address Line 2		
	City	State	ZIP Code
	LAUREL	MD	20707
	Phone 1	Phone 2	Fax
	301-725-3232		
	E-mail		

Applicant (This section is not required.)

Search As Owner As Lic. Prof As Contact

Type *	First Name	MI	Last Name
Applicant	MICHELLE		CLANCY
Relationship	Full Name		
Applicant	MICHELLE CLANCY		
Primary	Organization Name		
Yes	APPLIED & APPROVED PERMITS LLC		
	Street Address		
	P.O. BOX 310		
	Address Line 2		
	City	State	Zip Code
	PERRY HALL	MD	21128
	Phone	Cell	Fax
	443-340-1229		
	E-mail *		
	MICHELLE@APPLIEDANDAPPROVED.COM		

Addtl info

Est Construction Cost *	Housing Units *	Number of Buildings *	Public Owned
2000	0	0	No
Construction Type			
--Select--			

TANK INFORMATION

RESIDENTIAL TANK INFORMATION

Capital Project-No Fee *	Capital Project Number	Fee Exempt *	Roadside Tree Project Permit *	Roadside Tree Permit #
<input type="radio"/> Yes <input checked="" type="radio"/> No		<input type="radio"/> Yes <input checked="" type="radio"/> No	<input type="radio"/> Yes <input checked="" type="radio"/> No	
Existing Use	Number of Tanks Installed *	Number of Tanks Removed *		
--Select--	1	0		
Water Supply	Sewage Disposal	Expiration Date	Relocate Existing Tank *	
Private	Private	8/13/2022	0	

PAYMENT INFORMATION

Check 1	Payee 1	Check 2	Payee 2	SAP Doc No	SAP Entered

Submit Cancel

PREPARED BY:

p: 443.819.3994
www.exactaMD.com



PROPERTY ADDRESS: 13610 MEADOW GLENN, CLARKSVILLE, MARYLAND 21029

SURVEY NUMBER: 2009.7292



FIELD WORK DATE: 10/20/2020

REVISION HISTORY: (REV 10/22/2020)


2009.7292
BOUNDARY SURVEY
LOT 18
DUNFRETEN ESTATES
HOWARD COUNTY, MARYLAND
10-21-2020 SCALE 1"=80'

NOTES:

1. THE PROPERTY SHOWN HEREON IS IDENTIFIED AS TAX MAP #392993 AMONG THE ASSESSMENT RECORDS OF HOWARD COUNTY, MARYLAND.

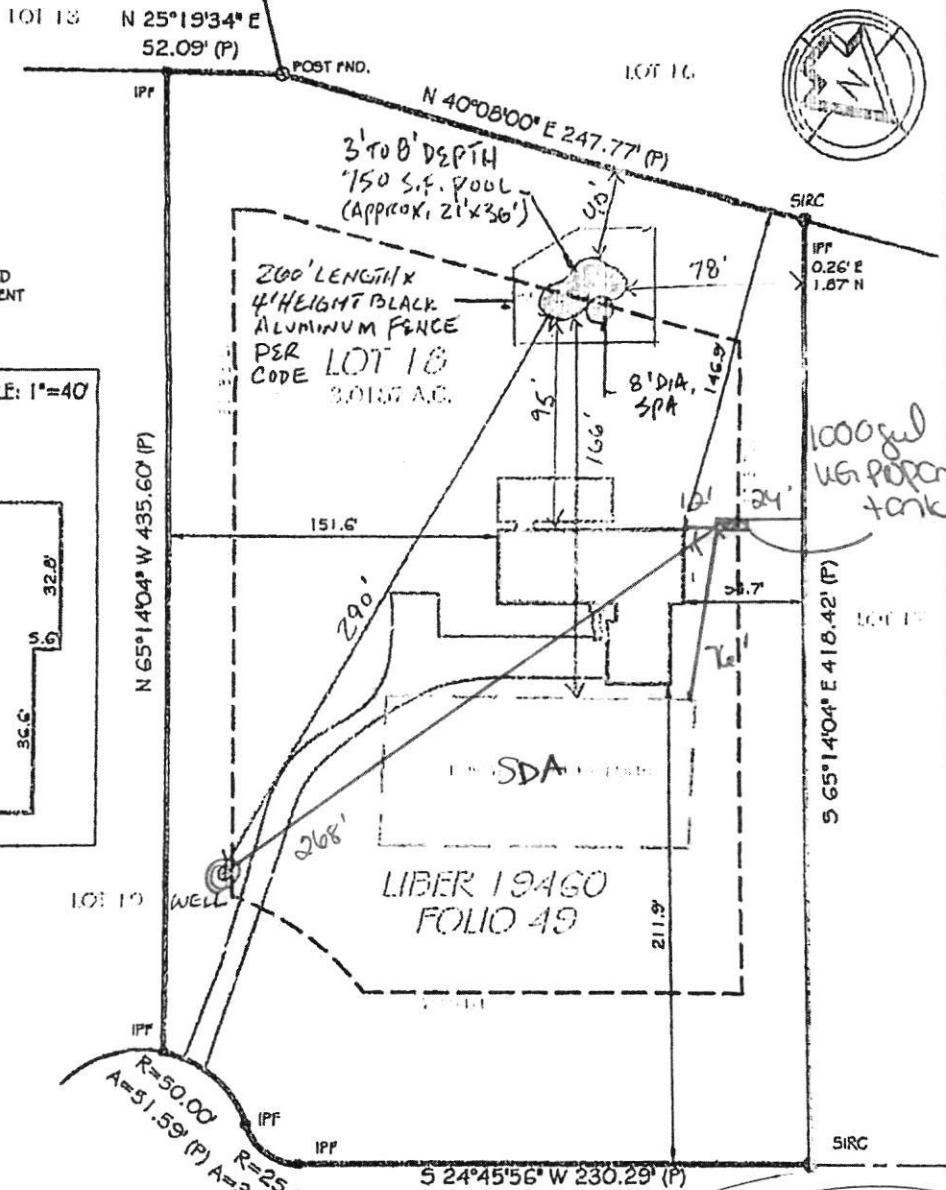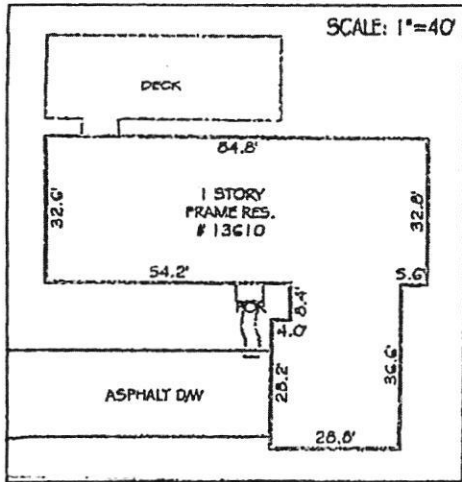

EXPIRES 5-26-2022

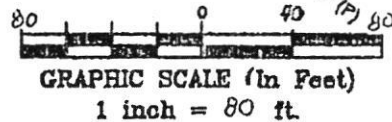

MEADOW GLENN

Approved for LP tank
B22000241
2/14/22

POINTS OF INTEREST: