


Basement

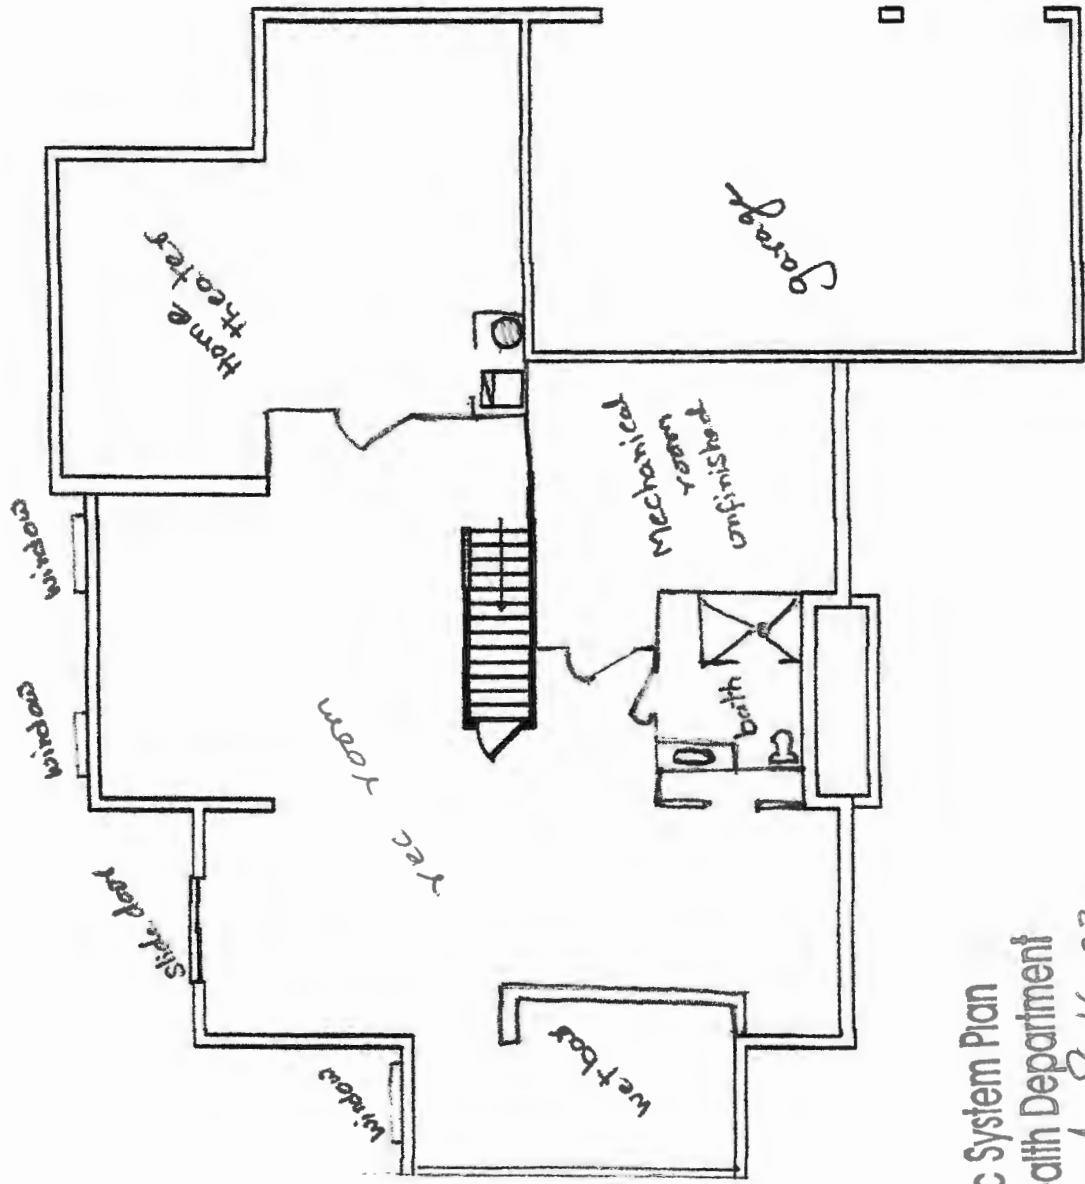

Approved Septic System Plan
Howard County Health Department

Dana Bernard 8-16-23

Signature

Date