



HOWARD COUNTY HEALTH DEPARTMENT

67327

DATE 2/27/20

P5
301-370-4121

Received From

Legacy Septic
excavation LLC

PHONE #

For

Tank replacement -
3174 Fenning
Chapel, MD.

CASH

CHECK

NO.

55916

One hundred sixty five


Dollars

\$

165 | 00

Received By

King

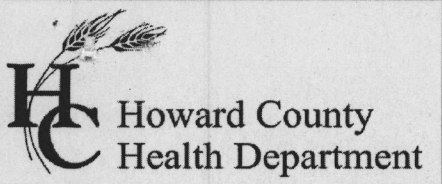

Bureau of Environmental Health

8930 Stanford Boulevard, Columbia, MD 21045

Main: 410-313-2640 | Fax: 410-313-2648

TDD 410-313-2323 | Toll Free 1-866-313-6300

www.hchealth.org

Facebook: www.facebook.com/hocohealth

Maura J. Rossman, M.D., Health Officer

RECEIPT DATE: 2/27/20 ONSITE SEWAGE DISPOSAL SYSTEM P 567327

APPROVAL DATE: 03/10/2020 PERMIT: REPAIR A

PROPERTY ADDRESS: 3174 Jennings Chapel Road

SUBDIVISION: LOT: TAX ID: 04-325044

CONTRACTOR: Legacy Septic and Excavation EMAIL:

CONTRACTOR ADDRESS: 1538 Manchester Road, Westminster, MD 21157 PHONE: 410-840-8766

PROPERTY OWNER: Junate Bujanauskas EMAIL:

OWNER ADDRESS: 3174 Jennings Chapel Road, Woodbine, MD 21797 PHONE: 443-722-0604

SEPTIC TANK SIZE (GALLONS): 1500 PUMP CHAMBER CAPACITY (GALLONS): PUMP SIZE:

NUMBER OF BEDROOMS: 3 HOUSE SQ. FT. APPLICATION RATE:

DISTRIBUTION SYSTEM: GRAVITY FED [X] LOW PRESSURE DOSED []

Table with 2 columns: Field Name, Value. Includes TRENCHES, LOCATION, and NOTES sections.

ISSUED BY: JOSEPH CABALLER 001997 ISSUE DATE: 03/10/2020 EXPIRATION DATE: 03/10/2021


- NOTE: CONTRACTOR MUST SCHEDULE A PRE-CONSTRUCTION INSPECTION PRIOR TO BEGINNING ANY INSTALLATION
NOTE: CONTRACTOR MUST SCHEDULE AN INSPECTION AND GAIN APPROVAL OF ALL COMPONENTS PRIOR TO COVERING
NOTE: STONE MUST BE APPROVED BY HEALTH DEPARTMENT AND GRAVEL TICKET MUST BE AVAILABLE FOR REVIEW.
NOTE: WATERTIGHT SEPTIC TANKS REQUIRED
NOTE: ALL PARTS OF SEPTIC SYSTEM SHALL BE AT LEAST 100 FEET DOWNGRADIENT FROM ANY WATER WELL
NOTE: MANHOLE RISERS REQUIRED ON ALL SEPTIC TANKS AND PUMP CHAMBERS
NOTE: AN ELECTRICAL PERMIT IS REQUIRED FOR INSTALLATION OF ANY ELECTRICAL COMPONENTS OF THE SYSTEM
NOTE: THE HCHD DOES NOT WARRANTY ANY SYSTEM AND CANNOT GUARANTEE THE PERFORMANCE OF THIS SYSTEM AS DESIGNED.
NOTE: MDE RECOMMENDS SEPTIC TANKS, BAT, AND OTHER PRETREATMENT UNITS BE PUMPED AT A FREQUENCY ADEQUATE TO ENSURE THAT SOLIDS ARE NOT DISCHARGED TO THE DISPOSAL AREA

NEITHER THE HOWARD COUNTY COUNCIL NOR THE HEALTH DEPARTMENT IS RESPONSIBLE FOR THE SUCCESSFUL OPERATION OF ANY SYSTEM. PERMITTEE RESPONSIBLE FOR OBTAINING FINAL APPROVAL ON THIS PERMIT. CALL 410-313-1771 TO SCHEDULE INSPECTIONS.

POSSIBLE
REP WELL
AREA

EXISTING
DRAIN WELL

12' DIAMETER
~2'-1.5' COVER
(11.5' DEEP TO GRADE)
10' BELOW INVERT
10" FALL (AS OF
3/10/2020)

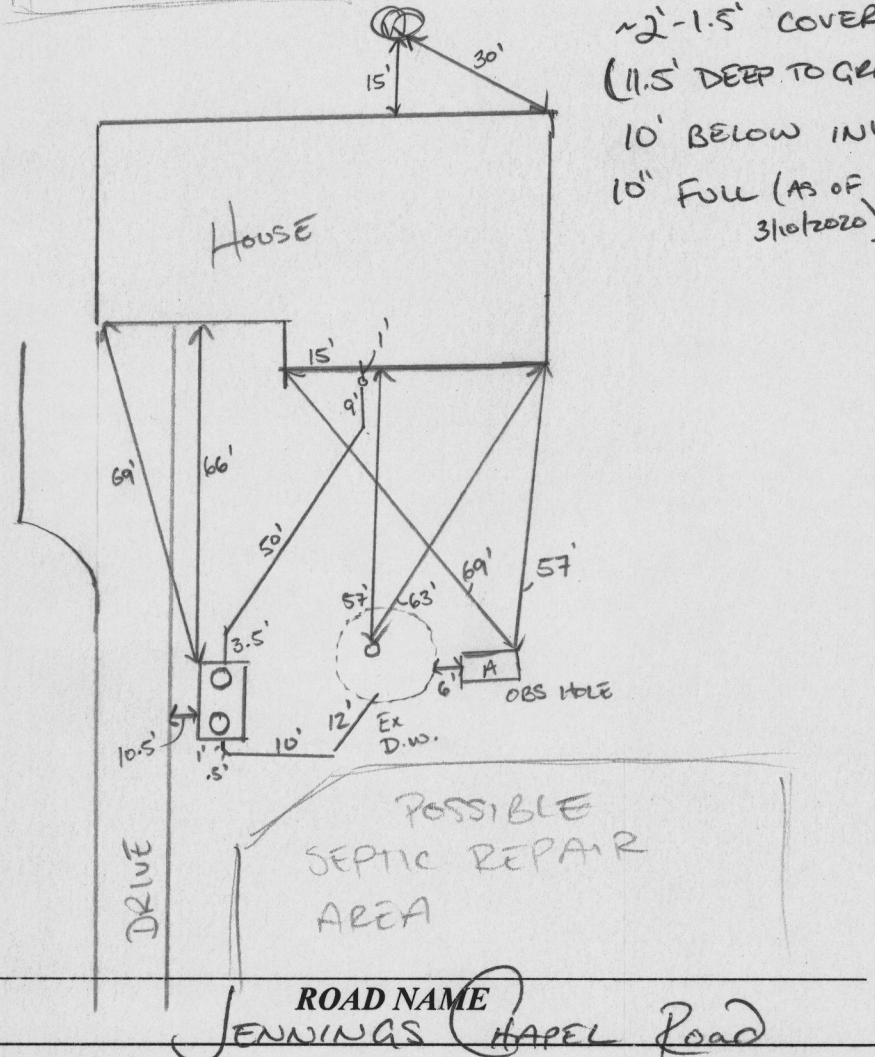

TRENCH/DRAINFIELD DATA

WIDTH	INLET	BOTTOM
Ex D.W.		
NUMBER OF TRENCHES		—
TOTAL LENGTH		—
ABSORPTION AREA		—
DISTRIBUTION BOX LEVEL		—
DISTRIBUTION BOX BAFFLE		—
DISTRIBUTION BOX PORT		—

PRE-CONSTRUCTION:

SEPTIC TANK DATA

SEPTIC TANK 1 LEVEL	
MANUFACTURER	BABYLON
CAPACITY	1500 GAL
SEAM LOC	TOP
TANK LID DEPTH	~1'
BAFFLES	YES
BAFFLE FILTER	NO
MANHOLE LOC	FRONT/BACK
6" PORT LOC	—
WATERTIGHT TEST	—
SLOTTED	YES
DATE ON LID	02/10/2020

PUMP/SEPTIC TANK LEVEL

MANUFACTURER	
CAPACITY	_____ GAL
SEAM LOC	_____
TANK LID DEPTH	_____
BAFFLES	_____
BAFFLE FILTER	_____
MANHOLE LOC	_____
6" PORT LOC	_____
WATERTIGHT TEST	_____
SLOTTED	_____
DATE ON LID	_____

3/10/2020 OBS PIT DIG FOR VISUAL ON SOIL AND TO CONFIRM 4' TREATMENT ZONE. MACHINE MAX DEPTH 14'. (SEE ATTACHED OBS SOIL DATA)


INSTALLATION:

03/10/2020 EX TANK AND EX DW EXPOSED. TANK PUMPED AND COLLAPSED, FILLED W/ CLEAN FILL. NEW TANK LOCATION MOVED ~100' FROM WELL. DW MEASURED 12' DIAMETER x 11.5' DEEP (10' BELOW INVERT) w/ 10" STANDING WATER. (PM) TANK INSTALLED. SHC INSTALLED ~.0097% FALL.

FINAL INSPECTOR

DATE OF APPROVAL

03/10/2020

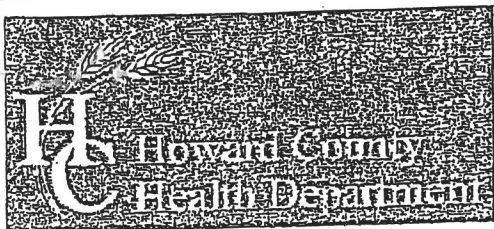

Bureau of Environmental Health
 8930 Stanford Boulevard, Columbia, MD 21045
 Main: 410-313-2640 | Fax: 410-313-2648
 TDD 410-313-2323 | Toll Free 1-866-313-6300
 www.hchealth.org
 Facebook: www.facebook.com/hocohealth
 Twitter: HowardCoHealthDep

Dr. Maura J. Rossman, M.D., Health Officer

INFORMATION FORM – SEPTIC SYSTEM REPAIR/UPGRADE

Reason for Request:

- Failing System
- System relocation for proposed addition
- System upgrade for proposed addition
- Inadequate treatment zone
- Collapsed septic tank Leaking
- Collapsed drywell

Existing system design

- Drywell
- Trench
- Mound
- Unknown
- Other: _____

Is discharge surfacing on the ground?

- Yes
- No

Has the septic tank been pumped within the last month?

- Yes Date pumped: _____
- No

Was a visual inspection of the septic tank and/or drain fields conducted?

- Yes Explain observations: _____
- No

Was a visual inspection of the sewage line conducted?

- Yes
 - Blockage leading to the tank
 - Yes. Explain: _____
 - No BUT REPLACING W/PVC
 - Blockage leading to the field
 - Yes. Explain: _____
 - No BUT REPLACING W/PVC

Additional Comments: WILL HAVE TO MOVE TANK AWAY FROM WELL

*For REPAIRS, are the owners proposing, or do they plan to add in the future, any additions or modifications to the property, i.e. pools, living space additions, garages, etc? This information must be disclosed at the time of this application. The Health Department will not be able to accommodate requests in the field for property modifications unrelated to the repair request. Such requests may require an additional fee, testing, and submittal of a Percolation Certification Plan, if the property does not meet current Code and Regulation.

Septic Contractor: Legacy Septic Contractor's Phone: 301-370-4121
 Contractor's Address: 1538 Manchester Road Westminster
 Property Address: 3174 Jennings Chapel Road County file: 325044
 Subdivision: Woodbine MD 21797 Lot: _____ Year Built: _____
 Owner's Name: JURATE BUJANASKAS Owner's Phone: 443-722-0604
 Name of previous owners: _____ Existing bedrooms: 3
 Proposed bedrooms: 3

Has this request been previously discussed with a Sanitarian? (Name): PC
 Public Sewer available/nearby: PC

*A Sanitarian will be in contact within three business days, depending upon the urgency of the situation, to coordinate the scheduling/review of the repair or upgrade.

Prior to scheduling inspections, scaled plans should be submitted to clarify the nature of the addition.

Print out a copy of Real Property Data via Dept. of Taxation website _____ Indexed file found _____

If public sewer may be nearby, verify whether sewer is technically "available" through the Bureau of Engineering.

If sewer is available and the property is within the Metropolitan District, connection to sewer is required. If the owner believes reason for exemption exists, the owner should justify the request in writing.

If soil/site conditions are limited and sewer and/or Metro District status is not conducive to connection, the Sanitarian may recommend pursuit of Emergency Sewer Extension or Emergency Metro District Inclusion. The Owner should contact the Bureau of Utilities for details.

No permit is to be issued nor inspection to be scheduled without prior fee collection at the office unless an emergency situation exists. The contractor is to notify office of the emergency situation as soon as possible.


HOME LAND ENVIRONMENTAL

→ Failed Tank
LEAKING

p:443-995-5385 | f:443-267-0098 | info@homelandhealthyhomes.com | www.homelandseptic.com


Sketch of System

←
Front of House

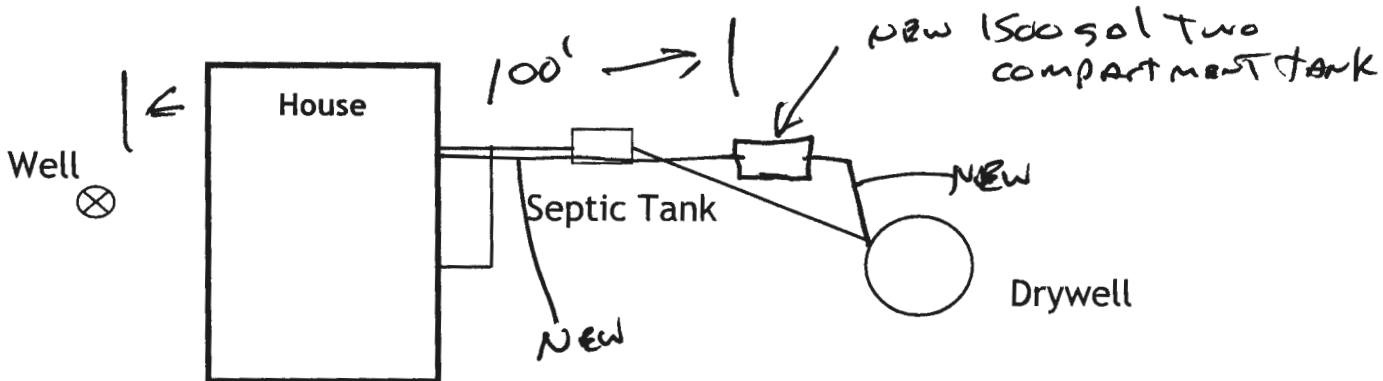

DISCLAIMERS

- This is a subjective and visual inspection only, the conclusions of which are based on the observed condition of the system components that could reasonably be accessed, and information known about the system at the time this report was completed. There may be unknown historical problems or unseen conditions which may compromise the conclusions stated in this report.
- Suggestions or recommendations for repairs or remediation may result in the need for further repair or remediation once the system components are fully excavated.
- A 'Satisfactory' evaluation does not mean the system will meet the local approving authority's criteria for determining compliance with state code: COMAR 26.04.02.02 D(4).
- The evaluation of the Sewage Disposal System as reported is based on the conditions observed on the day of the inspection.
- This report is neither a WARRANTY nor does it GUARANTEE continued acceptable functionality or performance of the Sewage Disposal Systems operations.
- If the house has been unoccupied the findings in this report may not be accurate, as limited or no use of the system may conceal or mask problems that may be revealed under typical sewage loading.
- If the general ground condition is excessively wet at the time of inspection, the findings in this report may not be accurate, as ground moisture may cover or hide septic effluent that may be on or near the ground surface.
- If the house is vacant or the conditions excessively wet during inspection, it is recommended that the system be reevaluated at a later date and/or alternate techniques be used to address those potential issues.
- Payment and/or use of this evaluation signify understanding and acceptances of the above clauses, as well as any noted faults with the system.

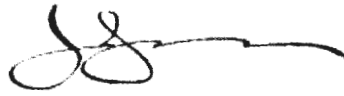Representative's Signature:		Date: 12/19/2019
-----------------------------	--	------------------

p:443-995-5385 | f:443-267-0098 | info@homelandhealthyhomes.com | www.homelandseptic.com