

Record Detail * (This section is required.)

Permit Type Building/Residential/Misc/Tanks Permit Number B24000541 Opened Date 02/20/2024
 Description of Work SFD/Install 2 100 gallon aboveground tanks for a generator

Approved.
 g/d 2/26/24

[check spelling](#)

Address * (This section is required.)

Search Reset Clear Get Parcel & Owner

Street # 14505 Street Name MACCLINTOCK Street Type DR
 Unit Type --Select-- Unit # X Coordinate -77.01955 Y Coordinate 39.27834
 City GLENWOOD State MD Zip Code 21738 Primary Yes

Parcel * (This section is required.)

Search Reset Clear Get Address & Owner

GIS ID *	Parcel	Parcel Area	Land Value	Improved Value	Exemption Value	Plan Area
899101	129	1.17	246700	458900	212200	RURAL

Legal Description
 IMPSPLOT 10 BL B S 4{ }14505 MACCLINTOCK DR{ }WARFIELD ESTS

[check spelling](#)

Block	Lot	Census Tract	Council Dist	Inspection Dist	Supervisor Dist	Map #	DAP Zone
	10	605601	5				

Plan Area State Tax Id 1404329031 Subdivision Name WARFIELD ESTATES SEC 4
 Section Area Tax Map 21
 Grid Zoning District RR-DEO ADC Map 4812-G6
 SDP No. Final Plan No. F-98-076 WP File No.
 Record Plat No. WS Contract No. FDP No. Primary Yes
 21 98
 Owner Occupied Year Built 1975 Historic District
 Yes No
 Historic District Registry No. Stat Area 4-09 Flood Plain
 Yes No
 Building No

Owner * (This section is required.)

Search Reset Clear

Name * STURGES DAVID A & TAMARA A
 Address Line 1 14505 MACCLINTOCK DR
 Address Line 2
 Address Line 3

Mail City GLENWOOD Mail State MD Mail Zip Code 21738
 Phone 410-442-2724 Primary Yes

E-mail

Cell Number

Fax Number

Professionals (This section is not required.)

License # * 20100079809 Business Name MID ATLANTIC COOPERATIVE SOLUTIONS DBA AERO ENERGY

License Type * Propane Gs First Name 3ICHARD Middle Name THOMAS Last Name JARCY

Primary Address Line 1 230 LINCOLN WAY EAST
Yes Address Line 2

City NEW OXFORD State PA ZIP Code 17350-0000

Phone 1 2406744592 Phone 2 717-624-5809 Fax

E-mail RJARCY@AEROENERGY.COM

Applicant (This section is not required.)

Search As Owner As Lic. Prof As Contact

Type * Applicant First Name steve MI Last Name dannenfeldt

Relationship Applicant Full Name steve dannenfeldt

Primary Organization Name Aero Energy
Yes Street Address 230 lincoln way East
Address Line 2

City New Oxford State PA Zip Code 17350

Phone 717-577-5923 Cell Fax

E-mail * dfrazier@aeroenergy.com

Addtl Info

Est Construction Cost * 3000 Housing Units * 0 Number of Buildings * 0 Public Owned No

Construction Type --Select--

TANK INFORMATION

RESIDENTIAL TANK INFORMATION

Capital Project-No Fee * Yes No Capital Project Number Fee Exempt * Yes No Roadside Tree Project Permit * Yes No Roadside Tree Permit #


Existing Use * SFD Number of Tanks Installed * 2 Number of Tanks Removed * 0

Water Supply Private Sewage Disposal Private Expiration Date 8/19/2024 Relocate Existing Tank * 0

Submit Cancel

MAC CLINTOCK
ARC-263.44

50' DRIVE
R=495.0'

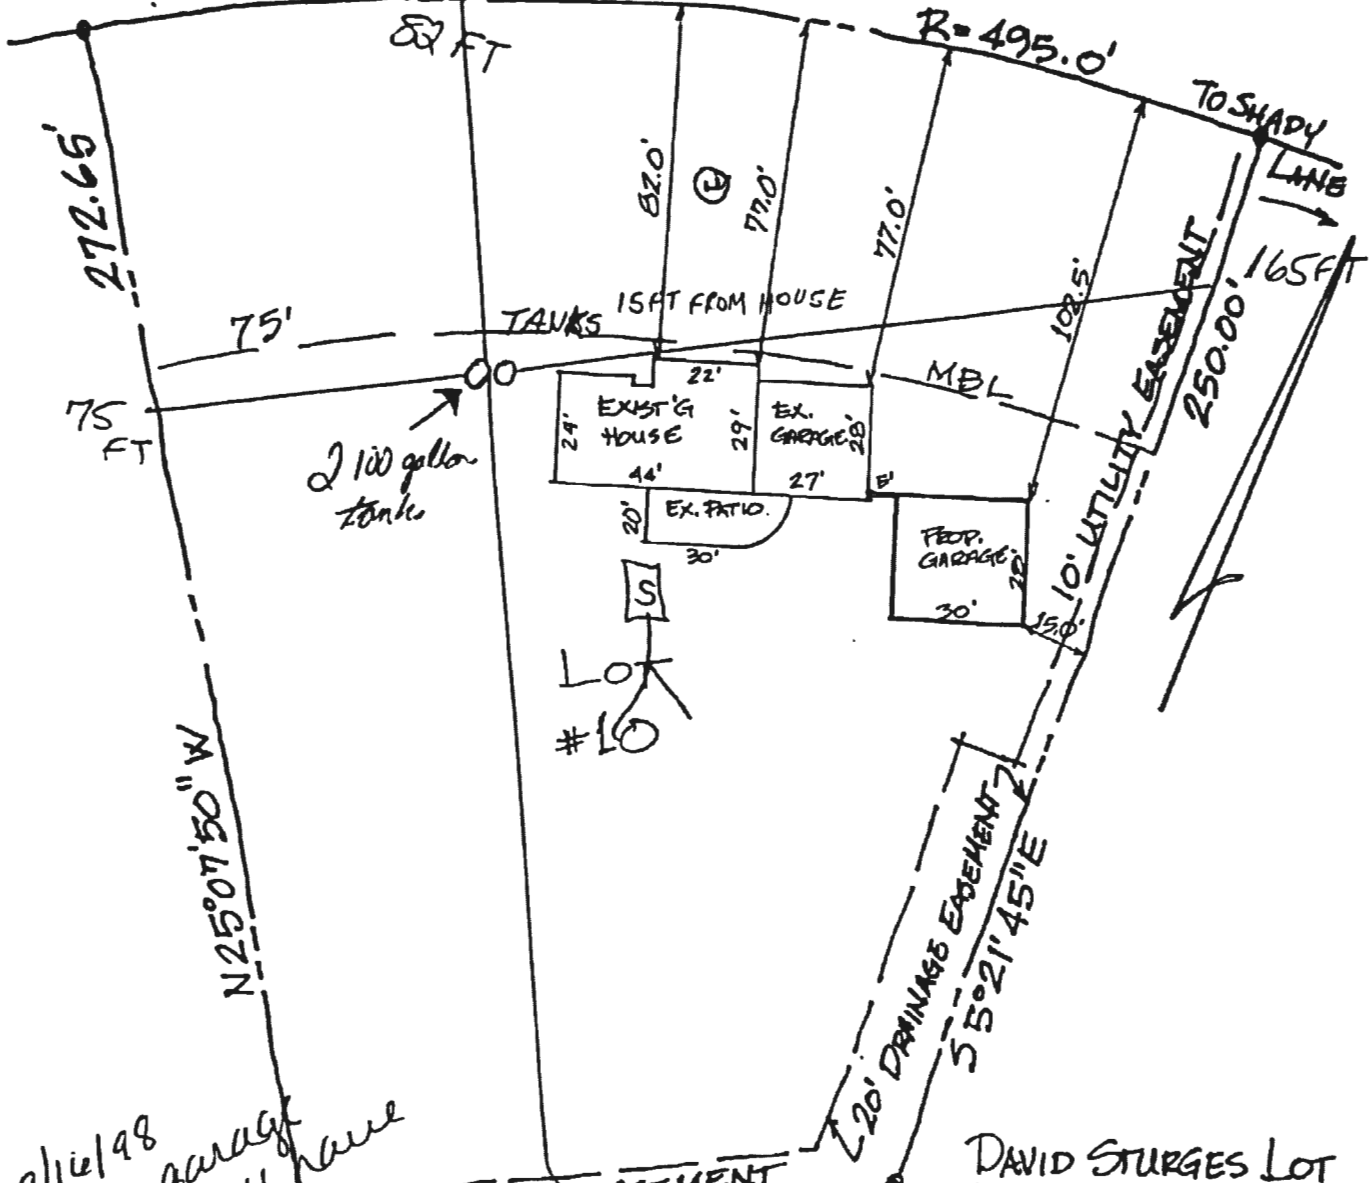


2 100 gallon tanks

Lot #10

DAVID STURGES LOT
LOT 10, BLOCK "B", SECT. 4
DIST. 4, HOWARD Co. MD.

9/16/98
Shown garage addition will have no impact to the existing well or septic

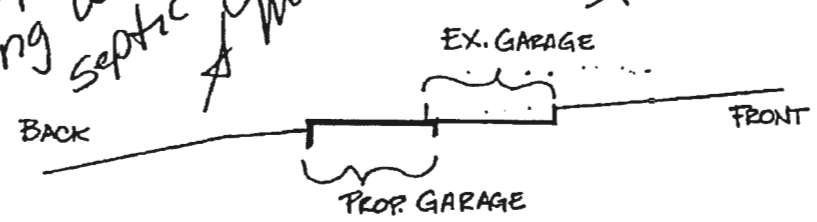

ELEVATION

Scale: 1"=40' Date: 9/10/98
DWN. BY: M.T.G.