

Record Detail (This section is required.)

Permit Type	Permit Number	Opened Date
Building/Residential/Misc/Tanks	B24001109	04/01/2024
Description of Work		
SFD//INSTALL (1) 250 GAL UNDERGROUND PROPANE TANK		

[check spelling](#)

Address (This section is required.)

Search Reset Clear Get Parcel & Owner

Street #	Street Name	Street Type
8030	KAYLADINE	LN
Unit Type	Unit #	X Coordinate
-Select-		-76.92887
		Y Coordinate
		39.14982
City	State	Zip Code
FULTON	MD	20759
	Primary	
	Yes	

Approved 4/2/24
FA

Parcel (This section is required.)

Search Reset Clear Get Address & Owner

GIS ID	Parcel	Parcel Area	Land Value	Improved Value	Exemption Value	Plan Area
1102707	103	1.32	279300	2274900	1995600	RURAL
Legal Description						
IMPSLOT 9 1.315 A.[]8030 KAYLADINE LN[]DUSTINS GOLDEN FIELDS						

[check spelling](#)

Block	Lot	Census Tract	Council Dist	Inspection Dist	Supervisor Dist	Map #	DAP Zone
	9	605102	4				
Plan Area	State Tax Id	Subdivision Name					
	1405596598	Dustin's Golden Fields					
Section	Area	Tax Map					
		46					
Grid	Zoning District	ADC Map					
46-1	RR-DEO	5052-B7					
SDP No.	Final Plan No.	WP File No.					
	F-07-100						
Record Plat No.	WS Contract No.	FDP No.		Primary			
22888-2289				Yes			
Owner Occupied	Year Built	Historic District					
<input type="radio"/> Yes <input checked="" type="radio"/> No	2023	<input type="radio"/> Yes <input checked="" type="radio"/> No					
Historic District Registry No.	Stat Area	Flood Plain					
	5-17A	<input type="radio"/> Yes <input checked="" type="radio"/> No					
Building No							

Owner (This section is required.)

Search Reset Clear

Name
TRUSTEES PATRICK C OGUEJIOFOR LIVI

Address Line 1
8603 CROOKED TREE LN

Address Line 2

Address Line 3

Mail City	Mail State	Mail Zip Code
LAUREL	MD	20724
Phone	Primary	
443-981-1598	Yes	

E-mail

Cell Number Fax Number

Professionals (This section is not required.)

License # * 20100102776
 Business Name N/A
 License Type * Propane Gs
 Primary Yes
 First Name ROBERT Middle Name FRANCIS Last Name HINKLEMAN
 Address Line 1 5260 WESTVIEW DR., STE. 200
 Address Line 2
 City FREDERICK State MD ZIP Code 21703
 Phone 1 410-652-0050 Phone 2 855-965-5577 Fax
 E-mail RHINKLEMAN@THOMPSONGAS.COM

Applicant (This section is not required.)

Search As Owner As Lic. Prof As Contact

Type * Applicant
 Relationship Applicant
 Primary Yes
 First Name MICHELLE MI Last Name CLANCY
 Full Name MICHELLE CLANCY
 Organization Name APPLIED & APPROVED PERMITS LLC
 Street Address P.O. BOX 310
 Address Line 2
 City PERRY HALL State MD Zip Code 21128
 Phone 443-340-1229 Cell Fax
 E-mail MICHELLE@APPLIEDANDAPPROVED.COM

Addtl Info


Est Construction Cost 1500 Housing Units 0 Number of Buildings 0 Public Owned No
 Construction Type 329 - Structures Other Than Buildings (Retaining Walls/Tents)

TANK INFORMATION

RESIDENTIAL TANK INFORMATION

Capital Project-No Fee * Capital Project Number Fees Exempt * Roadside Tree Project Permit * Roadside Tree Permit #
 Yes No Yes No Yes No
 Existing Use * Number of Tanks Installed Number of Tanks Removed *
 SFD 1 0
 Water Supply Sewage Disposal Expiration Date Relocate Existing Tank
 Private Private 9/29/2024 0

Submit Cancel

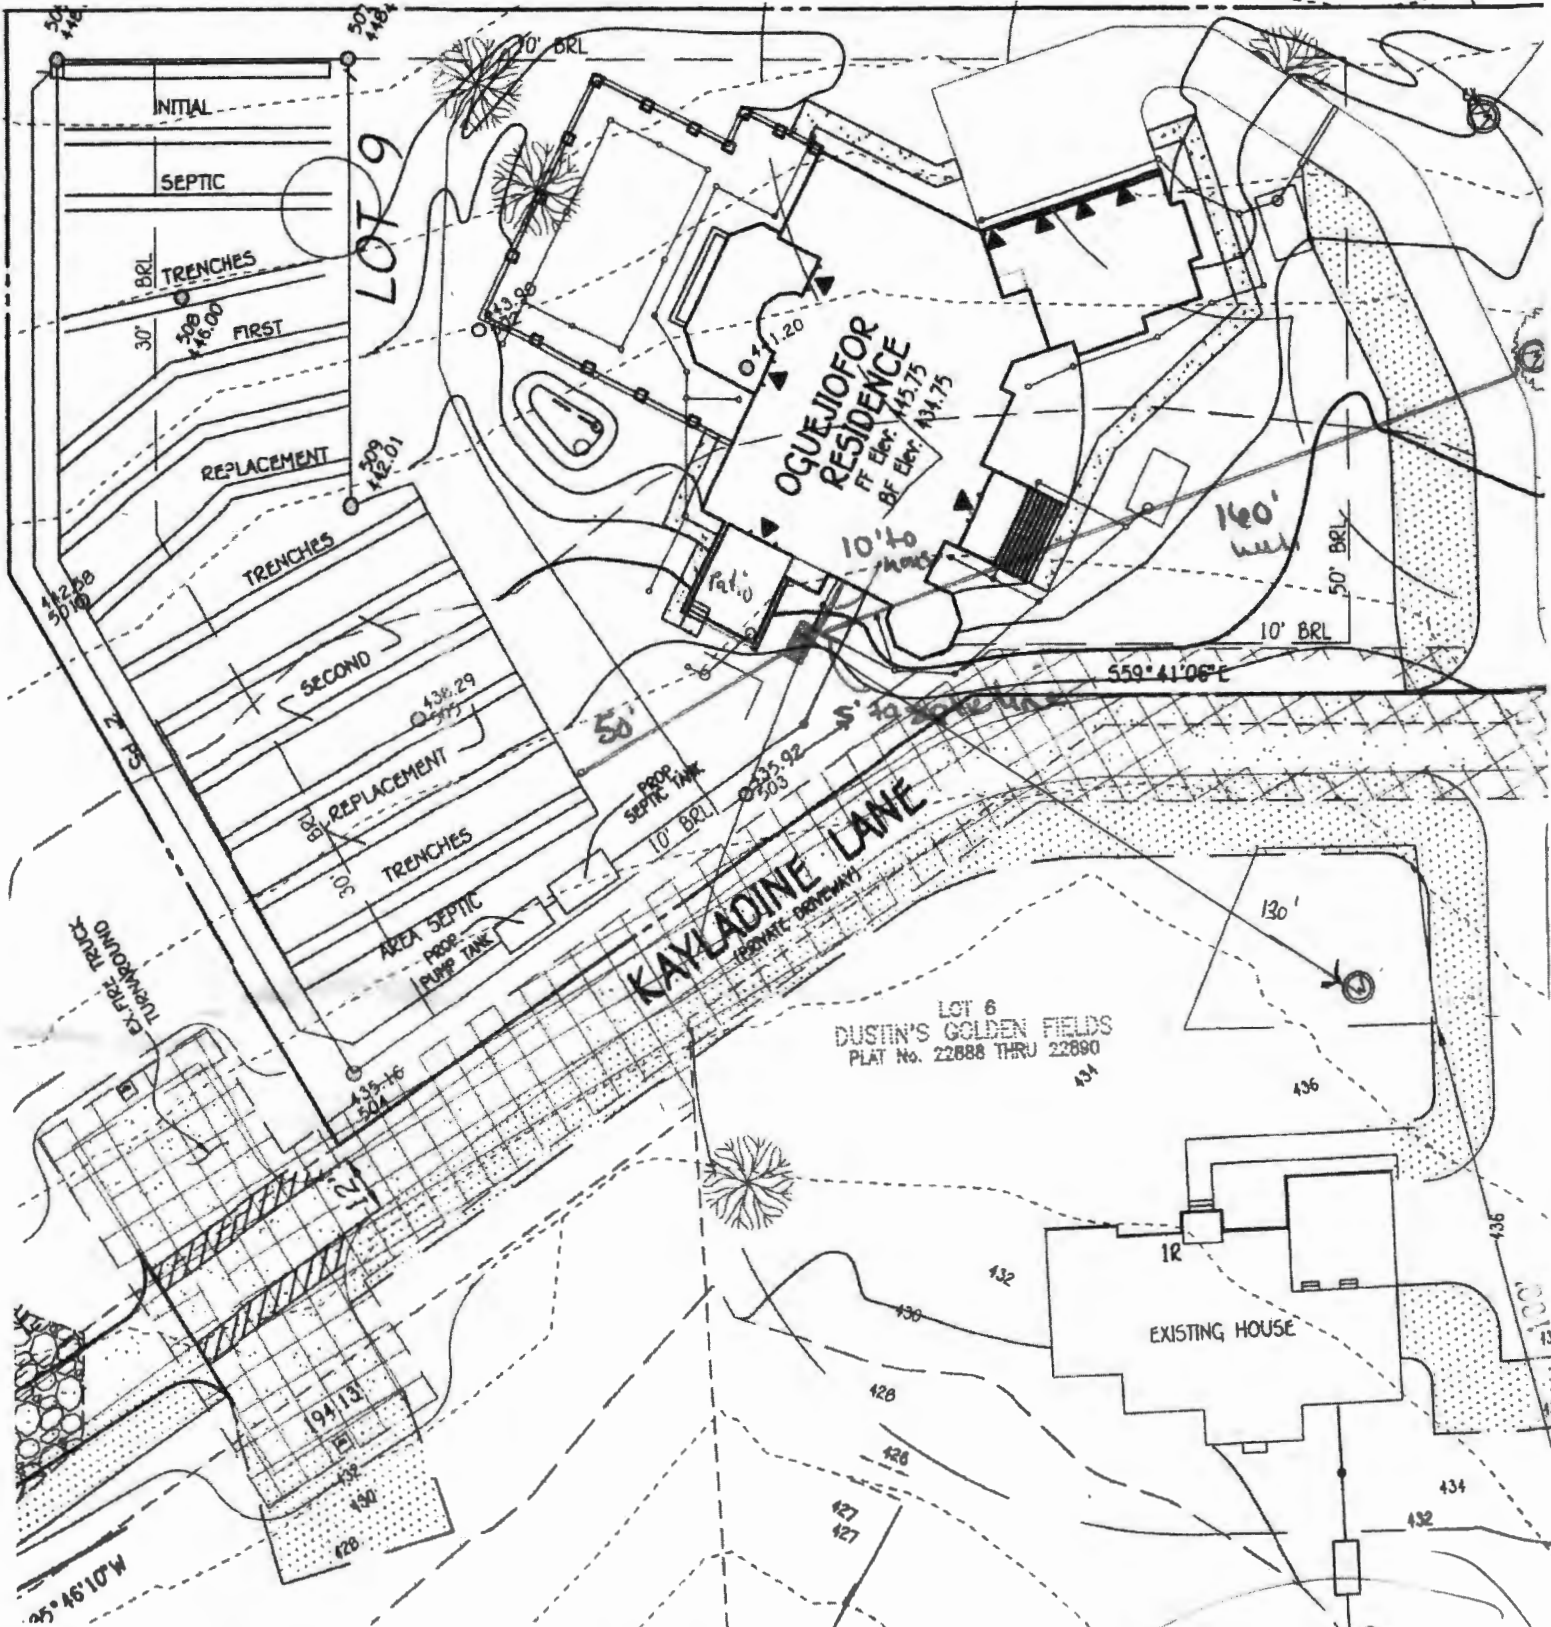

Scale
1-40

* 250 gal UG Propene tank
10' from house
5' from septic line

Approved - 6 LP tanks
B 24 001109
RTH 4/2/24

8030 Kayladine Ave

PLAN
SCALE: 1" = 30'

TRENCH DATA

