



Bureau of Environmental Health
 8930 Stanford Blvd | Columbia, MD 21045
 410.313.2640 - Voice/Relay
 410.313.2648 - Fax
 1.866.313.6300 - Toll Free

Maura J. Rossman, M.D., Health Officer

**APPLICATION
 FOR PERCOLATION TESTING AND SITE EVALUATION**

PROPERTY LOCATION

SUBDIVISION/PROPERTY NAME _____

PROPERTY ADDRESS 2726 Jennings Chapel Rd Woodbine 21797
STREET TOWN ZIP

TAX ACCOUNT # 04-360028 TAX MAP 13 GRID 15 PARCEL 43 LOT NO. _____ PROPOSED LOT SIZE (ACRES) _____

ZONING CATEGORY _____ TIER _____

PROPERTY OWNER(S) Helio & Cibelly Ribeiro - POC is Crystiano Bastian (Contractor)

DAYTIME PHONE 240-671-5133 CELL _____ EMAIL ccgeneralservices@gmail.com

MAILING ADDRESS same as property address
STREET CITY, STATE ZIP

APPLICANT Fogle's Septic Clean, Inc. RELATIONSHIP TO OWNER: Septic Contractor

DAYTIME PHONE 410-795-5670 CELL _____ EMAIL john@foglesinc.com

MAILING ADDRESS 580 Obrecht Rd Sykesville, MD 21784
STREET CITY, STATE ZIP

I HEREBY APPLY FOR THE NECESSARY TESTING/EVALUATION PRIOR TO ISSUANCE OF SEWAGE DISPOSAL SYSTEM PERMIT(S):

PROPERTY:

- SUBDIVISION: NUMBER OF LOTS INCLUDING RESIDUE: _____
SUBDIVISION CLASSIFICATION (PER DEPT. OF PLANNING AND ZONING) MAJOR MINOR
- CONSTRUCT NEW OSDS ON UNDEVELOPED LOT
- REPAIR OR REPLACE FAILING OSDS
- UPGRADE EXISTING OSDS

BUILDING:

- RESIDENTIAL WITH 3 **EXISTING** OR PROPOSED BEDROOMS IN THE COMPLETED STRUCTURE
- COMMERCIAL (PROVIDE DETAIL OF TYPE OF USE AND NUMBERS OF EMPLOYEES/CUSTOMERS ON ACCOMPANYING PLAN)

IS THE PROPERTY WITHIN 2500 FEET OF ANY RESERVOIR?

- YES
- NO




AS APPLICANT, I UNDERSTAND THE FOLLOWING:

- THIS APPLICATION IS VALID FOR TWO(2) YEARS FROM DATE OF FEE PAYMENT AND APPROVAL IS BASED UPON HEALTH OFFICER SIGNATURE OF A PERC CERTIFICATION PLAN PRIOR TO EXPIRATION OF THIS PERMIT.
- THE APPLICATION FEE IS NON-REFUNDABLE
- THIS APPLICATION MUST BE ACCOMPANIED BY ALL APPLICABLE FEES AND A SUITABLE SITE PLAN IN ORDER TO BE PROCESSED
- THIS IS A PUBLIC DOCUMENT

I declare and affirm that to the best of my knowledge, the information contained herein is correct. I declare that I am the owner of the property or duly authorized to make this application on behalf of the owner. I agree to comply with all applicable state and county regulations.

By signature of this application, I hereby grant Howard County Health Department officials the right to enter onto the property for the purpose of inspecting the property as directly related to the requested permit/service.

 SIGNATURE OF APPLICANT 5/15/2024
DATE

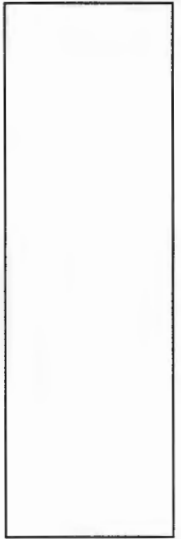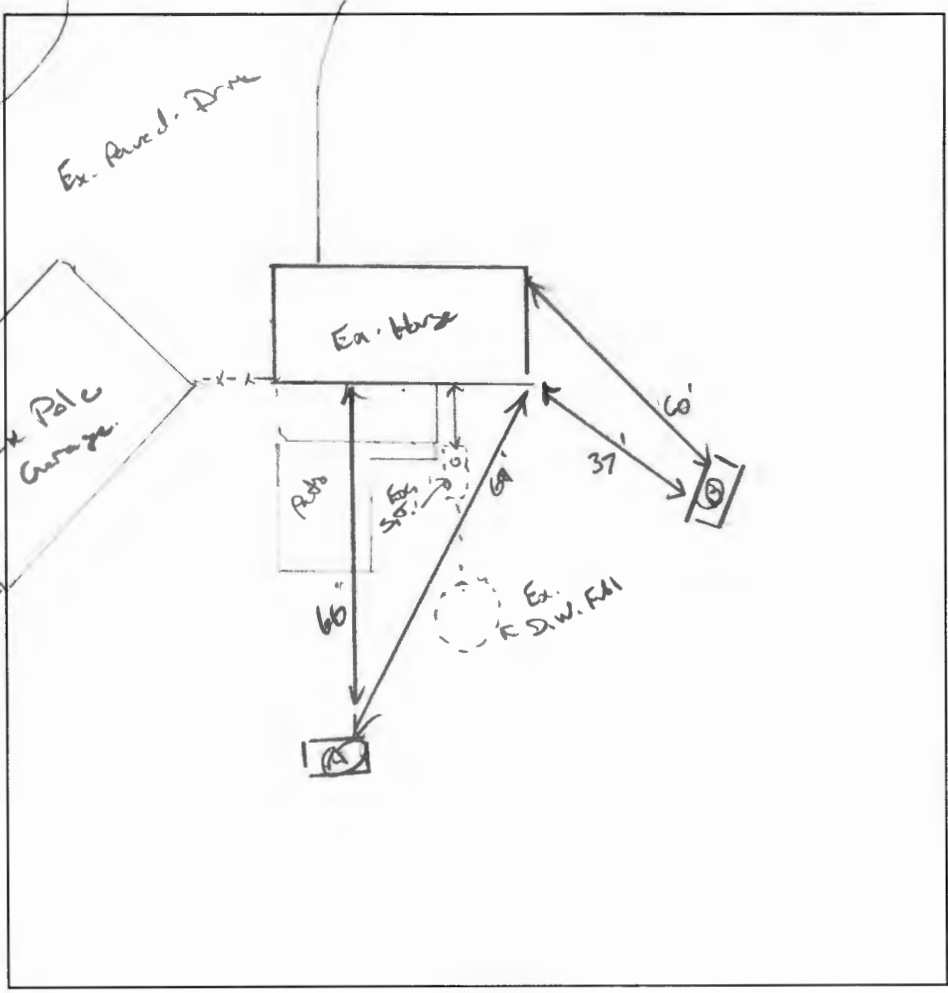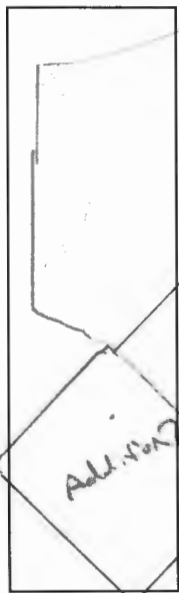

(A)
 1' br cl
 wk copl
 Fruble
 library L.
 wk copl.
 Fruble, w
 chimney roots.
 4'
 1' br cl
 wk copl.
 Fruble, cw
 15' to 20'
 to wk Sprink
 measure
 7'
 library sl
 wk copl
 Fruble

DATE	TEST #	DEPTH	START	BREAK 1" DROP	STOP 2" DROP	TIME OF 2ND INCH	P/F/H
5/22/2011	(A)	4 1/2" 14' 0"	00:02	00:36	00:11	5	P
		H ₂ O poured @ 14'				≈ 7mp	P
	(B)	visual				OK	P



REMARKS over material plus to build 2nd story on ex hbrz
Edge Driveway full. No surface discharge
 SANITARIAN K. Wolf BACKHOE Mike (Hoped Fogel) OTHERS owner
 TEST HOLES USED IN SDA 2 AVG. PERC TIME _____ SQ. FT/BR _____
 TRENCH WIDTH 2 INLET DEPTH 3' MAX. BOT DEPTH 7 EFFECTIVE SW 4.4

$5.44 = \frac{250}{1.2}$, $625 \div 2 = 312.5$, $6.44 = 139$

Wolf, Kevin

From: Wolf, Kevin
Sent: Tuesday, April 8, 2025 12:16 PM
To: Jeff Palmer (jeff@foglesinc.com)
Cc: john@foglesinc.com
Subject: 2726 Jennings Chapel Road | design plan

Jeff,
Comments on this plan need to be addressed, resubmit a revised plan with the corrected comments below:

1. Make the trenches look like trenches and not lines
2. Label 'proposed tank, proposed trenches', etc.
3. This site plan is not accurate, theres an addition that comes off the back of the detached garage that is not shown on the plan. The owner indicated plumbing coming from this addition while we were onsite.
4. The owner commented 4 existing bedrooms not 3 and he wanted us to size the system for 5 bedrooms. Please confirm.
5. Need a plan title
6. Need "plan prepared by..."

Thanks,

Kevin M. Wolf, LEHS, REHS/RS
Groundwater Mgmt. Sec. Supervisor
Well & Septic Program
Howard County Health Department
8930 Stanford Blvd.
Columbia, MD 21045
410-313-2645 (Office)
410-313-2648 (Fax)
www.hchealth.org



kwolf@howardcountymd.gov

CONFIDENTIALITY NOTICE

This message and the accompanying documents are intended only for the use of the individual or entity to which they are addressed and may contain information that is privileged, confidential, or exempt from disclosure under applicable law. If the reader of this email is not the intended recipient, you are hereby notified that you are strictly prohibited from reading, disseminating, distributing, or copying this communication. If you have received this email in error, please notify the sender immediately and destroy the original transmission.