

OK (MB)  
 6/17/2024

\*\*\*\*\*  
 WATER WELL ABANDONMENT-SEALING REPORT FORM  
 \*\*\*\*\*

SUBMIT COPIES OF COMPLETED FORM TO:

- \* COUNTY ENVIRONMENTAL AGENCY (contact MDE, WMA if address needed)
- \* WELL OWNER
- \* MDE, WATER MANAGEMENT ADMINISTRATION, WELL PROGRAM

DATE WELL ABANDONED: 2/8/2024 (month/day/year)

\* PERMIT NUMBER OF ABANDONED WELL (if any) \_\_\_\_\_

\* PERMIT NUMBER OF REPLACEMENT WELL: \_\_\_\_\_


\* PERSON ABANDONING WELL: JOHN HESS WELL DRILLER'S LICENSE NUMBER: 553

CIRCLE: MWD / MSD / MGD

\* OWNER'S NAME: ~~HESS~~ STEWART WADSWORTH

SITE LOCATION MAP

\* WELL LOCATION:  
 COUNTY: HOWARD  
 NEAREST TOWN: ELK RIDGE  
 TAX MAP        BLOCK        PARCEL         
 SUBDIVISION: \_\_\_\_\_  
 SECTION: \_\_\_\_\_ LOT: \_\_\_\_\_  
 STREET ADDRESS: 5025 LANDING ROAD

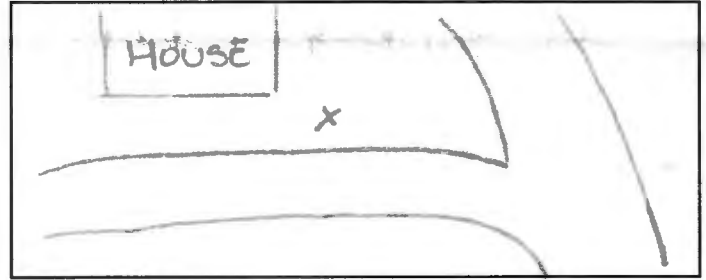

LATITUDE 39.233236

LONGITUDE 76.764576

LOG OF SEALING MATERIAL

MATERIAL	FEET	
	FROM	TO
BENTONITE	27	0
VOLUME OF MATERIAL USED		
<u>40.5 GALLONS</u>		

\* TYPE OF WELL BEING ABANDONED:  
 DRILLED \_\_\_\_\_ JETTED \_\_\_\_\_  
 BORED \_\_\_\_\_ HAND DUG \_\_\_\_\_  
 OTHER (specify) \_\_\_\_\_

\* USE CODE:  
 DOMESTIC \_\_\_\_\_ MUNICIPAL/PUBLIC \_\_\_\_\_  
 IRRIGATION \_\_\_\_\_ INDUSTRIAL \_\_\_\_\_  
 TEST/OBSERVATION \_\_\_\_\_ GEOTHERMAL \_\_\_\_\_

\* TYPE OF CASING:  
 STEEL \_\_\_\_\_ PLASTIC \_\_\_\_\_  
 CONCRETE \_\_\_\_\_ OTHER (specify) \_\_\_\_\_

SIZE OF CASING: 6 INCHES IN DIAMETER

DEPTH OF WELL: 27 FEET DEEP

WAS ANY CASING REMOVED?  YES \_\_\_\_\_ NO \_\_\_\_\_  
 If yes, length removed, in feet: 2 FT

WAS CASING RIPPED OR PERFORATED? \_\_\_\_\_ YES  NO

John Hess  
 SIGNATURE-MASTER WELL DRILLER OR SUPERVISING SANITARIAN LICENSE# 553

MWD / MSD / MGS

CIRCLE ONE

3/7/24  
 DATE

COUNTY

