

Maura J. Rossman, M.D., Health Officer

INFORMATION FORM - SEPTIC SYSTEM REPAIR/UPGRADE

Reason for Request:

- Failing System
- System relocation for proposed addition
- System upgrade for proposed addition
- Inadequate treatment zone
- Collapsed septic tank
- Collapsed drywell

Existing system design

- Drywell
- Trench
- Mound
- Unknown
- Other: _____

Is discharge surfacing on the ground?

- Yes
- No

Additional Comments:

Tank overfull (homeowner called for emergency pumping). Snaked outlet line and dug up d-box, no relief, trenches taking water.

Has the septic tank been pumped within the last month?

- Yes Date pumped: 5/1/23
- No

Was a visual inspection of the septic tank and/or drain fields conducted?

- Yes Explain observation: _____
- No

Was a visual inspection of the sewage line conducted?

- Yes
- No

Blockage Leading to the field

- Yes Explain _____
- No

*For REPAIRS, are the owners proposing, or do they plan to add in the future any additions or modifications to the property, i.e. pools, living space additions, garages, etc? This information must be disclosed at the time of this application. The Health Department will not be able to accommodate requests in the field for property modifications unrelated to the repair request. Such requests may require an additional fee, testing, and submittal of a Percolation Certification Plan, if the property does not meet current Code and Regulations.

Septic Contractor: Fogle's Septic Clean, Inc. Contractor's Phone: 410-795-5670

Contractor's Address: 580 Obrecht Rd Sykesville, MD 21784

Property Address: 3140 Longfield Rd County File: 04-349288

Subdivision: Wellington Lot: 6 Year Built: 2000

Owner's Name: Raymond Henry Existing bedrooms: 5

Name of previous owners: _____ Existing bedrooms: _____

Proposed bedrooms: _____

*A Sanitarian will be in contact within three business days, depending upon the urgency of the situation, to coordinate the scheduling/review of the repair or upgrade.

Prior to scheduling inspections, scaled plans should be submitted to clarify the nature of the addition.

Print out a copy of Real Property Data via Dept. of Taxation website _____ Indexed file found _____

If soil/site conditions are limited and sewer and/or Metro District status is not conducive to connection, the Sanitarian may recommend pursuit of Emergency Sewer Extension or Emergency Metro District Inclusion. The Owner should contact the Bureau of Utilities for details.

No permit is to be issued nor inspection to be scheduled without prior fee collection at the office unless an emergency exists.

The contractor is to notify the office of the emergency as soon as possible.

2/2020

4/15/00
2-3pm
INDEXED

PERMIT

SEWAGE DISPOSAL SYSTEM

DEPARTMENT OF HEALTH AND MENTAL HYGIENE

04-349288

P 513318

A 511111

DISTRICT _____

DATE 3/15/2000

HOWARD COUNTY HEALTH DEPARTMENT
BUREAU OF ENVIRONMENTAL HEALTH
~~XXXXXXXX~~ 410-313-2640

DATE SYSTEM APPROVED 4/1/00

INSPECTOR M. Riffin

Jack Fyock Septic Service Service IS PERMITTED TO INSTALL ALTER _____

ADDRESS P.O. Box 89, Glenelg, MD 21737 PHONE 410-988-9270

SUBDIVISION Wellington LOT 6 ROAD 3140 Longfield Road

PROPERTY OWNER Rosemark Custom Home

ADDRESS _____

SEPTIC TANK CAPACITY 1000 GALLONS

NUMBER OF BEDROOMS 3

180 SQUARE FEET PER BEDROOM

LINEAR FEET OF TRENCH REQUIRED 135

TRENCHES - Trench to be 2 feet wide. Inlet 4 feet below original grade. Bottom maximum depth 8 feet below original grade. Effective area begins at 4 feet below original grade. 4 feet of stone below distribution pipe.

LOCATION - From the intersection of the 355' and the 755.88' lot lines, place the distribution box 225 feet down the 755.88' lot line and 110 feet off that same lot line. Run trenches along contour in both directions.

NOTES - No trench to exceed 100 feet in length. Provide 6" - 8" diameter cleanout and cap to grade or above on septic tank. 6/10/99 OK ALM

PLANS APPROVED BY Donna K. Soe DATE 5-20-1999

COVER NO WORK UNTIL INSPECTED AND APPROVED

NEITHER THE HOWARD COUNTY COUNCIL NOR THE HEALTH DEPARTMENT IS RESPONSIBLE FOR THE SUCCESSFUL OPERATION OF ANY SYSTEM

NOTE: CLEANOUT REQUIRED EVERY 70 FEET OF SEWER LINE AND/OR AT 90° SWEEPS IN LINES FROM HOUSE TO DRAIN FIELDS. 90° ELBOWS NOT ACCEPTABLE.

NOTE: ALL PARTS OF SEPTIC SYSTEMS (I.E. TANK, DISTRIBUTION BOX TRENCHES) TO BE 100 FEET FROM WELL (UNLESS OTHERWISE SPECIFICALLY AUTHORIZED)

NOTE: IF DEEP TRENCH(ES) ARE USED CALL FOR INSPECTION BEFORE AND AFTER PLACING GRAVEL IN TRENCH(ES)

NOTE: NO DRY WELL SHALL EXCEED 15 FOOT IN DIAMETER NO ABSORPTION TRENCH TO EXCEED 100 FEET IN LENGTH

NOTE: ALL PIPE FROM HOUSE TO SEPTIC TANK MUST BE CAST IRON OR SCHEDULE 35/40 PVC OR A23

PERMIT VOID AFTER TWO YEARS

NOTE: INSTALL STAND PIPE ON SEPTIC TANK AND DRY WELL STAND PIPES MUST BE 6 INCHES IN DIAMETER CAST IRON. CONCRETE OR TERRA COTTA OR PVA OR A33 ACCEPTED. IF TOP OF SEPTIC TANK IS DEEPER THAN 3 FEET. MANHOLE TO GRADE REQUIRED.


NOTE: DISTRIBUTION BOXES MUST HAVE BAFFLES

*INSTALLER IS RESPONSIBLE FOR OBTAINING FINAL APPROVAL ON THIS PERMIT

*CALL 461-9933 FOR INSPECTION OF SEPTIC SYSTEM.

BLDG. PERMITS ~~5/19/00~~
AND RETURNED 5/19/00
B00123903 Propane Tank

51111

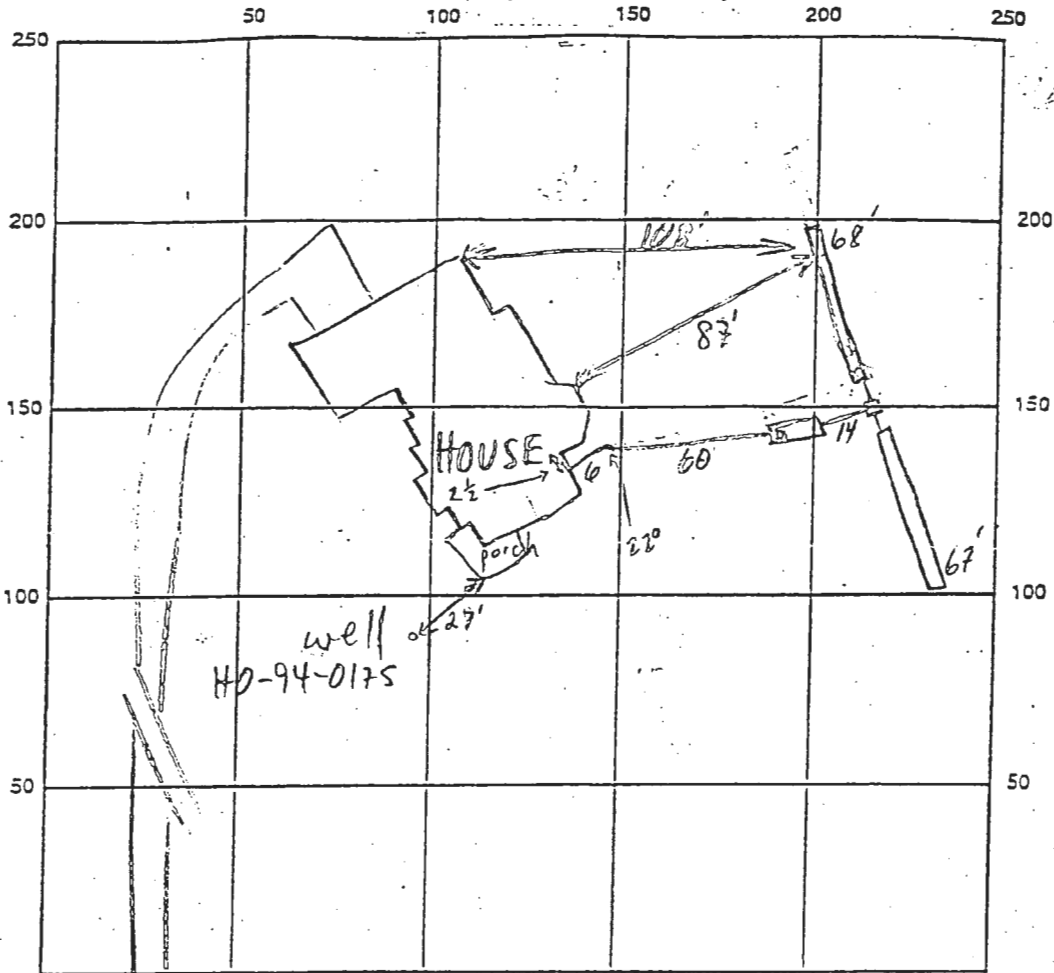

LONGFIELD RD

INDICATE NORTH - NAME ADJOINING ROADWAY AS BASE LINE

SEPTIC TANK LEVEL 1000 GAL - MID SEAM CLEANOUTS S.T. - OK

DISTRIBUTION BOX LEVEL OK - BAFFLE IN

DRAIN FIELD/TITLE DEPTH 8 FT. TRENCH WIDTH 2 FT. INLET DEPTH 4 FT.

EFFECTIVE GRAVEL DEPTH 4 FT. TOTAL LENGTH 135 FT.


NUMBER OF TRENCHES 2 ONE SIDEWALL/BOTTOM AREA 540 SQ. FT.

DRYWALL INSIDE DIAMETER — FT. EFFECTIVE DEPTH BELOW INLET — FT.

ABSORBENT AREA — SQ. FT.

REMARKS: 4/11/00 OK TO FINISH & COVER (MR)

DATE SYSTEM APPROVED 4/11/00 INSPECTOR M. R. P. Kin

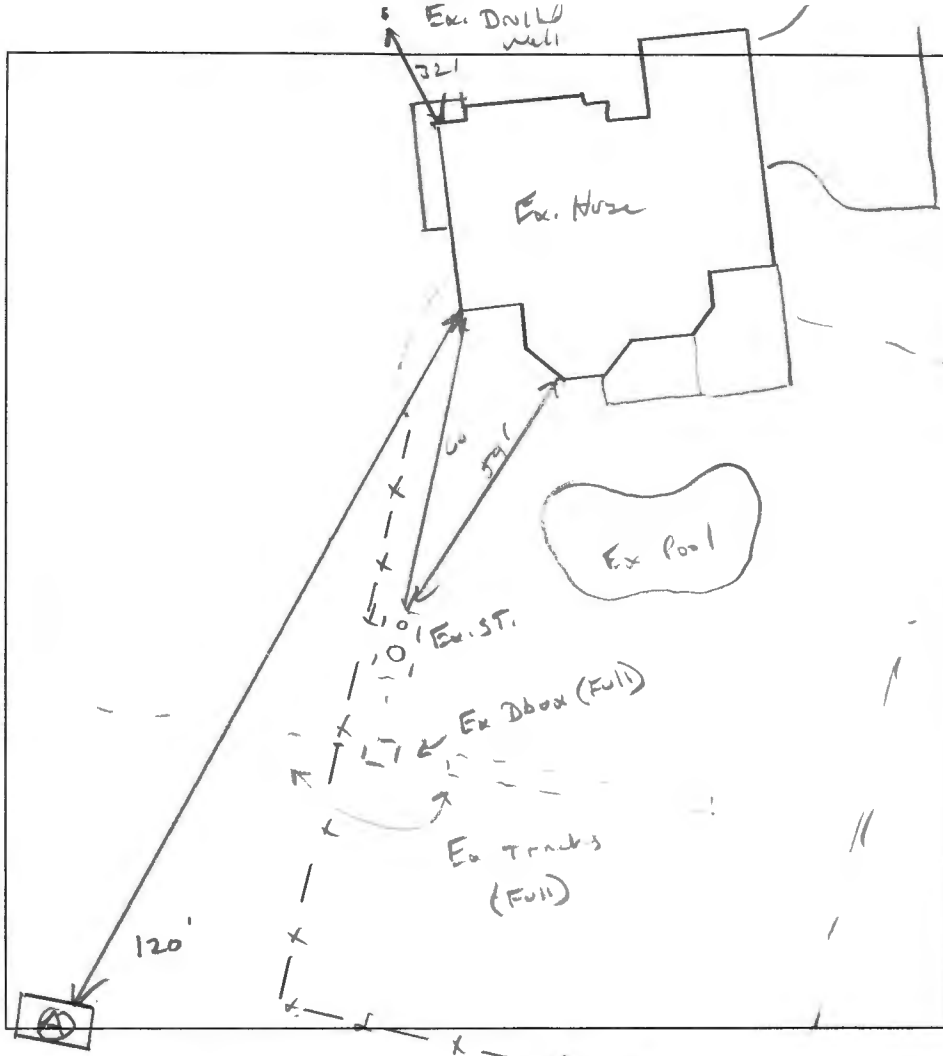

(A)

2' Dk Red CL
2msBK
CW, roots

4' Br L
wk Co SBK
Frable, roots
CW m... ..

6' 1 Br/Y SL
wk Co PL
Frable
nic... ..

9' Br/Y SL

15' wk FpL
Frable
light m... ..

DATE	TEST #	DEPTH	START	BREAK 1" DROP	STOP 2" DROP	TIME OF 2ND INCH	P/F/H
	(A)	6' 15'	00:43	00:46	00:51	5	P
		H ₂ O	found	e	15'	Supi	P

REMARKS _____

SANITARIAN K. Wolf BACKHOE Chris = Foglis OTHERS arris


TEST HOLES USED IN SDA 1 AVG. PERC TIME 5 SQ. FT/BR 12

TRENCH WIDTH 2 INLET DEPTH 3 MAX. BOT DEPTH 9 EFFECTIVE SW 5' (-30)

$$5 \times \frac{7.0}{1.2} = 29.17 \approx 29.2 \div 2 = 14.6 \text{ (30)} = 112.5 \text{ (2x60)}$$

HENRY RESIDENCE

3140 LONGFIELD ROAD GLENWOOD MD 21738

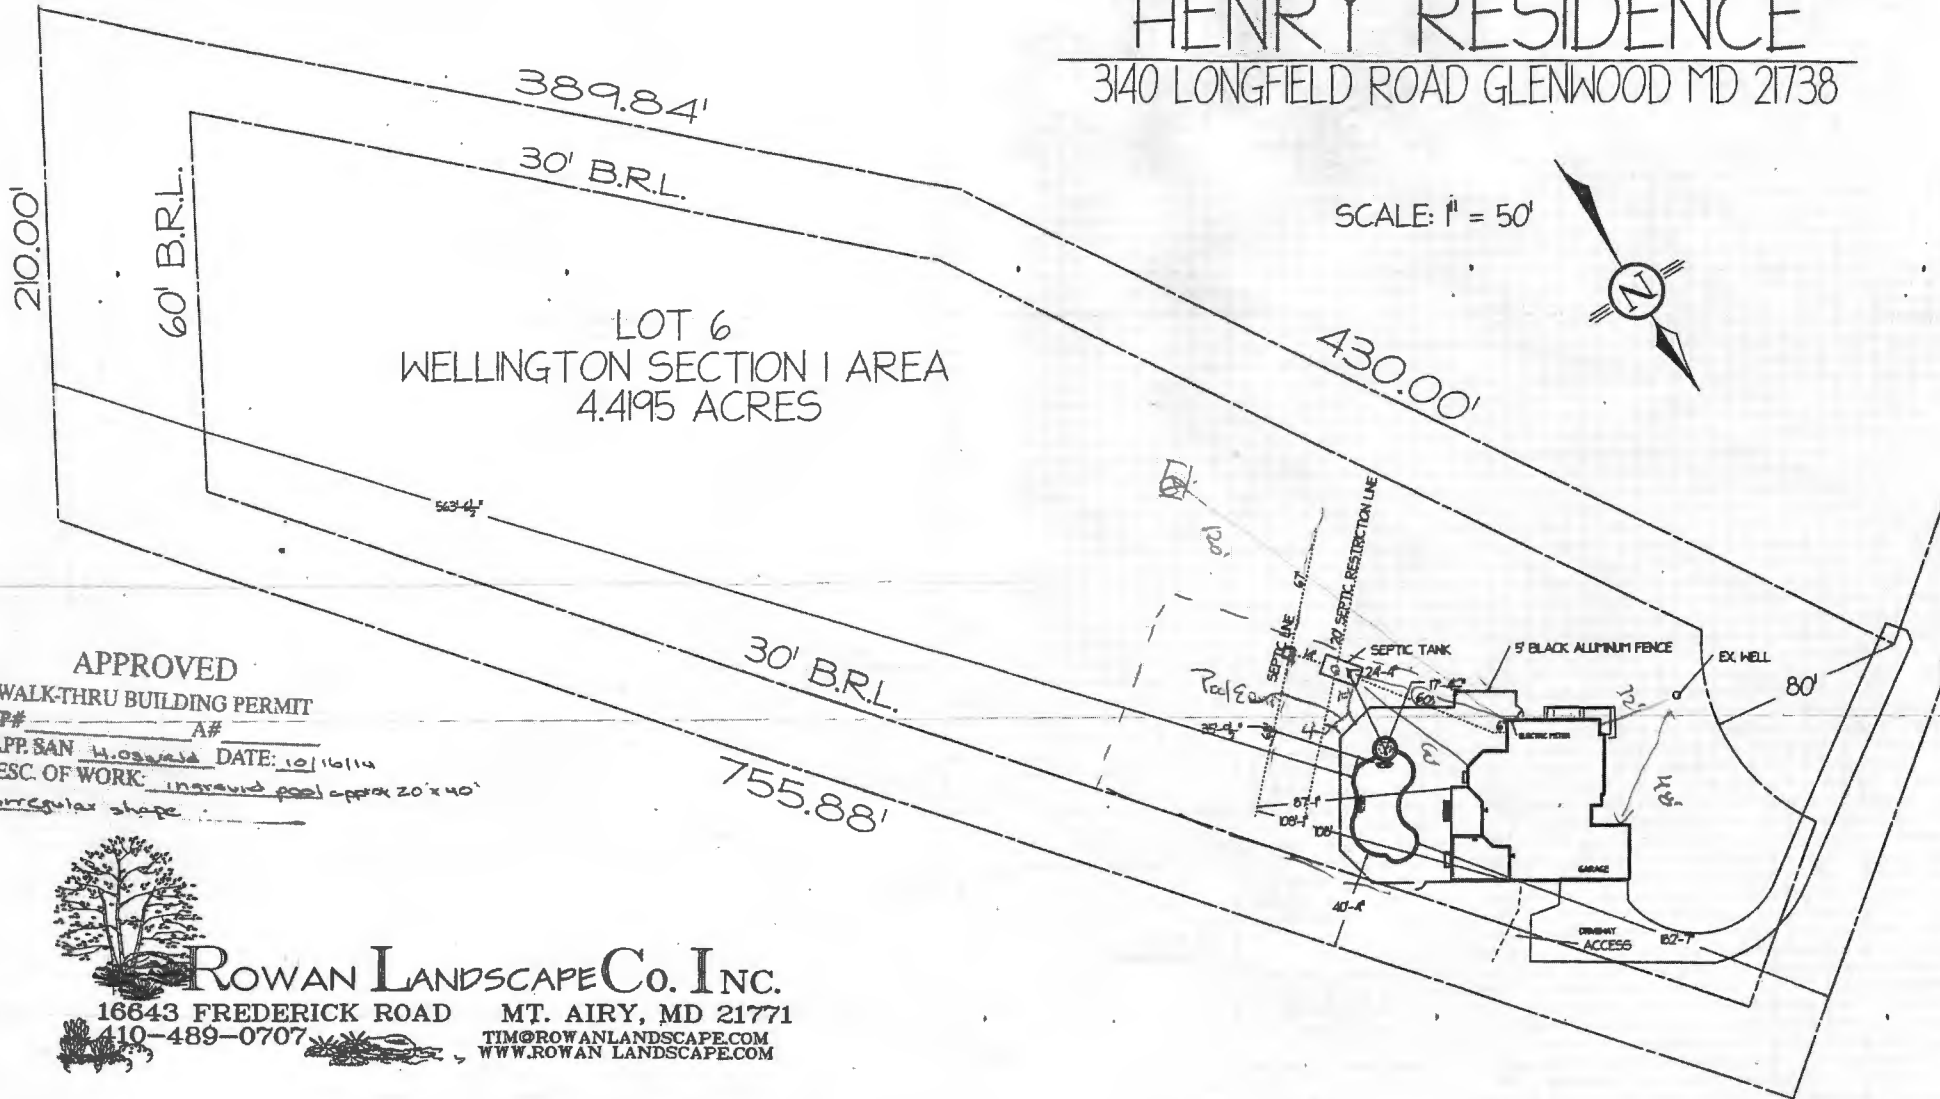

APPROVED
 WALK-THRU BUILDING PERMIT
 BP# _____ A# _____
 APP. SAN H. Oswald DATE: 10/16/14
 DESC. OF WORK: in-ground pool approx 20' x 40'
 irregular shape



ROWAN LANDSCAPE Co. INC.
 16843 FREDERICK ROAD MT. AIRY, MD 21771
 410-489-0707 TIM@ROWANLANDSCAPE.COM
 WWW.ROWANLANDSCAPE.COM

Real Property Data Search ()
 Search Result for HOWARD COUNTY

[View Map](#) [View GroundRent Redemption](#) [View GroundRent Registration](#)

Special Tax Recapture: None

Account Identifier: District - 04 Account Number - 349288

Owner Information

Owner Name: HENRY RAYMOND Use: RESIDENTIAL
 HENRY KIMBERLY Principal Residence: YES
 Mailing Address: 3240 LONGFIELD RD Deed Reference: /09122/ 00506
 GLENWOOD MD 21738-9702

Location & Structure Information

Premises Address: 3140 LONGFIELD RD Legal Description: LOT 6 4.4195 A
 GLENWOOD 21738-0000 3140 LONGFIELD RD
 WELLINGTON SEC 1 AREA 1

Map: Grid: Parcel: Neighborhood: Subdivision: Section: Block: Lot: Assessment Year: Plat No: 8945
 0014 0021 0239 4010103.14 1309 6 2023 Plat Ref:

Town: None

Primary Structure Built Above Grade Living Area Finished Basement Area Property Land Area County Use
 2000 5,476 SF 1800 SF 4.4100 AC

StoriesBasementType ExteriorQualityFull/Half BathGarage Last Notice of Major Improvements
 2 YES STANDARD UNITSIDING/6 5 full/ 1 half 1 Attached

Value Information

	Base Value	Value	Phase-in Assessments	
			As of 01/01/2023	As of 07/01/2022
Land:	275,500	326,700		As of 07/01/2023
Improvements	817,600	1,099,800		
Total:	1,093,100	1,426,500	1,093,100	1,204,233
Preferential Land:	0	0		

Transfer Information

Seller: WALKER STEVE Date: 04/21/2005 Price: \$1,250,000
 Type: ARMS LENGTH IMPROVED Deed1: /09122/ 00506 Deed2:
 Seller: MTR CUSTOM HOMES LLC Date: 01/28/2000 Price: \$125,000
 Type: ARMS LENGTH VACANT Deed1: /05001/ 00637 Deed2:
 Seller: GLENWOOD ASSOCIATES LLC Date: 03/02/1999 Price: \$125,000
 Type: ARMS LENGTH VACANT Deed1: /04637/ 00072 Deed2:

Exemption Information

Partial Exempt Assessments: Class 07/01/2022 07/01/2023
 County: 000 0.00
 State: 000 0.00
 Municipal: 000 0.00|0.00 0.00|0.00

Special Tax Recapture: None

Homestead Application Information

Homestead Application Status: Approved 02/25/2011

Homeowners' Tax Credit Application Information

Homeowners' Tax Credit Application Status: No Application Date:



RECEIPT

Howard County, MD
HOWARD COUNTY HEALTH DEPARTMENT
ASCEND ONE BUILDING
Columbia, MD 21045
8930 STANFORD BLVD

Application: WS-SP-APP-23-00104
Application Type: EnvHealth/Well and Septic/Sewage Disposal System/Application
Address: 3140 Longfield RD,

Receipt No.	Ref Number	Amount Paid	Payment Date	Cashier ID	Received	Comments
6659	78822	\$165.00	05/09/2023	JUKING		Receipt # 74116

Work Description: Septic Repair/ 3140 Longfield Rd

RECEIPT

Howard County, MD
HOWARD COUNTY HEALTH DEPARTMENT
ASCEND ONE BUILDING
Columbia, MD 21045
8930 STANFORD BLVD

Application: WS-PT-23-01163
Application Type: EnvHealth/Well and Septic/Percolation Test/Application
Address: 3140 Longfield RD,

Receipt No.	6658					
Payment Method	Ref Number	Amount Paid	Payment Date	Cashier ID	Received	Comments
Check	78822	\$165.00	05/09/2023	JUKING		Receipt # 74116
Work Description:	Perc Repair/ 3140 Longfield Rd					