

Doc 5/23

Name of Requestor: Hong Tao Ma  
Street Address: 4268 Maisel Farm Ln  
City, State, Zip: Ellicott City MD 21042  
Date: 5/6/24

Approved R/K  
5/24/2024

Amendment, Permit # B 22004576

Ms. Debbie Whalen  
Division of Plan Review  
Department of Inspections, Licenses and Permits  
Howard County Government  
3430 Court House Dr  
Ellicott City, MD 21043

Dear Ms. Whalen:

I am requesting to amend Permit # B 22004576 at  
4268 Maisel Farm Ln Ellicott City MD 21042 to

(Site Address)

Remove a full Bush to show a half Bath

Enclosed:

Fee: \$25 → Check # 1531  
Plot Plans  
Sets of Construction Drawings  
Other:


If there is anything we can do to assist you, please let me know.

Sincerely,

2024 MAY 11 PM 12:25

Name: Hong Tao Ma  
Title: Owner  
Phone and/or Email: 410 493 4950 htma963@yahoo.com

First floor  
Existing

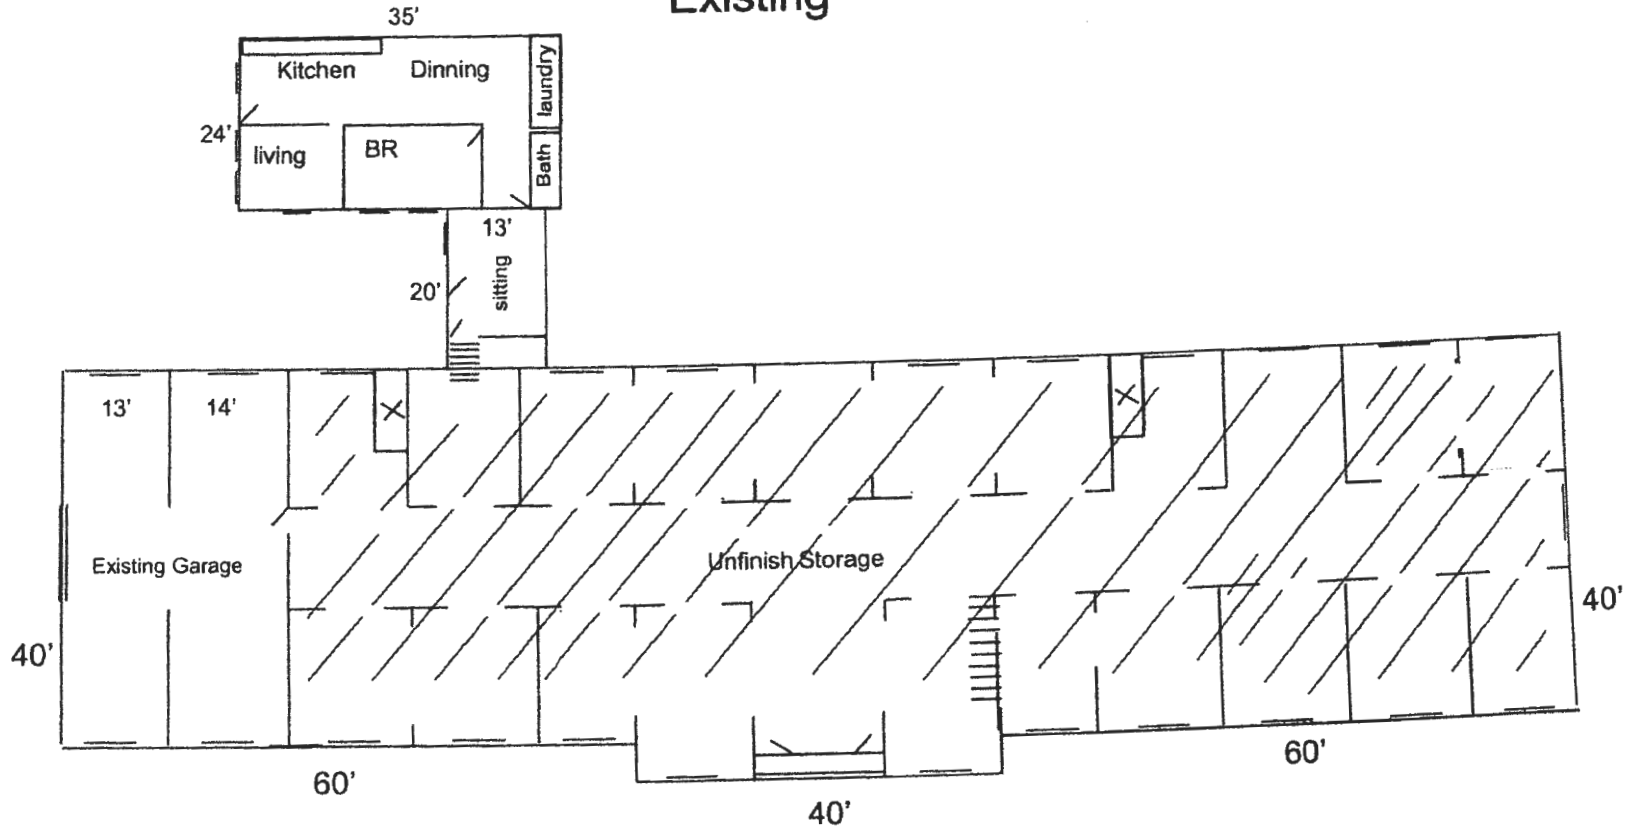


Total Finished: 1100 sq ft

4268 Maisel Farm Lane  
Ma's property

# First floor Proposed

01/11/2022 THUR 6 PM 12:50

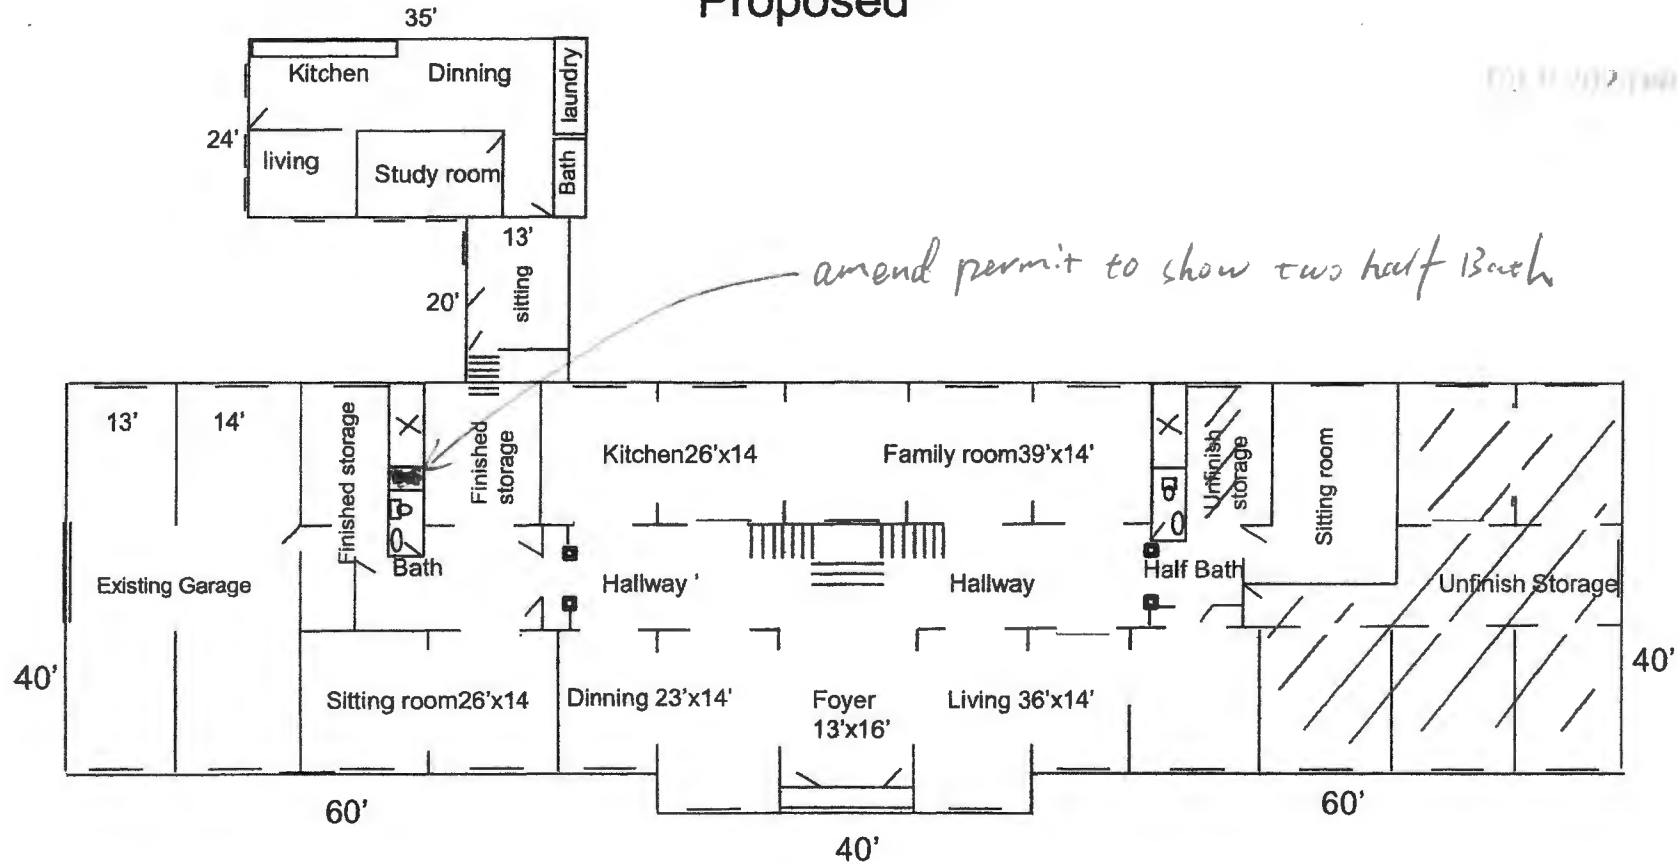

*amend permit to show two half Bath*

Total new finishing: 3856 sq ft  
 Note: Two stoves are in the dwelling

4268 Maisel Farm Lane  
 Ma's property