

ASAP
4/15/88

PERMIT

SEWAGE DISPOSAL SYSTEM

MARYLAND STATE DEPARTMENT OF HEALTH

P 41877

A REPAIR

DISTRICT _____

DATE 4/6/88

HOWARD COUNTY
BUREAU OF ENVIRONMENTAL HEALTH
461-9933

05-358922

DATE SYSTEM APPROVED _____

INSPECTOR _____

INDEXED

_____ Jack Fuock _____ IS PERMITTED TO INSTALL _____ ALTER X

ADDRESS _____ PHONE 988-9270

SUBDIVISION _____ ROAD 4675 Linthicum Road LOT _____

PROPERTY OWNER Peter Margelos
4675 Linthicum Road

ADDRESS _____

IF GARBAGE GRINDER IS USED INCREASE SEPTIC TANK CAPACITY BY 50% AND ABSORPTION AREA BY 22%.

GARBAGE GRINDER? YES _____ NO X

2982

SEPTIC TANK CAPACITY 1000 GALLONS NUMBER OF BEDROOMS 3

~~REPAIR - CALL FOR INSPECTION WHEN GROUND IS OPENED UP SO SANITARIAN CAN RECOMMEND REPAIR.~~

BUILDING PERMIT SIGNED AND RETURNED

5603 BOD 141099 - GARAGE
7705 BOD 15473 - RADIO TOWER

PLANS APPROVED BY C. Williams DATE 4/04/88

COVER NO WORK UNTIL INSPECTED AND APPROVED.

NEITHER THE HOWARD COUNTY COUNCIL NOR THE HEALTH DEPARTMENT IS RESPONSIBLE FOR THE SUCCESSFUL OPERATION OF ANY SYSTEM.

NOTE: CLEANOUT REQUIRED EVERY 70 FEET OF SEWER LINE AND/OR AT 90° SWEEPS IN LINES FROM HOUSE TO DRAIN FIELDS.

NOTE: ALL PARTS OF SEPTIC SYSTEMS (I.E., TANK, DISTRIBUTION BOX, TRENCHES) TO BE 100 FEET FROM WELL. (UNLESS OTHERWISE SPECIFICALLY AUTHORIZED)

NOTE: IF DEEP TRENCH(ES) ARE USED CALL FOR INSPECTION BEFORE AND AFTER PLACING GRAVEL IN TRENCH(ES).

NOTE: NO DRY WELL SHALL EXCEED 15 FOOT IN DIAMETER. NO ABSORPTION TRENCH TO EXCEED 100 FEET IN LENGTH.

NOTE: ALL PIPE FROM HOUSE TO SEPTIC TANK MUST BE CAST IRON OR SCHEDULE 40 PVC OR ABS.

PERMIT VOID AFTER TWO YEARS.

NOTE: INSTALL STAND PIPE ON SEPTIC TANK AND DRY WELL. STAND PIPES MUST BE 6 INCHES IN DIAMETER. CAST IRON, CONCRETE OR TERRA COTTA OR PVC OR ABS ACCEPTED. IF TOP OF SEPTIC TANK IS DEEPER THAN 3 FEET, MANHOLE TO GRADE REQUIRED.


NOTE: DISTRIBUTION BOXES MUST HAVE BAFFLES.

***INSTALLER IS RESPONSIBLE FOR OBTAINING FINAL APPROVAL ON THIS PERMIT**

*CALL 461-9933 FOR INSPECTION OF SEPTIC SYSTEMS.

EH - 2-1186

41877

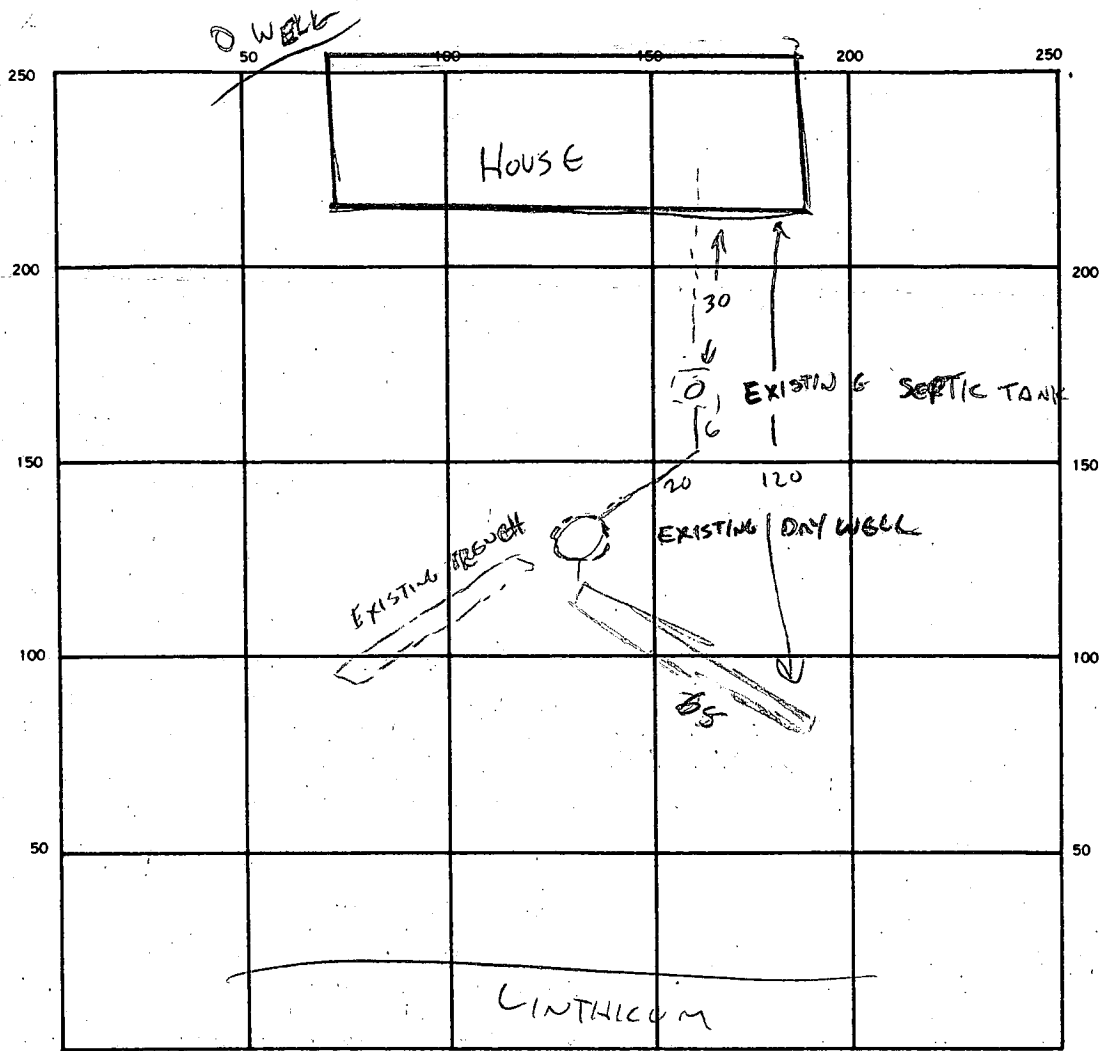

INDICATE NORTH. — NAME ADJOINING ROADWAY AS BASE LINE.

**BUILDING PERMIT SIGNED
AND RETURNED**

SEPTIC TANK LEVEL EXISTING

CLEANOUTS EXISTING

DISTRIBUTION BOX LEVEL N/A

DRAIN FIELD/TILE FIELD. DEPTH 11 FT. TRENCH WIDTH 2 FT. INLET DEPTH 5 FT.

EFFECTIVE GRAVEL DEPTH 6 FT. TOTAL LENGTH 65 FT.

NUMBER OF TRENCHES 1 ONE SIDEWALL/BOTTOM AREA 390 SQ. FT.

DRYWELL INSIDE DIAMETER _____ FT. EFFECTIVE DEPTH BELOW INLET _____ FT.

ABSORBENT AREA 390 + EXISTING SQ. FT.

REMARKS _____

4/5/88 OK TO COVER. CW

DATE SYSTEM APPROVED

4/5/88

INSPECTOR

CW

Click here for a plain text ADA compliant screen.

 Maryland Department of Assessments and Taxation HOWARD COUNTY Real Property Data Search	Go Back View Map New Search
--	---

Account Identifier: District - 05 Account Number - 358922

Owner Information

Owner Name:	MARGELOS PETER G & WF	Use:	RESIDENTIAL
		Principal Residence:	YES
Mailing Address:	4675 LINTHICUM RD DAYTON MD 21036-1003	Deed Reference:	1) / 558/ 745 2)

Location & Structure Information

Premises Address	Zoning	Legal Description
4675 LINTHICUM RD DAYTON 21036	RRDEO	5 AR 4675 LINTHICUM RD DAYTON

Map	Grid	Parcel	Sub District	Subdivision	Section	Block	Lot	Group	Plat No:
28	2	161						81	Plat Ref:

Special Tax Areas	Town Ad Valorem Tax Class	NO A/V, NO M/P, RURAL FIRE TAX
--------------------------	----------------------------------	--------------------------------

Primary Structure Built	Enclosed Area	Property Land Area	County Use
1977	1,644 SF	5.00 AC	

Stories	Basement	Type	Exterior
1	YES	STANDARD UNIT	BRICK

Value Information

	Base Value	Value As Of	Phase-in Assessments	
		01/01/2002	As Of	As Of
			07/01/2002	07/01/2003
Land:	125,000	145,000		
Improvements:	118,830	141,590		
Total:	243,830	286,590	258,083	272,336
Preferential Land:	0	0	0	0


Transfer Information

Seller:	Date:	Price:
Type:	Deed1:	Deed2:
Seller:	Date:	Price:
Type:	Deed1:	Deed2:
Seller:	Date:	Price:
Type:	Deed1:	Deed2:

Exemption Information

Partial Exempt Assessments	Class	07/01/2002	07/01/2003
County	000	0	0
State	000	0	0
Municipal	000	0	0

Tax Exempt: NO	Special Tax Recapture:
Exempt Class:	* NONE *

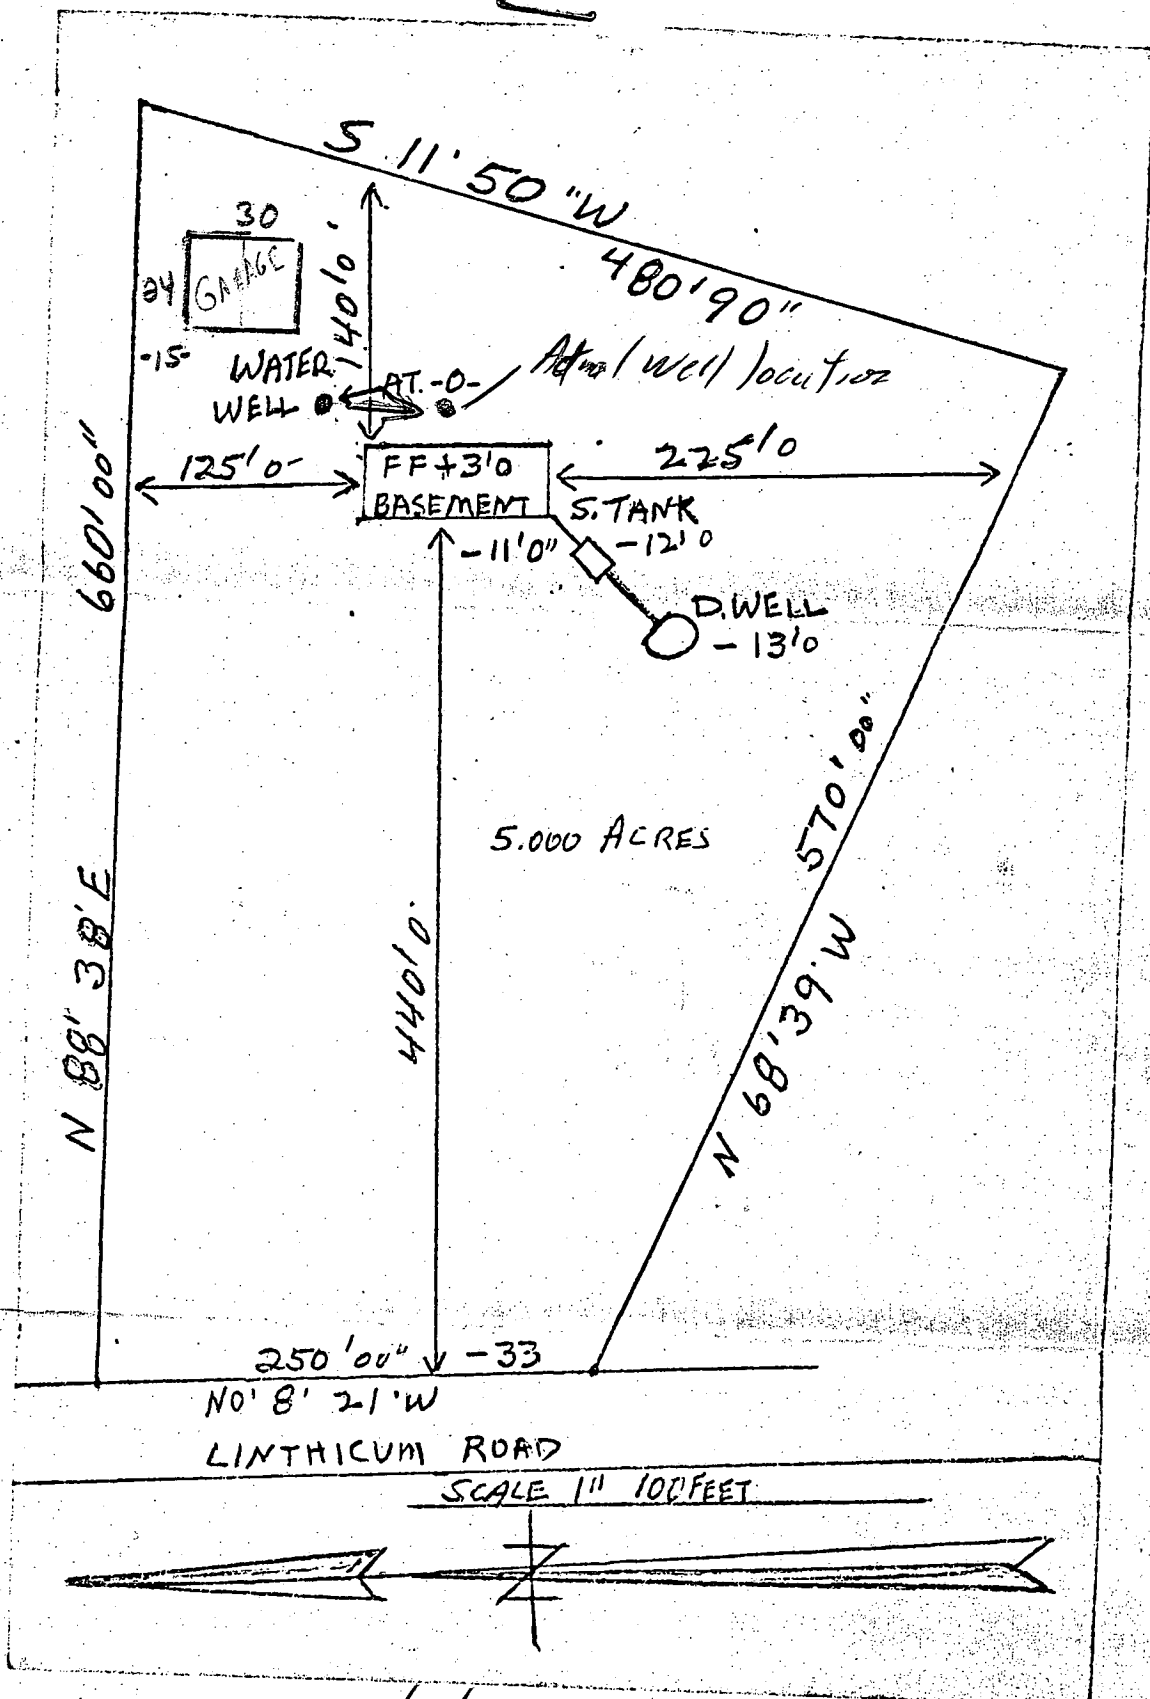

5/5/03 Site visit, set backs OK
 5/6/03 Proposed Garage OK (SC)
 B00141099

7/7/05 BOU 154773
Proposed tower location
OK (KJB)

