

5/2/89 PM } 03-300277
No inspection

5/02 { HOLD SEE BELOW }

PERMIT

P 44608
A REPAIR

SEWAGE DISPOSAL SYSTEM
MARYLAND STATE DEPARTMENT OF HEALTH DISTRICT _____

HOWARD COUNTY
BUREAU OF ENVIRONMENTAL HEALTH
461-9933

TAX ID 03-300277

DATE 6/28/89

DATE SYSTEM APPROVED 5/26/89

INSPECTOR C. Williams

INDEXED

Jack Fyock IS PERMITTED TO INSTALL _____ ALTER X

ADDRESS _____ PHONE 988-9270

SUBDIVISION _____ ROAD 3813 Ivory Road LOT _____

PROPERTY OWNER Staph, Frederick

ADDRESS 3813 Ivory Road
Glendg, Md 21737

IF GARBAGE GRINDER IS USED INCREASE SEPTIC TANK CAPACITY BY 50% AND ABSORPTION AREA BY 22%.

GARBAGE GRINDER? YES _____ NO _____

SEPTIC TANK CAPACITY _____ GALLONS NUMBER OF BEDROOMS _____

REPAIR - CALL FOR INSPECTION WHEN GROUND IS OPENED UP SO SANITARIAN CAN RECOMMEND REPAIR.

5/2/89 TO SEND MR. WILLIAMS A DRAWING ON
THIS AS PER R.M. INSTRUCTION. C.B.C.
(LEFT PERMIT WITH FYOCK'S MEN)

PLANS APPROVED BY C. Williams DATE 5/01/89

COVER NO WORK UNTIL INSPECTED AND APPROVED C.B.C. saw 5/2/89

NEITHER THE HOWARD COUNTY COUNCIL NOR THE HEALTH DEPARTMENT IS RESPONSIBLE FOR THE SUCCESSFUL OPERATION OF ANY SYSTEM.

NOTE: CLEANOUT REQUIRED EVERY 70 FEET OF SEWER LINE AND/OR AT 90° SWEEPS IN LINES FROM HOUSE TO DRAIN FIELDS

NOTE: ALL PARTS OF SEPTIC SYSTEMS (I.E. TANK DISTRIBUTION BOX TRENCHES) TO BE 100 FEET FROM WELL (UNLESS OTHERWISE SPECIFICALLY AUTHORIZED)

NOTE: IF DEEP TRENCHES ARE USED CALL FOR INSPECTION BEFORE AND AFTER PLACING GRAVEL IN TRENCHES)

BUILDING PERMIT SIGNED AND RETURNED

NOTE: NO DRY WELL SHALL EXCEED 15 FOOT IN DIAMETER NO ABSORPTION TRENCH TO EXCEED 100 FEET IN LENGTH.

NOTE: ALL PIPE FROM HOUSE TO SEPTIC TANK MUST BE CAST IRON OR SCHEDULE 40 PVC OR ABS

102504-PORCH + 2nd Story
3-03-05 BOD 152501-LP TANK

PERMIT VOID AFTER TWO YEARS

NOTE: INSTALL STAND PIPE ON SEPTIC TANK AND DRY WELL STAND PIPES MUST BE 6 INCHES IN DIAMETER. CAST IRON, CONCRETE OR TERRA COTTA OR PVC OR ABS ACCEPTED. IF TOP OF SEPTIC TANK IS DEEPER THAN 3 FEET, MANHOLE TO GRADE REQUIRED


NOTE: DISTRIBUTION BOXES MUST HAVE BAFFLES

***INSTALLER IS RESPONSIBLE FOR OBTAINING FINAL APROVAL ON THIS PERMIT**

*CALL 461-9933 FOR INSPECTION OF SEPTIC SYSTEMS.

BLDG. PERMIT SIGNED AND RETURNED 3/9/91
Serial # 36735 - correct

44608

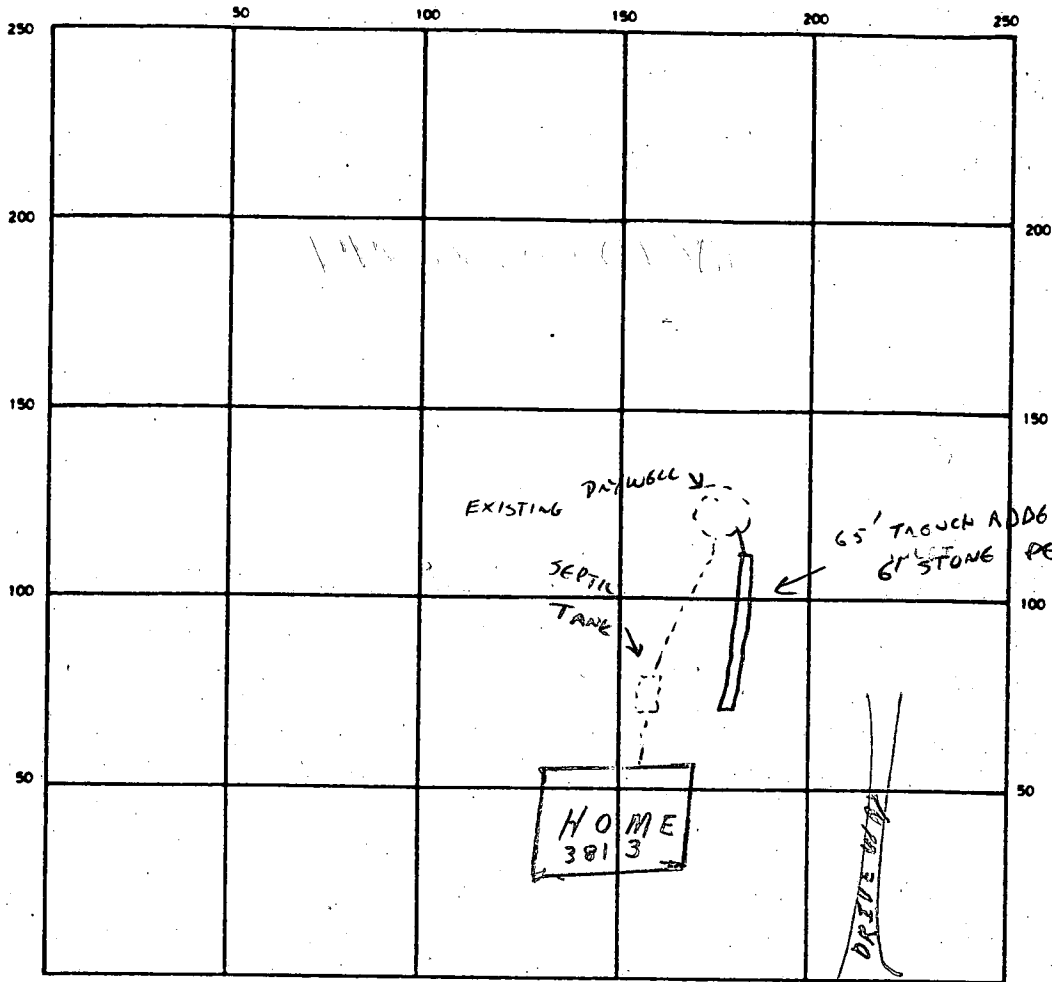

INDICATE NORTH - NAME ADJOINING ROADWAY AS BASE LINE

IVORY ROAD

SEPTIC TANK LEVEL EXIST. CLEANOUTS S.T. N/A

DISTRIBUTION BOX LEVEL N/A

DRAIN FIELD/TILE FIELD DEPTH 11 FT. TRENCH WIDTH 2 FT. INLET DEPTH 5 FT.

EFFECTIVE GRAVEL DEPTH 6 FT. TOTAL LENGTH 65 FT.

NUMBER OF TRENCHES 1 ONE SIDEWALL/BOTTOM AREA 390 SQ FT.

DRYWELL INSIDE DIAMETER _____ FT. EFFECTIVE DEPTH BELOW INLET _____ FT.

ABSORBENT AREA 390 + EXISTING SQ. FT.

DESIGNED BY

REMARKS 5/26/89 M. - OK TO CONTINUE REPAIR IN PROGRESS

HOLD FOR CERTIFIED DRAWING; left info with FYOCK'S MEN. C.B.D

5/26/89 CONTRACTOR'S SKETCH REVIEWED OK - SYSTEM APPROVED C. Wellian

DATE SYSTEM APPROVED 5/26/89 INSPECTOR C. Wellian


N 60° 24' 10" W

421.65'

S 46° 22' 00"

SEPTIC TANK

12' x 10' frame shed

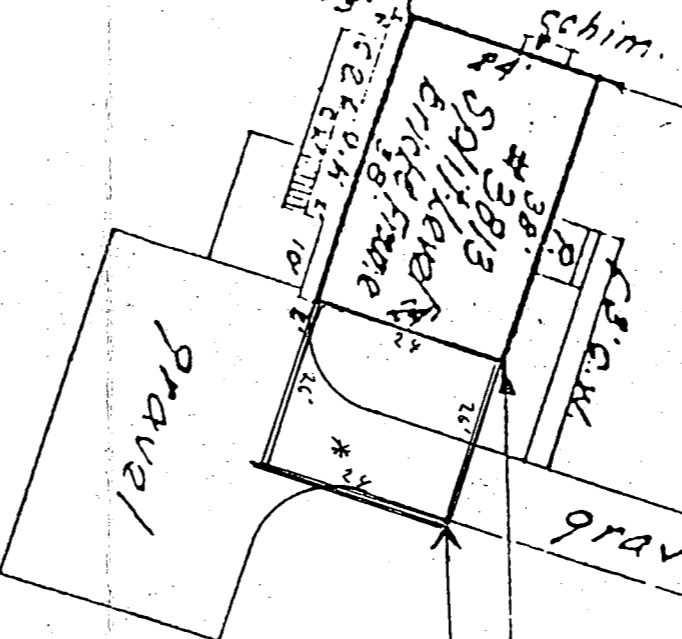

gravel driveway

gravel

DRILLED WELL

40' ±

75' ±

104' ±

78' ±

N 46° 22' 05" E 1319.47.05' WAY

194.56' 20' ± MASS

100' ±

300' ±

* DRIVE-THRU CAR PORT BRICK + FRAME

3/4/91 PLANS OK

S 62° 13' 18" E

425.94'

gravel driveway

PERMIT

SEWAGE DISPOSAL SYSTEM

P 25726

A 25096

MARYLAND STATE DEPARTMENT OF HEALTH

HOWARD COUNTY

03-300277

ELLICOTT CITY

DISTRICT 3rd

DATE 4/25/77

INDEXED

Jim Brittingham

IS PERMITTED TO INSTALL ALTER

ADDRESS 3004 N. Rogers Avenue, Ellicott City, Md. 21043 PHONE 461-1870

A SEWAGE DISPOSAL SYSTEM LOCATED AT _____

SUBDIVISION _____ ROAD 3813 Ivory Road LOT 6-A

PROPERTY OWNER R. J. Builders Company

ADDRESS 19627 Folly Quarter Road, Ellicott City, Md. 21043 Phone: 286-3824

SPECIFICATIONS 3 bedrooms

DRAIN FIELD _____ DEPTH _____ FEET, BOTTOM AREA _____ SQ. FT.

SEEPAGE PITS _____ ABSORBENT SIDE-WALL AREA _____ SQ. FT.

SEPTIC TANK CAPACITY 1000 GALLONS

FOR GARBAGE GRINDER, INCREASE DISPOSAL AREA 22% & TANK CAPACITY 50%.


OTHER DRY WELL AND TRENCH - Dry well to have 288 sq. ft. sidewall area. Inlet at 5 ft. and maximum depth 11 ft. below original grade. Locate dry well 20 ft. from right side line (as seen from Ivory Road) and 188 ft. from front lot line. Trench to be 35 ft. long for a total sidewall area of 192.5 sq. ft. Inlet at 5½ ft. and maximum depth 11 ft. on trench below original grade. NOTE: CALL FOR INSPECTION OF TRENCH BEFORE PLACING STONE IN TRENCH. NOTE: IN NO CASE IS ANY DRY WELL TO EXCEED 15 FOOT IN DIAMETER. NOTE: ALL PIPE FROM HOUSE TO DISPOSAL AREA MUST BE CAST IRON. PERMIT VOID AFTER THREE YEARS. NOTE: INSTALL STAND PIPE ON SEPTIC TANK AND DRY WELL. STAND PIPES MUST BE 6 INCHES IN DIAMETER. CAST IRON, CONCRETE OR TERRA COTTA ACCEPTED.

PLANS APPROVED BY Hal Benson DATE 11/24/76

FILL SEPTIC TANK AND DISTRIBUTION BOX WITH WATER BEFORE CALLING FOR AN INSPECTION. COVER NO WORK UNTIL INSPECTED AND APPROVED.

NEITHER THE HOWARD COUNTY COMMISSIONERS NOR THE HEALTH DEPARTMENT IS RESPONSIBLE FOR THE SUCCESSFUL OPERATION OF ANY SYSTEM.

A 25096

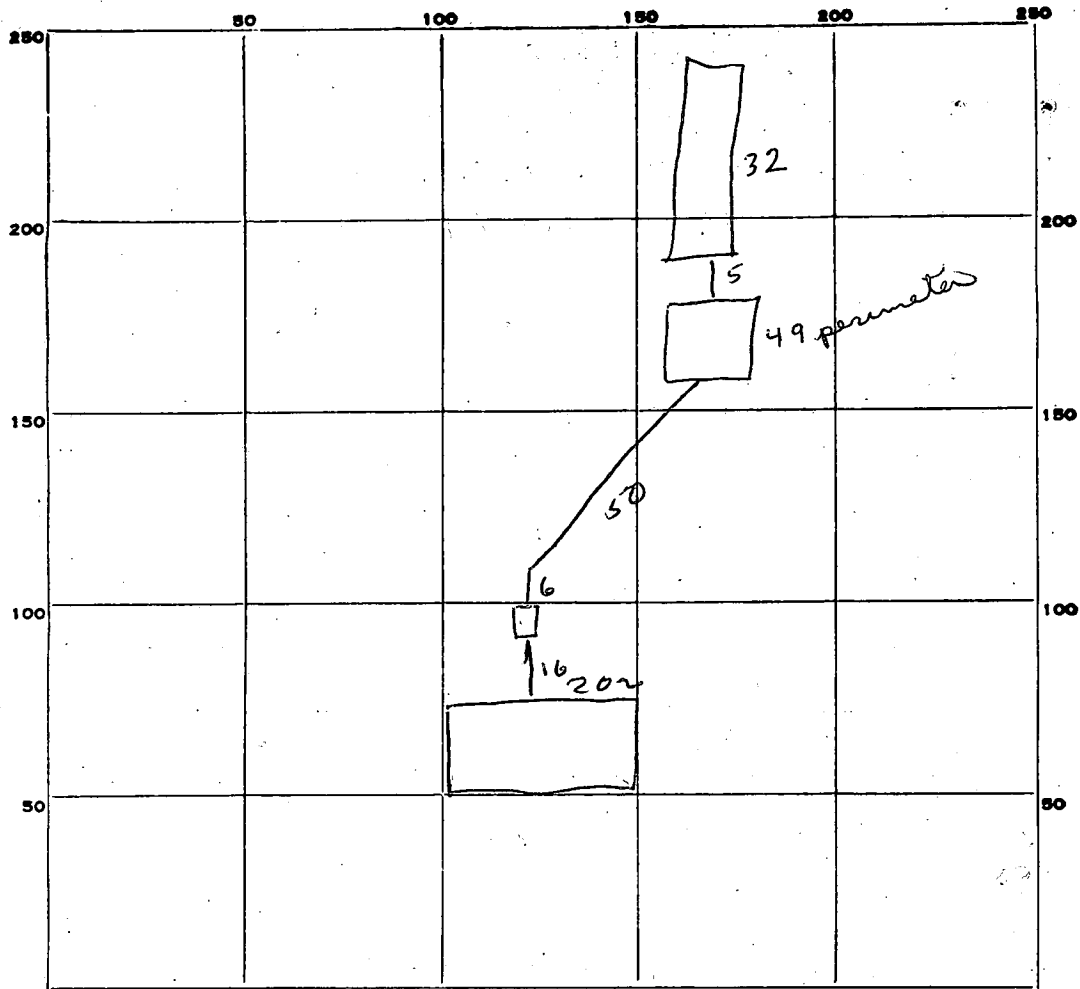

INDICATE NORTH. - NAME ADJOINING ROADWAY AS BASE LINE.

PERMIT CARD

SEPTIC TANK, LEVEL

CLEANOUTS DW + ST.

DISTRIBUTION BOX, LEVEL

TILE FIELD, DEPTH 11 FT. TRENCH WIDTH 2 FT.

GRAVEL DEPTH 5 1/2 IN. TOTAL LENGTH 34 FT.

NUMBER OF TRENCHES 1 TOTAL BOTTOM AREA 192 ^{1 side}

SEEPAGE PITS, ^{outside} INSIDE DIAMETER 50 FT. DEPTH BELOW INLET 5' FT.

ABSORBENT AREA 300 SQ. FT. + 192 = 480

REMARKS OK to cover

DATE SYSTEM APPROVED APR 27 77 INSPECTOR R. Briggs

APPLICATION

A 25096

SEWAGE DISPOSAL TESTING

P _____

STATE OF MARYLAND - DEPARTMENT OF HEALTH AND MENTAL HYGIENE

HOWARD COUNTY HEALTH DEPARTMENT
ENVIRONMENTAL HEALTH SERVICES
P. O. BOX 476, ELLICOTT CITY, MARYLAND 21043
TELEPHONE: 465-5000, EXT. 356

DISTRICT _____

DATE _____

TO: THE COUNTY HEALTH OFFICER
ELLICOTT CITY, MARYLAND

I, HEREBY, APPLY FOR THE NECESSARY TEST IN ORDER TO CONSTRUCT (OR RECONSTRUCT) A SEWAGE DISPOSAL SYSTEM.

PROPERTY OWNER: _____

ADDRESS _____ PHONE _____

PROPERTY LOCATION:

SUBDIVISION _____ LOT NO. 6A

ROAD AND DESCRIPTION _____

SIZE OF LOT _____ TYPE BLDG. _____

NUMBER OF BEDROOMS _____

IF NOT SINGLE RESIDENCE DESCRIBE _____

THE SYSTEM INSTALLED UNDER THIS APPLICATION IS ACCEPTABLE ONLY UNTIL PUBLIC FACILITIES BECOME AVAILABLE.

SIGNATURE OF APPLICANT: _____

APPROVED BY: _____ FOR _____ DATE _____

(KIND OF SYSTEM)

REJECTED BY: _____ FOR _____ DATE _____


(KIND OF SYSTEM)

HOLD PENDING FURTHER TESTS: _____ DATE _____


REASONS FOR REJECTION OR HOLDING _____

THIS IS NOT A PERMIT

A25096

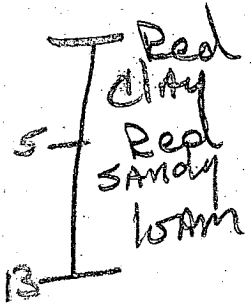

Nearly level lot

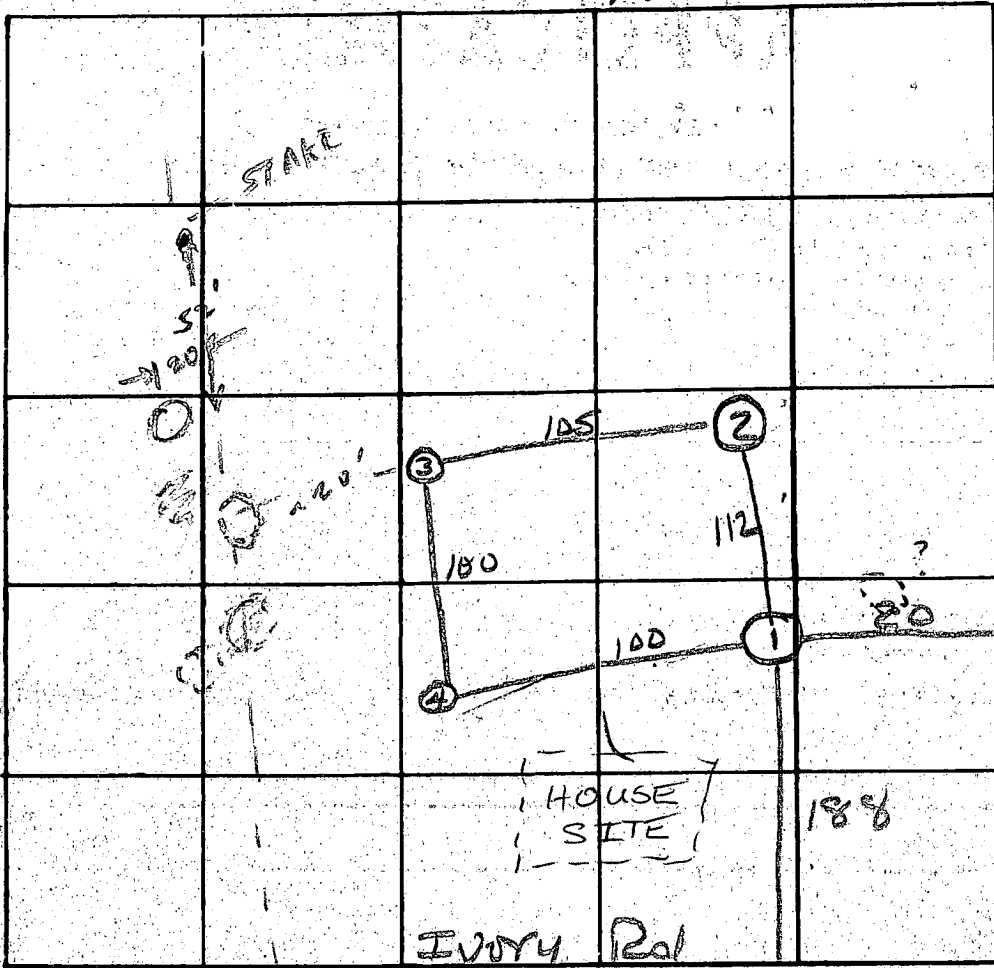

INDICATE NORTH. - NAME ADJOINING ROADWAY AS BASE LINE.

DATE	TEST NO.	DEPTH.	PRE-WET		TEST - 1" DROP		TIME
			START	STOP	START	STOP	
10/5/76	1A	5	1:34	1:40	1:40	1:46	6
		13 1/2	1:34	1:40	1:40	1:51	11
	2A	5	1:36	1:39	1:39	1:45	6
		13 1/2	1:36	1:44	1:44	2:01	16
	3	12 1/2	similar soil - dry				
	4A-1	4	1:57	pulled at 2:27		2:27	no perk
		13	1:55	2:12	2:12	2:27	15
	4A-2	5 1/2	3:20	3:23	3:23	3:33	10

AVG 11 min perk

REMARKS use hole 1

TYPE OF SOIL _____

TESTED BY wwz & kb ALSO PRESENT: Paquette

1 4465 SEQUENCE NO. (WRA USE ONLY)

1 2 3 (SEQ. NO.) 6

(THIS NUMBER IS TO BE PUNCHED IN COLS. 3-6 ON PL CARDS)

DATE RECEIVED (WRA USE ONLY)

DATE WELL COMPLETED 4-19-77

DEPTH OF WELL 125 (TO NEAREST FOOT)

PERMIT NO. FROM "PERMIT TO DRILL WELL" 40-73-1999

DRILLERS IDENTIFICATION NO. 130

STATE OF MARYLAND
 WATER RESOURCES ADMINISTRATION
 TAWES STATE OFFICE BLDG., ANNAPOLIS, MD. 21401
 WELL COMPLETION REPORT

THIS REPORT MUST BE SUBMITTED WITHIN 30 DAYS AFTER WELL COMPLETION

FILL IN THIS FORM COMPLETELY

COUNTY NUMBER

OWNER: ROBERT L. DORSEY + SON

LAST NAME: DORSEY FIRST NAME: ROBERT L.

STREET OR RFD: 1926 CYPRESS MEDE POST OFFICE: ELICOTT CITY, MD.

WELL LOG

STATE THE KIND OF FORMATIONS PENETRATED, THEIR COLOR, DEPTH, THICKNESS AND IF WATER BEARING

DESCRIPTION (USE ADDITIONAL SHEETS IF NECESSARY)	FEET		CHECK IF WATER BEARING
	FROM	TO	
OVERBURDEN	0	8	
BROWN SHALE	8	42	
GRAY ROCK	42	125	X

GROUTING RECORD

WELL HAS BEEN GROUTED (CIRCLE APPROPRIATE BOX) YES NO

TYPE OF GROUTING MATERIAL (CIRCLE BOX)

CEMENT BENTONITE CLAY

NO. OF BAGS 12 NO. OF POUNDS 1200

GALLONS OF WATER 72

DEPTH OF GROUT SEAL (TO NEAREST FOOT)

FROM 0 FT. TO 44 FT.

CASING RECORD

INSERT APPROPRIATE CODE BELOW

STEEL CONCRETE

PLASTIC OTHER

MAIN CASING TYPE NOMINAL DIAMETER TOP (MAIN) CASING (NEAREST INCH) 6 TOTAL DEPTH OF MAIN CASING (NEAREST FOOT) 44

OTHER CASING (IF USED)

DIAMETER (INCH) DEPTH (FEET) FROM TO

SCREEN RECORD

INSERT APPROPRIATE CODE BELOW

STEEL BRASS OR BRONZE OPEN HOLE

PLASTIC OTHER

SCREENS

1	2	3	(SEQ. NO.)	6
1	8	9	11	15
2	23	24	26	30
3	38	39	41	45

DEPTH (NEAREST WHOLE FOOT) FROM TO 4 FROM 125 TO

SLOT SIZE 1. 2. 3.

DIAMETER OF SCREEN 56 (NEAREST INCH) FROM TO

GRAVEL PACK

IF WELL DRILLED WAS A FLOWING WELL CIRCLE BOX 68

WRA USE ONLY (NOT TO BE FILLED IN BY DRILLER)

TELESCOPE CASING LOG INDICATOR

PUMPING TEST

HOURS PUMPED (TO NEAREST HOUR) 6

PUMPING RATE (GALLONS PER MINUTE TO NEAREST GALLON) 20

METHOD USED TO MEASURE PUMPING RATE AIR

WATER LEVEL: (DISTANCE FROM LAND SURFACE)

BEFORE PUMPING 29 (NEAREST FOOT)

WHEN PUMPING 110 (NEAREST FOOT)

TYPE OF PUMPED USED (CIRCLE APPROPRIATE BOX) (FOR PUMPING TEST)

AIR PISTON TURBINE

CENTRIFUGAL ROTARY OTHER (DESCRIBE BELOW)

JET SUBMERSIBLE

PUMP INSTALLED

TYPE OF PUMP (WRITE APPROPRIATE LETTER IN BOX - SEE ABOVE: A, C, J, P, R, S, T, O)

DRILLER WILL INSTALL PUMP (CIRCLE APPROPRIATE BOX) YES NO

CAPACITY:

GALLONS PER MINUTE (TO NEAREST GALLON) 31 35

PUMP HORSE POWER 37 41

PUMP COLUMN LENGTH (NEAREST FOOT) 43 47

CASING HEIGHT (CIRCLE APPROPRIATE BOX AND ENTER CASING HEIGHT)

ABOVE BELOW

LAND SURFACE 1 (NEAREST FOOT)

LOCATION OF WELL ON LOT

SHOW PERMANENT STRUCTURE SUCH AS BUILDINGS, SEPTIC TANKS, AND/OR OTHER LAND MARKS AND INDICATE NOT LESS THAN TWO DISTANCES (MEASUREMENTS TO WELL).

CIRCLE APPROPRIATE BOXES

A WELL WAS ABANDONED AND SEALED WHEN THIS WELL WAS COMPLETED

ELECTRIC LOG OBTAINED

TEST WELL CONVERTED TO PRODUCTION WELL

I HEREBY CERTIFY THAT I HAVE COMPLIED WITH ALL CONDITIONS STATED ON THE ABOVE-CAPTIONED "PERMIT TO DRILL WELL", AND THAT INFORMATION CONTAINED IN THIS REPORT IS TRUE, ACCURATE, AND COMPLETE TO THE BEST OF MY KNOWLEDGE, INFORMATION AND BELIEF.

DRILLERS NAME: GEDGAR HARRIS SONS CORP.

SIGNATURE: [Signature]

PITLESS ADAPTER

B 1 9661

SEQUENCE NO. (WRA USE ONLY)

STATE OF MARYLAND
WATER RESOURCES ADMINISTRATION

WRA PERMIT NUMBER

TAWES STATE OFFICE BLDG., ANNAPOLIS, MARYLAND 21401
APPLICATION FOR PERMIT TO DRILL WELL

~~A 25096~~
40-731949
FILL IN THIS FORM COMPLETELY

DATE RECEIVED (WRA USE ONLY)
4/26/77
9:30 AM

OWNER: ROBERT L. DORSEY + SON, INC.
COL 15 LAST NAME COL 16 FIRST NAME COL 34
STREET OR RFD: 9926 CYDREDADE
COL 36 COL 58
POST OFFICE: ELLENDALE CITY, MD 21043
COL 57 COL 76

B 1 CONTINUED DRILLER INFORMATION
1 2 3 (SEQ. NO.) 6
DATE: MARCH 9, 1977 LICENSE NUMBER: 120
8 77 80
G. EDGAR HARR SONS CORP
FIRST NAME DRILLER LAST NAME
SIGNATURE: [Signature]

B 3 LOCATION OF WELL
1 2 3 (SEQ. NO.) 6
COUNTY: HOWARD
8 (DO NOT ABBREVIATE COUNTY NAME) 21
SUBDIVISION: 23 42
SECTION: 44 46 LOT: 6A 50
NEAREST TOWN: GLENELG 71
MILES FROM TOWN (ENTER 0 IF IN TOWN): 1 73 MI 76 77 78

B 2 WELL INFORMATION
1 2 3 (SEQ. NO.) 6
MAXIMUM PUMPING RATE (GALLONS PER MINUTE): 5 8 12
AVERAGE DAILY QUANTITY NEEDED (GALLONS PER DAY): 750 14 20
USE FOR WATER (CIRCLE APPROPRIATE BOX):
 HOME (SINGLE OR DOUBLE HOUSEHOLD UNIT ONLY)
 FARMING, AGRICULTURE, IRRIGATION
 INDUSTRIAL, COMMERCIAL, STATE AND FEDERAL GOVERNMENT.
 MUNICIPAL WATER SUPPLY } MUST HAVE STATE HEALTH DEPT. APPROVAL
 PRIVATE WATER COMPANY
 TEST

B 4 DIRECTION FROM TOWN (CIRCLE APPROPRIATE BOX)
1 2 3 (SEQ. NO.) 6
 NORTH EAST NORTHEAST SOUTHEAST
 SOUTH WEST NORTHWEST SOUTHWEST
NEAR WHAT ROAD: 3813 IVORY ROAD
ON WHICH SIDE OF ROAD (CIRCLE APPROPRIATE BOX): NORTH SOUTH EAST WEST 30
DISTANCE FROM ROAD (ENTER DISTANCE AND CIRCLE APPROPRIATE BOX): 80 37 MI 38 39

APPROXIMATE DEPTH OF WELL: 150 FEET
APPROXIMATE DIAMETER OF WELL: 6 (NEAREST INCH)


METHOD OF DRILLING USED (CIRCLE APPROPRIATE METHOD)
 BORED (OR AUGERED) JETTED DRIVEN
30-37 AIR-ROTARY AIR-PERCUSSION ROTARY (HYDRAULIC ROTARY)
 CABLE REVERSE-ROTARY DRIVE-POINT
OTHER (DESCRIBE):

REPLACEMENT OR DEEPEMED WELLS (CIRCLE APPROPRIATE BOX)
 THIS WELL WILL NOT REPLACE AN EXISTING WELL
 THIS WELL WILL REPLACE A WELL THAT WILL BE ABANDONED AND SEALED
 THIS WELL WILL REPLACE A WELL THAT WILL BE USED AS A STANDBY
 THIS WELL WILL DEEPEM AN EXISTING WELL PERMIT NUMBER OF WELL TO BE REPLACED OR DEEPEMED (IF AVAILABLE)
41 52

NOT TO BE FILLED IN BY DRILLER (WRA USE ONLY)
APPROPRIATION PERMIT NUMBER: 54 ENGINEER REVIEW DISTRICT NO.: 63
FORCE: WRITE INITIALS IN BOX CONDITIONS: A E N S G W Q C L U
67 68 70 71 72 73 74 75 76 77 78 79

B 4 CONTINUED HEALTH DEPARTMENT APPROVAL
1 2 3 (SEQ. NO.) 6
Howard W25444
41 STATE HEALTH (CIRCLE BOX) COUNTY NAME COUNTY NO.
DATE: 3 13 77
MO. DAY YR.
APPROVED BY: Fred Frommelt, Sanitarian
43 48

DRAW A SKETCH BELOW SHOWING LOCATION OF WELL IN RELATION TO NEARBY TOWNS, ROADS AND STREAMS WITH NORTH IN THE DIRECTION OF THE ARROW, AND GIVE DISTANCE FROM WELL TO NEAREST ROAD JUNCTION OR STREAM CROSSING SHOWN ON THE SKETCH. ALSO SHOW, BY MEANS OF AN "X", THE WELL LOCATION IN THE BOX BELOW, AND THE BOX NUMBER FROM THE WELL LOCATION MAP.

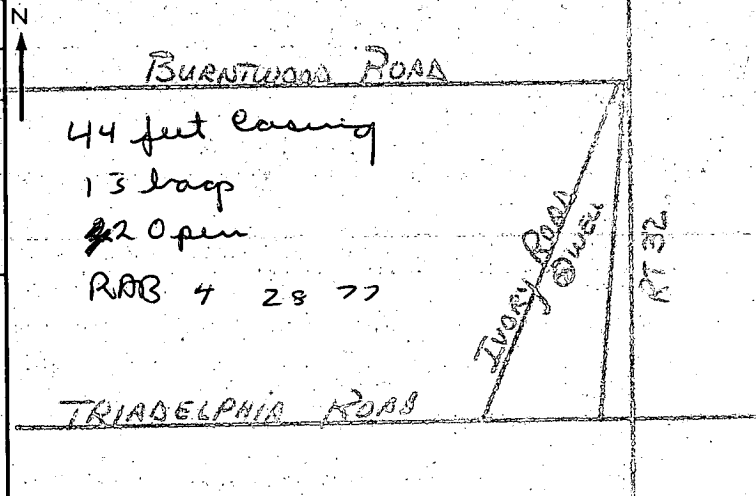


BOX NUMBER: 800 (E), 520 (N)
NORTH COORDINATE: 5010000 50 51 52 53 54 55
EAST COORDINATE: 0910000 57 58 59 60 61 62 63
ELEVATION AT WELL HEAD (FEET): 65 66 67 68 0/0 5/0

B 5 SPECIAL CONDITIONS 8-63 (WRA USE ONLY)
1 2 3 (SEQ. NO.) 6

465-5739


HEALTH

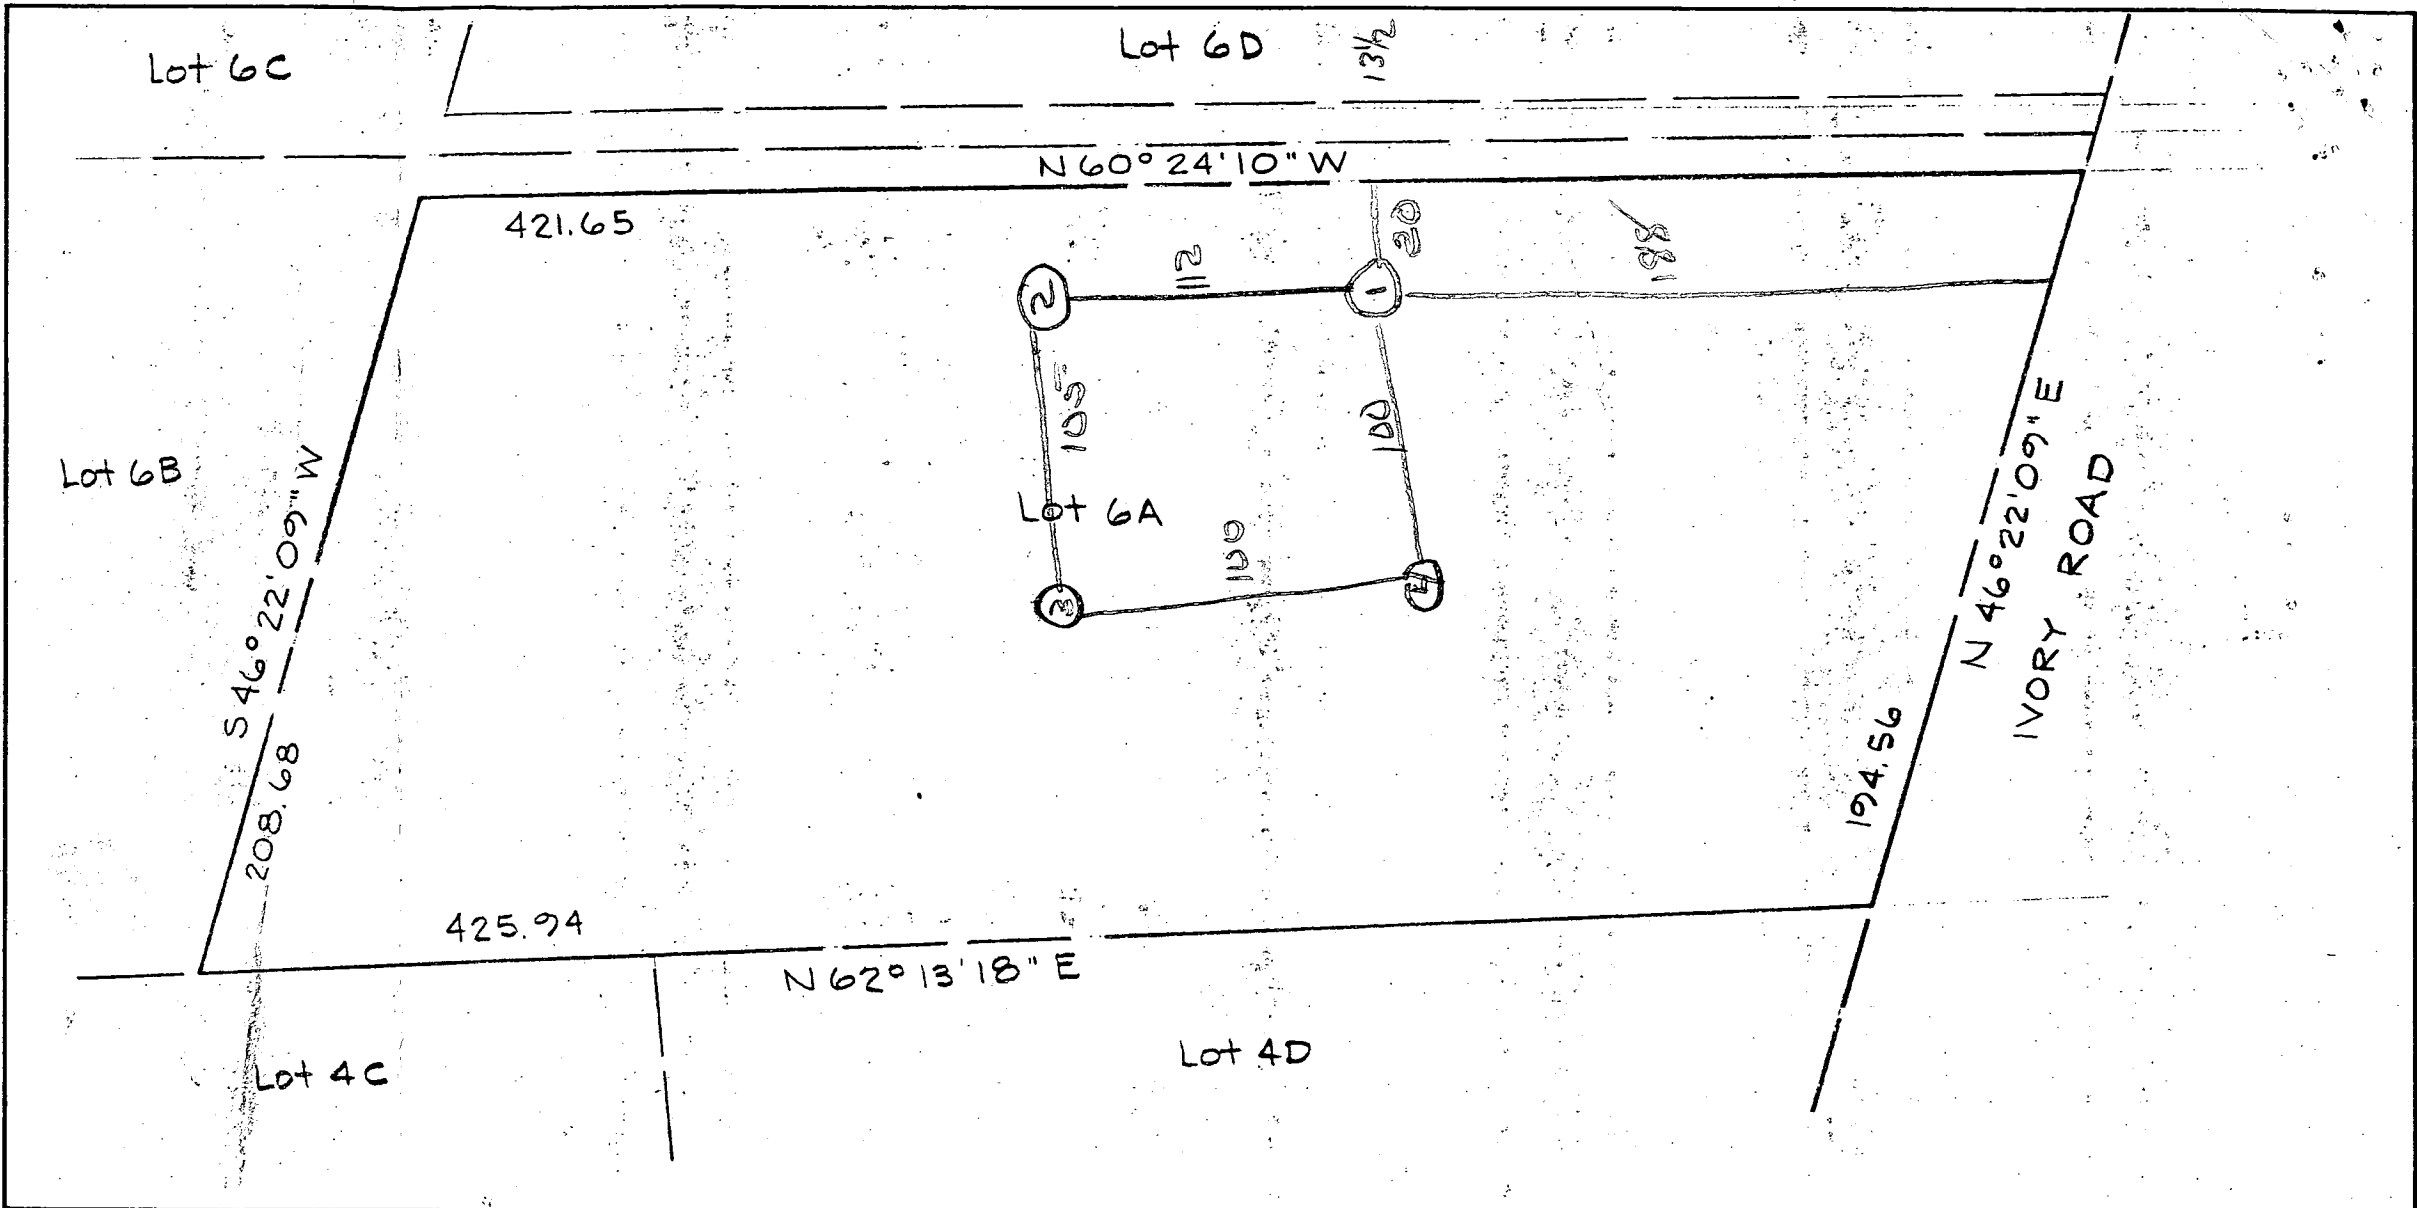

BRUNING 40-105 11334

Nearly level lot

REFERENCE

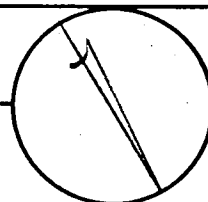

MERIDIAN

MAP OF PROPERTY OF
HOWARD ASSOC.

SITUATED IN

3rd Election Dist.

Howard Co., Md.

SCALE: 1" = 50'

DATE:


RICHARD P. BROWNE ASSOCIATES

CONSULTING ENGINEERS, PLANNERS
WAYNE, N.J. COLUMBIA, MD.

DRAWN MK CHECKED _____


PROJECT No. 4047 W. O. No. 2631


No. _____

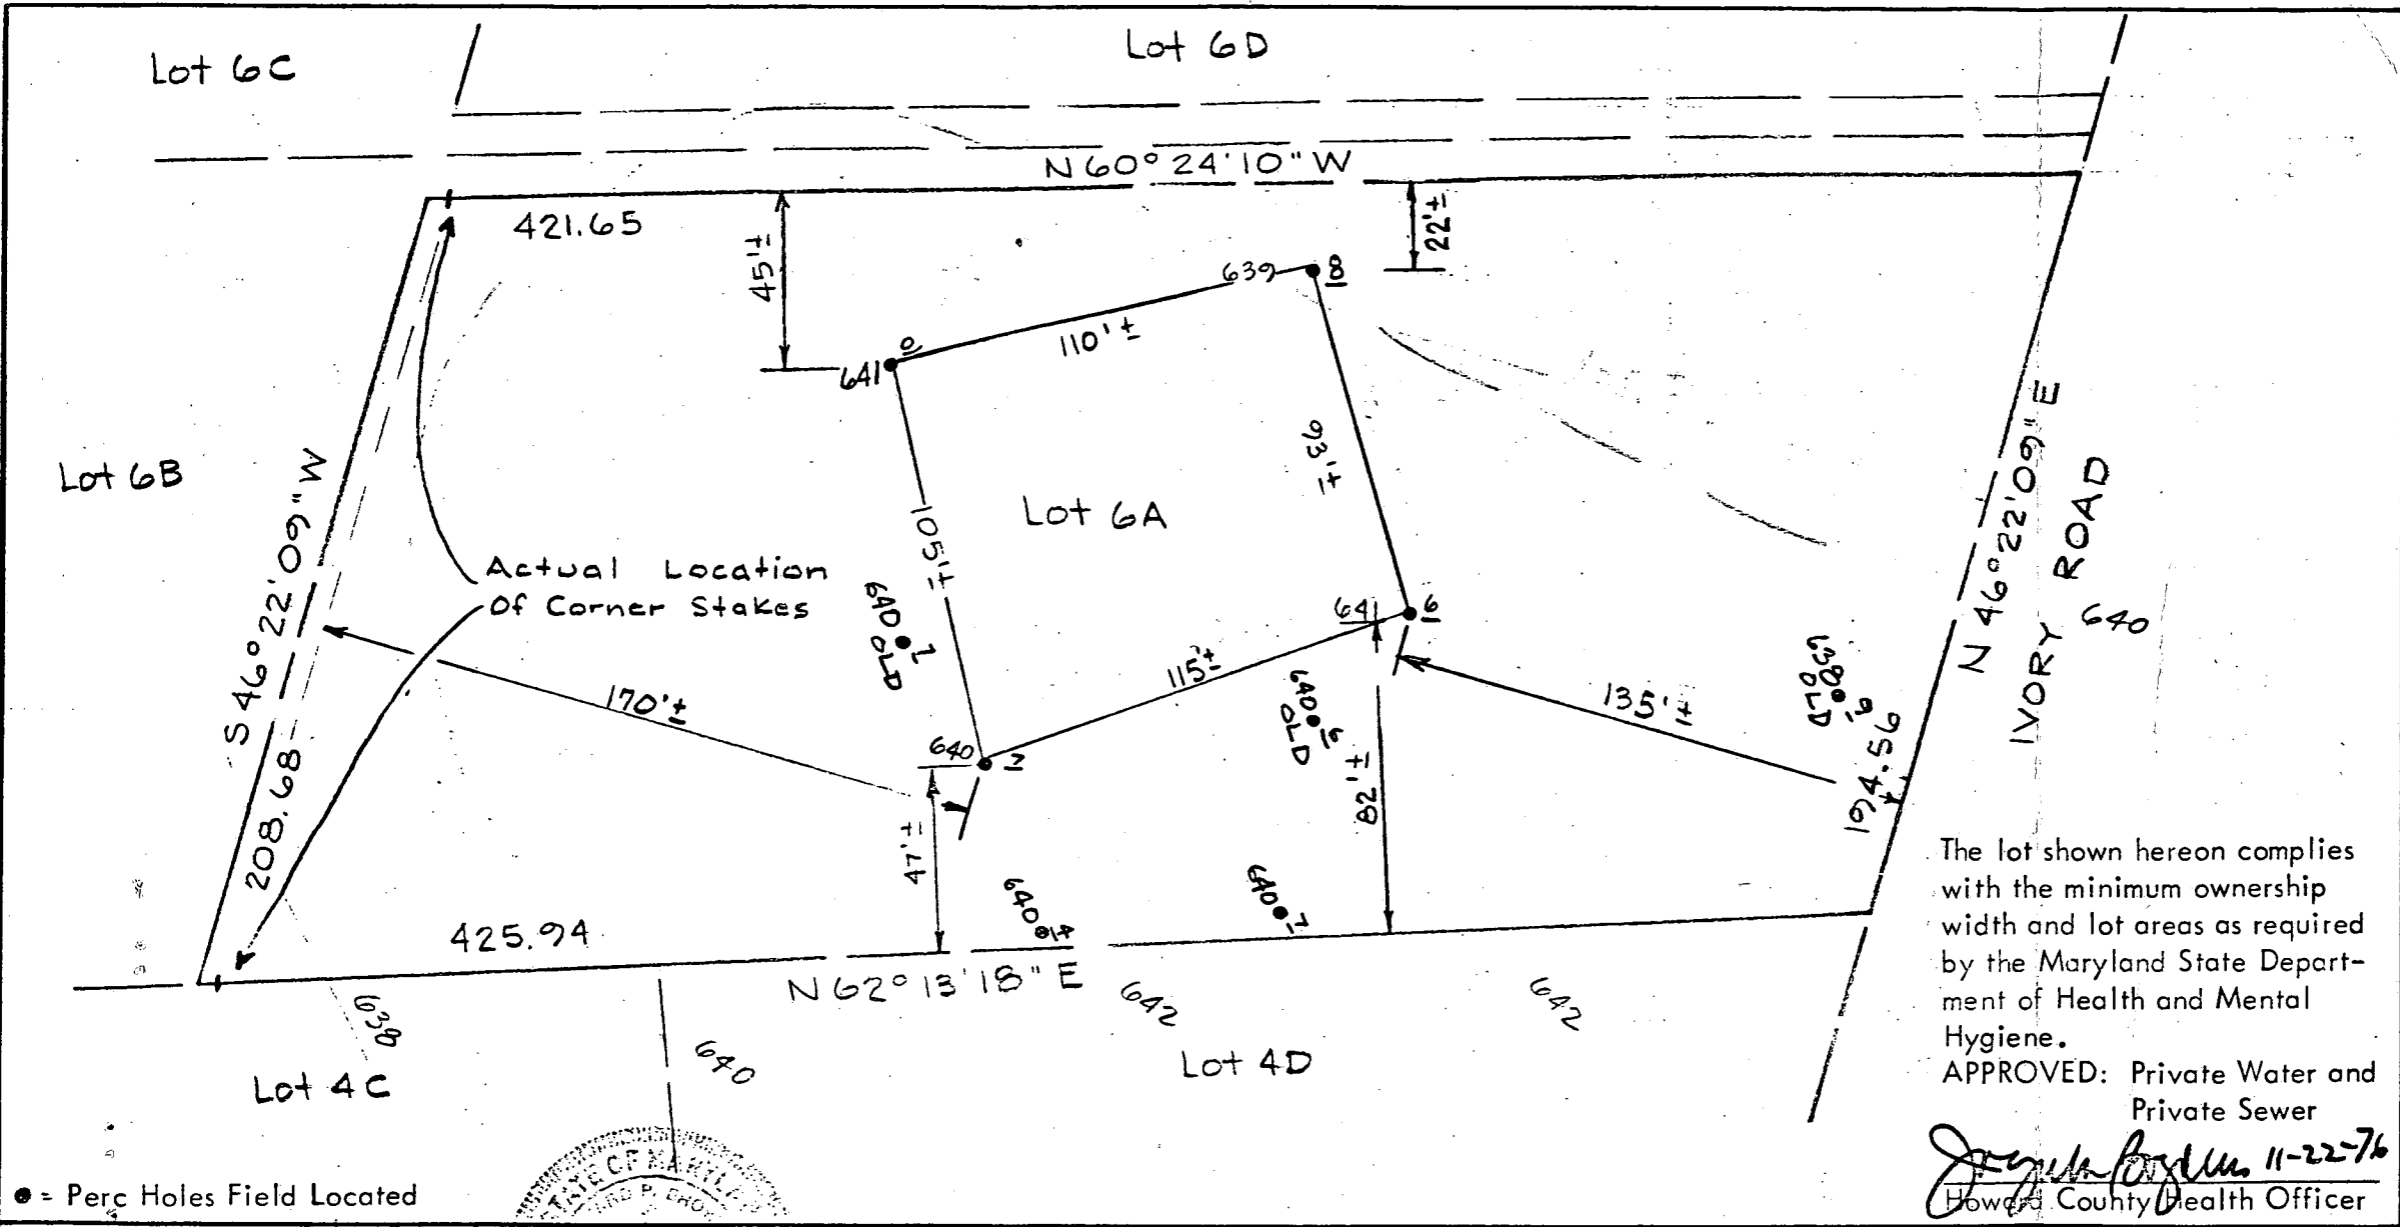

The lot shown hereon complies with the minimum ownership width and lot areas as required by the Maryland State Department of Health and Mental Hygiene.
 APPROVED: Private Water and Private Sewer
Joseph Boyle 11-22-76
 Howard County Health Officer

● = Perc Holes Field Located

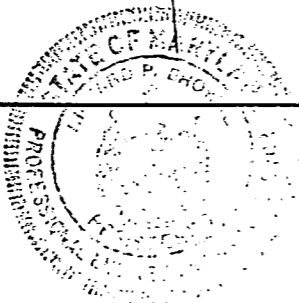

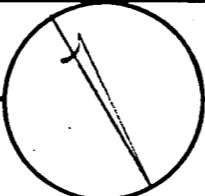REFERENCE  MERIDIAN

RICHARD P. BROWNE ASSOCIATES
 CONSULTING ENGINEERS, PLANNERS
 WAYNE, N.J. COLUMBIA, MD.

MAP OF PROPERTY OF
HOWARD ASSOC.

SITUATED IN
 3rd Election Dist. Howard Co., Md.
 SCALE: 1" = 50'
 DATE:

BRUNING 40-105 11334

PROJECT No. 4047 W. O. No. 263

DRAWN IAK CHECKED

LH02-67-103 3813 IVORY RD GLENELG HOW 8/26/02 GOOZ Case#2002197

Fema Panel: 240044 0021B
Flood Zone: C
PARCEL OF LAND
1.869 AC +/-
Book: 5856
Folio: 340
Dist: 3
Co: HOWARD
MD


Scale 1" = 40'

10-25-04
NEED EXACT
MEASUREMENT
FROM PROPOSED
extension to
S.T.
Well??

PLAN IS
to scale
RD KN
RD 304 RW

10-27-04
Well and septic
set backs met

Drain Field
6' 65" long
of gravel
extension on rear

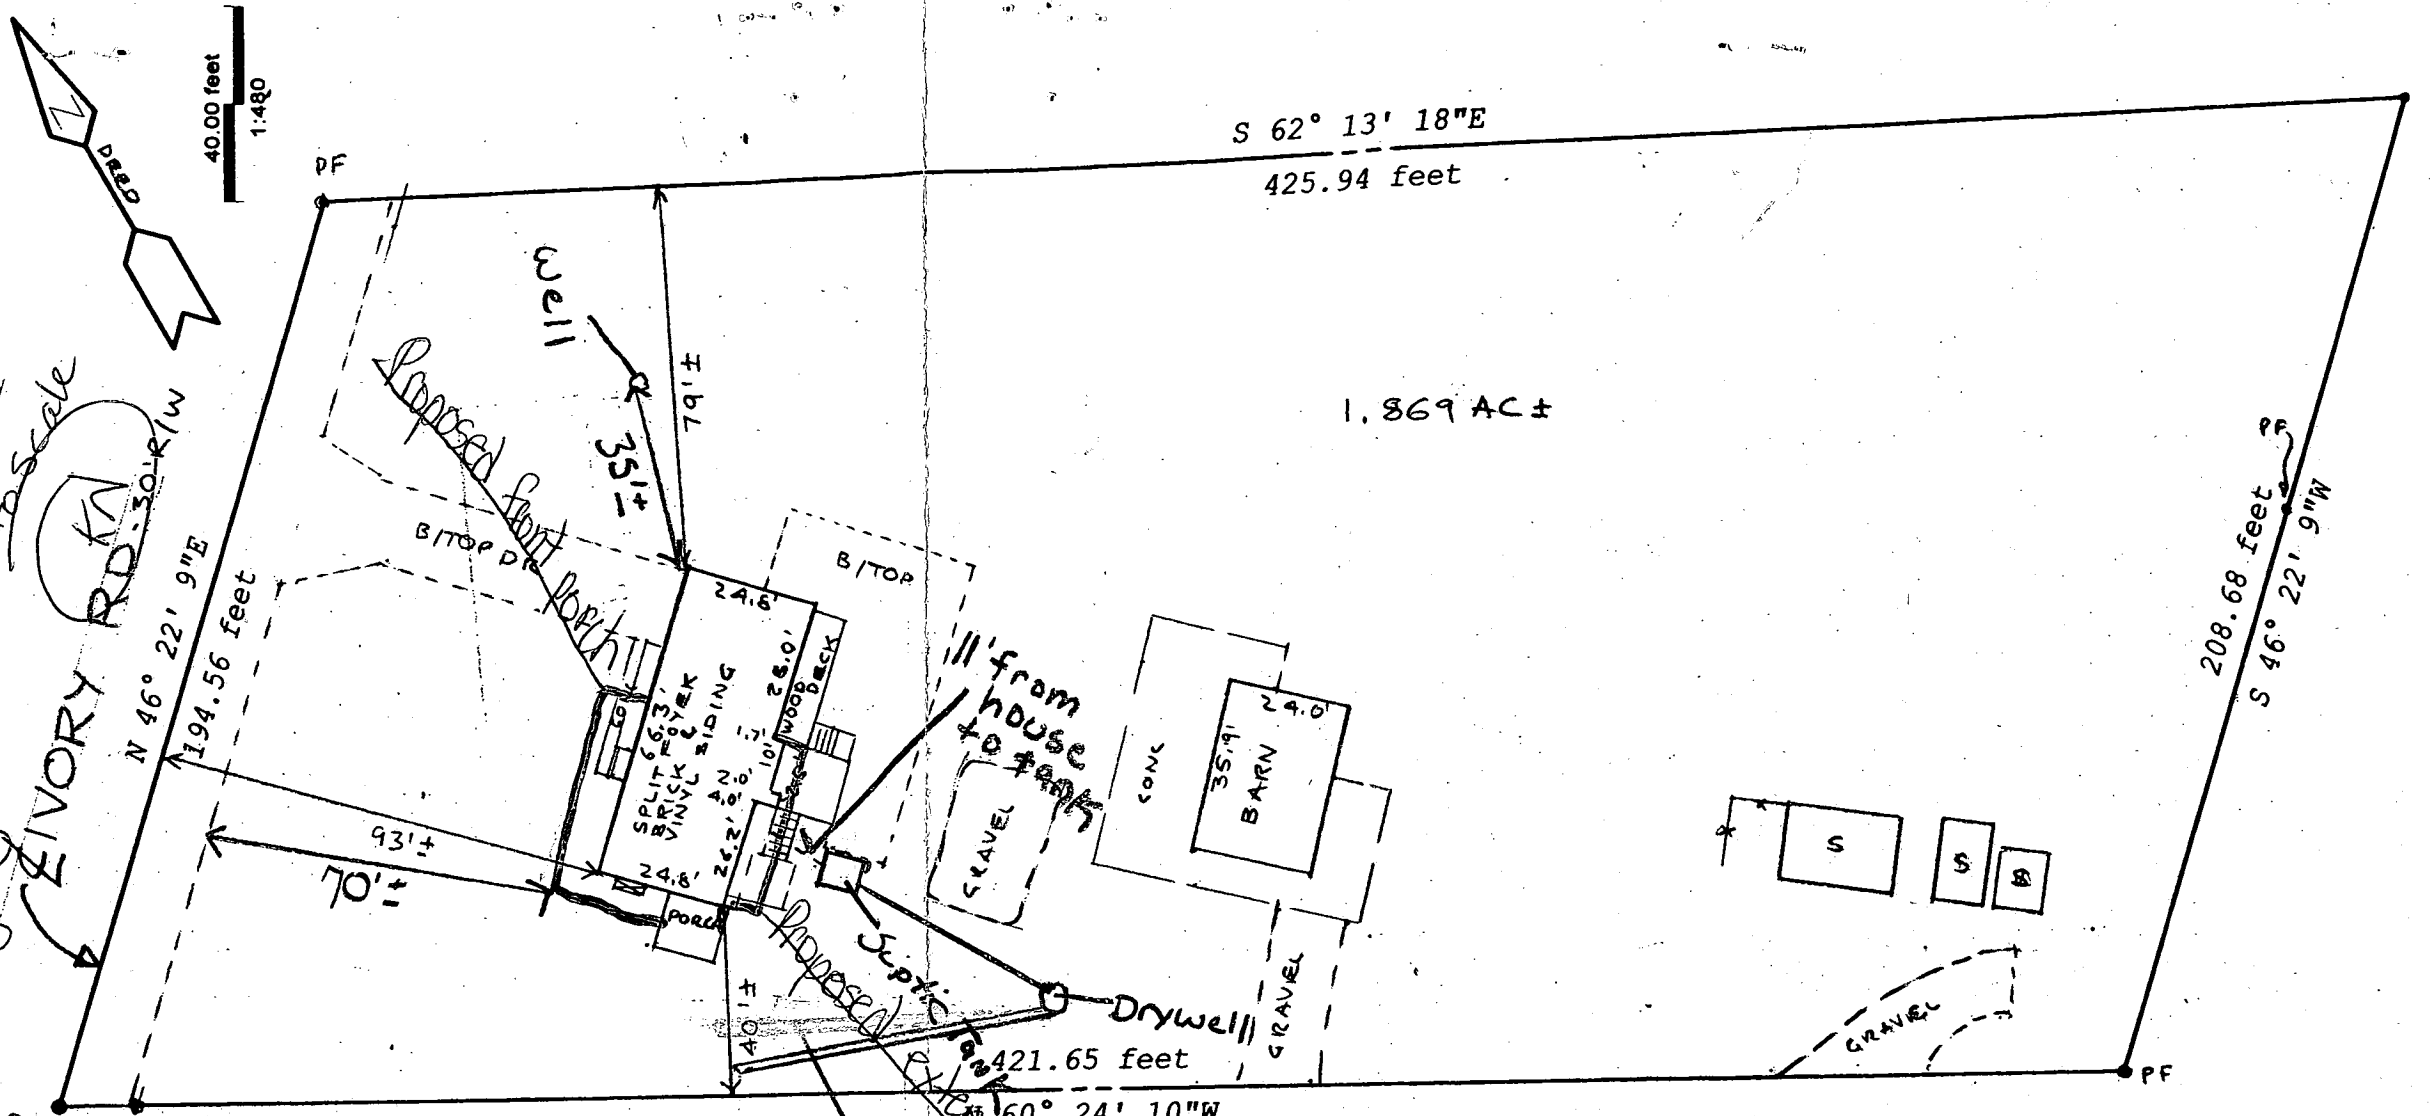

S 62° 13' 18"E
425.94 feet

1.869 AC ±

208.68 feet
S 46° 22' 9"W

N 46° 22' 9"E
194.56 feet

60° 24' 10"W
421.65 feet

APPROVED

WALK-THRU BUILDING PERMIT
BP# 150793 A# P44608
APP. SAN KN DATE: 10-27-04
DESC. OF WORK: porch
extensions



E mail: surveyassociates@erols.com

LOCATION
MORTGAGE
SURVEY

SURVEY ASSOCIATES OF MARYLAND

4905 SUDLEY RD
WEST RIVER MARYLAND 20778
TEL 410 266 7211 FAX 410 266 0918
FAX BALTIMORE 410 841 6150
FAX METRO DC 301 970 2514

Large Lots: Boundaries on larger lots may not all be inspected.
Accuracy: Approximate average accuracy (SD of sideline distances) for small suburban lots is two feet, and for large lots and metes and bounds parcels varies from two feet to twenty feet. In case of doubt, we recommend a Boundary Survey.

LEGEND

Shed (unsurveyed) [S] Blacktop Drive =====
Gravel Drive == == == Concrete =====


This is an improvements Location Survey only, and must not be used for Boundary purposes. No Title Report furnished. No statement is made as to ownership of property or right or interest therein. Fences are approximate only and may not be shown. Not to be used for construction purposes or permits of any kind whatsoever.

LH02-67-103 3813 IVORY RD GLENELG HOW 8/26/02 GOOZ Case#2002197

Fema Panel: 240044 0021B
Flood Zone: C
PARCEL OF LAND
1.869 AC +/-
Book: 5856
Folio: 340
Dist: 3
Co: HOWARD
MD
Scale 1" = 40'

10-25-04
NEED EXACT
MEASUREMENT
FROM PROPOSED
EXTENSION TO
S.T.
Well??

PLAN IS
TO SCALE
IVORY RD KN
30' R/W

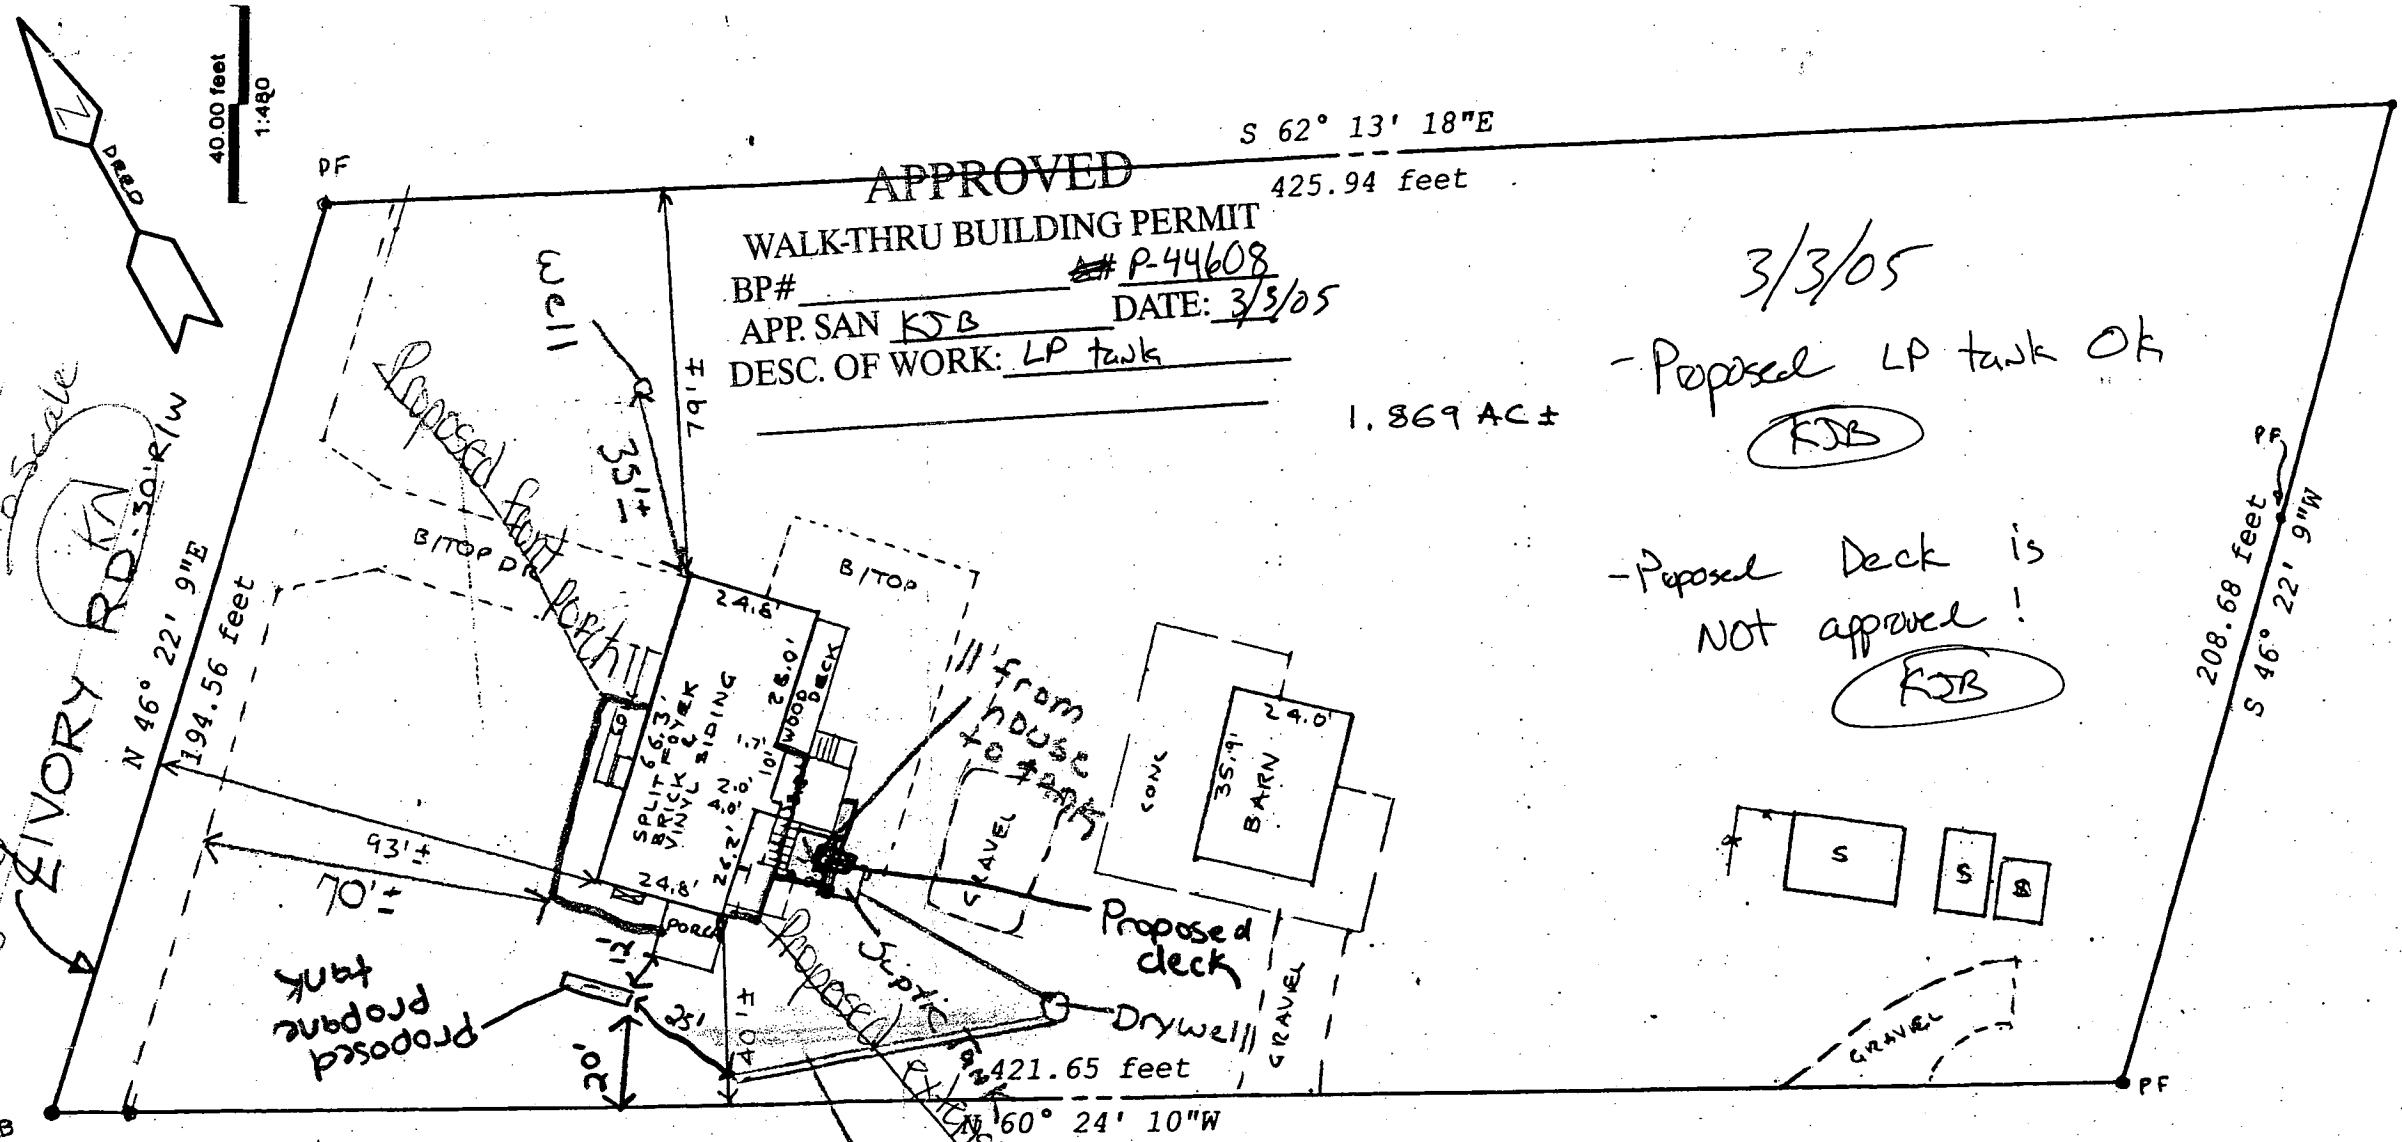

APPROVED
WALK-THRU BUILDING PERMIT
BP# # P-44608
APP. SAN KNB DATE: 3/3/05
DESC. OF WORK: LP tank

3/3/05
- Proposed LP tank OK
KNB
- Proposed Deck is
NOT approved!
KNB

10-27-04
Well and septic
setbacks met

Drain field
65' long
6' of gravel
EXTENSION ON REAR

APPROVED
WALK-THRU BUILDING PERMIT
BP# 150793 A# P44608
APP. SAN KN DATE: 10-27-04
DESC. OF WORK: porch
extensions



E mail: surveyassociates@erols.com

LOCATION
MORTGAGE
SURVEY

Large Lots: Boundaries on larger lots may not all be inspected.
Accuracy: Approximate average accuracy (SD of sideline distances) for small suburban lots is two feet, and for large lots and metes and bounds parcels varies from two feet to twenty feet. In case of doubt, we recommend a Boundary Survey.

LEGEND
Shed (unsurveyed) [S]
Gravel Drive == == == == Concrete == == == ==

This is an improvements Location Survey only, and must not be used for Boundary purposes. No Title Report furnished. No statement is made as to ownership of property or right or interest therein. Fences are approximate only and may not be shown. *Not to be used for construction purposes or permits of any kind whatsoever.*

SURVEY ASSOCIATES OF MARYLAND
4905 SUDLEY RD
WEST RIVER MARYLAND 20778
TEL 410 266 7211 FAX 410 266 0918
FAX BALTIMORE 410 841 6150
FAX METRO DC 301 970 2514

40.00 feet
1:480

S 62° 13' 18"E

APPROVED

425.94 feet

WALK-THRU BUILDING PERMIT

BP# 800152521 ~~#~~ P-44608

APP. SAN KJB DATE: 3/3/05

DESC. OF WORK: LP tank

1.869 AC ±


3/3/05

- Proposed LP tank OK

KJB

- Proposed Deck is NOT approved!

KJB

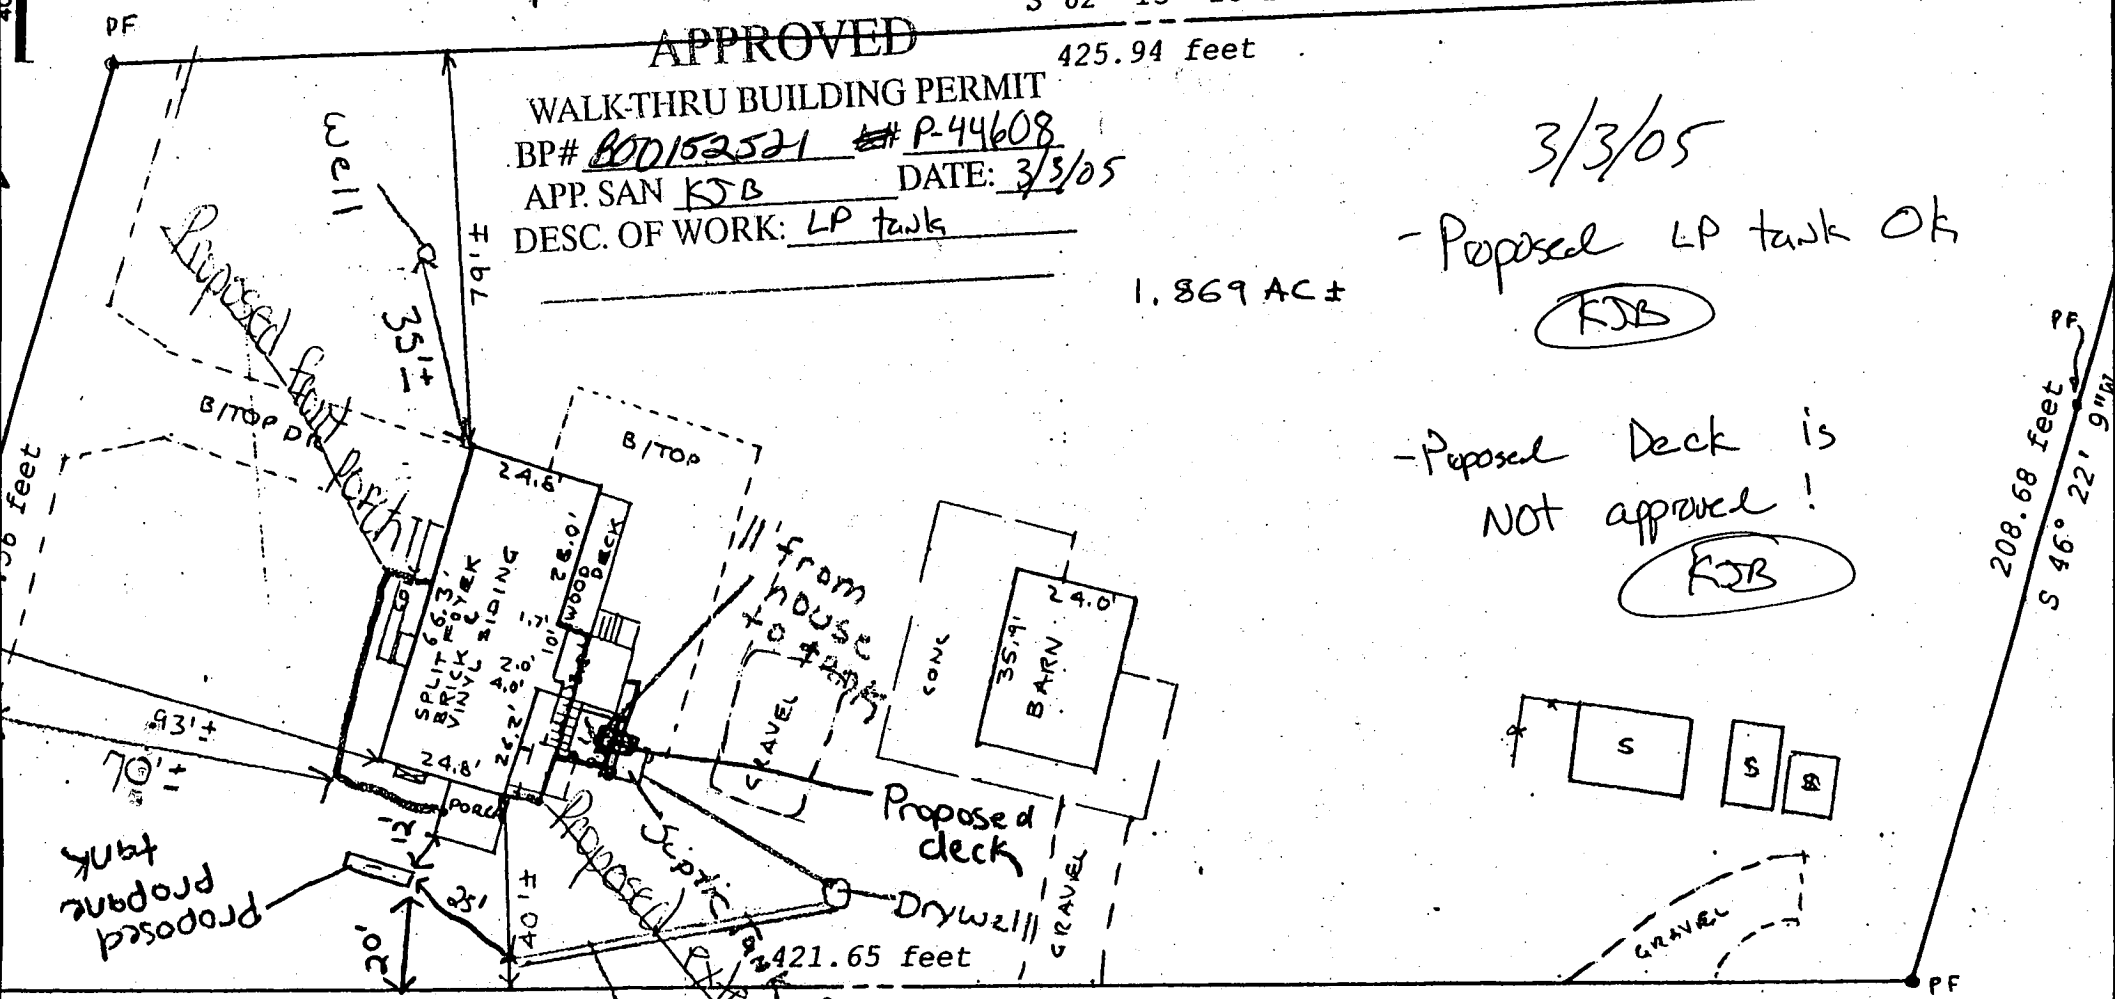

10-27-04
Well and septic
setbacks met

Drain field
6' x 65' long
Gravel

APPROVED

WALK-THRU BUILDING PERMIT

BP# 150793 A# P44608

APP. SAN KN DATE: 10-27-04

DESC. OF WORK: porch extensions



208.68 feet
S 46° 22' 9\"/>