

1/16/90 3PM
1/19/90 11:00

Tax ID - 04-344308??
316576

PERMIT

P 45713
A REPAIR

SEWAGE DISPOSAL SYSTEM
MARYLAND STATE DEPARTMENT OF HEALTH DISTRICT _____

HOWARD COUNTY
BUREAU OF ENVIRONMENTAL HEALTH
461-9933

DATE 10/24/89

INDEXED

DATE SYSTEM APPROVED 1/19/90

INSPECTOR M. R. J. King

Herman Sirk

IS PERMITTED TO INSTALL _____ ALTER X

ADDRESS 2555 Jennings Chapel Road, Woodbine, Maryland PHONE 489-4724

SUBDIVISION _____ ROAD 799 Long Corner Road LOT _____

PROPERTY OWNER _____ Haines - Street

ADDRESS _____ 799 Long Corner Road

IF GARBAGE GRINDER IS USED INCREASE SEPTIC TANK CAPACITY BY 50% AND ABSORPTION AREA BY 22%.

GARBAGE GRINDER? YES _____ NO _____

SEPTIC TANK CAPACITY _____ GALLONS NUMBER OF BEDROOMS 2

REPAIR - CALL FOR INSPECTION WHEN GROUND IS OPENED SO SANITARIAN CAN RECOMMEND REPAIR.

180 ABL Inlet 3' Bottom 9' 2' WIDE TRENCH
90' TRENCH

PLANS APPROVED BY C. Williams DATE 10/24/89

COVER NO WORK UNTIL INSPECTED AND APPROVED

NEITHER THE HOWARD COUNTY COUNCIL NOR THE HEALTH DEPARTMENT IS RESPONSIBLE FOR THE SUCCESSFUL OPERATION OF ANY SYSTEM

NOTE: CLEANOUT REQUIRED EVERY 70 FEET OF SEWER LINE AND/OR AT 90° SWEEPS IN LINES FROM HOUSE TO DRAIN FIELDS

NOTE: ALL PARTS OF SEPTIC SYSTEMS (I.E. TANK, DISTRIBUTION BOX, TRENCHES) TO BE 100 FEET FROM WELL (UNLESS OTHERWISE SPECIFICALLY AUTHORIZED)

NOTE: IF DEEP TRENCHES ARE USED CALL FOR INSPECTION BEFORE AND AFTER PLACING GRAVEL IN TRENCHES

NOTE: NO DRY WELL SHALL EXCEED 15 FOOT IN DIAMETER NO ABSORPTION TRENCH TO EXCEED 100 FEET IN LENGTH

NOTE: ALL PIPE FROM HOUSE TO SEPTIC TANK MUST BE CAST IRON OR SCHEDULE 40 PVC OR ABS

PERMIT VOID AFTER TWO YEARS


NOTE: INSTALL STAND PIPE ON SEPTIC TANK AND DRY WELL. STAND PIPES MUST BE 6 INCHES IN DIAMETER. CAST IRON, CONCRETE OR TERRA COTTA OR PVC OR ABS ACCEPTED. IF TOP OF SEPTIC TANK IS DEEPER THAN 3 FEET, MANHOLE TO GRADE REQUIRED

NOTE: DISTRIBUTION BOXES MUST HAVE BAFFLES

*INSTALLER IS RESPONSIBLE FOR OBTAINING FINAL APPROVAL ON THIS PERMIT

*CALL 461-9933 FOR INSPECTION OF SEPTIC SYSTEMS.

45713

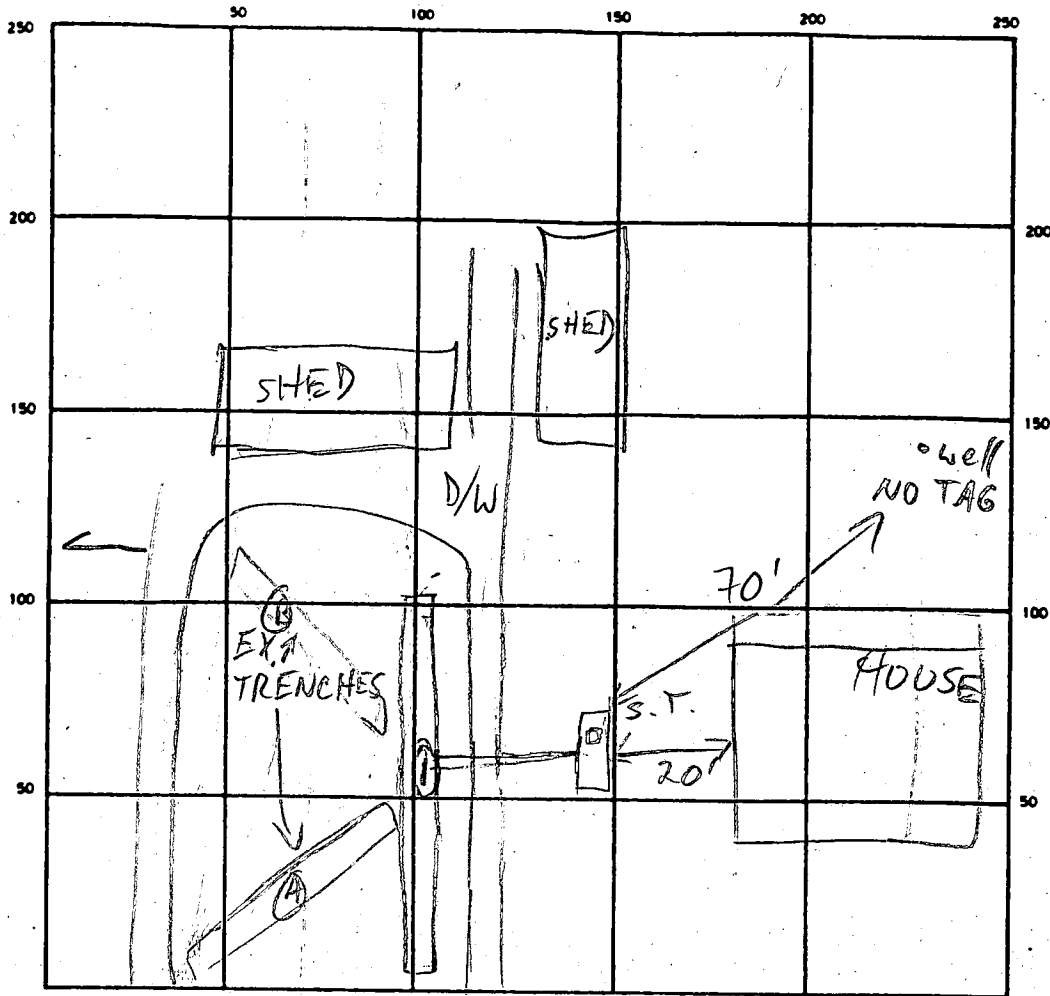

LONG CORNELL RD
INDICATE NORTH - NAME ADJOINING ROADWAY AS BASE LINE

SEPTIC TANK LEVEL OK-1000 GAL CINDER BLOCK CLEANOUTS OK

DISTRIBUTION BOX LEVEL ---

DRAIN FIELD/TILE FIELD. DEPTH 9 FT. TRENCH WIDTH 2 FT. INLET DEPTH 3 FT.

EFFECTIVE GRAVEL DEPTH 6 FT. TOTAL LENGTH 93 FT.

NUMBER OF TRENCHES 1 ONE SIDEWALL/BOTTOM AREA 558 SQ. FT.

DRYWELL INSIDE DIAMETER --- FT. EFFECTIVE DEPTH BELOW INLET --- FT.

ABSORBENT AREA --- SQ. FT.

REMARKS 1/16/90 EX. S.T. OK; EX. TRENCH (A) LEAKING ONTO ROAD, ESSENTIALLY RUNNING DOWNHILL TRENCH (B) SHOWS NO SIGNS OF USE, BUT INLET AT 2" - NOT ACCESSIBLE MR 1/19/90 OK TO COVER ALL; A "T" INSTALLED IN S.T. MR

DATE SYSTEM APPROVED 1/19/90 INSPECTOR M. Rifkin

INSTALLER IS RESPONSIBLE FOR OBTAINING FINAL APPROVAL ON THIS PERMIT

P 45 113

NOTE: DISTRIBUTION BOXES MUST HAVE Baffles

NOTE: INSTALL STAND PIPE ON SEPTIC TANK AND DRY WELL. STAND PIPES MUST BE 6 INCHES IN DIAMETER. CAST IRON, CONCRETE OR TERRA COTTA OR PVC OR ABS ACCEPTED. IF TOP OF SEPTIC TANK IS DEEPER THAN 3 FEET, MANHOLE TO GRADE REQUIRED

PERMIT VOID AFTER TWO YEARS

NOTE: ALL PIPE FROM HOUSE TO SEPTIC TANK MUST BE CAST IRON OR SCHEDULE 40 PVC OR ABS

NOTE: NO DRY WELL SHALL EXCEED 15 FOOT IN DIAMETER. NO ABSORPTION TRENCH TO EXCEED 100 FEET IN LENGTH

NOTE: IF DEEP TRENCH(IES) ARE USED CALL FOR INSPECTION BEFORE AND AFTER PLACING GRAVEL IN TRENCH(ES)

NOTE: ALL PARTS OF SEPTIC SYSTEMS (I.E. TANK, DISTRIBUTION BOX, TRENCHES) TO BE 100 FEET FROM WELL (UNLESS OTHERWISE SPECIFICALLY AUTHORIZED)

NOTE: CLEANOUT REQUIRED EVERY 70 FEET OF SEWER LINE AND/OR AT 90° SWEEPS IN LINES FROM HOUSE TO DRAIN FIELDS

NEITHER THE HOWARD COUNTY COUNCIL NOR THE HEALTH DEPARTMENT IS RESPONSIBLE FOR THE SUCCESSFUL OPERATION OF ANY SYSTEM

COVER NO WORK UNTIL INSPECTED AND APPROVED

PLANS APPROVED BY

C. Williams

DATE

10/24/89

180 gbl Inlet 3, Bottom 9', 2' WIDE TRENCH
90' TRENCH

REPAIR - CALL FOR INSPECTION WHEN GROUND IS OPENED SO SANITARIAN CAN RECOMMEND REPAIR.

SEPTIC TANK CAPACITY _____ GALLONS

NUMBER OF BEDROOMS 2

GARBAGE GRINDER? YES _____ NO _____

IF GARBAGE GRINDER IS USED INCREASE SEPTIC TANK CAPACITY BY 50% AND ABSORPTION AREA BY 22%

ADDRESS _____

PROPERTY OWNER
Haines - Street
799 Long Corner Road

SUBDIVISION _____

ROAD 799 Long Corner Road LOT _____

ADDRESS 2555 Jennings Chapel Road, Woodbine, Maryland

PHONE 489-4724

Herman Sirk

IS PERMITTED TO INSTALL _____

ALTER _____

X

HOWARD COUNTY
BUREAU OF ENVIRONMENTAL HEALTH
461-9933

INDEXED

INSPECTOR H.R. Kirk

DATE SYSTEM APPROVED 11/9/90

DATE 10/24/89

MARYLAND STATE DEPARTMENT OF HEALTH • DISTRICT _____

SEWAGE DISPOSAL SYSTEM

A REPAIR

PERMIT

P 45713

1/19/90 11:00

1/14/90 3pm

147 + D - 04 - 311302 27
316576