

5/18/90
WOOD
\$2,000

04-321162

File

5/18 (1) P.C.O.
C.B.D.

PERMIT

SEWAGE DISPOSAL SYSTEM

MARYLAND STATE DEPARTMENT OF HEALTH DISTRICT

HOWARD COUNTY
BUREAU OF ENVIRONMENTAL HEALTH
461-9933

P 46/21

A Resear

DATE 7/16/90

DATE SYSTEM APPROVED 5/18/90

INSPECTOR C.B.D.

INDEXED

J. Fyock

IS PERMITTED TO INSTALL _____ ALTER X

ADDRESS 13775 Tria Rd., Glenely, Md. PHONE 988-9270/286-7939

SUBDIVISION _____ ROAD 2460 McKendree Rd. LOT _____

PROPERTY OWNER Mr. Louis Taylor SUSAN + LARRY TAYLOR

ADDRESS 2460 McKendree Rd.

IF GARBAGE GRINDER IS USED INCREASE SEPTIC TANK CAPACITY BY 50% AND ABSORPTION AREA BY 22%.

GARBAGE GRINDER? YES _____ NO _____

SEPTIC TANK CAPACITY 1000 GALLONS NUMBER OF BEDROOMS (3)

See page (#1) - please.
C.B.D.

PLANS APPROVED BY Mr. "C.W." DATE 3/17/90

COVER NO WORK UNTIL INSPECTED AND APPROVED

NEITHER THE HOWARD COUNTY COUNCIL NOR THE HEALTH DEPARTMENT IS RESPONSIBLE FOR THE SUCCESSFUL OPERATION OF ANY SYSTEM

NOTE: CLEANOUT REQUIRED EVERY 70 FEET OF SEWER LINE AND/OR AT 90° SWEEPS IN LINES FROM HOUSE TO DRAIN FIELDS

NOTE: ALL PARTS OF SEPTIC SYSTEMS (I.E. TANK, DISTRIBUTION BOX, TRENCHES) TO BE 100 FEET FROM WELL (UNLESS OTHERWISE SPECIFICALLY AUTHORIZED)

NOTE: IF DEEP TRENCHES ARE USED CALL FOR INSPECTION BEFORE AND AFTER PLACING GRAVEL IN TRENCHES)

NOTE: NO DRY WELL SHALL EXCEED 15 FOOT IN DIAMETER NO ABSORPTION TRENCH TO EXCEED 100 FEET IN LENGTH.

NOTE: ALL PIPE FROM HOUSE TO SEPTIC TANK MUST BE CAST IRON OR SCHEDULE 40 PVC OR ABS

PERMIT VOID AFTER TWO YEARS

NOTE: INSTALL STAND PIPE ON SEPTIC TANK AND DRY WELL. STAND PIPES MUST BE 6 INCHES IN DIAMETER. CAST IRON, CONCRETE OR TERRA COTTA OR PVC OR ABS ACCEPTED. IF TOP OF SEPTIC TANK IS DEEPER THAN 3 FEET, MANHOLE TO GRADE REQUIRED


NOTE: DISTRIBUTION BOXES MUST HAVE BAFFLES

BLDG. PERMITS
AND RETURNED 8/23/01
B00131858. Garage w/
play room above den,
foyer, kit, ext.

*INSTALLER IS RESPONSIBLE FOR OBTAINING FINAL APROVAL ON THIS PERMIT

*CALL 461-9933 FOR INSPECTION OF SEPTIC SYSTEMS.

P46121 Repair 2640 McKendree Rd

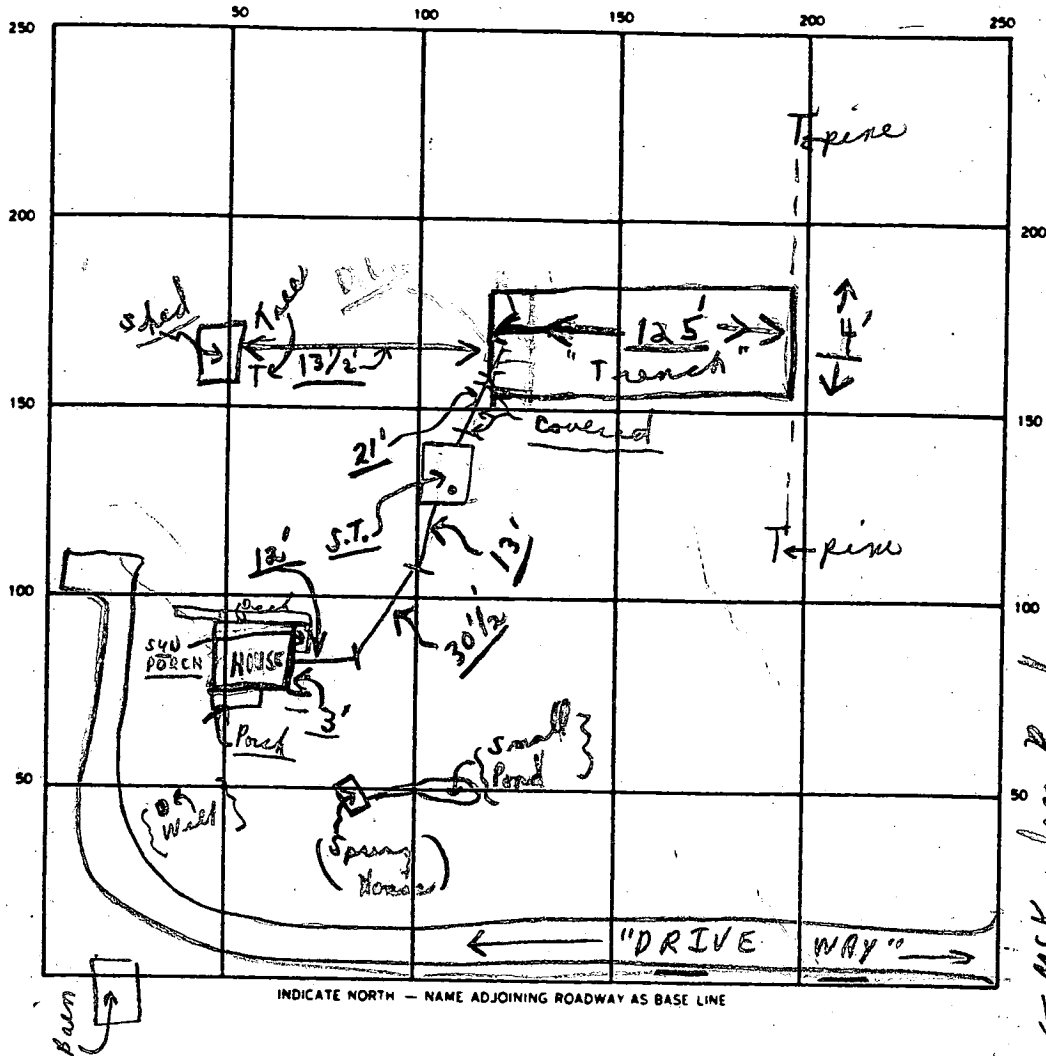

SEPTIC TANK LEVEL OK CLEANOUTS S.T. OK (TO CEMENT)

DISTRIBUTION BOX LEVEL (None)

DRAIN FIELD/TILE FIELD DEPTH 7 1/2' to 8' FT. TRENCH WIDTH 4 FT. INLET DEPTH 5 1/2' FT.

EFFECTIVE GRAVEL DEPTH 1 1/2' to 2' FT. TOTAL LENGTH 125 FT.

NUMBER OF TRENCHES 1 ONE SIDEWALL/BOTTOM AREA 500 SQ. FT.

DRYWELL INSIDE DIAMETER - FT. EFFECTIVE DEPTH BELOW INLET - FT.

ABSORBENT AREA 500 SQ. FT.

REMARKS 5/18/90 Partial - ok to cover from house to trench; ok for stones in trench only; first 50' of trench ready; c.B.S. 5/18/90 late p.m. - ok to cover as finish. File - Final.

[Drawing not to scale]

DATE SYSTEM APPROVED 5/18/90 INSPECTOR Charles Byers

Pg 2 of 2

P.M.
3/14
5/18/90

File

3/14 (1) P.C.O.
5/18 (1) P.C.O. C.B.D.
C.B.D.

PERMIT

SEWAGE DISPOSAL SYSTEM

MARYLAND STATE DEPARTMENT OF HEALTH DISTRICT _____

HOWARD COUNTY

BUREAU OF ENVIRONMENTAL HEALTH
461-9933

DATE 03/14/90
Late P.M.
DATE SYSTEM APPROVED 5/18/90
INSPECTOR C.B.D.

P _____
A REPAIR

Jack Fyock _____ IS PERMITTED TO INSTALL _____ ALTER X

ADDRESS 13775 Triadelphia Road, Glenelg, Md. 21737 PHONE 988-9270/286-2939

SUBDIVISION _____ ROAD 2460 McKendree Road LOT _____

PROPERTY OWNER Mr. Louis Taylor

ADDRESS 2460 McKendree Road
West Friendship, Maryland 21794


~~IF GARBAGE GRINDER IS USED INCREASE SEPTIC TANK CAPACITY BY 50% AND ABSORPTION AREA BY 20%~~

~~SANITARY GRINDER XXXXX YES XXXXXXXXXXXXXXXXXX~~

SEPTIC TANK CAPACITY 1000 GALLONS NUMBER OF BEDROOMS (3)

REPAIR - CALL FOR INSPECTION WHEN GROUND IS OPENED SO SANITARIAN CAN RECOMMEND REPAIR.

30' to 40' off fence - to rear of house
4' wide - 125' long 1 trench 4' hill
depth shallow as can be - (8' to 9')
1 1/2' of stone under pipe, pipe near center
(trench) pit both at start of trench. C.B.D.

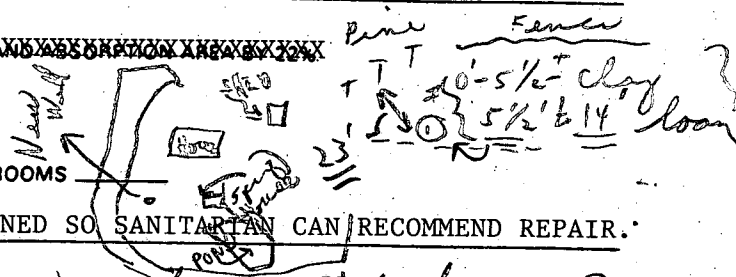

PLANS APPROVED BY Craig Williams CM DATE 03/14/90

COVER NO WORK UNTIL INSPECTED AND APPROVED

NEITHER THE HOWARD COUNTY COUNCIL NOR THE HEALTH DEPARTMENT IS RESPONSIBLE FOR THE SUCCESSFUL OPERATION OF ANY SYSTEM


- NOTE: CLEANOUT REQUIRED EVERY 70 FEET OF SEWER LINE AND/OR AT 90° SWEEPS IN LINES FROM HOUSE TO DRAIN FIELDS
- NOTE: ALL PARTS OF SEPTIC SYSTEMS (I.E. TANK, DISTRIBUTION BOX, TRENCHES) TO BE 100 FEET FROM WELL (UNLESS OTHERWISE SPECIFICALLY AUTHORIZED)
- NOTE: IF DEEP TRENCHES ARE USED CALL FOR INSPECTION BEFORE AND AFTER PLACING GRAVEL IN TRENCHES
- NOTE: NO DRY WELL SHALL EXCEED 15 FOOT IN DIAMETER NO ABSORPTION TRENCH TO EXCEED 100 FEET IN LENGTH.
- NOTE: ALL PIPE FROM HOUSE TO SEPTIC TANK MUST BE CAST IRON OR SCHEDULE 40 PVC OR ABS
- PERMIT VOID AFTER TWO YEARS
- NOTE: INSTALL STAND PIPE ON SEPTIC TANK AND DRY WELL. STAND PIPES MUST BE 6 INCHES IN DIAMETER. CAST IRON, CONCRETE OR TERRA COTTA OR PVC OR ABS ACCEPTED. IF TOP OF SEPTIC TANK IS DEEPER THAN 3 FEET, MANHOLE TO GRADE REQUIRED
- NOTE: DISTRIBUTION BOXES MUST HAVE BAFFLES

*INSTALLER IS RESPONSIBLE FOR OBTAINING FINAL APPROVAL ON THIS PERMIT

*CALL 461-9933 FOR INSPECTION OF SEPTIC SYSTEMS.

P 46121 Repair

2640 McKendree Rd

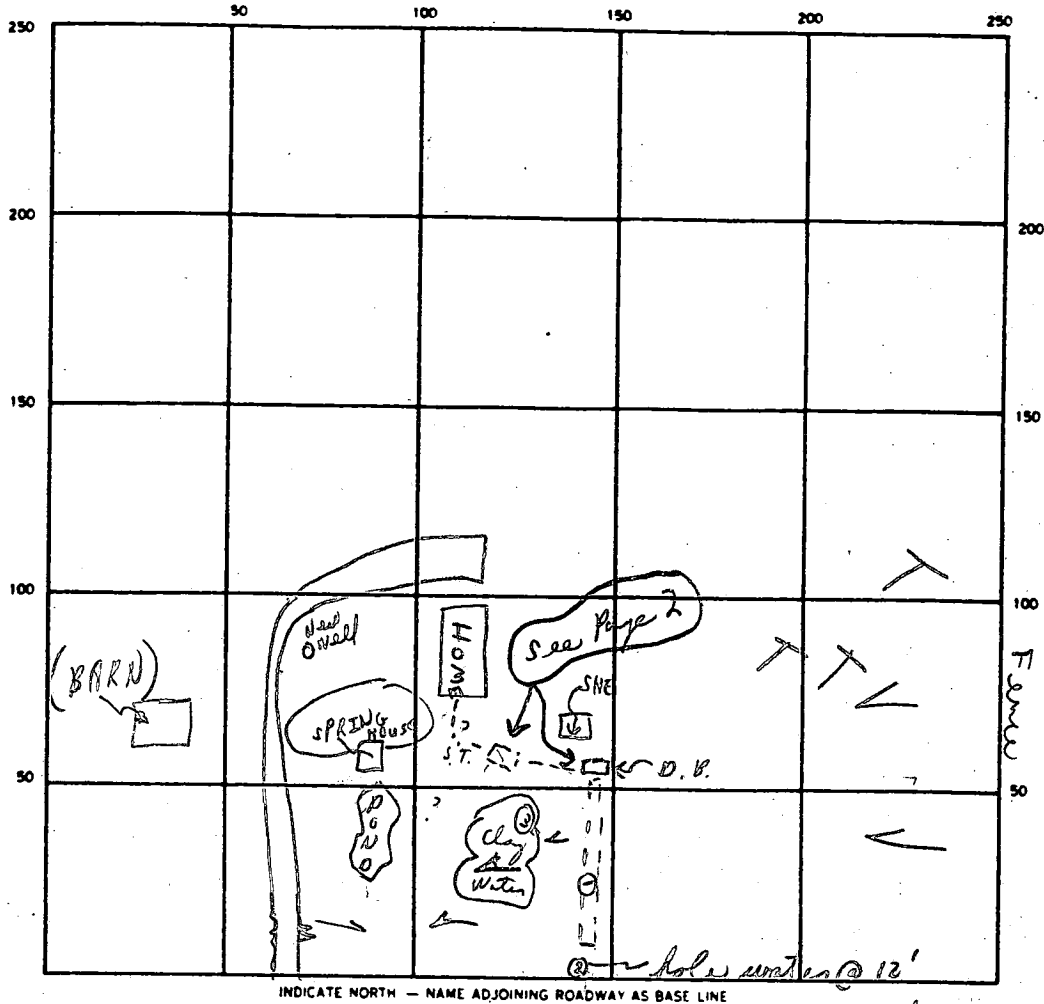

3/14

(New one to be installed)

McKendree Rd.

Need (?) in line C.O. may be needed

SEPTIC TANK LEVEL CLEANOUTS S.T.

DISTRIBUTION BOX LEVEL

DRAIN FIELD/TILE FIELD DEPTH 11 (maximum) FT. TRENCH WIDTH 4 FT. INLET DEPTH 86.9 FT. * (existing house)

EFFECTIVE GRAVEL DEPTH 1 1/2 - 2' FT. TOTAL LENGTH 125 FT.


NUMBER OF TRENCHES 1 ONE SIDEWALL/BOTTOM AREA 500 SQ. FT.

DRYWELL INSIDE DIAMETER FT. EFFECTIVE DEPTH BELOW INLET FT.

ABSORBENT AREA 500 SQ. FT.

REMARKS partial - 3/14/90 locate trench near "D" hole on high
area of lot. Note: * existing house + plumber to
put system in the hill without a pump, away from
ground w/ high water table; ok to continue C.B.D.
(C) 5/18 see page 2.
= C.B.D

DATE SYSTEM APPROVED _____ INSPECTOR _____

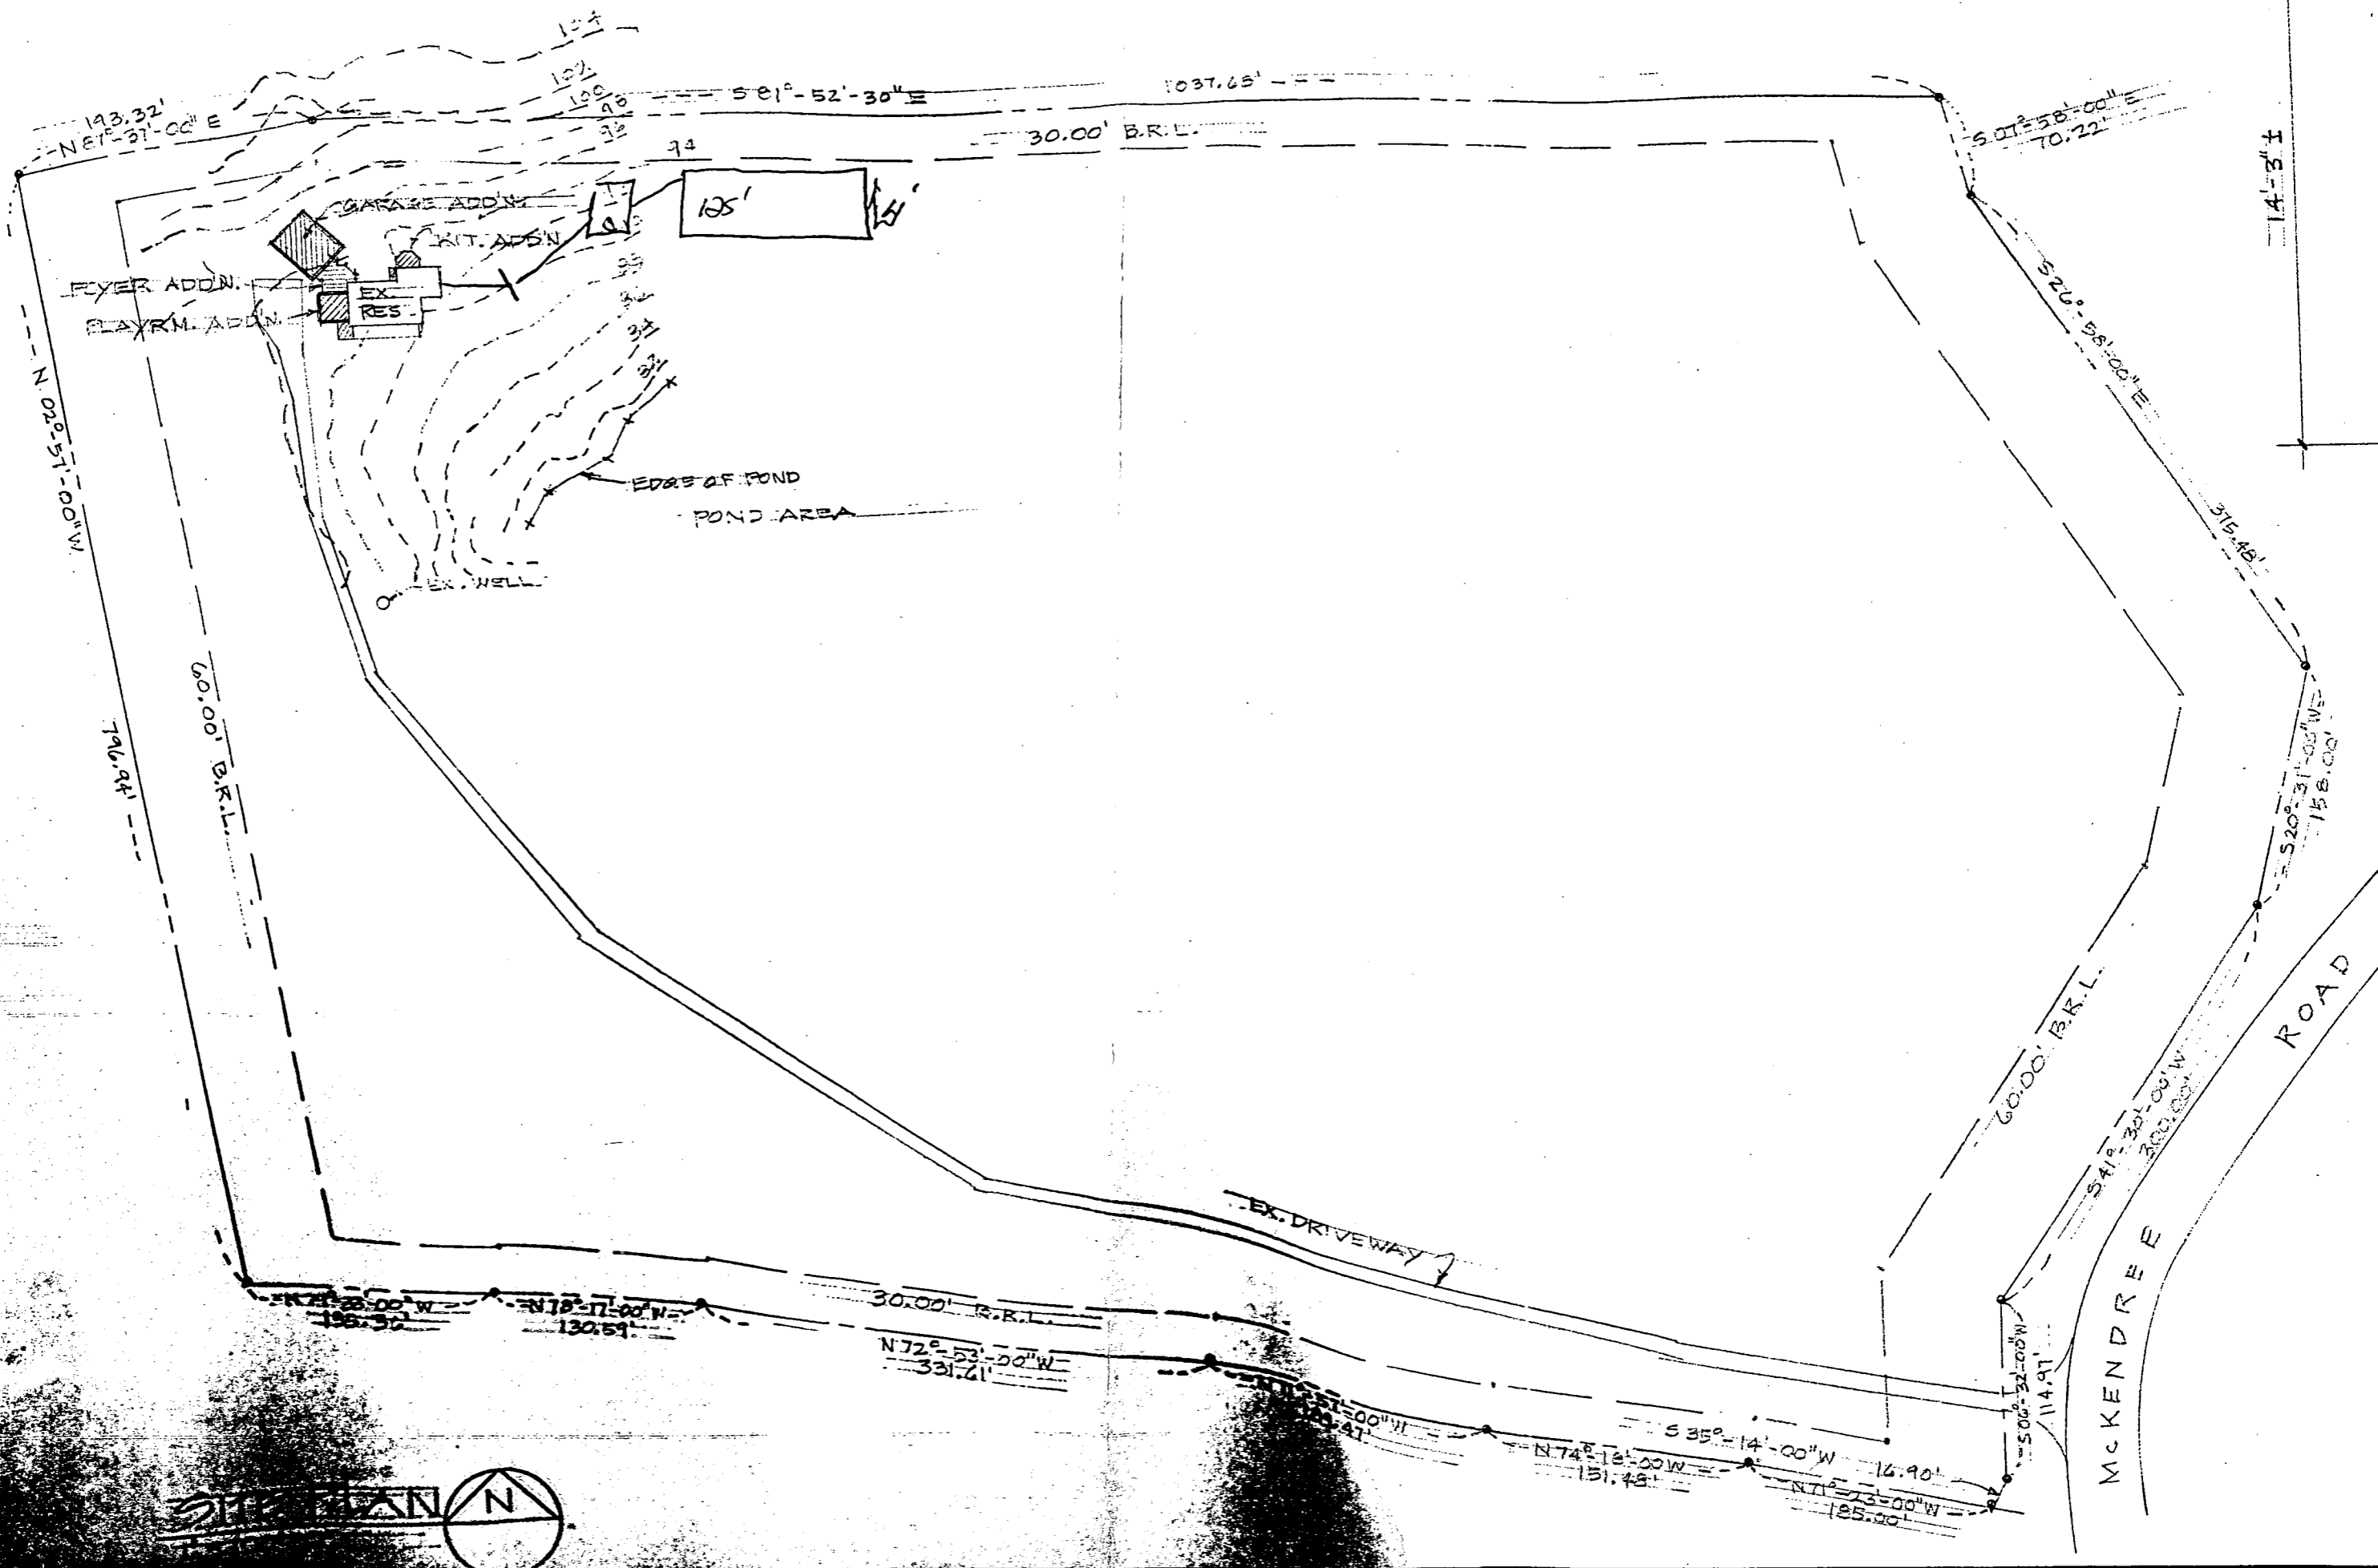

GARAGE
ADD'N

FOYER
ADD'N

1" = 10'

1 BR ADDED, 1 BR DELETED


NO SEPTIC REPAIR REQ'D

OR FOR BR (MR)

8/23/07

PLAYROOM

W/O FIRE
EGRESS
WINDOWS
(NOT A
BR)

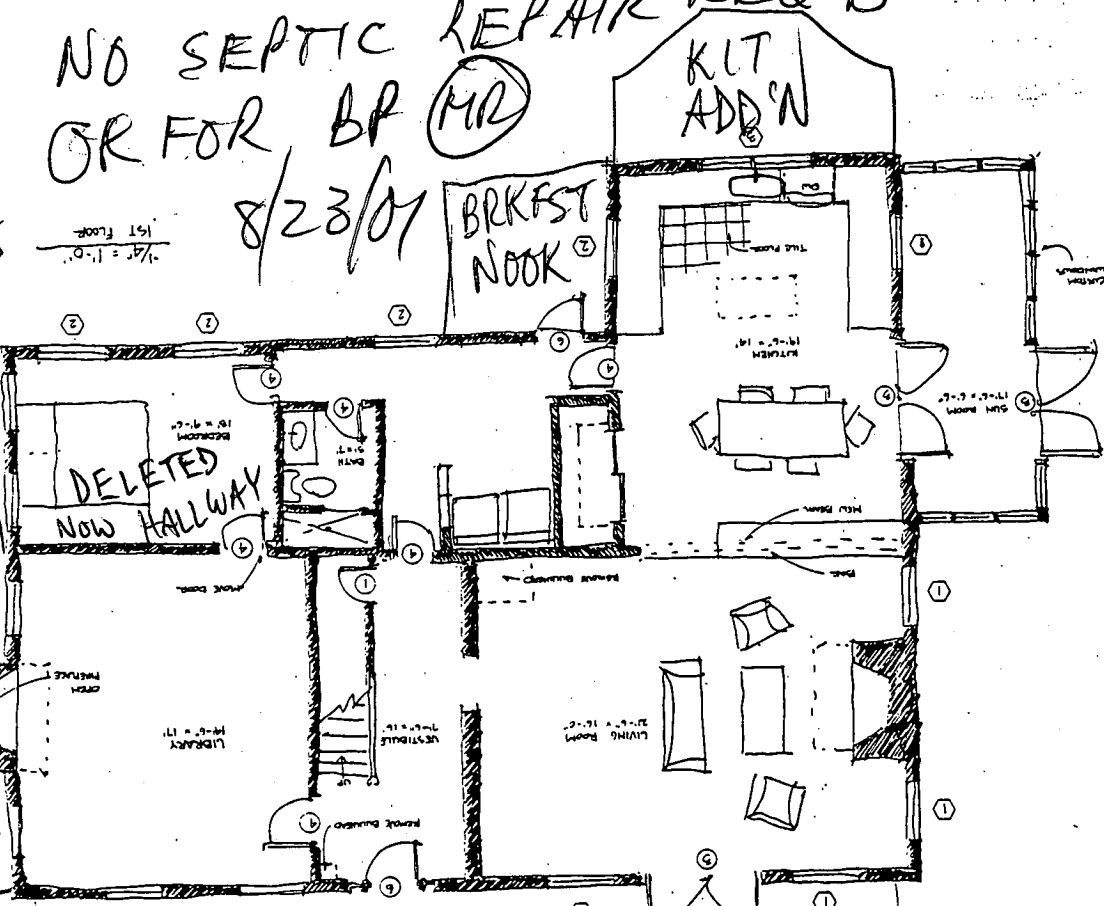


1" = 10'


1" = 10'

BR #3
ADDN OVER GARAGE



- WINDOW SCHEDULE
1. EXISTING
 2. NEW WINDOW
 3. NEW DOOR
 4. NEW TRAIL
 5. F.M.
- DOOR SCHEDULE
1. EXISTING
 2. POCKET DOOR
 3. SLIDING DOOR
 4. 2'-6"
 5. 3'-0"
1. WINDOW SCHEDULE

2nd Floor
1/4" = 1'-0"

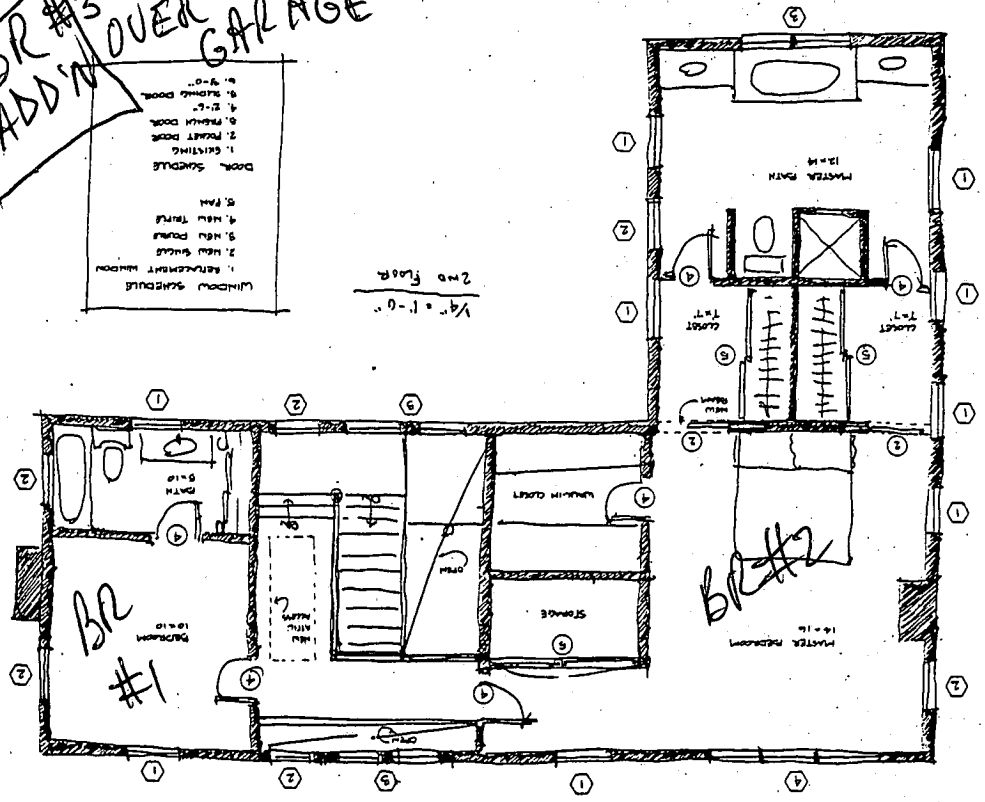

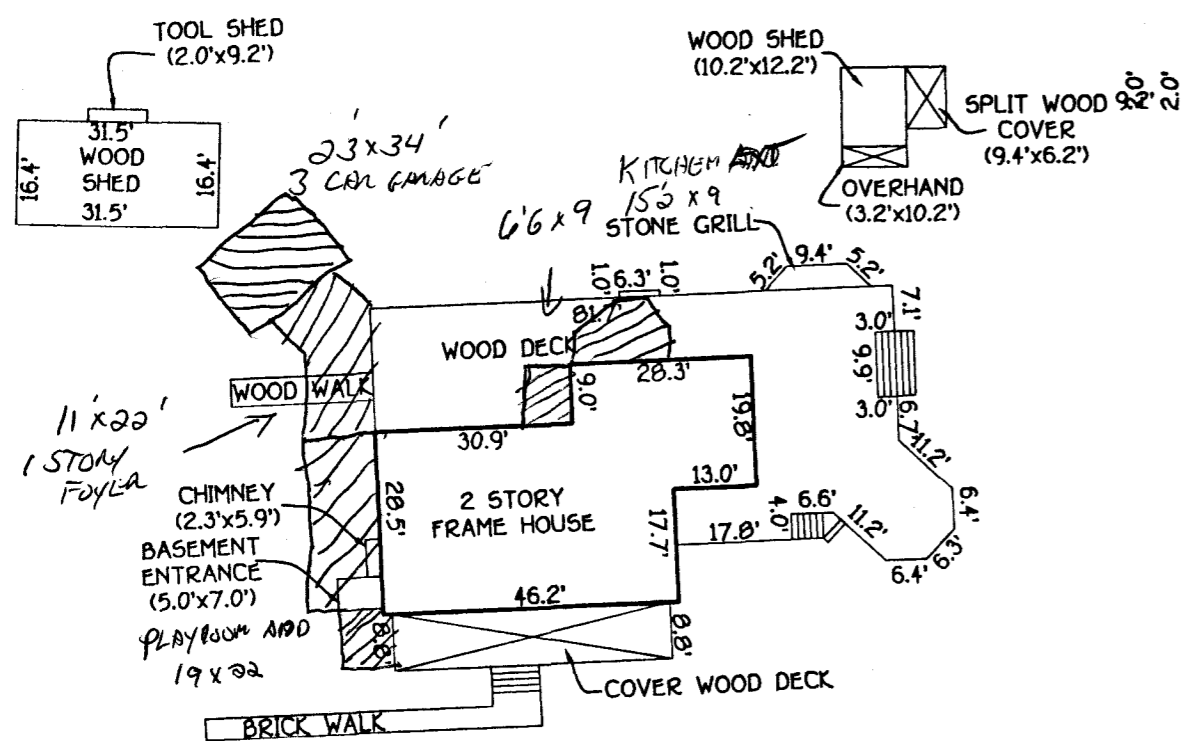

DETAIL
1"=30'

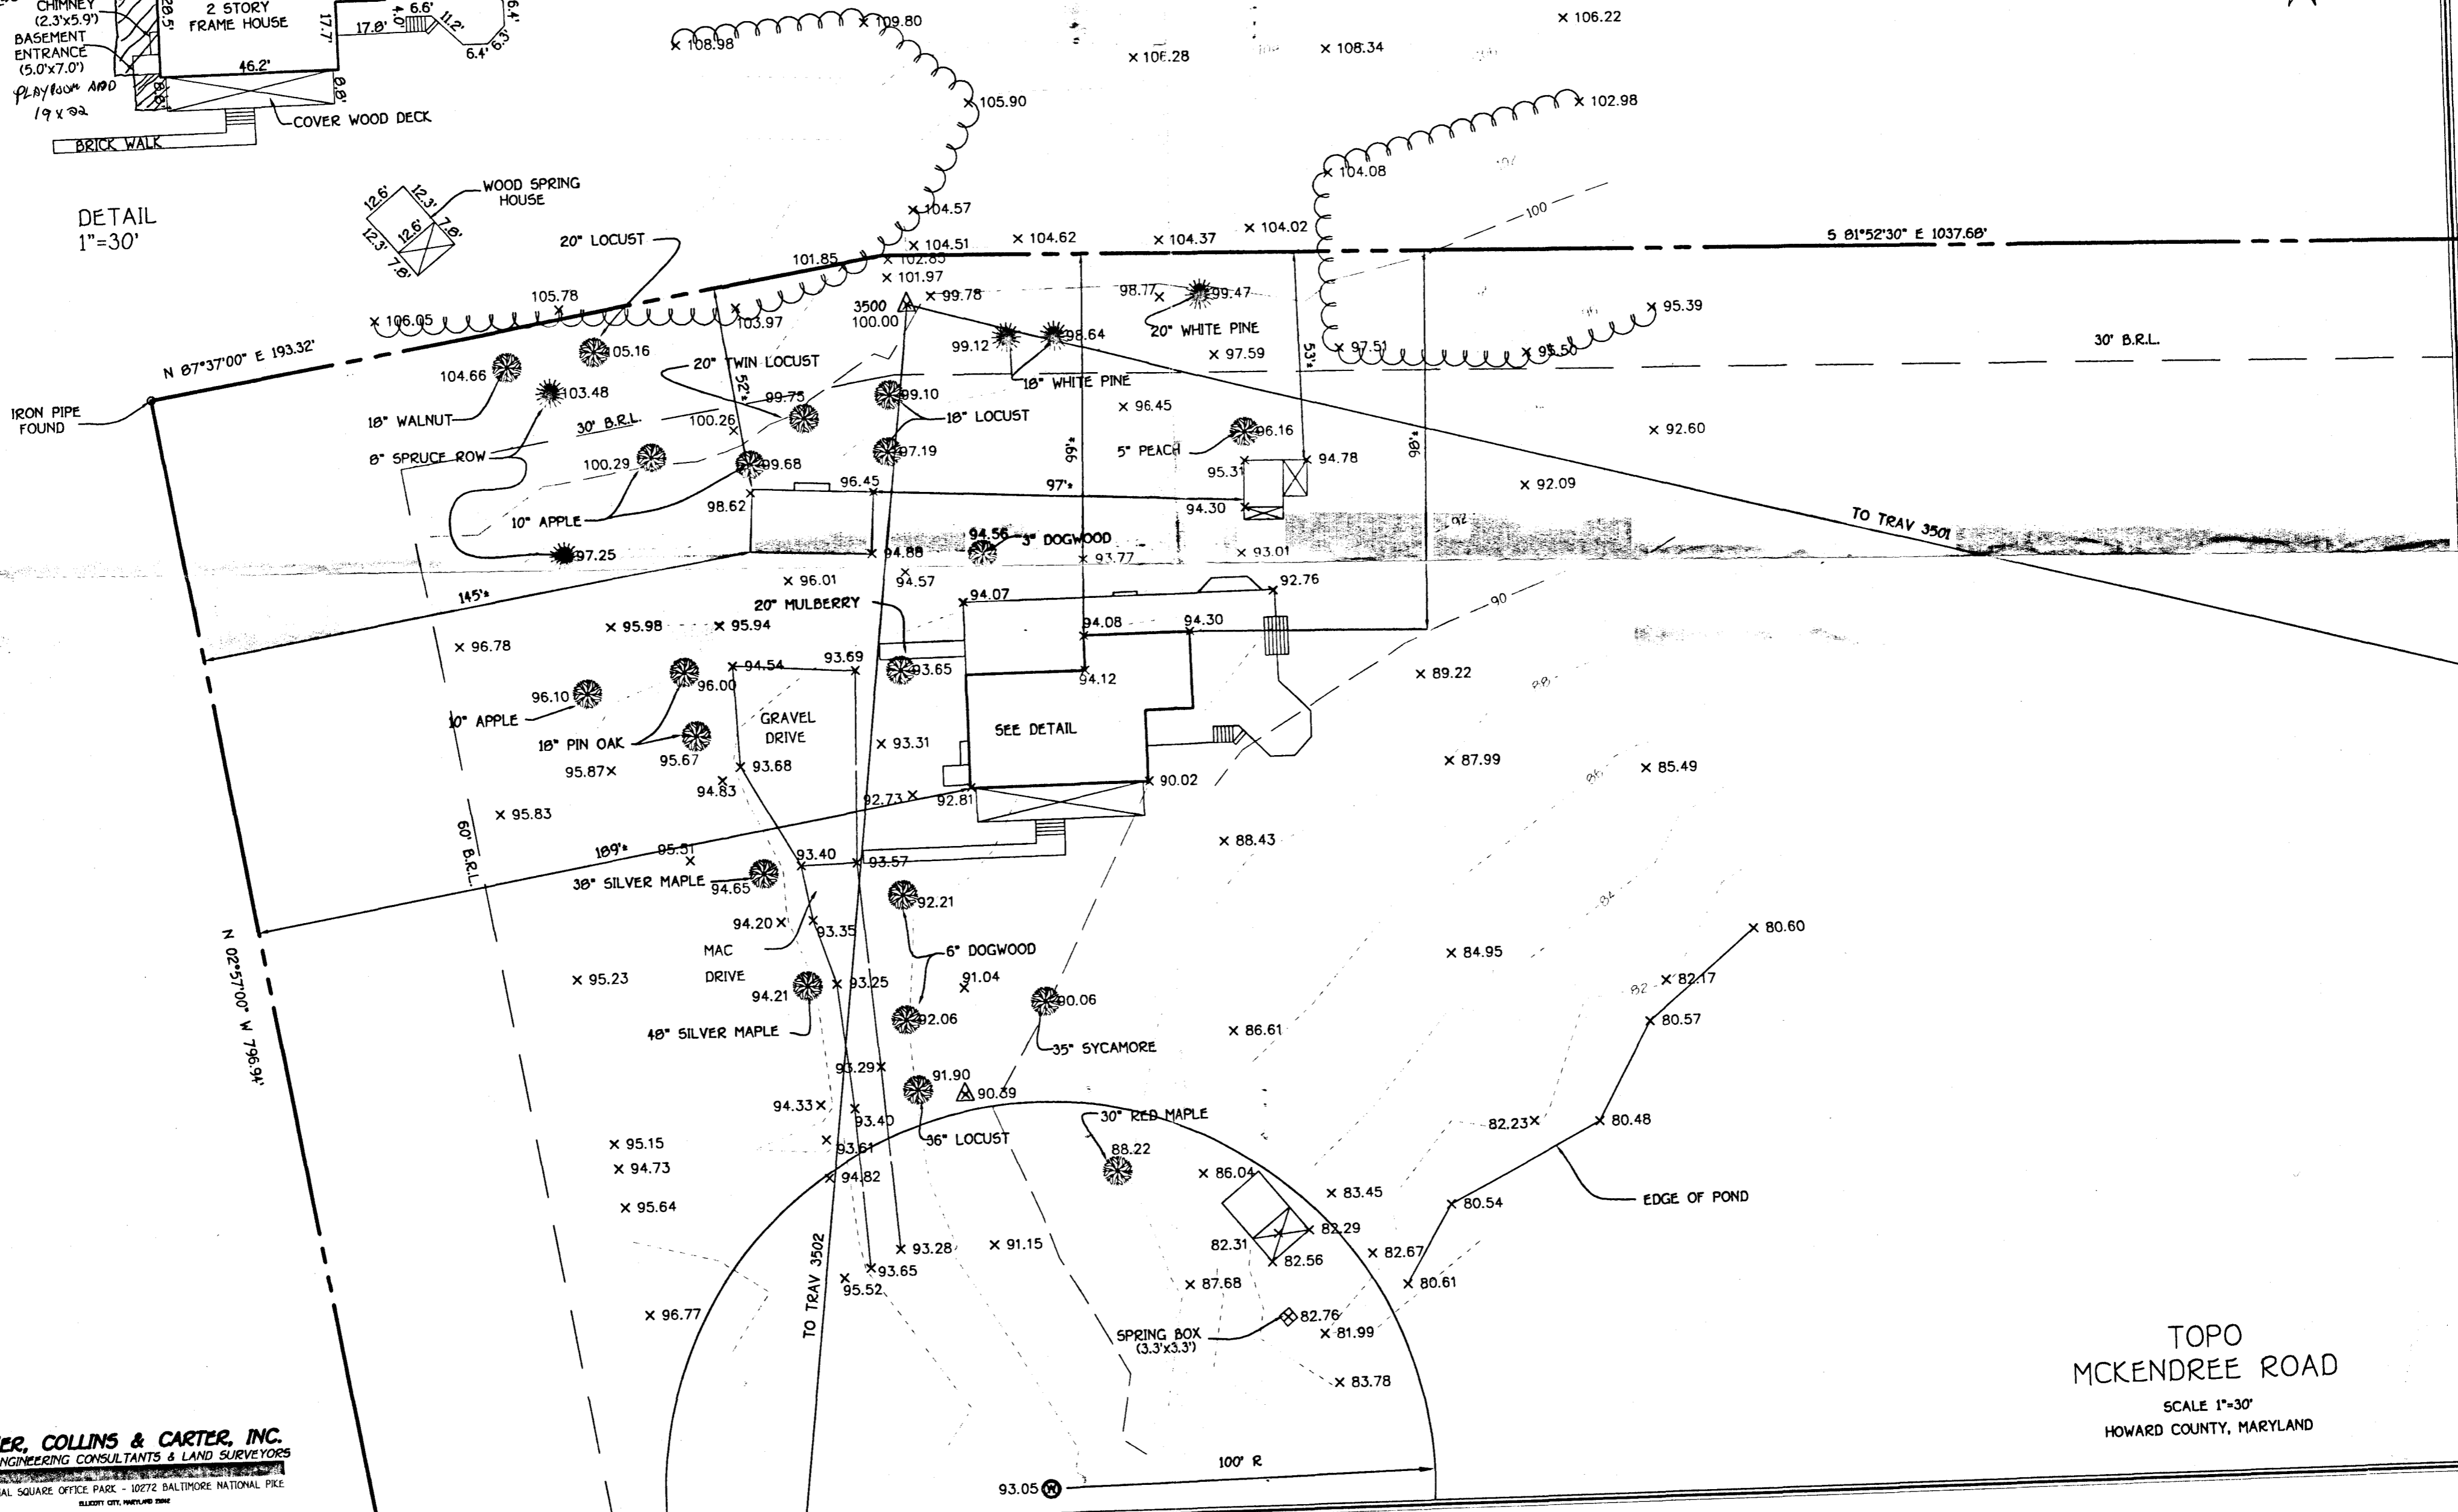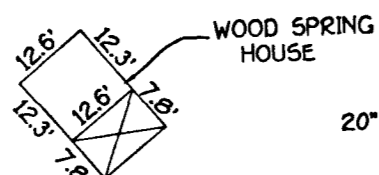

TOPO
MCKENDREE ROAD
SCALE 1"=30'
HOWARD COUNTY, MARYLAND

FISHER, COLLINS & CARTER, INC.
CIVIL ENGINEERING CONSULTANTS & LAND SURVEYORS
CENTENNIAL SQUARE OFFICE PARK - 10272 BALTIMORE NATIONAL PIKE
BELTSVILLE CITY, MARYLAND 20814
410-381-1000

W:\Drawings 6\161647 Mckendree Road\61647 30 scale Topo.dwg