

6/5/91
6/6/91

PERMIT

SEWAGE DISPOSAL SYSTEM

DEPARTMENT OF HEALTH AND MENTAL HYGIENE

5/24/91 No STOP
6/5/91 P.C.O. C.B.D.
P 47141
A REPAIR

HOWARD COUNTY HEALTH DEPARTMENT
BUREAU OF ENVIRONMENTAL HEALTH
461-9933

316010

INDEXED

DISTRICT _____

DATE 5/23/91

DATE SYSTEM APPROVED 6/6/91

INSPECTOR C.B.D.

Herman Sirk _____ IS PERMITTED TO INSTALL _____ ALTER X

ADDRESS 2555 Jennings Chapel Road, Woodbine, Maryland PHONE 489-4724

SUBDIVISION _____ LOT _____ ROAD 2445 Jennings Chapel Road

PROPERTY OWNER Virginia Smith & Jeannie Carter
ADDRESS 2445 Jennings Chapel Road

SEPTIC TANK CAPACITY 1000 GALLONS

NUMBER OF BEDROOMS 3

130⁺ SQUARE FEET PER BEDROOM

LINEAR FEET OF TRENCH REQUIRED 50' to 60'

[(?) 6/5/91 Not seen]

REPAIR - PURPOSE - Existing septic system has failed (drywell full) C.B.D.

Call for inspection when ground is opened so sanitarian can recommend repair.

6/5/91 (1) Trench - 50'+ Long; 2' Wide; 9' deep; Outlet 3"
at inlet - 6' of stone; 390'+ in ft. absorption sidewall area
C.B.D. needed. Trench to be connected to existing
septic tanks. → C.B.D. for Mr. C.W. "See books"

PLANS APPROVED BY Mark Rifkin DATE 5/21/91

COVER NO WORK UNTIL INSPECTED AND APPROVED

NEITHER THE HOWARD COUNTY COUNCIL NOR THE HEALTH DEPARTMENT IS RESPONSIBLE FOR THE SUCCESSFUL OPERATION OF ANY SYSTEM

NOTE: CLEANOUT REQUIRED EVERY 70 FEET OF SEWER LINE AND/OR AT 90° SWEEPS IN LINES FROM HOUSE TO DRAIN FIELDS, 90° ELBOWS NOT ACCEPTABLE.

NOTE: ALL PARTS OF SEPTIC SYSTEMS (I.E. TANK, DISTRIBUTION BOX TRENCHES) TO BE 100 FEET FROM WELL (UNLESS OTHERWISE SPECIFICALLY AUTHORIZED)

NOTE: IF DEEP TRENCH(ES) ARE USED CALL FOR INSPECTION BEFORE AND AFTER PLACING GRAVEL IN TRENCH(ES)

NOTE: NO DRY WELL SHALL EXCEED 15 FOOT IN DIAMETER NO ABSORPTION TRENCH TO EXCEED 100 FEET IN LENGTH

NOTE: ALL PIPE FROM HOUSE TO SEPTIC TANK MUST BE CAST IRON OR SCHEDULE 35/40 PVC OR ABS


PERMIT VOID AFTER TWO YEARS

NOTE: INSTALL STAND PIPE ON SEPTIC TANK AND DRY WELL STAND PIPES MUST BE 6 INCHES IN DIAMETER CAST IRON. CONCRETE OR TERRA COTTA OR PVA OR ABS ACCEPTED. IF TOP OF SEPTIC TANK IS DEEPER THAN 3 FEET. MANHOLE TO GRADE REQUIRED.

NOTE: DISTRIBUTION BOXES MUST HAVE BAFFLES

***INSTALLER IS RESPONSIBLE FOR OBTAINING FINAL APPROVAL ON THIS PERMIT**

P 47141
H/L/H

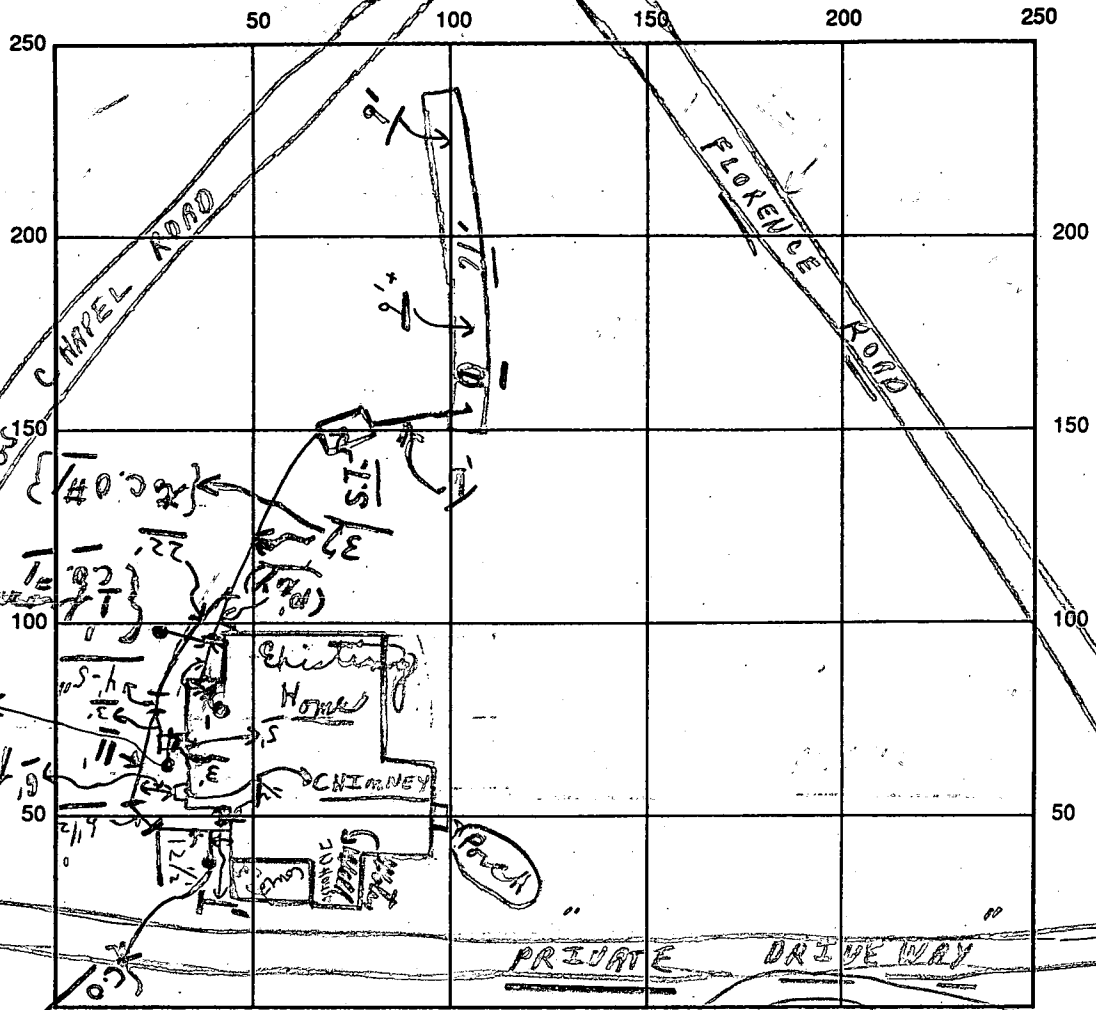

INDICATE NORTH - NAME ADJOINING ROADWAY AS BASE LINE

SEPTIC TANK LEVEL	Existing	CLEANOUTS	C.O. #1	C.O. #2	C.O. #3	S.T.
			OK	OK	OK	C.O. ok ✓

DISTRIBUTION BOX LEVEL Existing septic tank

DRAIN FIELD/TITLE DEPTH 9' average FT. TRENCH WIDTH 2 FT. INLET DEPTH 3 FT.

EFFECTIVE GRAVEL DEPTH 6 FT. TOTAL LENGTH 91 FT.

NUMBER OF TRENCHES 1 ONE SIDEWALL/FOUNDATION AREA 426 SQ. FT.

DRYWALL INSIDE DIAMETER FT. EFFECTIVE DEPTH BELOW INLET FT.

ABSORBENT AREA 426 SQ. FT.

REMARKS: P.M. 6/5/91 Partial - ok for stone in trench - only
6/6/91 NOON - Final ok to cover all work - all completed.

DATE SYSTEM APPROVED 6/6/91 INSPECTOR Charles Bryan Stecker