

11-15-96  
12:00 C.O.  
11-18-96  
12:00 C.O.

# PERMIT

## SEWAGE DISPOSAL SYSTEM

### DEPARTMENT OF HEALTH AND MENTAL HYGIENE

INDEXED

P 57347-A

A 49636

DISTRICT 4th

DATE 10-21-96

#### HOWARD COUNTY HEALTH DEPARTMENT

BUREAU OF ENVIRONMENTAL HEALTH

XXXXXXX 313-2640

DATE SYSTEM APPROVED 11/18/96

INSPECTOR ALM

04-356373

Pettit & Griffin, Inc./South Carroll Backhoe, Inc. IS PERMITTED TO INSTALL  ALTER

ADDRESS 18205-D Flower Hill Way Gaithersburg, MD 20879 PHONE (301) 875-4197  
975-1020

SUBDIVISION Gwyndyl Oak Estates LOT 40 ROAD 2650 McKendree Road

PROPERTY OWNER Wheeler Development, Inc. John + Karen Kortkamp

ADDRESS

SEPTIC TANK CAPACITY 1250 GALLONS

NUMBER OF BEDROOMS 4

180 SQUARE FEET PER BEDROOM

LINEAR FEET OF TRENCH REQUIRED 180

BLDG. PERMIT SIGNED

AND RETURNED 3/27/97

Serial # B10104536  
deck

TRENCHES - Trench to be 2 feet wide. Inlet 3 feet below original grade. Bottom maximum depth 7 feet below original grade. Effective area begins at 3 feet below original grade. 4 feet of stone below distribution pipe.

LOCATION - Beginning from the intersection of the left and front lot lines, place the distribution box 140 feet down the front lot line (180.00) and 45 feet off that same lot line when facing the lot from McKendree Road. Run trenches on contour toward the front lot line.

NOTES - No trench to exceed 100 feet in length. Provide 6" - 8" diameter cleanout and cap to grade or above on septic tank. OK 9/5/96 DKS

PLANS APPROVED BY Amy McMillen/Glen Savage DATE 08/28/96

COVER NO WORK UNTIL INSPECTED AND APPROVED

NEITHER THE HOWARD COUNTY COUNCIL NOR THE HEALTH DEPARTMENT IS RESPONSIBLE FOR THE SUCCESSFUL OPERATION OF ANY SYSTEM

NOTE: CLEANOUT REQUIRED EVERY 70 FEET OF SEWER LINE AND/OR AT 90° SWEEPS IN LINES FROM HOUSE TO DRAIN FIELDS, 90° ELBOWS NOT ACCEPTABLE.

NOTE: ALL PARTS OF SEPTIC SYSTEMS (I.E. TANK, DISTRIBUTION BOX TRENCHES) TO BE 100 FEET FROM WELL (UNLESS OTHERWISE SPECIFICALLY AUTHORIZED)

NOTE: IF DEEP TRENCH(ES) ARE USED CALL FOR INSPECTION BEFORE AND AFTER PLACING GRAVEL IN TRENCH(ES)

NOTE: NO DRY WELL SHALL EXCEED 15 FOOT IN DIAMETER NO ABSORPTION TRENCH TO EXCEED 100 FEET IN LENGTH

NOTE: ALL PIPE FROM HOUSE TO SEPTIC TANK MUST BE CAST IRON OR SCHEDULE 35/40 PVC OR ABS

PERMIT VOID AFTER TWO YEARS

NOTE: INSTALL STAND PIPE ON SEPTIC TANK AND DRY WELL STAND PIPES MUST BE 6 INCHES IN DIAMETER CAST IRON. CONCRETE OR TERRA COTTA OR PVA OR ABS ACCEPTED. IF TOP OF SEPTIC TANK IS DEEPER THAN 3 FEET. MANHOLE TO GRADE REQUIRED.

NOTE: DISTRIBUTION BOXES MUST HAVE BAFFLES

**\*INSTALLER IS RESPONSIBLE FOR OBTAINING FINAL APPROVAL ON THIS PERMIT**

A 49636



# APPLICATION

PERCOLATION TESTING

A 2  
P \_\_\_\_\_

HOWARD COUNTY HEALTH DEPARTMENT  
BUREAU OF ENVIRONMENTAL HEALTH  
3525-H ELLICOTT MILLS DRIVE/ELLICOTT CITY, MARYLAND 21043  
TELEPHONE: 313-2640

DISTRICT \_\_\_\_\_  
DATE \_\_\_\_\_

TO: THE COUNTY HEALTH OFFICER  
ELLICOTT CITY, MARYLAND

I HEREBY APPLY FOR THE NECESSARY TEST PRIOR TO APPLICATION FOR PERMIT TO CONSTRUCT (OR RECONSTRUCT) A SEWAGE DISPOSAL SYSTEM.

PROPERTY OWNER Wheeler Development, Inc.

ADDRESS \_\_\_\_\_ PHONE \_\_\_\_\_

AGENT OR PROSPECTIVE BUYER \_\_\_\_\_

ADDRESS \_\_\_\_\_ PHONE \_\_\_\_\_

PROPERTY LOCATION:

SUBDIVISION MCKENDREE ESTATES LOT NO. X (Replacement for lot near 7)

ROAD AND DESCRIPTION (2050 MCKENDREE ROAD)

TAX MAP \_\_\_\_\_ PARCEL # \_\_\_\_\_

SIZE OF LOT \_\_\_\_\_ TYPE BLDG. \_\_\_\_\_  
(SINGLE FAMILY DWELLING OR COMMERCIAL)

BLDG. PERMIT SIGNED  
AND RETURNED 8/28/96  
Serial # BR 01876-5FD  
4Bm

THE SYSTEM INSTALLED UNDER THIS APPLICATION IS ACCEPTABLE ONLY UNTIL PUBLIC FACILITIES BECOME AVAILABLE. I FULLY UNDERSTAND THE FEE CONNECTED WITH THE FILING OF THIS PERC TEST APPLICATION IS NON-REFUNDABLE UNDER ANY CIRCUMSTANCES. I ALSO AGREE TO COMPLY WITH ALL M.O.S.H.A. REQUIREMENTS IN TESTING THIS LOT.

(SIGNATURE OF APPLICANT)

APPROVED BY \_\_\_\_\_ FOR \_\_\_\_\_ DATE \_\_\_\_\_

DISAPPROVED BY \_\_\_\_\_ FOR \_\_\_\_\_ DATE \_\_\_\_\_

HOLD PENDING FURTHER TESTS \_\_\_\_\_

REASONS FOR REJECTION OR HOLDING \_\_\_\_\_

BLDG. PERMIT SIGNED  
AND RETURNED 11/24/96  
Serial # BR 103199  
perpetual

PERCOLATION TEST PLAT/PRELIMINARY PLAT - TITLE OR I.D. # \_\_\_\_\_ DATE \_\_\_\_\_

SITE DEVELOPMENT PLAN/FINAL PLAT - TITLE OR I.D. # \_\_\_\_\_ DATE \_\_\_\_\_

# THIS IS NOT A PERMIT

# NEW LOT X (9/23/93)


COUNTY #

SOIL PROFILE

SOIL PROFILE ①  
 0'  
 TOPSOIL  
 BROWN CLAY  
 4'  
 TAN SAND LOAM

SOIL PROFILE ②  
 0'  
 TOPSOIL  
 BROWN CLAY  
 2h  
 BEIGE TAN SAND LOAM

SOIL PROFILE ③  
 0'  
 TOPSOIL  
 RED CLAY  
 4.5'  
 TAN SAND LOAM

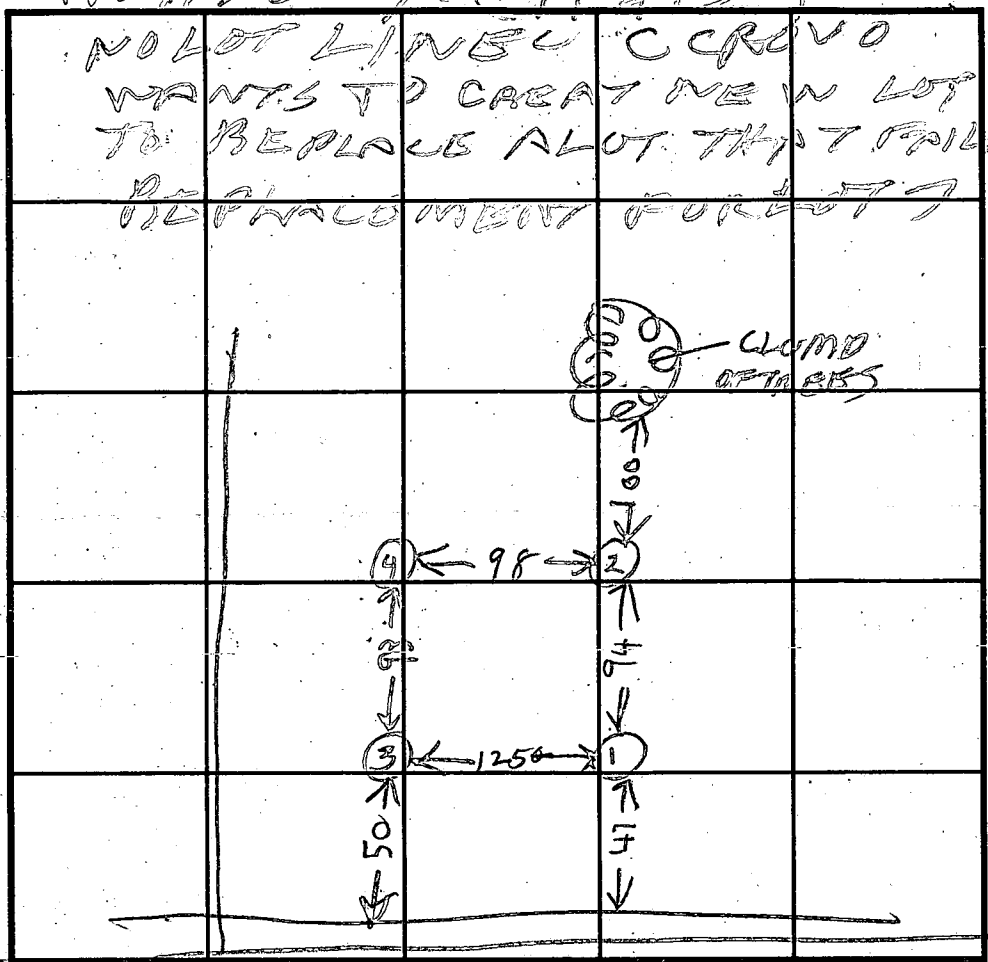

SOIL PROFILE

SOIL PROFILE ④  
 0'  
 TOPSOIL  
 BROWN CLAY  
 4'  
 BEIGE SAND LOAM

HOLE ELEVATION  
 ③ = HIGHEST  
 ② = LOWEST  
 ④ NEXT HIGHEST  
 ① NEXT LOWEST

INDICATE NORTH - NAME ADJOINING ROADWAY AS BASE LINE.  
 MCKENDREE RD

DATE	TEST NO.	DEPTH	PRE-WET		TEST - 1" DROP		TIME
			START	STOP	START	STOP	
9/23/93	1V	4.5	145	146	146	147	1
	2V	11.5	OK				
	2V	4.5	1250	1251	1251	1252	1
	3V	8.5	OK				
	3V	5.5	1258	1259	1259	102	3
	3V	5.5	1259	100	100	101	1
	3V	12	OK				
	4V	11.5	OK				

REMARKS See Plan

TYPE OF SOIL \_\_\_\_\_

TESTED BY \_\_\_\_\_ ALSO PRESENT \_\_\_\_\_

TRENCH DESIGN DATA: AVERAGE PERCOLATION TIME \_\_\_\_\_ TRENCH WIDTH \_\_\_\_\_

INLET DEPTH \_\_\_\_\_ MAXIMUM BOTTOM DEPTH \_\_\_\_\_ SQ. FT./BEDROOM \_\_\_\_\_

C1 3598

SEQUENCE NO. (DENY USE ONLY)

STATE OF MARYLAND WELL COMPLETION REPORT

THIS REPORT MUST BE SUBMITTED WITHIN 45 DAYS AFTER WELL IS COMPLETED.

COUNTY NUMBER A# 49636

(THIS NUMBER IS TO BE PUNCHED IN GOLS 3-6 ON ALL CARDS)

ST/CO USE ONLY DATE RECEIVED

DATE WELL COMPLETED 034595

Depth of Well 340 (TO NEAREST FOOT)

PERMIT NO. FROM PERMIT TO DRILL WELL 40-94-0375

OWNER PETTIT + GRIFFIN INC. last name M. KENDREE ROAD first name TOWN GLENWOOD SUBDIVISION GWYNDYD OAK EST S/O SECTION LOT 40

WELL LOG Not required for driven wells STATE THE KIND OF FORMATIONS PENETRATED, THEIR COLOR, DEPTH, THICKNESS AND IF WATER BEARING.

Table with columns: DESCRIPTION (Use additional sheets if needed), FEET (FROM, TO), Check if water bearing. Rows include soft brown dirt, hard tan/gray rock, med hard tan rock, med hard/hard tan, med tan rock, med hard/hard tan, hard gray rock, med hard gray rock, hard gray rock, hard green rock.

GROUTING RECORD WELL HAS BEEN GROUTED (Circle Appropriate Box) TYPE OF GROUTING MATERIAL CEMENT (CM) BENTONITE CLAY (BC) NO. OF BAGS 9 NO. OF POUNDS 900 GALLONS OF WATER 54 DEPTH OF GROUT SEAL (to nearest foot) from 0 ft. to 37 ft.

CASING RECORD casing types insert appropriate code below MAIN CASING TYPE PL 6 38 Nominal diameter top (main) casing (nearest inch) Total depth of main casing (nearest foot)

OTHER CASING (if used) diameter inch depth (feet) from to

SCREEN RECORD screen type or open hole insert appropriate code below ST BR HO STEEL BRASS OPEN HOLE PL OT PLASTIC OTHER

IN HARD ROCK AREAS, IDENTIFY SPECIFICALLY WHERE SATURATED FRACTURES WERE OBSERVED. WELL HYDROFRACTURED yes (Y) no (N)

CIRCLE APPROPRIATE LETTER A A WELL WAS ABANDONED AND SEALED WHEN THIS WELL WAS COMPLETED E ELECTRIC LOG OBTAINED P TEST WELL CONVERTED TO PRODUCTION WELL

I HEREBY CERTIFY THAT THIS WELL HAS BEEN CONSTRUCTED IN ACCORDANCE WITH COMAR 26.04.04 "WELL CONSTRUCTION" AND IN CONFORMANCE WITH ALL CONDITIONS STATED IN THE ABOVE CAPTIONED PERMIT, AND THAT THE INFORMATION PRESENTED HEREIN IS ACCURATE AND COMPLETE TO THE BEST OF MY KNOWLEDGE.

DRILLERS IDENT. NO. 304 David Kelley DRILLERS SIGNATURE (MUST MATCH SIGNATURE ON APPLICATION) Danney W. Knobel SITE SUPERVISOR (sign. of driller or journeyman responsible for sitework if different from permittee)

DEPTH (nearest ft.) 38 340 C2 EACH SCREEN 1 H O 38 340 2 3 3 SLOT SIZE 1 2 3 DIAMETER OF SCREEN (NEAREST INCH) from to

GRAVEL PACK IF WELL DRILLED WAS FLOWING WELL INSERT F IN BOX 68

MDE USE ONLY (NOT TO BE FILLED IN BY DRILLER) T (E.R.O.S.) W Q TELESCOPE CASING LOG INDICATOR OTHER DATA

PUMPING TEST HOURS PUMPED (nearest hour) 6 PUMPING RATE (gal. per min. to nearest gal.) METHOD USED TO MEASURE PUMPING RATE timer WATER LEVEL (distance from land surface) BEFORE PUMPING WHEN PUMPING TYPE OF PUMP USED (for test) A air P piston T turbine C centrifugal R rotary O other (describe below) J jet S submersible

PUMP INSTALLED DRILLER WILL INSTALL PUMP YES (NO) IF DRILLER INSTALLS PUMP, THIS SECTION MUST BE COMPLETED FOR ALL WELLS EXCEPT HOME USE TYPE OF PUMP INSTALLED PLACE (A,C,J,P,R,S,T,O) IN BOX - SEE ABOVE: CAPACITY: GALLONS PER MINUTE (to nearest gallon) PUMP HORSEPOWER PUMP COLUMN LENGTH (nearest ft.) CASING HEIGHT (circle appropriate box and enter casing height) LAND SURFACE (nearest foot)

LOCATION OF WELL ON LOT SHOW PERMANENT STRUCTURE SUCH AS BUILDING, SEPTIC TANKS, AND/OR LANDMARKS AND INDICATE NOT LESS THAN TWO DISTANCES (MEASUREMENTS TO WELL) 20' LPL 40' FPL

11-7-96  
W.P.T.

OK TO COVER  
NEEDS SEALED CAP  
WJ

HOWARD COUNTY HEALTH DEPARTMENT  
Bureau of Environmental Health  
3525-H Ellicott Mills Drive  
Ellicott City, MD 21043  
461-9933



APPLICATION FOR PITLESS ADAPTER, WELL PUMP AND PRESSURE TANK INSTALLATION

New Installation  Replacement   
Receipt # \_\_\_\_\_ Date 11/7/96  
Name of Installer WALTER W KING PLBG Telephone 301-662-6990  
License Number MD 2217 Certified Well Pump Installer \_\_\_\_\_ Well Driller \_\_\_\_\_ Registered Plumber   
Name of Property Owner PETTIT & GRIPPIN Telephone 301-975-1020  
Subdivision GWYNDYL OAK EST. Lot # 40 Well Tag # HD-94-0375  
Site Address 2650 MCKENDREE RD

Pump  
1. Type  
a. Deep well jet \_\_\_\_\_  
b. Shallow well jet \_\_\_\_\_  
c. Submersible   
2. Make STA-RITE  
3. Model # BSP4002HL  
4. Capacity 5 GPM  
5. Pump exceeds well capacity Yes  No \_\_\_\_\_  
6. If Yes, is low pressure cutoff switch installed? Yes  No \_\_\_\_\_  
7. What methods are used to protect the pump and electrical wiring from vibrations? Torque arrestors \_\_\_\_\_ Cable guards  Other \_\_\_\_\_  
Motor  
1. Horsepower 3/4  
2. RPM 3450  
3. Voltage \_\_\_\_\_  
a. 110 \_\_\_\_\_  
b. 220   
Pitless Adapter  
1. Make MARTINSON  
2. Model # BP-10K  
3. Depth 42" MIN  
60" MAX

Tank  
1. Capacity 80  
2. Pressure relief valve? YES  
Piping  
1. Type PLASTIC 160 PSI  
2. Size 1"  
3. NSF and/or BOCA Code approved   
4. Depth of supply line 42" MIN  
60" MAX  
Well data  
1. Depth 340 ft.  
2. Yield 1.8 GPM  
3. Static water level \_\_\_\_\_ ft.  
4. Will water supply be disinfected by installer? YES

I understand that it is my responsibility to notify the Howard County Health Department when the installation is ready for inspection (otherwise this permit is null and void).

All information given above is true to the best of my knowledge.  
Signature of Applicant: Walter W King EST  
Date: 11/7/96

Note: A sticker indicating approval/status of the installation will be placed on the well casing at the time of the inspection.





PRELIMINARY PLAN SP-93-15

CHARLES & HOBBS IV  
AND WIFE  
1300/505  
ZONED RC/DEO

E 797,000

LOT 40  
1.15 AC ±

MAIL DWELLING

A-44583


ROAD  
(MINOR COLLECTOR)

ENDREE

LAND DEDICATED TO HOWARD  
COUNTY MARYLAND FOR THE  
PURPOSE OF A PUBLIC ROAD

AREA 8

1.37 AC

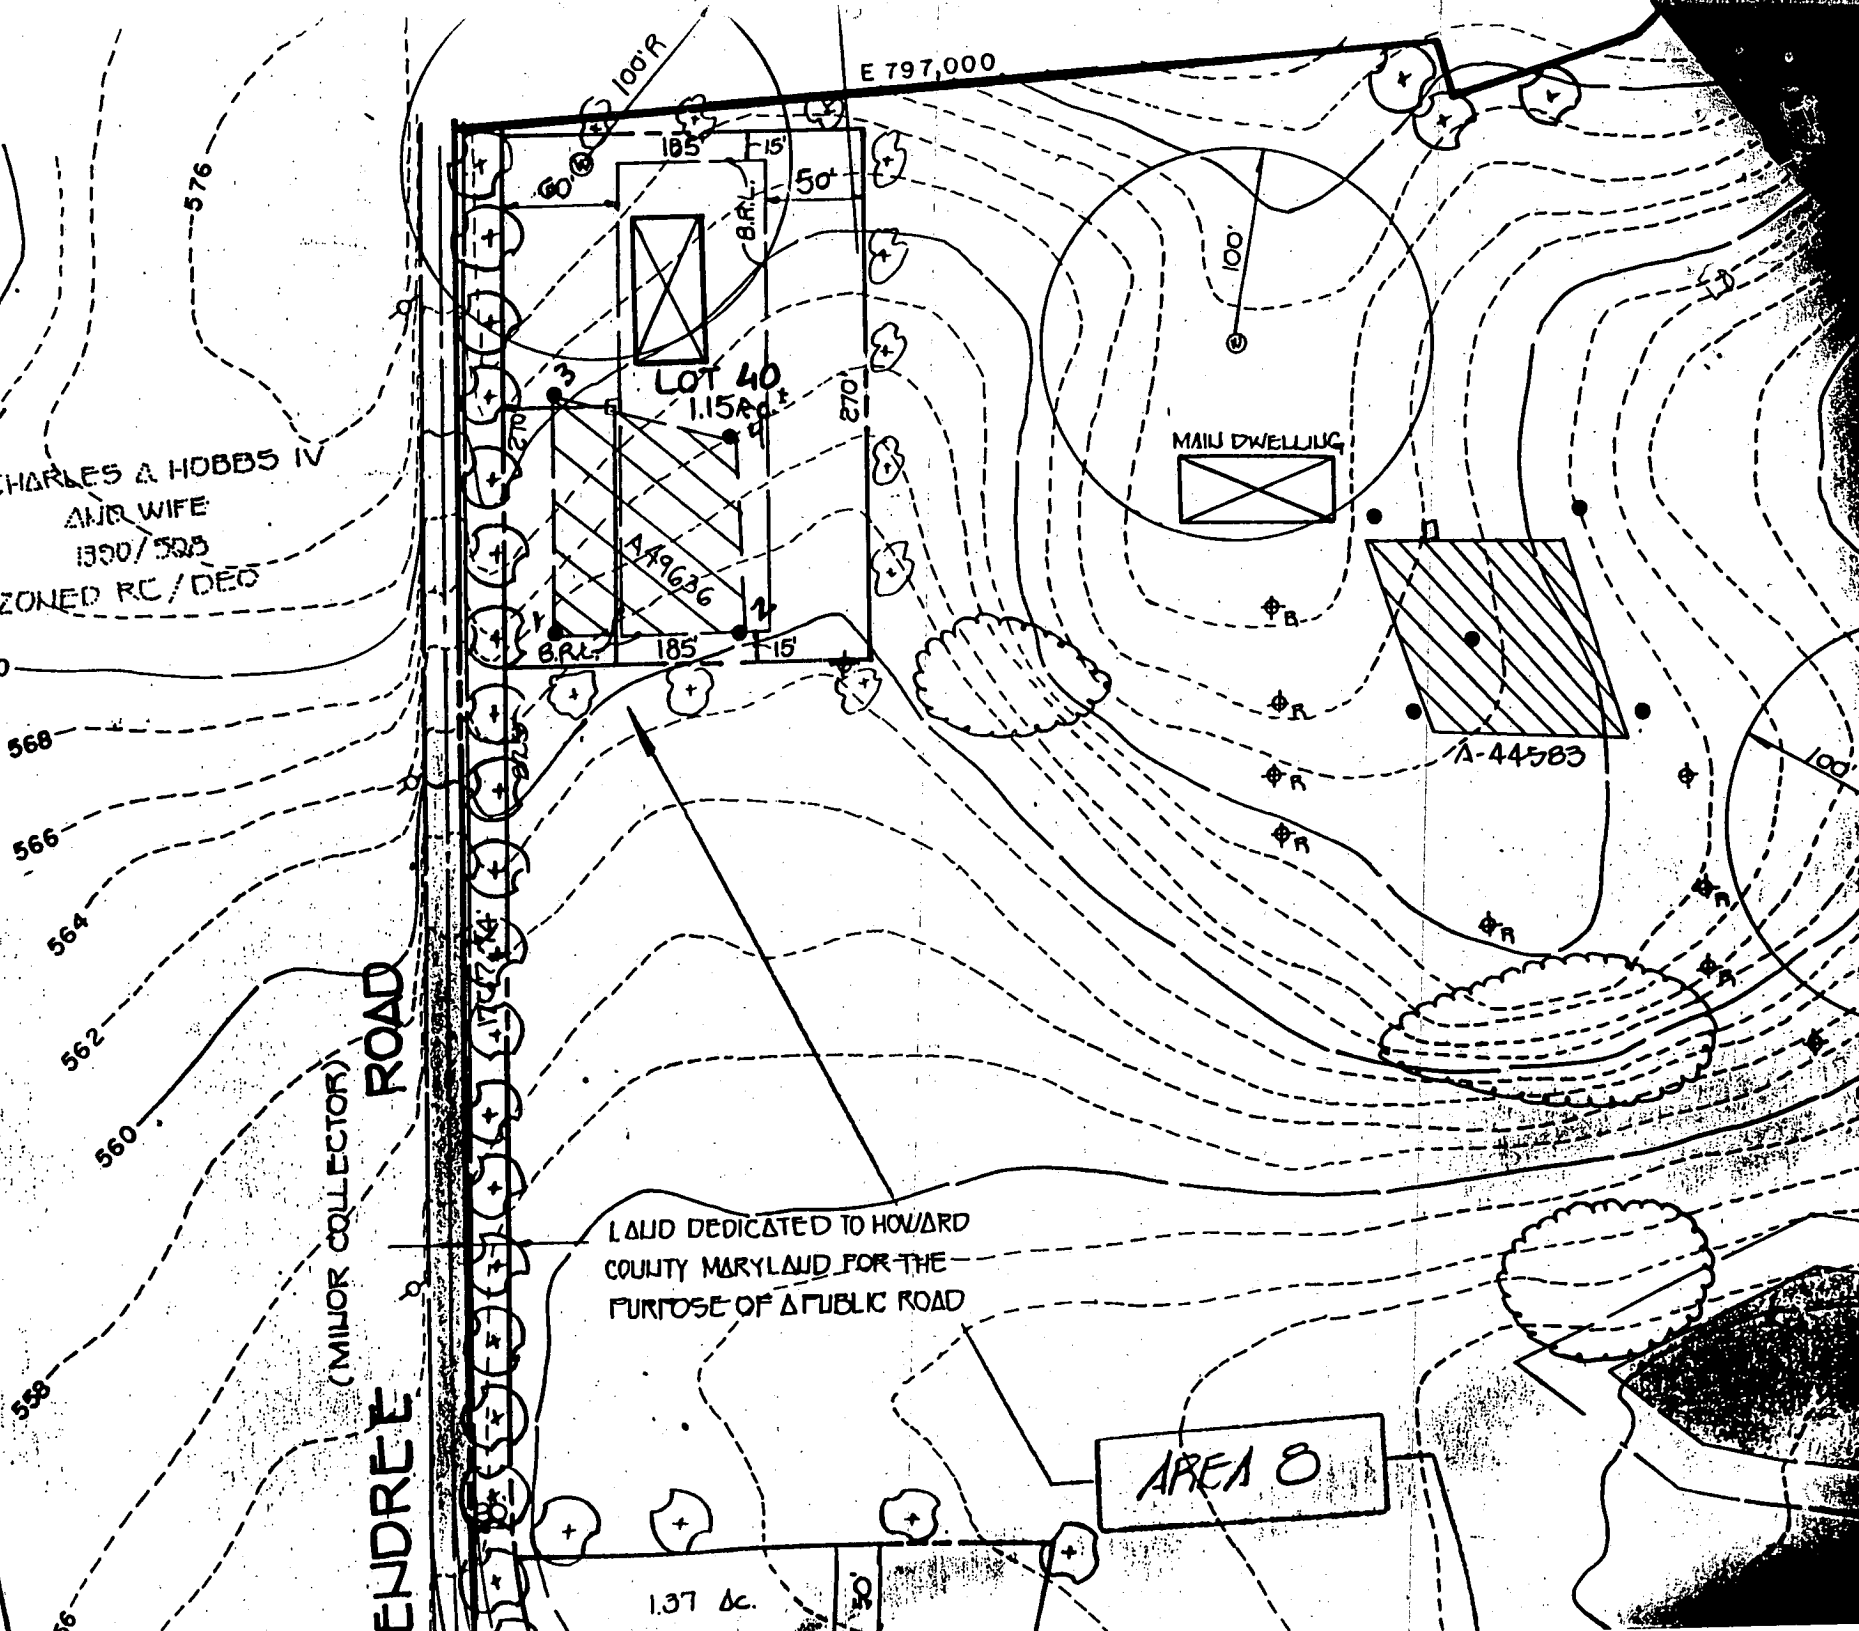

1633

1653

1651

34.31'

134.01'

444.13'

880.10'

150.84'

276.80'

209.29'

MATCH LINE SEE SHEET 5 OF 6

N03°25'36"E 209.29'


N04°32'44"E 309.24'

N13°00'00"W 105.00'

N06°34'24"W 55.00'

185.00'

LOT 40  
50,079 Sq.Ft.

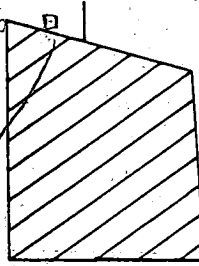

506'12.05'E 146


272.59'

504°13'46"W 185.00'

**RESERVATION OF PUBLIC UTILITY AND FOREST CONSERVATION EASEMENTS**

DEVELOPER RESERVES UNTO ITSELF, ITS SUCCESSORS AND ASSIGNS, ALL EASEMENTS SHOWN ON THIS PLAT FOR WATER, SEWER, STORM DRAINAGE, OTHER PUBLIC UTILITIES AND FOREST CONSERVATION (DESIGNATED AS "FOREST CONSERVATION AREA"), LOCATED IN, ON, OVER AND THROUGH LOTS 1 THROUGH 40 AND PARCELS A, B, C AND D. ANY CONVEYANCES OF THE AFORESAID LOTS SHALL BE SUBJECT TO THE EASEMENTS HEREIN RESERVED, WHETHER OR NOT EXPRESSLY STATED IN THE DEED(S) CONVEYING SAID LOT(S). DEVELOPER SHALL EXECUTE AND DELIVER DEEDS FOR THE EASEMENTS HEREIN RESERVED TO HOWARD COUNTY, AND, IN THE CASE OF DESCRIPTION OF THE FOREST RESERVED TO HOWARD COUNTY, WITH A METES AND BOUNDS OF THE FOREST CONSERVATION AREA. UPON COMPLETION OF THE FOREST CONSERVATION EASEMENT(S), UPON COMPLETION OF THE DEVELOPER'S OBLIGATIONS UNDER THE FOREST CONSERVATION INSTALLATION AND MAINTENANCE AGREEMENT EXECUTED BY DEVELOPER AND THE COUNTY, AND THE RELEASE OF DEVELOPER'S SURETY POSTED WITH SAID AGREEMENT, THE COUNTY SHALL ACCEPT THE EASEMENT(S) AND RECORD THE DEED(S) OF EASEMENT IN THE LAND RECORDS OF HOWARD COUNTY.

N10°46'48"E 42.48'

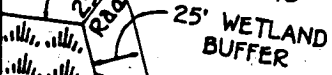

25' WETLAND BUFFER

-N79°44'04"E 36.98'

512°00'22"W 40.94'

508°27'24"W 10.93'


1679

N04°13'46"E 276.80'

1568

1569

MATCH

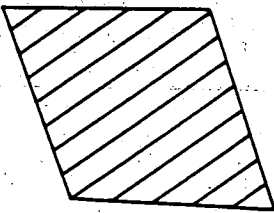


E 797.500

N 535.250

PRESERVE PARCEL (AGRICULTURE) PRESERVE AREA THIS SHEET TOTAL AREA OF PARCEL (PRIVATELY OWNED)

25' WETLAND BUFFER

N1°56'00"E 43.30'

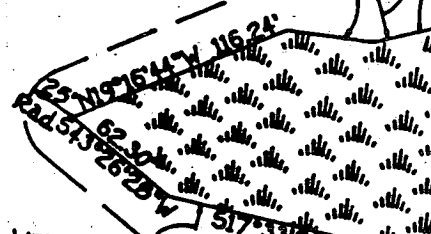

25' WETLAND BUFFER

N19°16'44"W 116.24'

N68°33'22"W 158.30'

N68°33'22"W 228.66'


NOTE: THIS LOCATION DRAWING IS OF BENEFIT TO A CONSUMER ONLY INsofar AS IT IS REQUIRED BY A LENDER OR A TITLE INSURANCE COMPANY OR ITS AGENT IN CONNECTION WITH A CONTEMPLATED TRANSFER AND FINANCING, AND IS NOT TO BE RELIED UPON FOR THE ESTABLISHMENT OR LOCATION OF FENCES, SHEDS, GARAGES, BUILDINGS, LANDSCAPING, OR OTHER EXISTING OR FUTURE IMPROVEMENTS, AND DOES NOT PROVIDE FOR THE ACCURATE IDENTIFICATION OF PROPERTY BOUNDARY LINES, BUT SUCH IDENTIFICATION MAY NOT BE REQUIRED FOR THE TRANSFER OF TITLE OR SECURING FINANCING.

THIS LOCATION DRAWING WAS PREPARED WITHOUT THE BENEFIT OF A CURRENT TITLE REPORT. THIS PROPERTY IS SUBJECT TO ANY AND ALL EASEMENTS, RIGHTS-OF-WAY, COVENANTS, AND RESTRICTIONS, ETC. OF RECORD, SOME OR ALL OF WHICH MAY OR MAY NOT BE SHOWN AND/OR REFERENCED HEREON. BEARINGS AND DISTANCES OF THE PROPERTY BOUNDARY LINES SHOWN HEREON ARE PER AVAILABLE RECORDS AND HAVE NOT BEEN FIELD VERIFIED.

3/27/97 proposed deck OK  
as shown. (OKS)

PARCEL 'B'

PARCEL 'C'

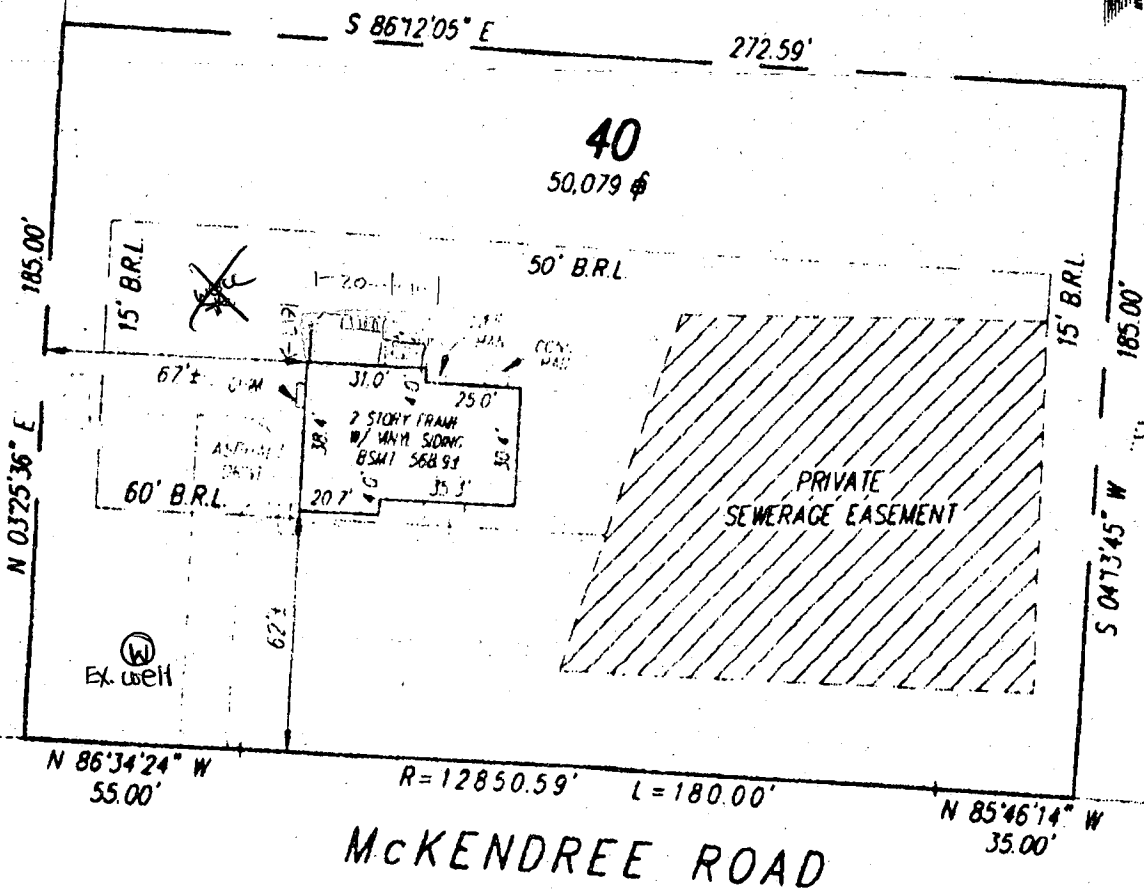

McKENDREE ROAD

BUILDING SETBACKS (B.R.L.'s) SHOWN HEREON PER PLAT No. 11553  
SETBACK DISTANCES SHOWN HEREON AS "±" HAVE AN ACCURACY OF ±1 FOOT.

THE PROPERTY SHOWN HEREON LIES WITHIN ZONE C (AREA OF MINIMAL FLOODING) AS SHOWN ON THE F.E.M.A. FLOOD INSURANCE RATE MAP.

APPLICATION

HOWARD COUNTY

Walk-THRU 155

SERIAL NUMBER

# PERMIT APPLICATION

\$125.00

DEPARTMENT OF INSPECTIONS, LICENSES & PERMIT  
3430 COURT HOUSE DRIVE, ELLICOTT CITY, MARYLAND 21043

4778  
B001017

BUILDING ADDRESS (HOUSE NO., STREET, TOWN OR AREA)  
2650 MCKENLORE ROAD  
Glenwood Md 21738 (25316)

GRADING/SEDIMENT CONTROL  YES  NO SDP #

DESCRIPTION OF WORK AUTHORIZED  
CONSTRUCT NEW IN-GROUND  
VINYL LINER / DE FILTER  
WALK-IN STAIR / DIVING BOARD

LOT NO.	PARCEL NO.	SEC.	AREA	BLOCK NO.	LIBER	FOLIO
SUB DIVISION		ZONE	ZONE MAP	ELEC. DIST.	CENSUS TR.	

SIZE OF BLDG.	FRONT	DEPTH	HEIGHT
	20'	40'	3.8 FEET

OWNER NAME AND ADDRESS  
KORTE CAMP, JOHN & KAREN 410-489-4499

TYPE OF BLDG.	AREA	VOLUME	ROOF
B. ROOMS			
ROOMS			
BATHS			
FIREPLACES			

OCCUPANT'S NAME AND ADDRESS  
OWNER

FOOTINGS	FOUNDATION	S. WALLS
		STEEL

ARCHITECT OR ENGINEER'S NAME AND ADDRESS

CONTRACTOR'S NAME AND ADDRESS  
REGINA PODS & SONS 410-252-5116  
2006 YOCK RD TIMONIUM MD 21093

UTILITIES					
WATER/WELL	SEWER/SEPTIC	GAS	ELECTRICITY	TYPE OF HEAT	AC
<input checked="" type="checkbox"/>	<input checked="" type="checkbox"/>				

I have carefully examined and read this application and know the same is true and correct, and that in doing this work, all provisions of Howard County Ordinances and the State Laws of Maryland will be complied with, whether specified or not; and I will notify the Department of Inspections, and Permits twenty-four hours in advance when I am ready for the inspections called for elsewhere in the application; and that no work will be covered up until such inspections have been completed with.

EXISTING USE: SFD  
PROPOSED USE: SFD w/ IN-GROUND POOL

SIGNATURE: [Signature]  
TITLE: [Title]  
DATE: 4/3/97

EST. CONSTRUCTION COST: 18,000  
LICENSE NUMBER: 0082  
PERMIT FEE: 125

W/S CODE FOR OFFICE USE ONLY

FUNCTION	DATE	SIGNATURE APPROVAL
ZONING/PLANNING	X	
SHA		
SEDIMENT/GRADING		
BUILDING OFFICIAL	X 4/3/97	[Signature]
WATER & SEWER		
HEALTH DEPT.	X 4/3/97	[Signature]
FIRE PROTECTION		D.I.L.P.I.C.E.
STORM WATER MGM.		

DISTANCE IN FEET FROM R/W LINE TO FRONT BUILDING LINE \_\_\_\_\_  
SIDE YARD (DISTANCE IN FEET FROM SIDE BLDG. LINE TO SIDE PROPERTY LINE) \_\_\_\_\_  
TO SIDE BUILDING LINE \_\_\_\_\_  
DISTANCE IN FEET, REAR YD. REQUIRING SET \_\_\_\_\_  
BACK (CORNER LOT ONLY) \_\_\_\_\_ SDP # \_\_\_\_\_

Check payable to: DIRECTOR OF FINANCE OF HOWARD COUNTY

**CAUTION**  
To begin construction before a permit placard has been issued and displayed on the job is a violation of the law.  
Use and occupancy permit must be applied for two weeks before it will be issued.

IMPORTANT: PLEASE SHOW ZIP CODES AND AREA CODES WHEREVER REQUIRED.  
LP-69-691 (4) 11C# 1535

APPROVED: [Signature] DATE: [Date]  
Distribution of Copies: White - Building Official, Green - Planning & Zoning, Yellow - Engineering, Pink - Health Dept., Gold - S.H.A.


BUILDING SETBACKS (B.R.L.'s) SHOWN HEREON PER PLAT No. 11553  
SETBACK DISTANCES SHOWN HEREON AS "±" HAVE AN ACCURACY OF ±1 FOOT.

**GLW GUTSCHICK, LITTLE & WEBER, P.A.**  
CIVIL ENGINEERS, SURVEYORS, PLANNERS, LANDSCAPE ARCHITECTS  
3909 NATIONAL DRIVE - SUITE 250 - BURTONSVILLE OFFICE PARK  
BURTONSVILLE, MARYLAND 21066  
Tel: (301) 471-4024 MD VA (301) 989-2524 HAIT (410) 890-1820 FAX (301) 471-4186

THE PROPERTY SHOWN HEREON LIES WITHIN ZONE C (AREA OF MINIMAL FLOODING) AS SHOWN ON THE F.E.M.A. FLOOD INSURANCE RATE MAP, COMMUNITY PANEL No. 240044 0014 B, REVISED DECEMBER 4, 1986.  
REFERENCE: PLAT No. 11553  
DATE OF LATEST FIELD WORK: 12-20-96  
DRAWN BY: WEC/CAD

ONLY INsofar AS IT IS REQUIRED BY A LENDER OR A TITLE INSURANCE COMPANY OR ITS AGENT IN CONNECTION WITH A MORTGAGE LOAN, AND IS NOT TO BE RELIED UPON FOR THE ESTABLISHMENT OR LOCATION OF FENCES, SIEDS, OR OTHER EXISTING OR FUTURE IMPROVEMENTS; AND DOES NOT PROVIDE FOR THE ACCURATE IDENTIFICATION OF PROPERTY BOUNDARY INFORMATION REQUIRED FOR THE TRANSFER OF TITLE OR SECURING FINANCING. THIS REPORT IS SUBJECT TO ANY AND ALL EASEMENTS, RIGHTS-OF-WAY, ETC. OF RECORD, SOME OF WHICH MAY OR MAY NOT BE SHOWN AND/OR REFERENCED HEREON. BEARINGS AND DISTANCES OF THE LINES SHOWN HEREON ARE PER AVAILABLE RECORDS AND HAVE NOT BEEN FIELD VERIFIED.

HOWARD COUNTY ENVIRONMENTAL HEALTH DEPARTMENT  
 1997 APR - 3 P 2:04  
 PARCEL 'C'

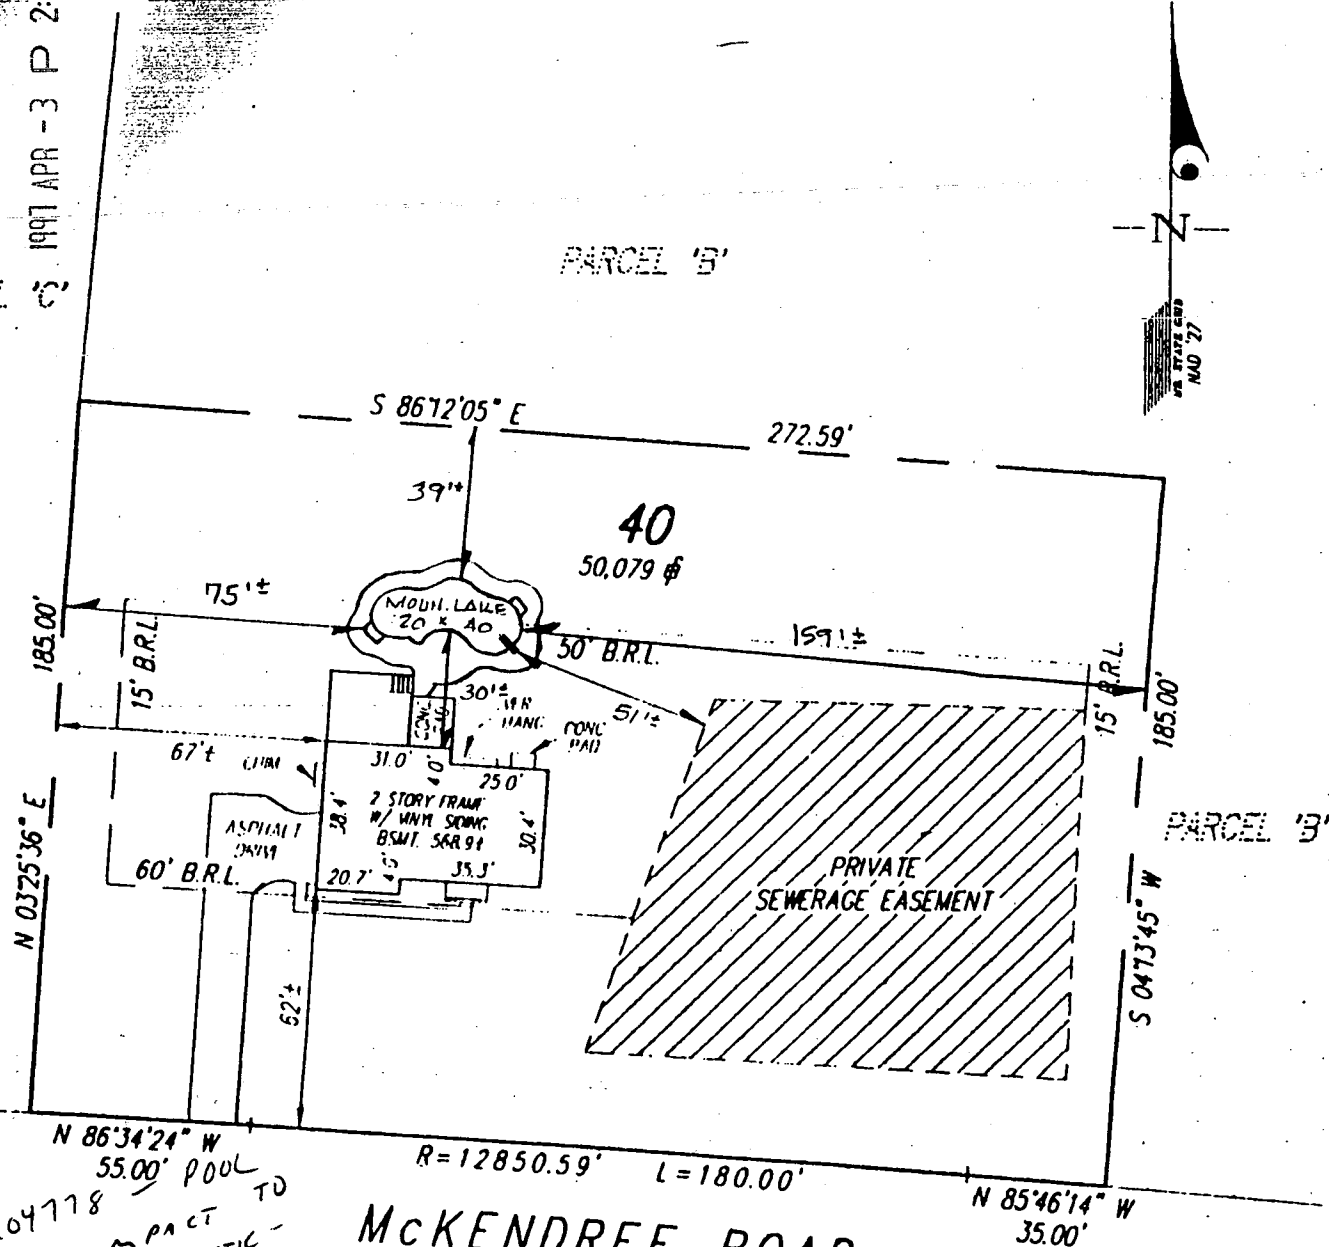

Boulo4778  
 NO IMPACT TO WELL OR SEPTIC - AC TO PROCEED  
 4/3/97 CW  
 HOW CO HEALTH

MCKENDREE ROAD

BUILDING SETBACKS (B.R.L.'s) SHOWN HEREON PER PLAT No. 11553  
 SETBACK DISTANCES SHOWN HEREON AS "±" HAVE AN ACCURACY OF ±1 FOOT.

**GLW GUTSCHICK, LITTLE & WEBER, P.A.**

CIVIL ENGINEERS, SURVEYORS, PLANNERS, LANDSCAPE ARCHITECTS  
 3909 NATIONAL DRIVE - SUITE 250 - BURTONSVILLE OFFICE PARK  
 BURTONSVILLE, MARYLAND 20866  
 TEL: (301) 471-4024 MO. VA. (301) 989-2574 BALT. (410) 890-1820 FAX (301) 421-4186

THE PROPERTY SHOWN HEREON LIES WITHIN ZONE C (AREA OF MINIMAL FLOODING) AS SHOWN ON THE F.E.M.A. FLOOD INSURANCE RATE MAP COMMUNITY PANEL No. 240044 0014 B, REVISED DECEMBER 4, 1988.

REFERENCE: PLAT No. 11553  
 DATE OF LATEST FIELD WORK: 12-20-96  
 DRAWN BY: WEG/CAD SCALE: 1" = 50'

HOWARD COUNTY HEALTH DEPARTMENT  
Completed Septic System

P 57347 A A 49636

DATE 10/21/96

LOCATION Gwyndyl Oak Estates  
2650 Mckendree Road  
LOT 40

APPLICATION  
HOLD ( )  
APPROVED (✓)  
REJECTED ( )

APPLICANT \_\_\_\_\_  
OWNER John Kortecamp  
PERMITTEE South Carroll Backhoe

INSTALLATION  
HOLD ( )  
APPROVED (✓)

HD-11 APPROVED DATE 11/18/96