

11/18/93 (A.M.)
(P.M.)

PERMIT

SEWAGE DISPOSAL SYSTEM

DEPARTMENT OF HEALTH AND MENTAL HYGIENE

03-296547

P 49761A

A REPAIR

DISTRICT _____

DATE 11/22/93

DATE SYSTEM APPROVED 11/18/93

HOWARD COUNTY HEALTH DEPARTMENT

BUREAU OF ENVIRONMENTAL HEALTH

~~XXXX-XXXX~~ 313-2640

INDEXED

(INSPECTOR C. Bel
as per other side)

Jenkins Brothers IS PERMITTED TO INSTALL _____ ALTER X

ADDRESS 7670 Smith's Private Road, Sykesville, Maryland 21784 PHONE 461-9282

SUBDIVISION _____ LOT _____ ROAD 1220 Marriottsville Road

PROPERTY OWNER Dept of Natural Resources

ADDRESS 1220 Marriottsville Road
Marriottsville, Maryland 21104

SEPTIC TANK CAPACITY 1000 GALLONS

NUMBER OF BEDROOMS 3

_____ SQUARE FEET PER BEDROOM

*{For Family New - Stone Ranches}
[Closer to Henington Road]*

LINEAR FEET OF TRENCH REQUIRED _____

REPAIR - PURPOSE - METAL TANK HAS COLLAPSED. Drainfields have failed.

Call for inspection when tank is in place and ground is opened so sanitarian can approve size and location of tank and recommend repair. 11/17/93

11/18 See other side - please. C. Bel

PLANS APPROVED BY C. Bel for "C.W." DATE 11/18/93

COVER NO WORK UNTIL INSPECTED AND APPROVED

NEITHER THE HOWARD COUNTY COUNCIL NOR THE HEALTH DEPARTMENT IS RESPONSIBLE FOR THE SUCCESSFUL OPERATION OF ANY SYSTEM

NOTE: CLEANOUT REQUIRED EVERY 70 FEET OF SEWER LINE AND/OR AT 90° SWEEPS IN LINES FROM HOUSE TO DRAIN FIELDS, 90° ELBOWS NOT ACCEPTABLE.

NOTE: ALL PARTS OF SEPTIC SYSTEMS (I.E. TANK, DISTRIBUTION BOX TRENCHES) TO BE 100 FEET FROM WELL (UNLESS OTHERWISE SPECIFICALLY AUTHORIZED)

NOTE: IF DEEP TRENCH(ES) ARE USED CALL FOR INSPECTION BEFORE AND AFTER PLACING GRAVEL IN TRENCH(ES)

NOTE: NO DRY WELL SHALL EXCEED 15 FOOT IN DIAMETER NO ABSORPTION TRENCH TO EXCEED 100 FEET IN LENGTH

NOTE: ALL PIPE FROM HOUSE TO SEPTIC TANK MUST BE CAST IRON OR SCHEDULE 35/40 PVC OR ABS


PERMIT VOID AFTER TWO YEARS

NOTE: INSTALL STAND PIPE ON SEPTIC TANK AND DRY WELL STAND PIPES MUST BE 6 INCHES IN DIAMETER CAST IRON. CONCRETE OR TERRA COTTA OR PVA OR ABS ACCEPTED. IF TOP OF SEPTIC TANK IS DEEPER THAN 3 FEET. MANHOLE TO GRADE REQUIRED.

NOTE: DISTRIBUTION BOXES MUST HAVE BAFFLES

***INSTALLER IS RESPONSIBLE FOR OBTAINING FINAL APPROVAL ON THIS PERMIT**

P 49761A

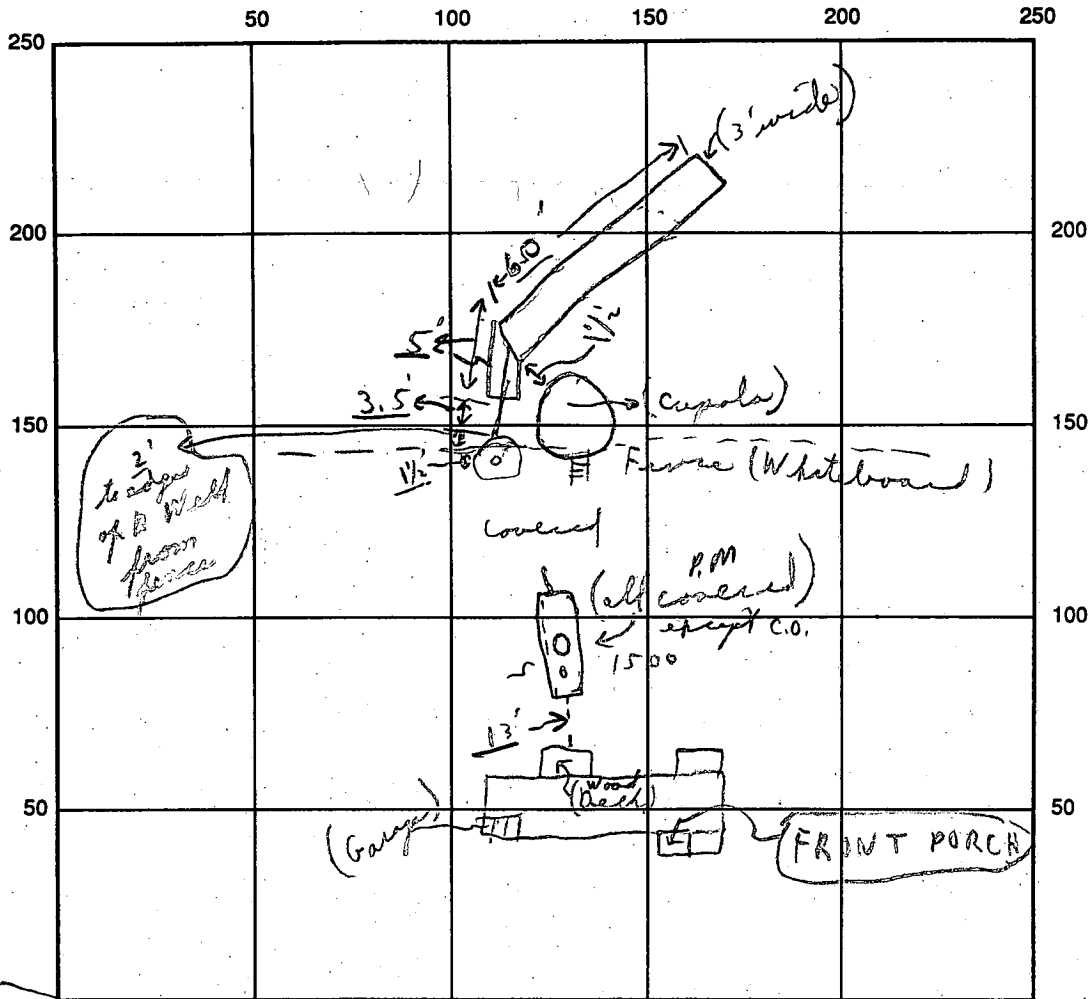

INDICATE NORTH - NAME ADJOINING ROADWAY AS BASE LINE

SEPTIC TANK LEVEL _____ 1500 covered (Machole) (S.T.) P.W. (Mannothsville) Stream

DISTRIBUTION BOX LEVEL _____ New Note in P.M. CLEANOUTS (Regular) (S.T.) (EXIST) (P.W.) ← (Mannothsville) Road

DRAIN FIELD/TITLE DEPTH 10' ± FT. TRENCH WIDTH 3 FT. INLET DEPTH 4 FT.

EFFECTIVE GRAVEL DEPTH 6' FT. TOTAL LENGTH 65 FT.

NUMBER OF TRENCHES 1 ONE SIDEWALL/BOTTOM AREA 390 SQ. FT. (old dry well)

DRYWALL INSIDE DIAMETER _____ FT. EFFECTIVE DEPTH BELOW INLET _____ FT.

ABSORBENT AREA 390 SQ. FT. (old dry well)

REMARKS: 11/10/93 Septic Tank area as seen. No trench yet
11/8 P.M. finished trench at 1:30 (C.B.D. on depth)
all pipes covered from and/or near septic tanks also.
CL I CERTIFY THE TRENCH IS 3' WIDE; 10' DEEP AND HAS 6'
OF STONE UNDER PIPE; 65' LONG. Charles Perkins

DATE SYSTEM APPROVED 11/10/93 INSPECTOR Charles Perkins
as per above