

10/7/85
3RD AM

01-173979

10-8-85
approved
S. Abel

PERMIT

P 36033
A REPAIR

SEWAGE DISPOSAL SYSTEM

MARYLAND STATE DEPARTMENT OF HEALTH*

HOWARD COUNTY
BUREAU OF ENVIRONMENTAL HEALTH
992-2330

ELLICOTT CITY
DISTRICT _____

INDEXED

DATE 9/27/85

Arnolds Backhoe & Septic Service, Inc. IS PERMITTED TO INSTALL _____ ALTER

ADDRESS 7212 Woodbine Road, Woodbine, Maryland 21797 PHONE 795-7873

SUBDIVISION Kerger ROAD 5213 Kerger Road LOT 4
Parcel 523

PROPERTY OWNER Dennis Gerlach
5213 Kerger Road

ADDRESS _____

IF GARBAGE GRINDER IS USED INCREASE SEPTIC TANK CAPACITY BY 50% AND ABSORPTION AREA BY 22%.

GARBAGE GRINDER? YES _____ NO _____

SEPTIC TANK CAPACITY _____ GALLONS NUMBER OF BEDROOMS 3

REPAIR - CALL FOR INSPECTION WHEN GROUND IS OPENED UP SO SANITARIAN CAN RECOMMEND

REPAIR. EXISTING SYSTEM HAS 12 DEEP DRYWELL & OVERFLOWING TRENCH.

DISCONNECT EXISTING TRENCH AND ADD NEW TRENCH

ALONG CURB GROUND. TRENCH TO BE MINIMUM OF 60' LONG

INLET AT 6', BOTTOM AT 12'.

PLANS APPROVED BY C. Williams DATE 9/27/85

COVER NO WORK UNTIL INSPECTED AND APPROVED.

NEITHER THE HOWARD COUNTY COUNCIL NOR THE HEALTH DEPARTMENT IS RESPONSIBLE FOR THE SUCCESSFUL OPERATION OF ANY SYSTEM.

NOTE: IF TRENCH IS USED CALL FOR INSPECTION BEFORE AND AFTER PLACING GRAVEL IN TRENCH.

NOTE: NO DRY WELL SHALL EXCEED 15 FOOT IN DIAMETER. NO ABSORPTION TRENCH TO EXCEED 100 FEET IN LENGTH.

NOTE: ALL PIPE FROM HOUSE TO SEPTIC TANK MUST BE CAST IRON OR SCHEDULE 40 PVC OR ABS.

PERMIT VOID AFTER THREE YEARS.


NOTE: INSTALL STAND PIPE ON SEPTIC TANK AND DRY WELL. STAND PIPES MUST BE 6 INCHES IN DIAMETER. CAST IRON, CONCRETE OR TERRA COTTA, OR PVC OR ABS ACCEPTED. IF TOP OF SEPTIC TANK IS DEEPER THAN 3 FEET MANHOLE TO GRADE REQUIRED.

***INSTALLER IS RESPONSIBLE FOR OBTAINING FINAL APROVAL ON THIS PERMIT**

*CALL 992-2330 FOR INSPECTION OF SEPTIC SYSTEMS.

EH - 2-1082


P 36033

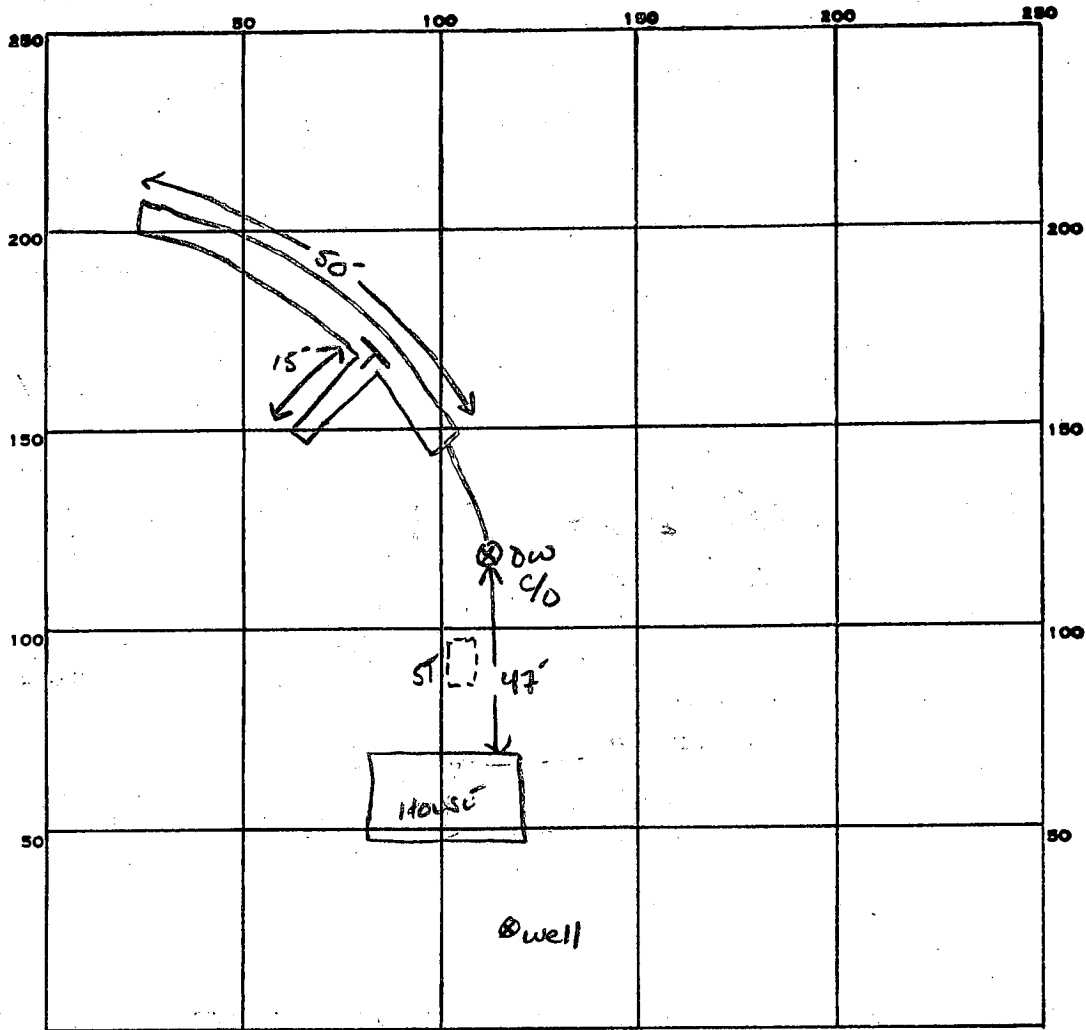

T = TIN
Distribution
Pipe

INDICATE NORTH. - NAME ADJOINING ROADWAY AS BASE LINE.

Kerger Rd.

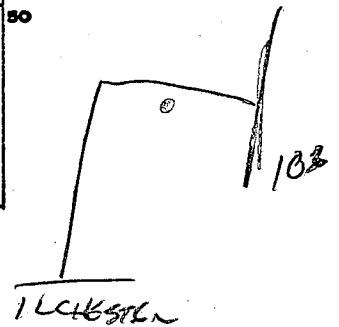

PERMIT CARD

SEPTIC TANK, LEVEL EXISTING

CLEANOUTS EXISTING D.W.

DISTRIBUTION BOX, LEVEL N/A

TILE FIELD, DEPTH 12" FT. TRENCH WIDTH 2 FT. INLET 6"

GRAVEL DEPTH 6 FT TOTAL LENGTH 65 FT.

NUMBER OF TRENCHES 1 ONE SIDE WALL TOTAL BOTTOM AREA 390 ϕ

SEEPAGE PITS, INSIDE DIAMETER FT. DEPTH BELOW INLET FT.

ABSORBENT AREA 390 SQ. FT.

REMARKS 10-8-85 STONE INSURTER AS TRENCH DUG -> SIDE WALLS COLLAPSED;
OK TO COVER ALL WORK.

DATE SYSTEM APPROVED 10-8-85

INSPECTOR S. Abel