

5-6-84  
ASAP  
10:00 AM

5/6/86  
repair  
OK'd  
B

# PERMIT

P 31888

A REPAIR

SEWAGE DISPOSAL SYSTEM

MARYLAND STATE DEPARTMENT OF HEALTH

HOWARD COUNTY  
BUREAU OF ENVIRONMENTAL HEALTH  
~~888-2233~~  
461-9933

ELLICOTT CITY  
DISTRICT \_\_\_\_\_  
DATE 5/5/86

INDEXED

Jack Fyock IS PERMITTED TO INSTALL \_\_\_\_\_ ALTER X

ADDRESS \_\_\_\_\_ PHONE 988-9270

SUBDIVISION \_\_\_\_\_ ROAD 6650 Martin Road LOT \_\_\_\_\_

PROPERTY OWNER Ellicott  
ADDRESS 6650 Martin Road  
Columbia, Maryland

IF GARBAGE GRINDER IS USED INCREASE SEPTIC TANK CAPACITY BY 50% AND ABSORPTION AREA BY 22%.

GARBAGE GRINDER? YES \_\_\_\_\_ NO \_\_\_\_\_

SEPTIC TANK CAPACITY 750 (existing) GALLONS NUMBER OF BEDROOMS 3

REPAIR - CALL FOR INSPECTION WHEN GROUND IS OPENED UP SO SANITARIAN CAN RECOMMEND REPAIR.

Red/brown clay/clay loam - 2'  
fine med grain tan brown sandy loam ↓  
hit solid sandstone 8 1/2 - 9 1/2'

tank pumped  
property has well (thought to opposite side of house)  
though none found

PLANS APPROVED BY C. Williams DATE 5/05/86

COVER NO WORK UNTIL INSPECTED AND APPROVED.

NEITHER THE HOWARD COUNTY COUNCIL NOR THE HEALTH DEPARTMENT IS RESPONSIBLE FOR THE SUCCESSFUL OPERATION OF ANY SYSTEM.

NOTE: IF TRENCH IS USED CALL FOR INSPECTION BEFORE AND AFTER PLACING GRAVEL IN TRENCH.

NOTE: NO DRY WELL SHALL EXCEED 15 FOOT IN DIAMETER. NO ABSORPTION TRENCH TO EXCEED 100 FEET IN LENGTH.

NOTE: ALL PIPE FROM HOUSE TO SEPTIC TANK MUST BE CAST IRON OR SCHEDULE 40 PVC OR ABS.

PERMIT VOID AFTER THREE YEARS.


NOTE: INSTALL STAND PIPE ON SEPTIC TANK AND DRY WELL. STAND PIPES MUST BE 6 INCHES IN DIAMETER. CAST IRON, CONCRETE OR TERRA COTTA, OR PVC OR ABS ACCEPTED. IF TOP OF SEPTIC TANK IS DEEPER THAN 3 FEET MANHOLE TO GRADE REQUIRED.

**\*INSTALLER IS RESPONSIBLE FOR OBTAINING FINAL APPROVAL ON THIS PERMIT**

\*CALL 992-2330 FOR INSPECTION OF SEPTIC SYSTEMS.

EH - 2-1082

3 calls  
A Repair

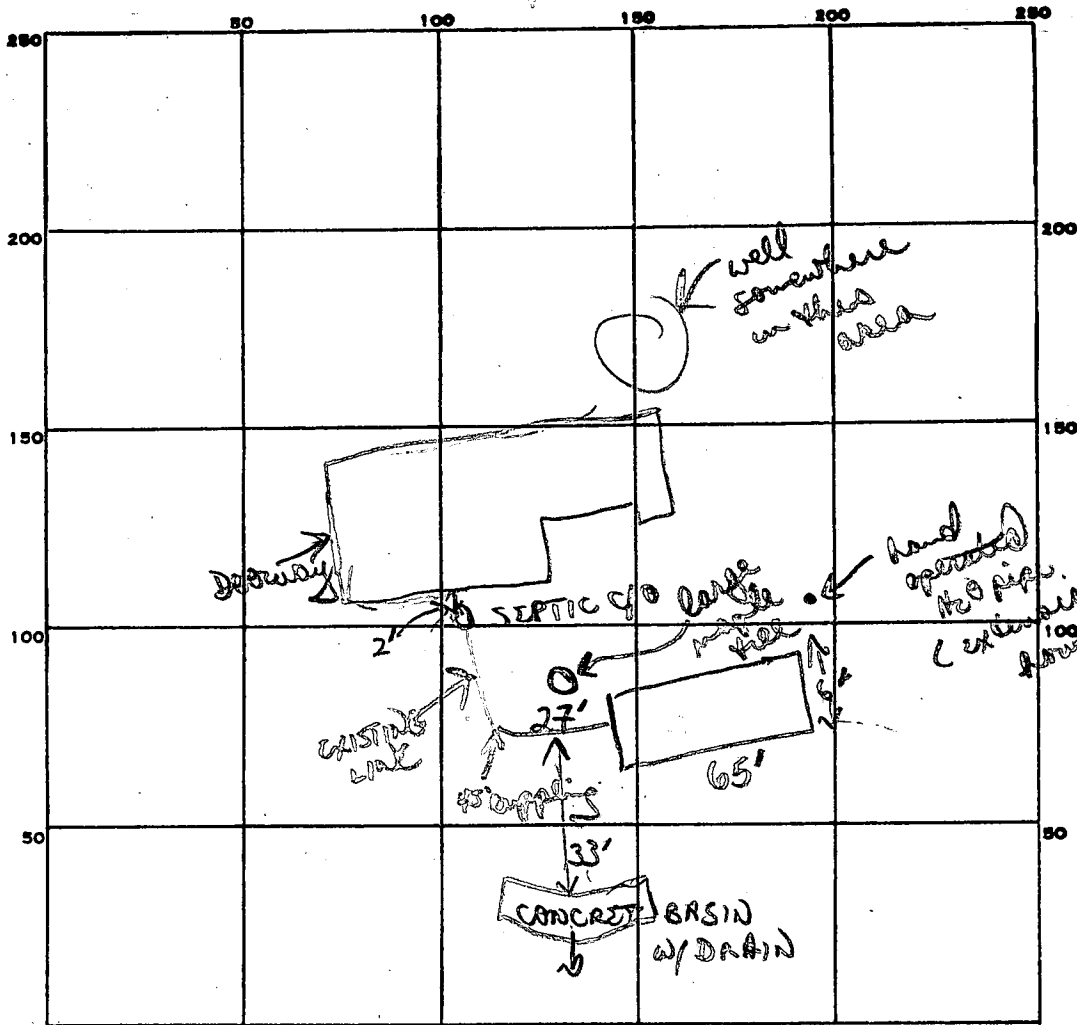

INDICATE NORTH. - NAME ADJOINING ROADWAY AS BASE LINE.

PERMIT CARD final PAVED ROADWAY (DRIVEWAY) MARTIN RD

SEPTIC TANK, LEVEL EXISTING 750 METAL CLEANOUTS S.T. C/O

DISTRIBUTION BOX, LEVEL                     

TILE FIELD, DEPTH 4 1/2 FT. TRENCH WIDTH 6 FT.

GRAVEL DEPTH 18" IN. TOTAL LENGTH 65 FT.

NUMBER OF TRENCHES 1 TOTAL BOTTOM AREA 390'

125  
3  
395  
65  
6  
390

SEEPAGE PITS, INSIDE DIAMETER                      FT. DEPTH BELOW INLET                      FT.

ABSORBENT AREA 390 SQ. FT.

REMARKS OK to use shallower system due to sandstone  
bottom. OK to add stone, pipe paper to trench.  
OK to cover, trench & line

DATE SYSTEM APPROVED 5/6/86 INSPECTOR B. W. W. W.

MARTIN ROAD