

P 5-5-86
ASAP AM

H081-1162

03-292231

5/5/86
septic OR 20
BW

INDEX AS:
P 316762

PERMIT

A 19043

SEWAGE DISPOSAL SYSTEM

MARYLAND STATE DEPARTMENT OF HEALTH*

HOWARD COUNTY
BUREAU OF ENVIRONMENTAL HEALTH
~~461-9933~~
461-9933

ELLICOTT CITY
DISTRICT 4/07/86
DATE 4/07/85

INDEXED

PROPERTY ADDRESS - 12008 OLD FREDERICK RD.

Peter J. Nacci - Herman Sirk. IS PERMITTED TO INSTALL ALTER (WORK)
ADDRESS 13 Dreher Ave. PHONE 484-3461 761 4986

SUBDIVISION 13008 Old Frederick Rd. ROAD 13008 Old Frederick Rd. LOT 11

PROPERTY OWNER Peter J. & Patricia Nacci

ADDRESS 13 Dreher Ave. BALTO., Md. 21208

IF GARBAGE GRINDER IS USED INCREASE SEPTIC TANK CAPACITY BY 50% AND ABSORPTION AREA BY 22%.

GARBAGE GRINDER? YES NO

SEPTIC TANK CAPACITY 1250 11000 GALLONS NUMBER OF BEDROOMS 3

TRENCHES - 180 sq. ft. per bedroom. Trench to be 2 feet wide. Inlet 5 feet below original grade. Bottom maximum depth 9 feet below original grade. Effective area begins 5 feet below original grade. 4 feet of stone below distribution pipe.

LOCATION - Start the trench 130 feet from the left lot line and 42 feet from the back lot line as seen when facing the lot from Route 99. Run trench(s) on level ground toward the front lot line.

NOTE - No trench to exceed 100 feet in length. If more than one trench used, a distribution box is required. Call for inspection of trench(s) before and after gravel is installed. Provide 6" - 8" diameter cleanout and cap to grade or above on septic tank. ok/cw

4-18-86 MAY HAVE DIFFICULTY MEETING 5' INLET, WILL ATTEMPT TO MEET SPECS, HOWEVER WILL CALL IF ANY PROBLEMS ARE CONFRONTED. S. ABM

PLANS APPROVED BY C. Williams DATE 4/04/86

COVER NO WORK UNTIL INSPECTED AND APPROVED.

NEITHER THE HOWARD COUNTY COUNCIL NOR THE HEALTH DEPARTMENT IS RESPONSIBLE FOR THE SUCCESSFUL OPERATION OF ANY SYSTEM.

NOTE: IF TRENCH IS USED CALL FOR INSPECTION BEFORE AND AFTER PLACING GRAVEL IN TRENCH.

NOTE: NO DRY WELL SHALL EXCEED 15 FOOT IN DIAMETER. NO ABSORPTION TRENCH TO EXCEED 100 FEET IN LENGTH.

NOTE: ALL PIPE FROM HOUSE TO SEPTIC TANK MUST BE CAST IRON OR SCHEDULE 40 PVC OR ABS.

PERMIT VOID AFTER THREE YEARS.

NOTE: INSTALL STAND PIPE ON SEPTIC TANK AND DRY WELL. STAND PIPES MUST BE 6 INCHES IN DIAMETER. CAST IRON, CONCRETE OR TERRA COTTA, OR PVC OR ABS ACCEPTED. IF TOP OF SEPTIC TANK IS DEEPER THAN 3 FEET MANHOLE TO GRADE REQUIRED.

BLDG. PERMIT SIGNED
AND RETURNED 5/22/87
Serial # 12175
PRA


*INSTALLER IS RESPONSIBLE FOR OBTAINING FINAL APPROVAL ON THIS PERMIT

*CALL 992-3330 FOR INSPECTION OF SEPTIC SYSTEMS.

EH - 2-1082

INDEX #: P 36762

A 19043

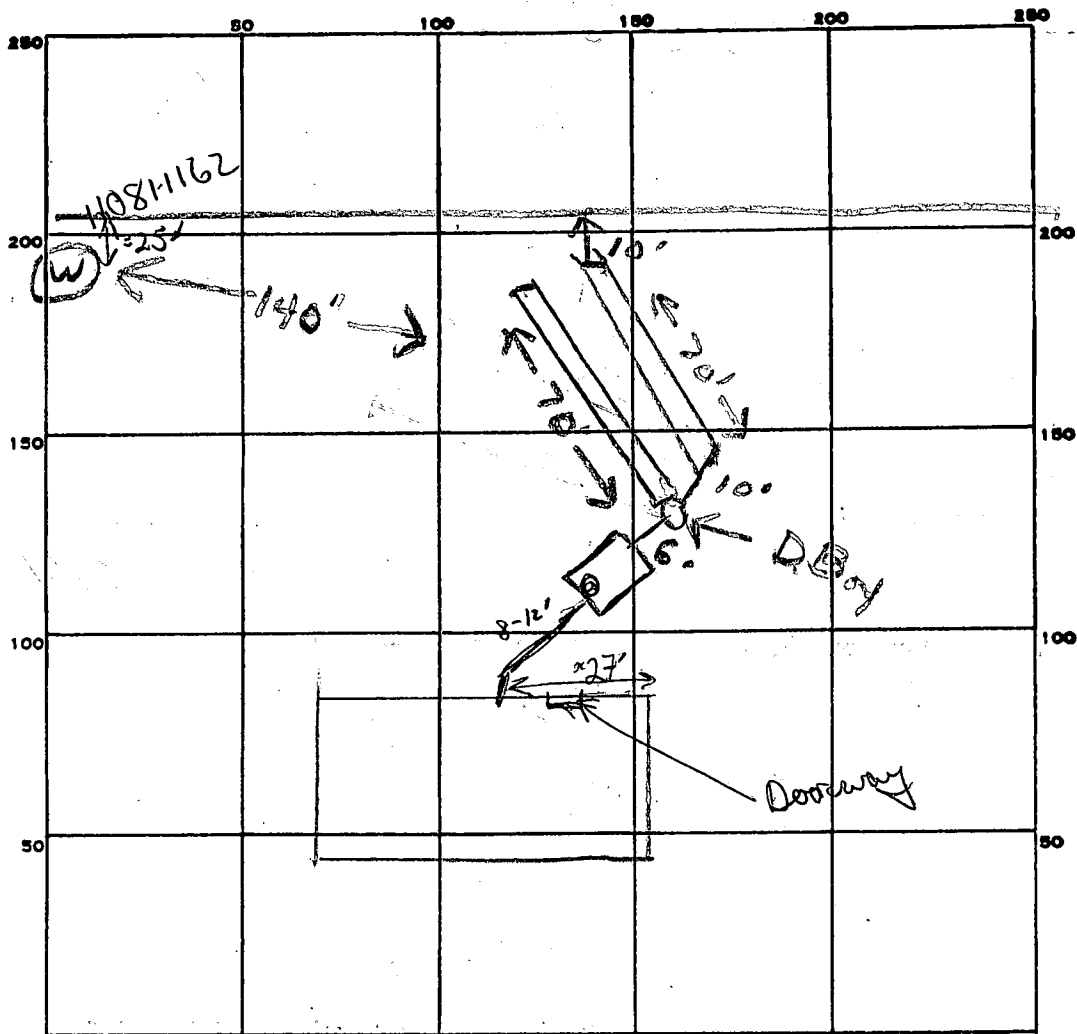

INDICATE NORTH. - NAME ADJOINING ROADWAY AS BASE LINE.

PERMIT CARD Final RT 99

SEPTIC TANK, LEVEL 1000

CLEANOUTS 1 ST.

DISTRIBUTION BOX, LEVEL ✓

TILE FIELD, DEPTH 9 FT. TRENCH WIDTH 2 FT.

GRAVEL DEPTH 4 IN. TOTAL LENGTH 140 FT.

NUMBER OF TRENCHES 2 TOTAL BOTTOM AREA 560

SEEPAGE PITS, INSIDE DIAMETER _____ FT. DEPTH BELOW INLET _____ FT.

ABSORBENT AREA 560 SQ. FT.

REMARKS 5-2-86 - OK to cover work to septic tank.

Need to see Runner connection of septic alarm out.
5/5/86 house connection verified & OK. All other work
already OK'd & covered

DATE SYSTEM APPROVED 5/5/86

INSPECTOR B. Nixon

