

8/17/87
AM

05-397774

~~8/17/87~~
~~AM~~

PERMIT

SEWAGE DISPOSAL SYSTEM

MARYLAND STATE DEPARTMENT OF HEALTH

P 39527

A 34760

DISTRICT 5th

DATE 4/30/87

DATE SYSTEM APPROVED 8-14-87

INSPECTOR JEN

HOWARD COUNTY
BUREAU OF ENVIRONMENTAL HEALTH
461-9933

INDEXED

Dale Fogle IS PERMITTED TO INSTALL X ALTER

ADDRESS 6430 Woodbine Road, Woodbine, Maryland PHONE 795-5670

SUBDIVISION Campbell Property ROAD 12920 Linden Church Road DOT 2

PROPERTY OWNER Frank Marcotte

ADDRESS _____

IF GARBAGE GRINDER IS USED INCREASE SEPTIC TANK CAPACITY BY 50% AND ABSORPTION AREA BY 22%.

GARBAGE GRINDER? YES _____ NO X

SEPTIC TANK CAPACITY 1250 GALLONS NUMBER OF BEDROOMS 4

TRENCHES - 187 sq. ft. per bedroom. Trench to be 2 feet wide. Inlet 4 feet below original grade. Bottom maximum depth 8 feet below original grade. Effective area begins at 4 feet below original grade. 4 feet of stone below distribution pipe.

LOCATION - Start the trench 420 feet from the 289.69 ft. lot line and 40 feet from the 552.80 ft lot line. Run trench(s) along level ground towards the 500 feet lot line.

NOTE - No trench to exceed 100 feet in length. Provide 6" - 8" diameter cleanout and cap to grade or above on septic tank.

10/20/87 Part of trench covered in unable to see pitress
pitless below 28" SAGE OK'd

PLANS APPROVED BY S. Abel DATE 4/23/87

COVER NO WORK UNTIL INSPECTED AND APPROVED.

NEITHER THE HOWARD COUNTY COUNCIL NOR THE HEALTH DEPARTMENT IS RESPONSIBLE FOR THE SUCCESSFUL OPERATION OF ANY SYSTEM.

NOTE: CLEANOUT REQUIRED EVERY 70 FEET OF SEWER LINE AND/OR AT 90° SWEEPS IN LINES FROM HOUSE TO DRAIN FIELDS.

NOTE: ALL PARTS OF SEPTIC SYSTEMS (I.E., TANK, DISTRIBUTION BOX, TRENCHES) TO BE 100 FEET FROM WELL (UNLESS OTHERWISE SPECIFICALLY AUTHORIZED)

NOTE: IF DEEP TRENCH(ES) ARE USED CALL FOR INSPECTION BEFORE AND AFTER PLACING GRAVEL IN TRENCH(ES).

NOTE: NO DRY WELL SHALL EXCEED 15 FOOT IN DIAMETER. NO ABSORPTION TRENCH TO EXCEED 100 FEET IN LENGTH.

NOTE: ALL PIPE FROM HOUSE TO SEPTIC TANK MUST BE CAST IRON OR SCHEDULE 40 PVC OR ABS.

PERMIT VOID AFTER TWO YEARS.

NOTE: INSTALL STAND PIPE ON SEPTIC TANK AND DRY WELL. STAND PIPES MUST BE 6 INCHES IN DIAMETER. CAST IRON, CONCRETE OR TERRA COTTA OR PVC OR ABS ACCEPTED. IF TOP OF SEPTIC TANK IS DEEPER THAN 3 FEET, MANHOLE TO GRADE REQUIRED.

NOTE: DISTRIBUTION BOXES MUST HAVE BAFFLES.

REG. PERMIT STAMP
AND RETURNED 9/21/90
Serial #34775 - Shed


***INSTALLER IS RESPONSIBLE FOR OBTAINING FINAL APPROVAL ON THIS PERMIT**

*CALL 461-9933 FOR INSPECTION OF SEPTIC SYSTEMS.

EH - 2-1186

A 34760

3:30

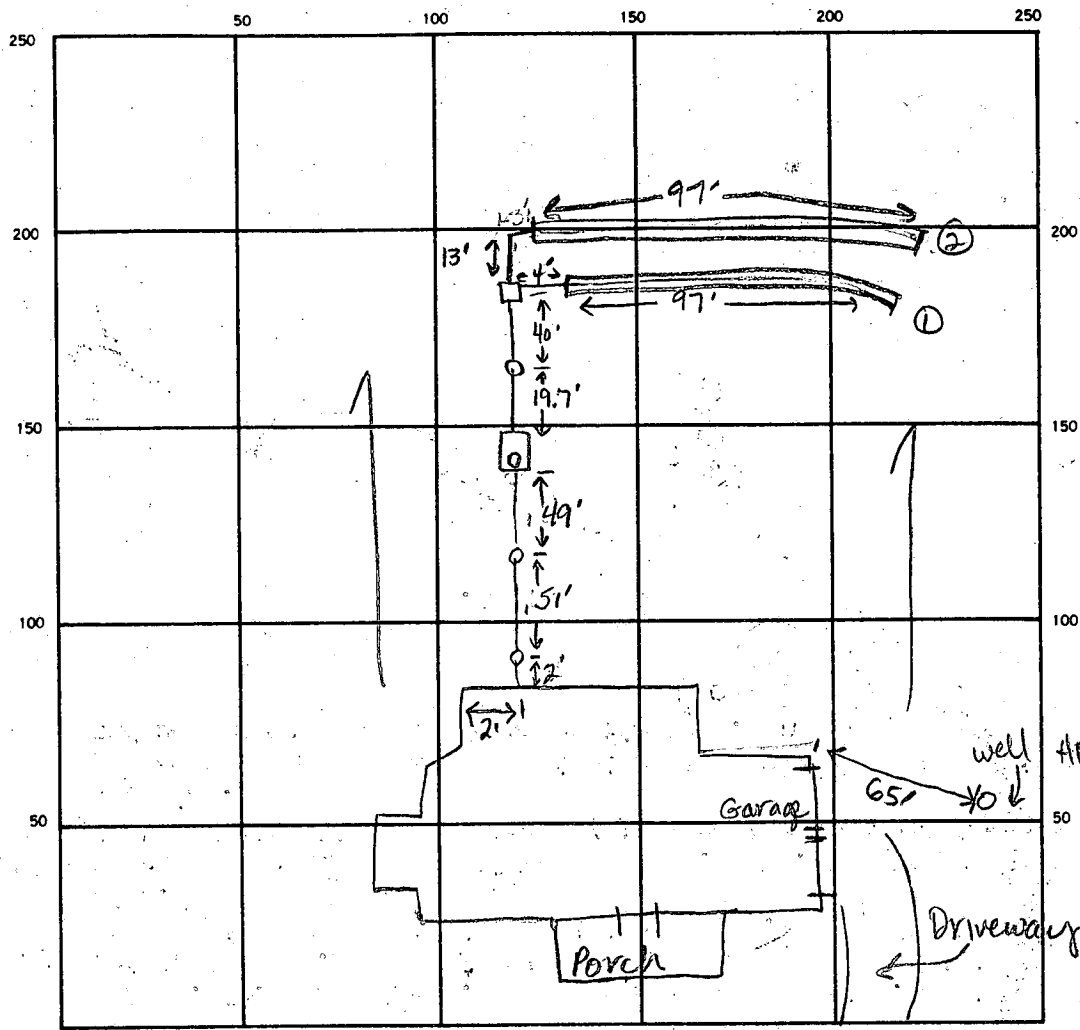

2
187
748
388
360

40-81-1707

INDICATE NORTH. — NAME ADJOINING ROADWAY AS BASE LINE.

Linden Church Rd

SEPTIC TANK LEVEL ✓ 1250 gal CLEANOUTS 2 on septic line, 1 on ST

DISTRIBUTION BOX LEVEL ✓ OK

DRAIN FIELD/TILE FIELD DEPTH 8 8 FT. TRENCH WIDTH 2 FT. INLET DEPTH 4 4 FT.

EFFECTIVE GRAVEL DEPTH 4 4 FT. TOTAL LENGTH 97 97 FT.

NUMBER OF TRENCHES 2 ONE SIDEWALL/BOTTOM AREA 388 388 SQ. FT.

DRYWELL INSIDE DIAMETER _____ FT. EFFECTIVE DEPTH BELOW INLET _____ FT.

ABSORBENT AREA 776 SQ. FT.

REMARKS 8-13-87 OK to cover work up to distribution box, add stone, pipe and paper to trench 1, location ok, good soil to 8 ft at right end of trench 1. JEN 8-13-87 OK to add stone to trench 2 and cover trench 1 JEN. Call for final, 8-14-87 OK to cover all work. JEN.

DATE SYSTEM APPROVED 8-14-87 INSPECTOR Jane E. Madear

SUBDIVISION: Campbell Property
LINDEN CHURCH Rd.

LOT NUMBER: 2

DRY WELL OR DRY WELL AND TRENCH

_____ sq. ft./bedroom

| | <u>Septic Tank</u> | <u>Minimum Total square Feet</u> |
|-----------|--------------------|----------------------------------|
| 3 bedroom | 1000 gallon | _____ |
| 4 bedroom | 1250 gallon | _____ |
| 5 bedroom | 1500 gallon | _____ |

Inlet _____ feet below original grade.

Bottom maximum depth _____ feet below original grade.

Effective area begins at _____ feet below original grade.

NOTE: If trench is used to make up absorbent area, run the trench on level ground and leave a 5 foot earth buffer between dry well and trench. No trench is to exceed 100 feet in length. Trench inlet to be same as dry well, with _____ feet of stone below distribution pipe.

TRENCHES

187 sq. ft./bedroom

Trench to be 2 wide.

Inlet 4 feet below original grade.

Bottom maximum depth 8 feet below original grade.

Effective area begins at 4 feet below original grade.

4 feet of stone below distribution pipe.

4BR per BP 11407

- NOTE:
- (1) No trench to exceed 100 feet in length.
 - (2) If more than one trench used, a distribution box is required.
 - (3) Trenches to be installed on level ground.
 - (4) Call for inspection of trench before gravel is installed.
 - (5) Provide 6"-8" diameter cleanout and cap to grade or above on septic tank and drywell.
 - (6) If a Garbage disposal is used, increase septic tank capacity by 50% and increase absorbant sidewall area by 22%.

LOCATION: START THE TRENCH 420 FT FROM THE 289.69 FT LOT LINE AND 40 FT FROM THE 552.80 FT LOT LINE, RUN TRENCH(S) ALONG LEVEL GROUND TOWARDS THE 500 FT LOT LINE. SA

APPLICATION

SEWAGE DISPOSAL TESTING

STATE OF MARYLAND - DEPARTMENT OF HEALTH AND MENTAL HYGIENE

A 34760
P _____

HOWARD COUNTY HEALTH DEPARTMENT
ENVIRONMENTAL HEALTH SERVICES
P. O. BOX 476 ELLICOTT CITY, MARYLAND 21043
TELEPHONE: 992-2330

DISTRICT 5

*MAY. 8' MAYBE 7'
check soil profile*

DATE 1/8/85

TO: THE COUNTY HEALTH OFFICER
ELLICOTT CITY, MARYLAND

I, HEREBY, APPLY FOR THE NECESSARY TEST IN ORDER TO CONSTRUCT (OR RECONSTRUCT) A SEWAGE DISPOSAL SYSTEM.

PROPERTY OWNER ~~Wendell Campbell~~ FRANK M Arcotte

ADDRESS Adelphi Road, Adelphi, Md PHONE 434-4416

PROPERTY LOCATION: Parcel 117 - Taxmap 28

SUBDIVISION Campbell Property LOT NO. 2

ROAD AND DESCRIPTION Linden Church Road, Clarksville, Maryland

County Road 12920 Linden Church Rd.

SIZE OF LOT 3.6 Acres TYPE BLDG. Single Family 4-
(NUMBER OF BEDROOMS)

THE SYSTEM INSTALLED UNDER THIS APPLICATION IS ACCEPTABLE ONLY UNTIL PUBLIC FACILITIES BECOME AVAILABLE. I FULLY UNDERSTAND THE

FEE CONNECTED WITH THE FILING OF THIS PERC TEST APPLICATION IS NON-REFUNDABLE UNDER ANY CIRCUMSTANCES. I ALSO AGREE TO COMPLY

WITH ALL M.O.S.H.A. REQUIREMENTS IN TESTING THIS LOT. Donald J. Oliver - Agent
(SIGNATURE OF APPLICANT)

APPROVED BY Sid. Abel FOR FRANCHISES DATE 7-8-85

REJECTED BY _____ FOR _____ DATE _____


HOLD PENDING FURTHER TESTS _____ DATE _____

REASONS FOR REJECTION OR HOLDING 1-30-85- perc. OK hold for certified hole PERAT Sabel

BLDG. PERMIT SIGNED
AND RETURNED 4/23/87
BP 11407 Sabel

THIS IS NOT A PERMIT

lot 2

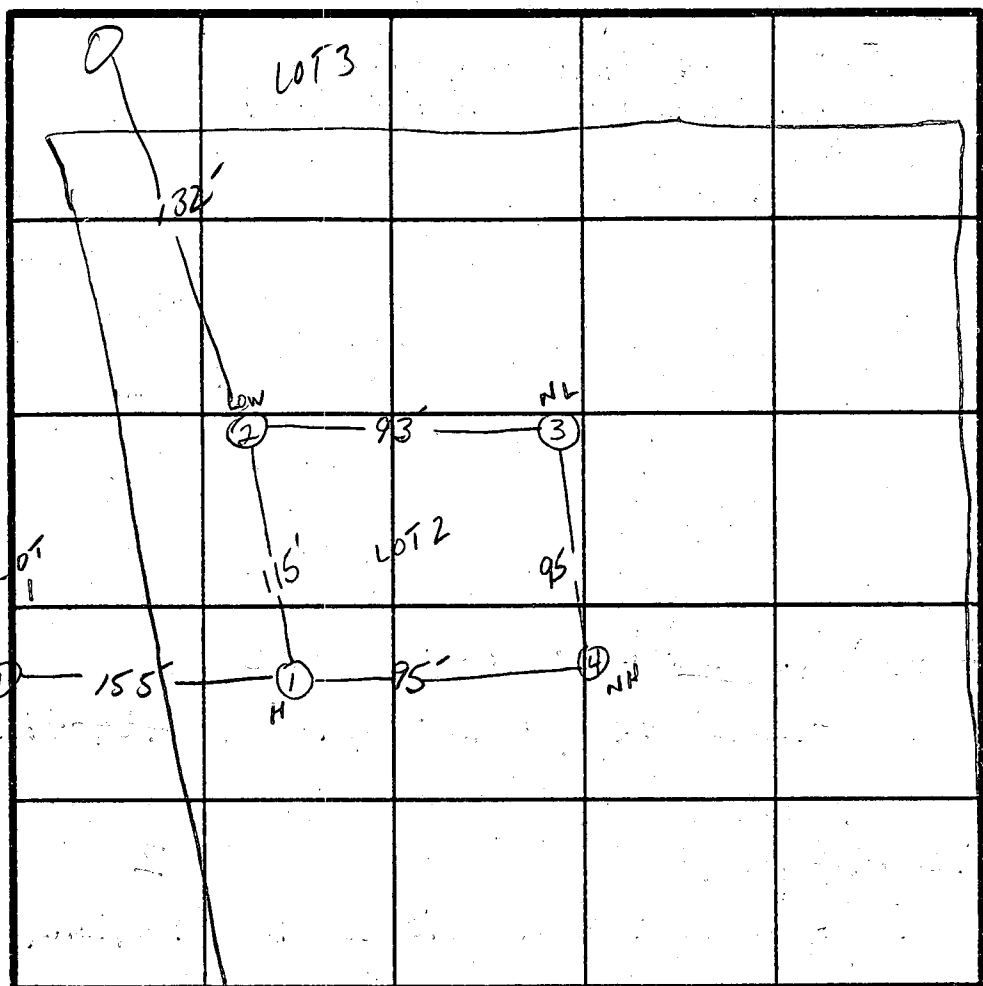

Low = 2
High = 1
N Low = 3
N High = 4

Speed *
shut = 4'
depth = 7'
map 8'
x 13 min

① SOIL PROFILE

| | |
|------|--|
| 0 | A ₀ -A ₃ |
| 1' | RED BROWN CLAY LOAM |
| 3.5' | L10% SAPROLITE |
| | B ₁ -2 |
| | RED BROWN SILT LOAM |
| 6.0' | 20-30% B ₃ SAPROLITE |
| | BROWN SILT LOAM |
| | MICAEOUS QUARTZ |
| 8.5' | >50% SAPROLITE |
| 12' | STRUCTURED MICAEOUS SAPROLITE QUARTZ MIX |

②

| | |
|-----|-------------------------------|
| 0 | A ₀ -3 |
| 1' | RED BROWN CLAY LOAM |
| 5' | 20-30% SAPROLITE |
| | BROWN SILT LOAM |
| | >50% SAPROLITE micaeous |
| 8' | STRUCTURED micaeous SAPROLITE |
| 10' | SAPROLITE |
| | >50% |
| 12' | BROWN SANDY LOAM |

③

| | |
|-----|---------------------------|
| 0 | A ₀ -3 |
| 1' | BROWN CLAY LOAM |
| 3' | 30-40% SAPROLITE micaeous |
| | BROWN SILT LOAM |
| | >50% mica SAPROLITE |
| 10' | STRUCTURED SAPROLITE |

④

| | |
|-----|---------------------------------|
| 0 | A ₀ -3 |
| 1' | RED BROWN CLAY LOAM |
| 5' | 20-30% B ₂ SAPROLITE |
| | C] Silty LOAM |
| | >50% SAPROLITE micaeous |
| 10' | STRUCTURED SAPROLITE |
| 13' | LARGE Fr. ROCK |

INDICATE NORTH - NAME ADJOINING ROADWAY AS BASE LINE.
V LINDEN CHURCH Rd. V

| DATE | TEST NO. | DEPTH | PRE-WET | | TEST - 1" DROP | | TIME | |
|---------|----------|----------------------|-----------------------------|--------------------------------|------------------|-------|--------|--|
| | | | START | STOP | START | STOP | | |
| 1/30/85 | 1S | 4.5' | 11:26 | 11:29 | 11:29 | 11:33 | 4 min | |
| | 1M | 8.5' | 11:36 | 11:41 | 11:41 | 11:47 | 6 min | |
| | 1V | 12' | STRUCTURED SAPROLITE | | From 8.5' to 12' | | | |
| | 2S | 4.5' | 11:53 | 12:18 | 12:18 | 12:47 | 29 min | |
| | 2M | 8' | 12:02 | 12:16 | 12:16 | 12:40 | 24 min | |
| | 2V | STRUCTURED SAPROLITE | | From 8:10' OK Below 10' to 12' | | | | |
| | 3S | 4.5' | 12:17 | 12:18 | 12:18 | 12:20 | 2 min | |
| | 3M | 8' | 12:19 | 12:23 | 12:23 | 12:30 | 7 min | |
| | 3V | 12' | STRUCTURED SAPROLITE | | 11'-12' | | | |
| | 4S | 4.0' | 12:37 | TOO SLOW > 30 min FOR 1/2" | | | | |
| | 4M | 8' | 12:36 | 12:43 | 12:43 | 12:51 | 8 min | |
| | 4V | 13' | LARGE FRACTURED ROCK AT 13' | | | | | |
| | 4SA | 5' | 1:00 | TOO SLOW > 30 min FOR 1/2" | | | | |
| | 4SB | 6' | 2:33 | 2:34 | 2:34 | 2:36 | 2 min | |


REMARKS * Keep System away from Res. hole #4 good soil doesn't begin until 5.5' - 6' down
TYPE OF SOIL Highley Micaeous Silt Loam
TESTED BY S. Abel / R. Hodges
ALSO PRESENT U660 VAN DER WALT KEVIN

EH-12-10

William E. Doyle

LAND SURVEYOR 8440

5312 EMERALD DRIVE SYKESVILLE, MARYLAND 21784 PHONE (301) 795-2210

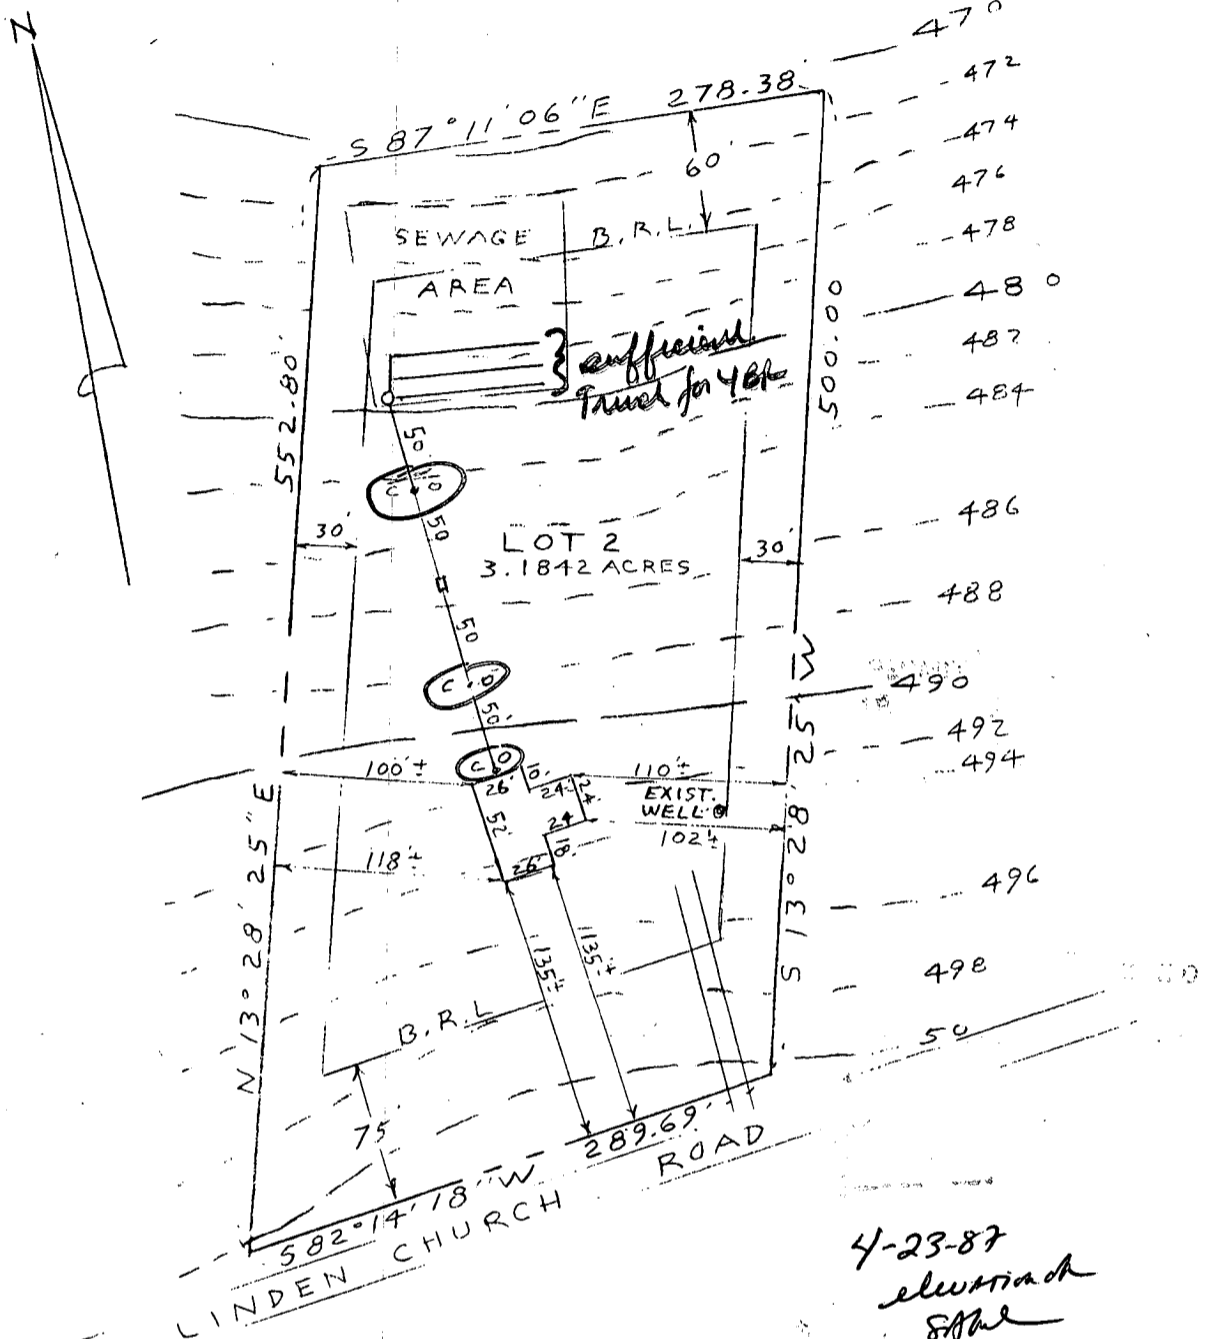

4-23-87
elevation
S.H.W.

| | |
|---------------------------|-----------------|
| EXIST. GRN. AT DISTR. BOX | 479.60 ✓ |
| INV. IN DISTR. BOX | 476.10 ✓ |
| INV. OUT OF SEPTIC TANK | 478.10 ✓ |
| INV. INTO SEPTIC TANK | 478.50 ✓ |
| INV. OUT OF DWELLING | 480.50 (⊕) BSMT |
| FIRST FLOOR ELEV. | 496.00 ✓ |
| CELLAR ELEV. | 487.00 ✓ |
| WELL ELEV. | 494.00 ✓ |
| NO. OF BEDROOMS | 3 |
| ACREAGE | 3.1842 ACRES |

3.5" INLET
SHOULD BE 4"

PLOT PLAN
LOT 2, LINDEN CHURCH ROAD
LIBER 1345 FOLIO 479
TAX MAP 28, PARCEL 117
PLAT NO. 6265
HOWARD COUNTY MD.

BLDG. PERMIT SIGNED
AND RETURNED 4-23-87

BP# 11407 S.H.W.

I CERTIFY THE ABOVE MEASUREMENTS
AND ELEVATIONS ARE ACTUAL AND
CORRECT FOR THIS PROPERTY.

signed William E. Doyle

SCALE: 1" = 100'

DRAWN: APRIL 13, 1987



FILE NO. 393-25

B 1 5273

SEQUENCE NO. (OEP USE ONLY)

STATE OF MARYLAND PERMIT TO DRILL WELL

OEP PERMIT NUMBER

10-81-1707 fill in this form completely

(THIS NUMBER IS TO BE PUNCHED IN COLS. 3-6 ON ALL CARDS)

please print or type

Date Received 10-18-88

OWNER INFORMATION

Owner information grid with fields for Last Name, First Name, Street or RFD, Town, State, Zip.

B 3

LOCATION OF WELL


Location of well grid with fields for County, Subdivision, Section, Lot, Nearest Town, Miles from town.

DRILLER INFORMATION

Driller information grid with fields for Driller's Name, License No., Firm Name, Address, Signature, Date.

B 4

DIRECTION OF WELL FROM TOWN (CIRCLE BOX)

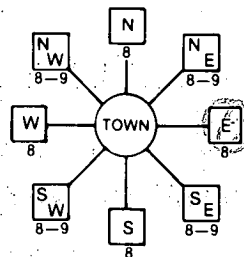

NEAR WHAT ROAD Linden Church Road

ON WHICH SIDE OF ROAD (CIRCLE APPROPRIATE BOX)



DISTANCE FROM ROAD 160

ENTER FT or MI 160

B 2

WELL INFORMATION

Well information grid with fields for Approx. Pumping Rate, Average Daily Quantity Needed.

USE FOR WATER (CIRCLE APPROPRIATE BOX)

- Home (Single or Double Household Unit Only)
Farming (Livestock Watering & Agricultural Irrigation)
Industrial, Commercial, State and Federal Gov. Other (Requires Appropriation Permit)
Public or Private Water Company (Requires Appropriation Permit and State Health Department Approval)
Test, Observation, Monitoring (May Require Appropriation Permit)

NOT TO BE FILLED IN BY DRILLER HEALTH DEPARTMENT APPROVAL

Health department approval section with fields for County Name, County No., OEP Signature, Date Issued, CO Signature, Exp. Date, North Grid, East Grid.

APPROXIMATE DEPTH OF WELL 300 FEET

APPROXIMATE DIAMETER OF WELL 6 INCH

METHOD OF DRILLING (circle one)

- Bored (or Augered)
Jetted
Jetted & Driven
Air-Rotary
Air-PerCussion
Rotary (Hydraulic Rotary)
Cable
Reverse-Rotary
Drive-Point
other

REPLACEMENT OR DEEPEMED WELLS (CIRCLE APPROPRIATE BOX)

- This well will not replace an existing well
This well will replace a well that will be abandoned and sealed
This well will replace a well that will be used as a standby
This well will deepen an existing well
Permit number of well to be replaced or deepened (if available)

Not to be filled in by driller (OEP USE ONLY)

APPROP. PERMIT NUMBER GAP


FORCE INITIALS IN BOX PERMIT NO. 10-81-1707

SHOW MAJOR FEATURES OF BOX & LOCATE WELL WITH AN X

SOURCES OF DRILLING WATER

- 1. Well
2.
3.

WRITE THE BOX NUMBER FROM THE MAP HERE

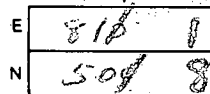

DRAW A SKETCH BELOW SHOWING LOCATION OF WELL IN RELATION TO NEARBY TOWNS AND ROADS AND GIVE DISTANCE FROM WELL TO NEAREST ROAD JUNCTION



Handwritten notes: Well 26 10/31/88 4 1/2" pipe 35' open 10+ BAGS left before well sites complete sample OK S. And

C-1 5342

SEQUENCE NO. (OEP USE ONLY)

STATE OF MARYLAND WELL COMPLETION REPORT

FILL IN THIS FORM COMPLETELY PLEASE PRINT OR TYPE

THIS REPORT MUST BE SUBMITTED WITHIN 45 DAYS AFTER WELL IS COMPLETED.

COUNTY NUMBER A 34760

DATE RECEIVED

8 13

DATE WELL COMPLETED

10/3/86

DEPTH OF WELL

360 (TO NEAREST FOOT)

PERMIT NO. FROM "PERMIT TO DRILL WELL"

HD-RI-1707

OWNER MARCOTZ FRANK

STREET OR RFD LINDEN CHURCH RD. TOWN DAYTON

SUBDIVISION CAMPBELL PROPERTY SECTION LOT 2

WELL LOG

Not required for driven wells

GROUTING RECORD

WELL HAS BEEN GROUTED (Circle appropriate box) Y N

TYPE OF GROUTING MATERIAL CEMENT BENTONITE CLAY

CEMENT CM BENTONITE CLAY BC

NO. OF BAGS NO. OF POUNDS

GALLONS OF WATER DEPTH OF GROUT SEAL (to nearest foot)

from 0 ft. to 35 ft. (enter 0 if from surface)

CASING RECORD

ST CO STEEL CONCRETE PL OT PLASTIC OTHER

MAIN CASING TYPE Nominal diameter top (main) casing (nearest inch) Total depth of main casing (nearest foot)

ST 6 49

OTHER CASING (if used)

diameter: inch depth (feet) from to

SCREEN RECORD

ST BR HO STEEL BRASS OPEN HOLE PL OT PLASTIC OTHER

C-2

DEPTH (nearest ft.) H0 48 360

SLOT SIZE 1 2 3 DIAMETER OF SCREEN (NEAREST INCH)

GRAVEL PACK IF WELL DRILLED WAS FLOWING WELL INSERT F IN BOX 68

OEP USE ONLY (NOT TO BE FILLED IN BY DRILLER) T (E.R.O.S.) WQ TELESCOPE CASING LOG INDICATOR OTHER DATA

C-3

PUMPING TEST

HOURS PUMPED (nearest hour) 6

PUMPING RATE (gal. per min. to nearest gal.) 2

METHOD USED TO MEASURE PUMPING RATE

WATER LEVEL (distance from land surface)

BEFORE PUMPING 45

WHEN PUMPING 29.5

TYPE OF PUMP USED (for test)

A air P piston T turbine C centrifugal R rotary O other (describe below) J jet S submersible

PUMP INSTALLED

DRILLER WILL INSTALL PUMP (CIRCLE) YES NO IF DRILLER INSTALLS PUMP, THIS SECTION MUST BE COMPLETED FOR ALL WELLS EXCEPT HOME USE TYPE OF PUMP INSTALLED PLACE (A,C,J,P,R,S,T,O) IN BOX - SEE ABOVE:


CAPACITY: GALLONS PER MINUTE (to nearest gallon) 31 35

PUMP HORSE POWER 37 41

PUMP COLUMN LENGTH (nearest ft.) 43 47

CASING HEIGHT (circle appropriate box and enter casing height) + above - below LAND SURFACE (nearest foot)

LOCATION OF WELL ON LOT SHOW PERMANENT STRUCTURE SUCH AS BUILDING, SEPTIC TANKS, AND/OR LANDMARKS AND INDICATE NOT LESS THAN TWO DISTANCES (MEASUREMENTS TO WELL)

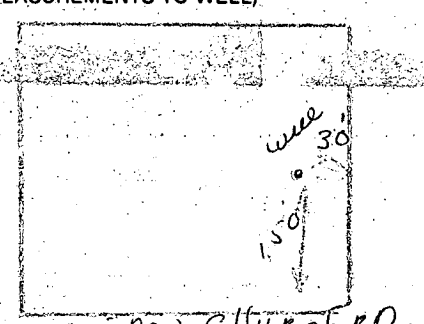

STATE THE KIND OF FORMATIONS PENETRATED, THEIR COLOR, DEPTH, THICKNESS AND IF WATER BEARING

DESCRIPTION (Use additional sheets if needed) FEET FROM TO Check if water bearing

SAND Stone 0 41 GRAY MICA Rock 41 360

CIRCLE APPROPRIATE LETTER A WELL WAS ABANDONED AND SEALED WHEN THIS WELL WAS COMPLETED

E ELECTRIC LOG OBTAINED

P TEST WELL CONVERTED TO PRODUCTION WELL

I HEREBY CERTIFY THAT THIS WELL HAS BEEN CONSTRUCTED IN ACCORDANCE WITH COMAR 10.17.13 "WELL CONSTRUCTION" AND IN CONFORMANCE WITH ALL CONDITIONS STATED IN THE ABOVE CAPTIONED PERMIT, AND THAT THE INFORMATION PRESENTED HEREIN IS ACCURATE AND COMPLETE TO THE BEST OF MY KNOWLEDGE.

DRILLERS IDENT. NO.

DRILLERS SIGNATURE (MUST MATCH SIGNATURE ON APPLICATION)

SITE SUPERVISOR (sign. of driller or journeyman responsible for sitework if different from permittee)

Page _____ of _____
 Date 10/31/86

Review OK'd BA 2/23/87

FIELD DATA SHEET
HOWARD COUNTY WELL YIELD TEST

Well Permit No. HO - 81-1707
 Location of property (road) LINDEN CHURCH RD
 Subdivision CAMBELL PROPERTY Lot 2 Block _____ Plat _____ Sec. _____
 Well Driller JOSEPH MAYNE Owner MARCOVE, FRANK

Depth of well 360'
 Distance of measuring point (M.P.) above ground 1'
 Static water level (S.W.L.) below M.P. 45'

I. High rate pumping -- reservoir drawdown

Time pump started 8:00 Pumping rate 12
 Total time 45 min to reach pumping water level 295 ft. below M.P.

II. Recovery pump test data - observations to be recorded every 15 minutes

| TIME (in 15 minute intervals) | WATER LEVEL below M.P. | PUMPING RATE time to fill 1 gallon bucket | FLOW METER READING (if used) | CALCULATED FLOW (gallons per minute) |
|-------------------------------|------------------------|---|------------------------------|--------------------------------------|
| 8:15 | 150 | 5 sec | | 12 |
| 8:30 | 220 | 5 | | 12 |
| 8:45 | 295 | 5 | | 12 |
| 9:00 | 295 | 34 | | 1 3/4 |
| 9:15 | 295 | 34 | | 1 3/4 |
| 9:30 | 295 | 34 | | 1 3/4 |
| 9:45 | 293 | 34 | | 1 3/4 |
| 10:00 | 293 | 30 | | 2 |
| 10:15 | 293 | 30 | | 2 |
| 10:30 | 293 | 30 | | 2 |
| 10:45 | 293 | 30 | | 2 |
| 11:00 | 293 | 30 | | 2 |
| 11:15 | 293 | 30 | | 2 |
| 11:30 | 293 | 30 | | 2 |
| 11:45 | 293 | 30 | | 2 |
| 12:00 | 293 | 30 | | 2 |
| 12:15 | 293 | 30 | | 2 |
| 12:30 | 293 | 30 | | 2 |
| 12:45 | 293 | 30 | | 2 |
| 1:00 | 293 | 30 | | 2 |
| 1:15 | 293 | 30 | | 2 |
| 1:30 | 293 | 30 | | 2 |
| 1:45 | 293 | 30 | | 2 |
| 2:00 | 293 | 30 | | 2 |
| 2:15 | 293 | 30 | | 2 |
| 2:30 | 293 | 30 | | 2 |

PLAT # 3503

Cornelius Jenkins
978 / 578

S 13° 28' 25" W

S 82° 14' 18" W 26.82

S 13° 28' 25" W

851.17

S 13° 28' 25" W 348.48

26.82
2682
200.69
630.53
630.62





DEDICATED TO HOWARD COUNTY,
MARYLAND FOR THE PURPOSE OF A PUBLIC ROAD

ROAD

0.9655 AC OF LAND DEDICATED TO HOWARD COUNTY,
MARYLAND FOR THE PURPOSE OF A PUBLIC ROAD

CHURCH



WIDEN

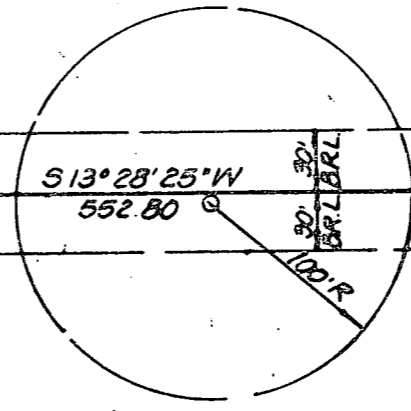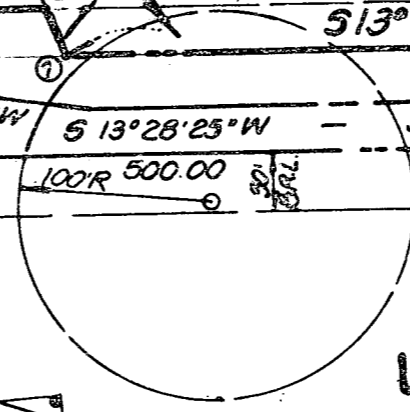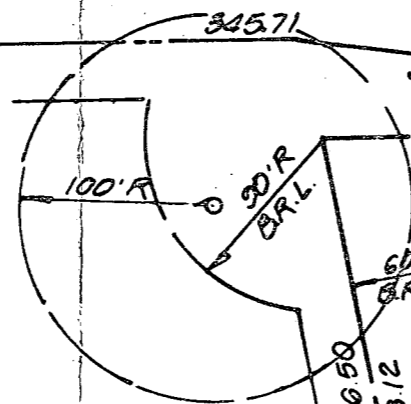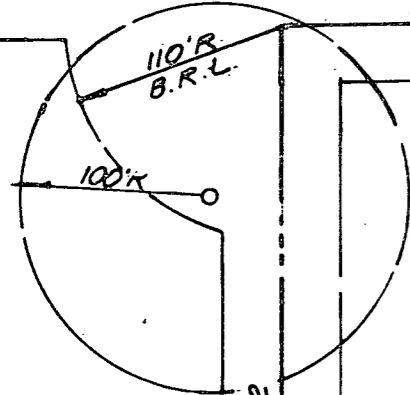

LOT 3
5.7640 Acres

LOT 2
3.1842 Acres

LOT 1
3.6882 Acres

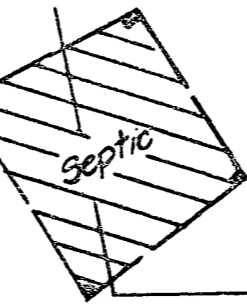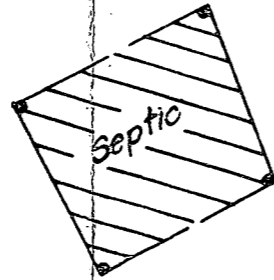

582.52

30' B.R.L. 30' B.R.L.

N 75° 57' 27" W

546.58
288.12

30' B.R.L.

S 87° 11' 06" E
270.56

60' B.R.L.

S 13° 28' 25" W
552.80

30' B.R.L. 30' B.R.L.

75' B.R.L.

75' B.R.L.

60' B.R.L.

462.00

30' B.R.L.

610.00

1748.93

300.00
N 82° 14' 18" W
582.14

26.82

4. easement by Maryland Mental Hygiene Improvement of public health until prohibited any building and void of system. This symbol site = O
5. Percolation has been filed for flow provided lot
6. For flow provided lot
7. For flow provided lot
8. For flow provided lot

6/20/85 as signed
J.S.

HOWARD COUNTY HEALTH DEPARTMENT

BUREAU OF ENVIRONMENTAL HEALTH

PUMP INSTALLATION

THE FOLLOWING STATEMENT MUST BE COMPLETED BY THE HOME OWNER
WHEN A PUMP IS INSTALLED BY A PERSON OTHER THAN THE WELL
DRILLER:

My well driller is not to install the pump for my water well, and I
hereby certify that it will be my responsibility to have a Pump Permit
taken out by a registered master plumber or certified pump installer.
It will be my responsibility to notify the Health Department before
and during the installation so that inspections can be made by their
representative. (Pursuant to Chapter XVII, of the Plumbing Code of
Howard County.)

Frank J. Marcotte
(Name)

16337 Old Frederick Rd
(Address) Mt Airy, MD 21771
442-1484

HO 811707
(OEP Well Permit Number)

9/6/86
(Date)

10/8/86

W.C. Cambell property


William E. Doyle

LAND SURVEYOR 8440

8312 EMERALD DRIVE SYKESVILLE, MARYLAND 21784 PHONE (301) 795-2210

LOCATION SURVEY

12920 LINDEN CHURCH ROAD
LOT 2, LIBER 1345, FOLIO 779
PLAT NO. 6265
ELECTION DISTRICT 5
HOWARD COUNTY MD.

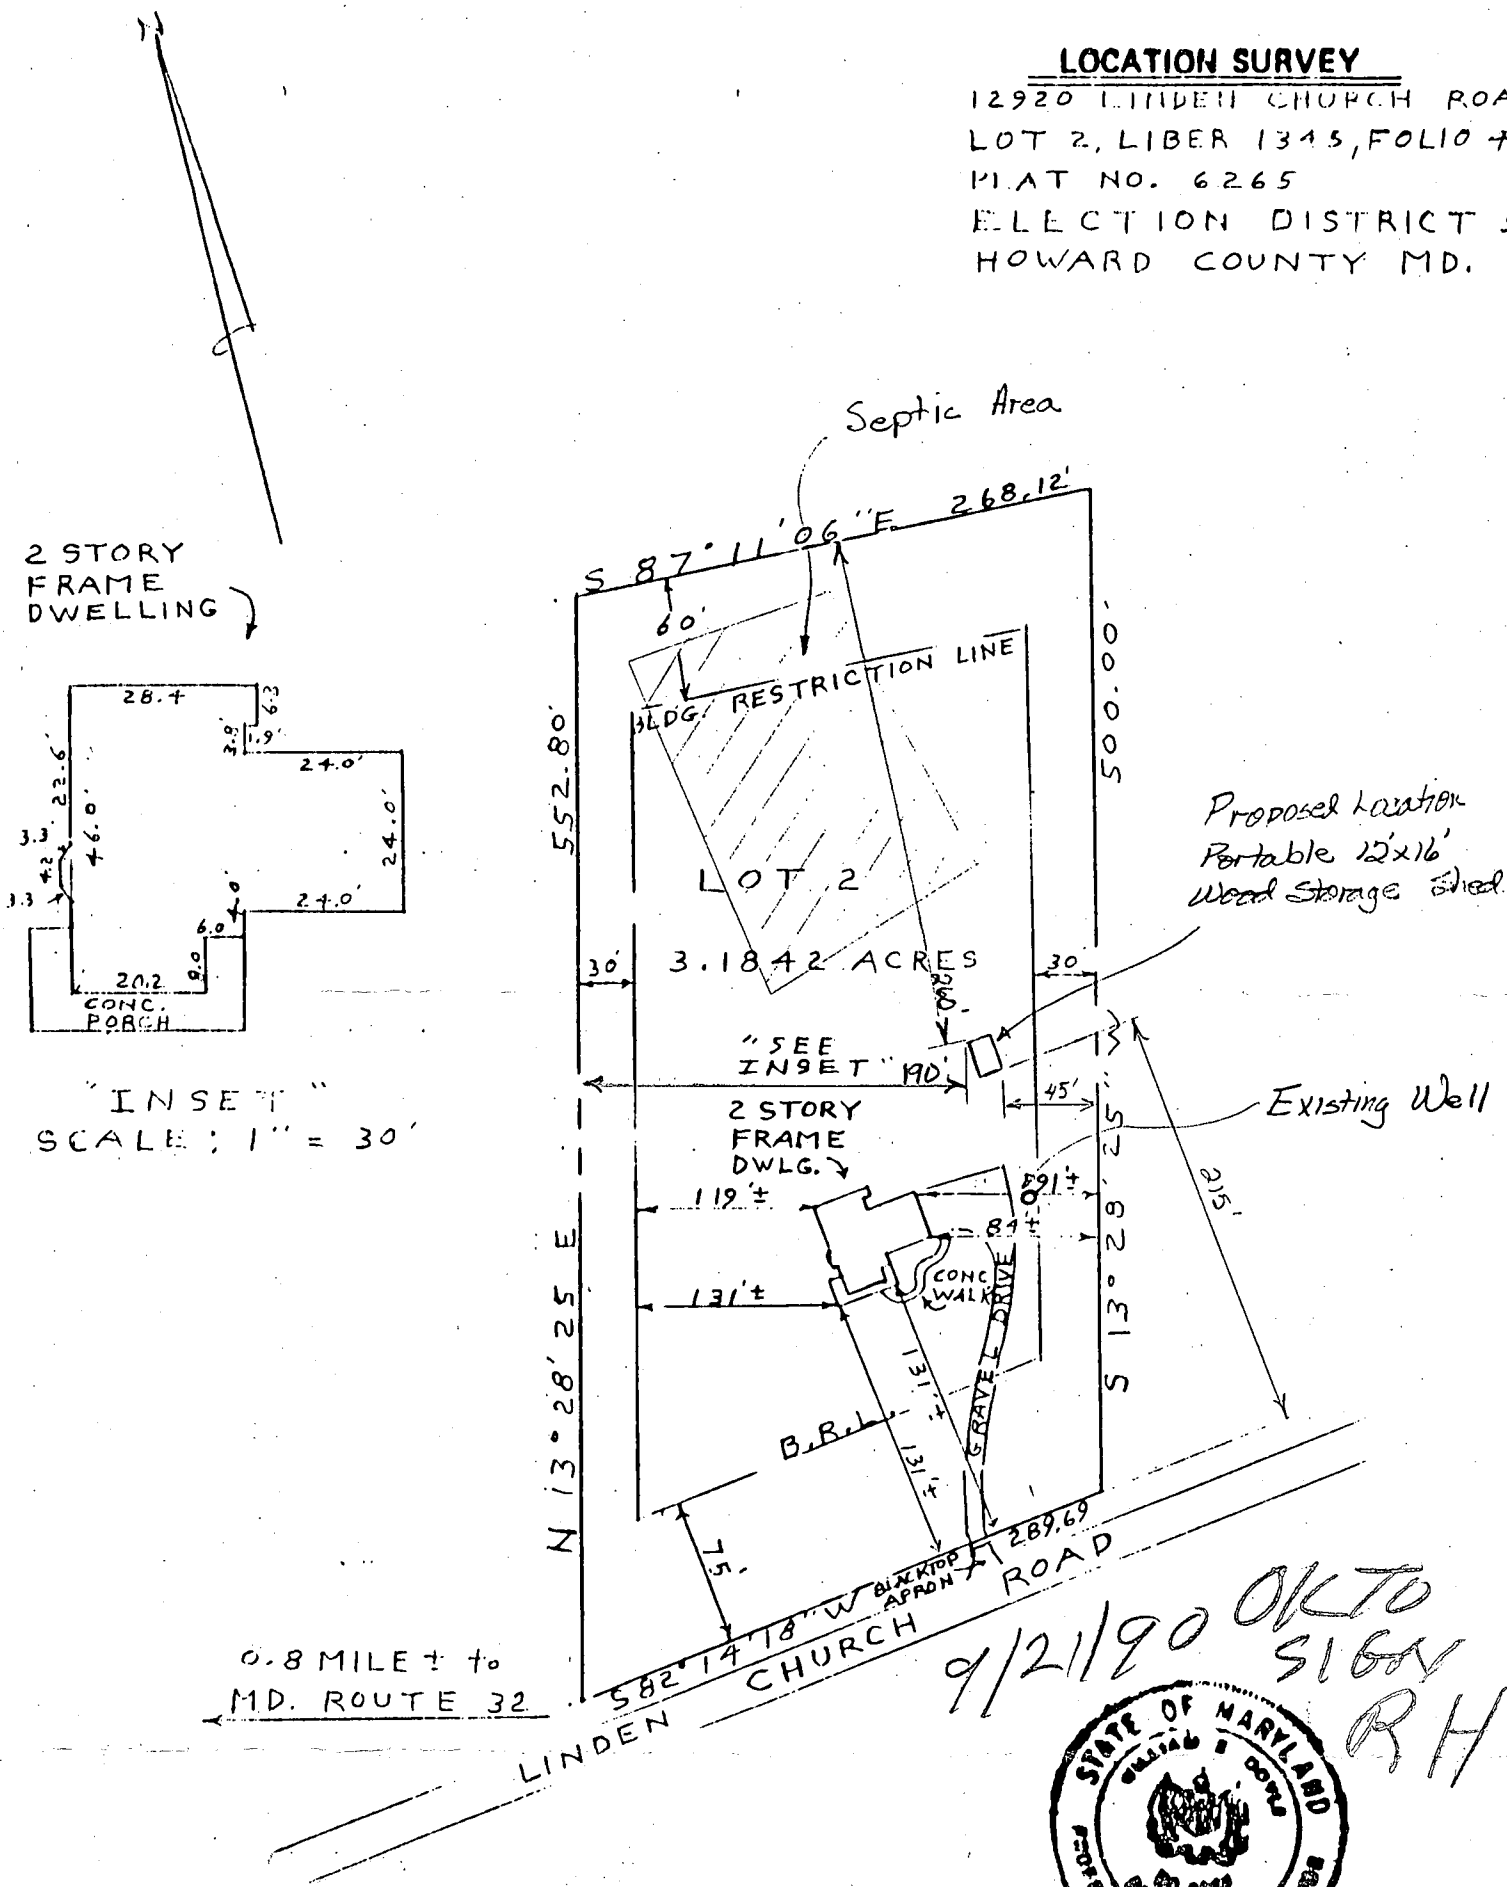

THIS IS TO CERTIFY THAT WE HAVE MADE A LOCATION SURVEY OF THE IMPROVEMENTS, AND THAT THEY ARE LOCATED ON THE LOT AS SHOWN HEREON.

Signed This 23rd day DECEMBER 1987

William E. Doyle

SCALE 100 ft. = 1 inch

File No. 393-25

NOTE: This plat cannot be used to establish property lines or corners.

