

3/2/84
around noon please

Approved 3/2/84
Stayed

PERMIT

P 33607

A Repair

SEWAGE DISPOSAL SYSTEM

MARYLAND STATE DEPARTMENT OF HEALTH*

HOWARD COUNTY
BUREAU OF ENVIRONMENTAL HEALTH
992-2330

06-431704
INDEX

ELLICOTT CITY
DISTRICT 5th

DATE 3/1/84

Jack Fyock

IS PERMITTED TO INSTALL _____ ALTER

ADDRESS 13775 Triadelphia Road, Glenelg, Maryland 21737 PHONE 988-9270

SUBDIVISION _____ ROAD 7687 Kindler Road LOT _____

PROPERTY OWNER Robert R. Templeton

ADDRESS 7687 Kindler Road, Lanel, Maryland 20707 Phone: 725-6679

IF GARBAGE GRINDER IS USED INCREASE SEPTIC TANK CAPACITY BY 50% AND ABSORPTION AREA BY 22%.

GARBAGE GRINDER? YES _____ NO _____

SEPTIC TANK CAPACITY _____ GALLONS NUMBER OF BEDROOMS _____

REPAIR - Call for an appointment when ground is opened up and Sanitarian will recommend the ~~repair~~ repair system.

PLANS APPROVED BY Frank A. Skinner DATE 3/1/84

COVER NO WORK UNTIL INSPECTED AND APPROVED.

NEITHER THE HOWARD COUNTY COUNCIL NOR THE HEALTH DEPARTMENT IS RESPONSIBLE FOR THE SUCCESSFUL OPERATION OF ANY SYSTEM.

NOTE: IF TRENCH IS USED CALL FOR INSPECTION BEFORE AND AFTER PLACING GRAVEL IN TRENCH.

NOTE: NO DRY WELL SHALL EXCEED 15 FOOT IN DIAMETER. NO ABSORPTION TRENCH TO EXCEED 100 FEET IN LENGTH.

NOTE: ALL PIPE FROM HOUSE TO SEPTIC TANK MUST BE CAST IRON OR SCHEDULE 40 PVC OR ABS.

PERMIT VOID AFTER THREE YEARS.


NOTE: INSTALL STAND PIPE ON SEPTIC TANK AND DRY WELL. STAND PIPES MUST BE 6 INCHES IN DIAMETER. CAST IRON, CONCRETE OR TERRA COTTA, OR PVC OR ABS ACCEPTED. IF TOP OF SEPTIC TANK IS DEEPER THAN 3 FEET MANHOLE TO GRADE REQUIRED.

***INSTALLER IS RESPONSIBLE FOR OBTAINING FINAL APPROVAL ON THIS PERMIT**

*CALL 992-2330 FOR INSPECTION OF SEPTIC SYSTEMS.

EH - 2-1082

A 33607

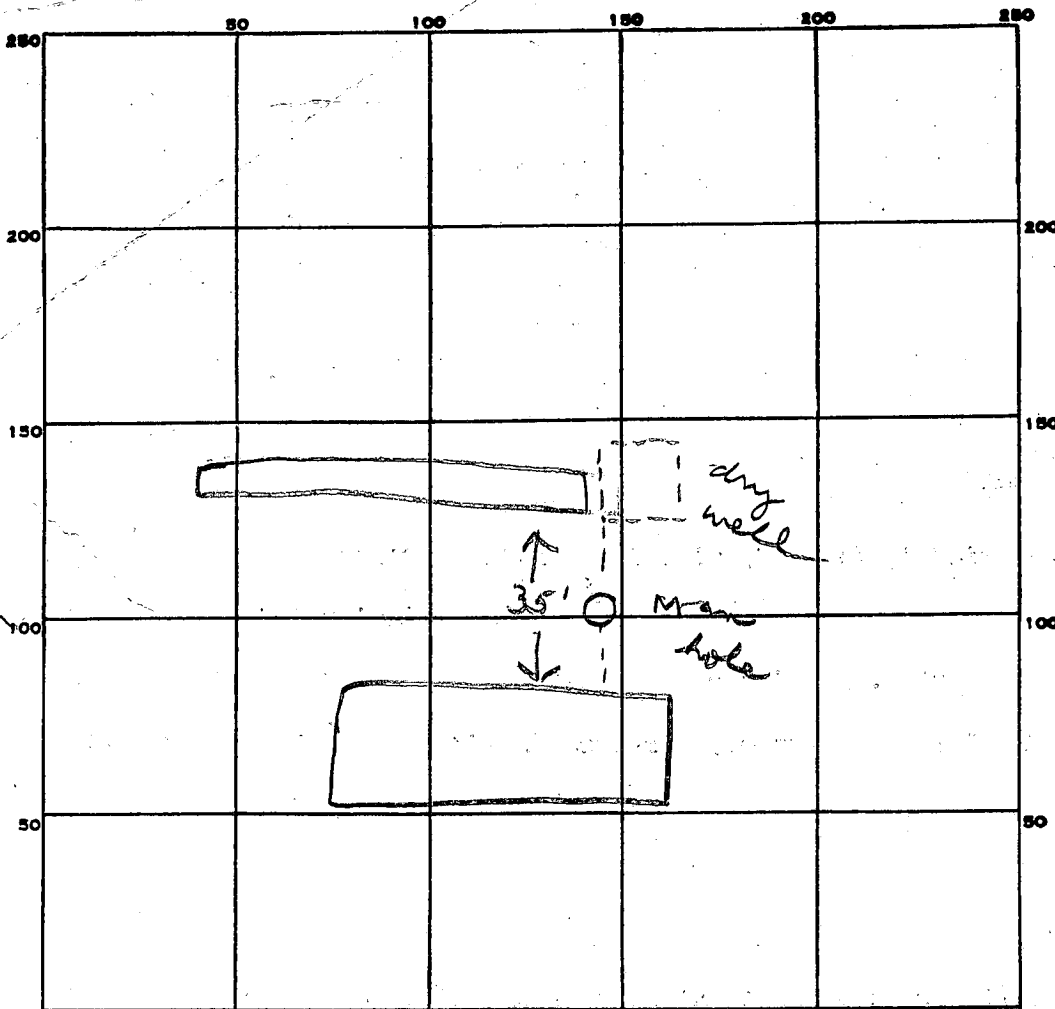

INDICATE NORTH. - NAME ADJOINING ROADWAY AS BASE LINE.

PERMIT CARD _____

SEPTIC TANK, LEVEL _____

CLEANOUTS _____

DISTRIBUTION BOX, LEVEL _____

TILE FIELD, DEPTH 11 FT. TRENCH WIDTH 2 FT.

GRAVEL DEPTH 7 IN. TOTAL LENGTH 55 FT.

NUMBER OF TRENCHES 1 TOTAL BOTTOM AREA 385

SEEPAGE PITS, INSIDE DIAMETER _____ FT. DEPTH BELOW INLET _____ FT.

ABSORBENT AREA 385 SQ. FT.

REMARKS 3/2/84 OK to add stone in trench. J

3/2/84 OK to cover all work. J

DATE SYSTEM APPROVED 3/2/84

INSPECTOR Stayer

3-2-84

I, Hazel Templeton
measured depth to be
14 1/2 ft deep & dry -

11 ft+ & Dry & sand

11 ft+ & Dry & sand

11 ft+ & Dry & sand

7687 Kendler Rd
Laurel, Md. 20707

Hazel S. Templeton

REGION Septic

[CALL FRIDAY MONDAY]

#5171 III

AREA _____ RATING _____

ACKNOWLEDGMENT AND CONTROLS	DATE
T/C <u>no coverage</u>	5/31
<u>applied at surface</u>	
<u>per Mr. Templeton 4:26</u>	

Howard County Department of Health
BUREAU OF ENVIRONMENTAL HEALTH

DISPOSITION	DATE

RECORD OF INVESTIGATION

Hammond Park Hammond

LOCATION 7687 Kindler Rd. Laurel MD ZIP 21113

OWNER Hazel Templeton ADDRESS 53/2/84 PHONE 725-6679

OCCUPANT Robert R. ADDRESS Mr. Fyock Jr. Contractor PHONE _____

COMPLAINANT _____ ADDRESS _____ PHONE _____

REASON FOR INVESTIGATION (asked) before going out, problem with septic system
(repaired last year another day well on 6/5/85)

RECEIVED BY R. Presti DATE 5-31-85 ASSIGNED TO C.B.S. DATE 5-31-85

DATE OF INVESTIGATION 6/4/85 TIME 3:00 PM WEATHER MILD, CLEAR

REPORT 6/4/85 TRENCH REPAIR HAD BEEN PROPERLY INSTALLED

AND APPROVED - 1 YR PREVIOUS. ~~1-3~~ FT. OF SOIL HAD WASHED OUT OF TRENCH. INSPECTION REVEALED SLIGHTLY ERODED DRAINAGE SWALE FEEDING INTO TRENCH. ONE RAIN GUTTER DUMPING TO SWALE. INFORMED MRS TEMPLETON THAT CORRECT REMEDY WOULD REQUIRE DIVERSION OF RUNOFF AWAY FROM TRENCH AREA.

Craig William

DATE SUBMITTED 6/4/85 SANITARIAN Craig William