

5/18/84  
9:30 AM

approved  
5/18/84  
CW

# PERMIT

P 33765

A Repair

SEWAGE DISPOSAL SYSTEM

MARYLAND STATE DEPARTMENT OF HEALTH\*

HOWARD COUNTY  
BUREAU OF ENVIRONMENTAL HEALTH  
992-2330

INDEX

04-319532

ELLICOTT CITY

DISTRICT 4th

DATE 4/10/84

Kenny Allen IS PERMITTED TO INSTALL \_\_\_\_\_ ALTER X

ADDRESS 15050 Carrs Mill Road, Woodbine, Md. 21797 PHONE 854-6561 or 489-7095

SUBDIVISION \_\_\_\_\_ ROAD 14501 MacClintock Drive OT \_\_\_\_\_

PROPERTY OWNER Mr. and Mrs. Adrian S. Huebner

ADDRESS 14501 MacClintock Drive, Glenwood, Maryland 21738 442-1268

IF GARBAGE GRINDER IS USED INCREASE SEPTIC TANK CAPACITY BY 50% AND ABSORPTION AREA BY 22%.

GARBAGE GRINDER? YES \_\_\_\_\_ NO \_\_\_\_\_

SEPTIC TANK CAPACITY \_\_\_\_\_ GALLONS NUMBER OF BEDROOMS \_\_\_\_\_

REPAIR - Call for an appointment when ground is opened up and Sanitarian will recommend the repair system.

INLET 4 1/2', BOTTOM 10 1/2' 5 FT STONE - 75' LONG. 5/18/84 CW

PLANS APPROVED BY Frank A. Skinner DATE 5/10/84

COVER NO WORK UNTIL INSPECTED AND APPROVED.

NEITHER THE HOWARD COUNTY COUNCIL NOR THE HEALTH DEPARTMENT IS RESPONSIBLE FOR THE SUCCESSFUL OPERATION OF ANY SYSTEM.

NOTE: IF TRENCH IS USED CALL FOR INSPECTION BEFORE AND AFTER PLACING GRAVEL IN TRENCH.

NOTE: NO DRY WELL SHALL EXCEED 15 FOOT IN DIAMETER. NO ABSORPTION TRENCH TO EXCEED 100 FEET IN LENGTH.

NOTE: ALL PIPE FROM HOUSE TO SEPTIC TANK MUST BE CAST IRON OR SCHEDULE 40 PVC OR ABS.

PERMIT VOID AFTER THREE YEARS.


NOTE: INSTALL STAND PIPE ON SEPTIC TANK AND DRY WELL. STAND PIPES MUST BE 6 INCHES IN DIAMETER. CAST IRON, CONCRETE OR TERRA COTTA, OR PVC OR ABS ACCEPTED. IF TOP OF SEPTIC TANK IS DEEPER THAN 3 FEET MANHOLE TO GRADE REQUIRED.

**\*INSTALLER IS RESPONSIBLE FOR OBTAINING FINAL APPROVAL ON THIS PERMIT**

\*CALL 992-2330 FOR INSPECTION OF SEPTIC SYSTEMS.

EH - 2-1082

P 33765

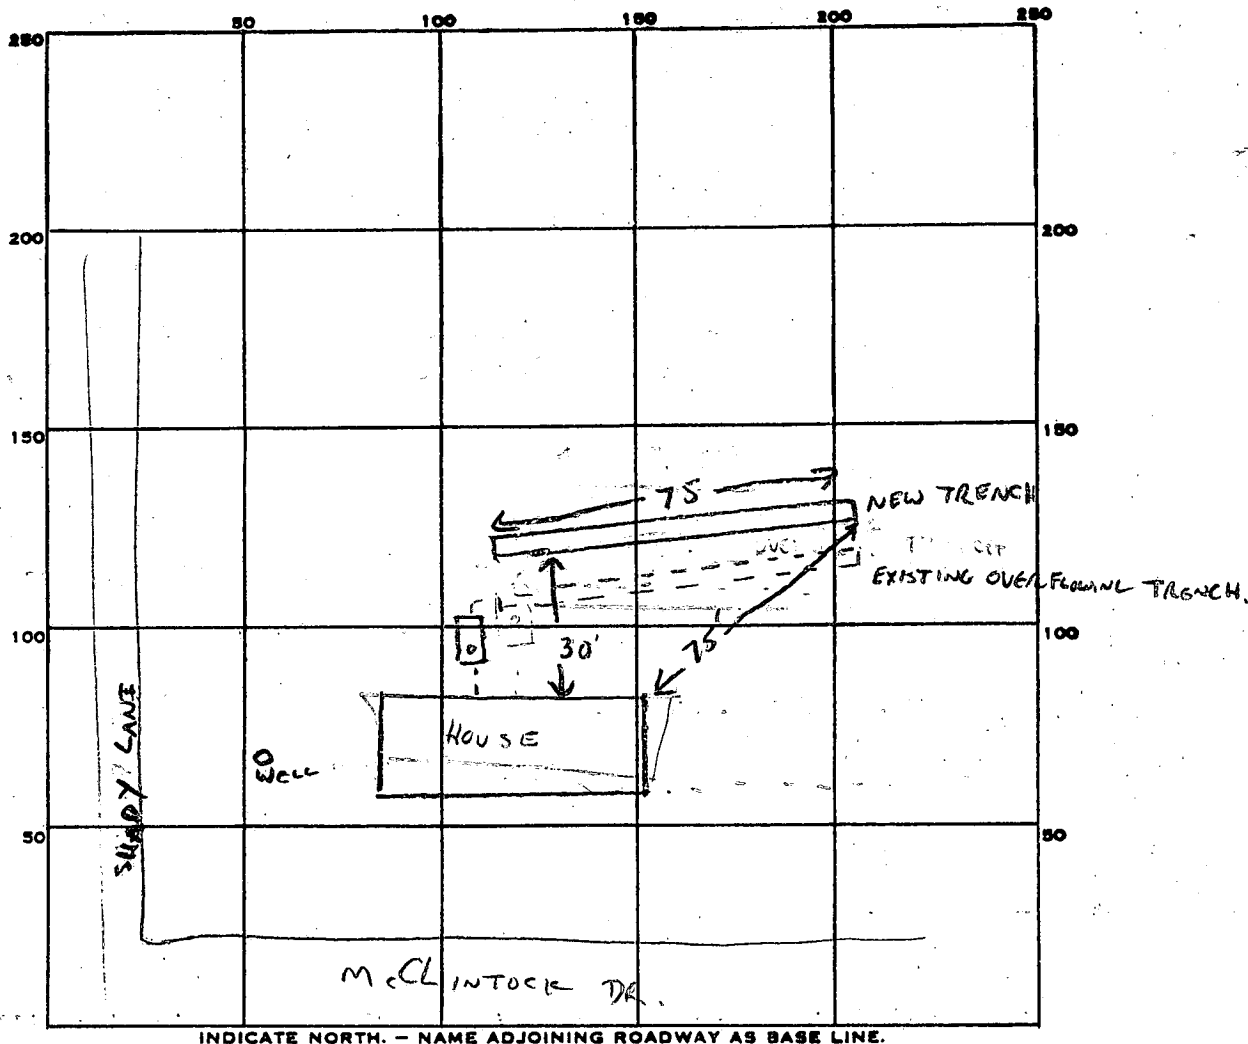

PERMIT CARD

SEPTIC TANK, LEVEL EXISTING

CLEANOUTS ST  EXISTING

DISTRIBUTION BOX, LEVEL N/A

TILE FIELD, DEPTH 9 1/2 FT. TRENCH WIDTH 2 FT.

GRAVEL DEPTH \_\_\_\_\_ IN. TOTAL LENGTH 75 FT.

NUMBER OF TRENCHES 1 TOTAL BOTTOM AREA \_\_\_\_\_

SEEPAGE PITS, INSIDE DIAMETER \_\_\_\_\_ FT. DEPTH BELOW INLET \_\_\_\_\_ FT.

ABSORBENT AREA \_\_\_\_\_ SQ. FT.

REMARKS TRENCH OK TO ADD GRAVEL 5/18/84 CW

SYSTEM COMPLETE. OK TO COVER 5/18/84 CW

DATE SYSTEM APPROVED 5/18/84

INSPECTOR Curtis