

7/17/84

9:30 A.M. 7/30/84 - P.M. please

APPROVED
7/31/84
P 33899 RJ

PERMIT

SEWAGE DISPOSAL SYSTEM

MARYLAND STATE DEPARTMENT OF HEALTH

A REPAIR

HOWARD COUNTY
BUREAU OF ENVIRONMENTAL HEALTH
992-2330

INDEX

ELLCOTT CITY

DISTRICT _____

DATE 5/17/84

01-178407

William F. Hausmann, Inc.

IS PERMITTED TO INSTALL ALTER _____

ADDRESS 1730 Bayside Beach Road, Pasadena, Md. 21122 PHONE 255-5259

SUBDIVISION _____ ROAD 5079 Landing Road LOT 7 1/2-722

PROPERTY OWNER Mrs. Margaret Rush Phone: 747-1796

ADDRESS 5079 Landing Road
Elkridge, Maryland 21227

IF GARBAGE GRINDER IS USED INCREASE SEPTIC TANK CAPACITY BY 50% AND ABSORPTION AREA BY 22%.

GARBAGE GRINDER? YES _____ NO

SEPTIC TANK CAPACITY 1000 GALLONS NUMBER OF BEDROOMS 3

REPAIR - CALL FOR INSPECTION WHEN GROUND IS OPENED UP SO SANITARIAN CAN RECOMMEND REPAIR.

Replace septic tank if needed + pipe to house.
60ft trench, 10ft deep, inlet around 3ft
with 7ft of stone. Run trench on level ground.

PLANS APPROVED BY Frank Skinner

DATE 5/17/84

COVER NO WORK UNTIL INSPECTED AND APPROVED.

NEITHER THE HOWARD COUNTY COUNCIL NOR THE HEALTH DEPARTMENT IS RESPONSIBLE FOR THE SUCCESSFUL OPERATION OF ANY SYSTEM.

NOTE: IF TRENCH IS USED CALL FOR INSPECTION BEFORE AND AFTER PLACING GRAVEL IN TRENCH.

NOTE: NO DRY WELL SHALL EXCEED 15 FOOT IN DIAMETER. NO ABSORPTION TRENCH TO EXCEED 100 FEET IN LENGTH.

NOTE: ALL PIPE FROM HOUSE TO SEPTIC TANK MUST BE CAST IRON OR SCHEDULE 40 PVC OR ABS.

PERMIT VOID AFTER THREE YEARS.


NOTE: INSTALL STAND PIPE ON SEPTIC TANK AND DRY WELL. STAND PIPES MUST BE 6 INCHES IN DIAMETER. CAST IRON, CONCRETE OR TERRA COTTA, OR PVC OR ABS ACCEPTED. IF TOP OF SEPTIC TANK IS DEEPER THAN 3 FEET MANHOLE TO GRADE REQUIRED.

*INSTALLER IS RESPONSIBLE FOR OBTAINING FINAL APPROVAL ON THIS PERMIT

*CALL 992-2330 FOR INSPECTION OF SEPTIC SYSTEMS.

EH - 2-1082

P 33899

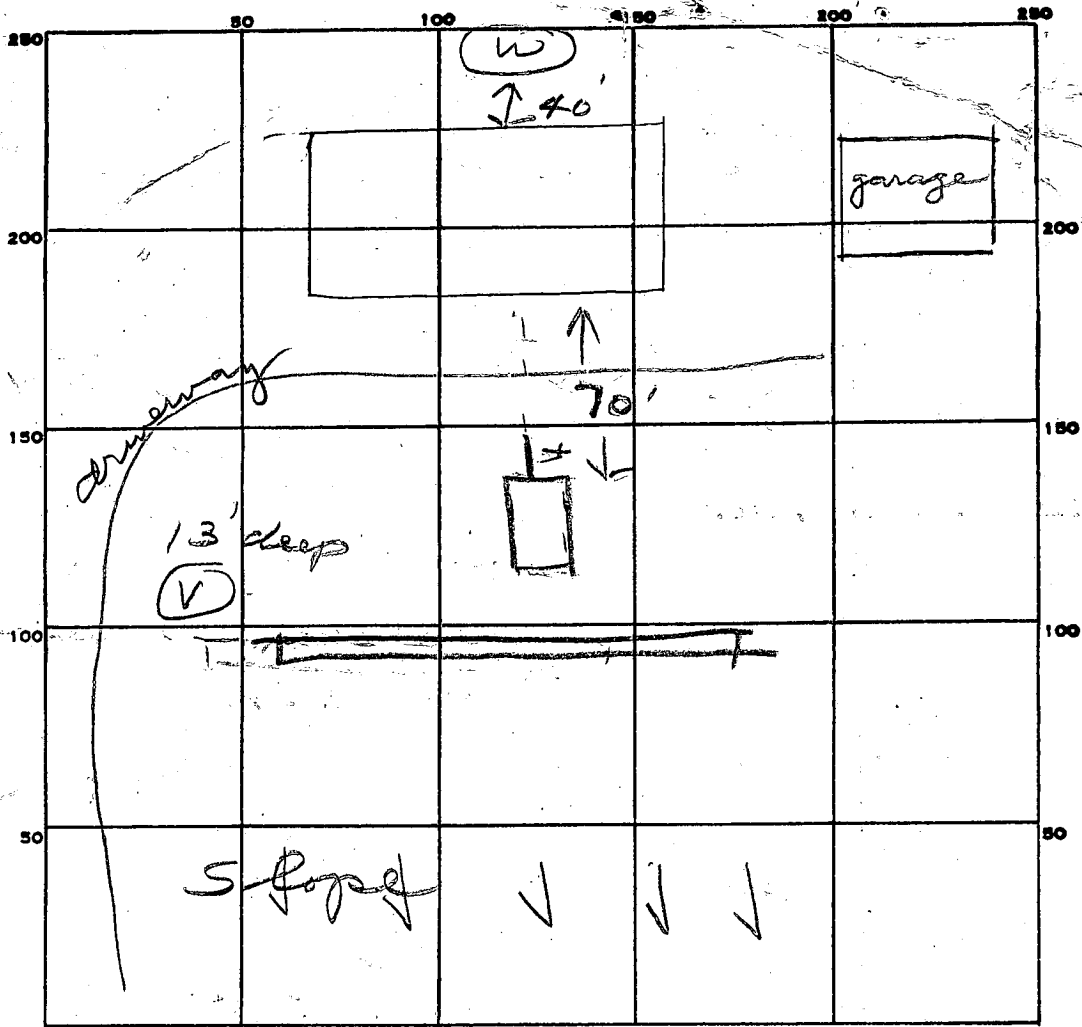

INDICATE NORTH. - NAME ADJOINING ROADWAY AS BASE LINE.

Landing Rd,

1000
3.25
6.75

PERMIT CARD _____

SEPTIC TANK, LEVEL OK 1000

CLEANOUTS ST OK

DISTRIBUTION BOX, LEVEL _____

TILE FIELD, DEPTH 10 FT. TRENCH WIDTH 2 FT.

GRAVEL DEPTH 6.75 IN. TOTAL LENGTH 61 FT.

NUMBER OF TRENCHES 1 TOTAL BOTTOM AREA 417

SEEPAGE PITS, INSIDE DIAMETER _____ FT. DEPTH BELOW INLET _____ FT.

ABSORBENT AREA _____ SQ. FT.

REMARKS 7/17/84 Visual 13' - 2' clay, all mixed clay sand

lyam. Did not perc. 18

7/30/84 ADD STONE & PIPE TO DITCH & CALL OK TO COVER TANK RH

7/31/84 STONE ADDED

DATE SYSTEM APPROVED

7/31/84

INSPECTOR

B. Hodge