

9/20/82
9/21/82
as soon as possible

Approved 9/21/82
Stayer P 32175
A REPAIR

PERMIT

SEWAGE DISPOSAL SYSTEM

MARYLAND STATE DEPARTMENT OF HEALTH

HOWARD COUNTY

05-342279

ELLICOTT CITY

DISTRICT _____

INDEX

DATE ~~Sept. 16, 1982~~

Jack Fyock, Jr. IS PERMITTED TO INSTALL ALTER

ADDRESS 13775 Triadelphia Rd., Glenelg, Md. 21737 PHONE 988-0270

SUBDIVISION BRAEBURN ROAD 6421 Lochridge Lochridge Road LOT _____

PROPERTY OWNER Mr. Crawley

ADDRESS 6421 Lockridge, Col., Md. ²¹⁰⁴⁴ (531-6485)

SPECIFICATIONS

SEPTIC TANK CAPACITY _____ GALLONS

DRAIN FIELD _____ DEPTH _____ FEET, BOTTOM AREA _____ SQ. FT.

DEEP TRENCH _____ DEPTH _____ FEET, BOTTOM AREA _____ SQ. FT.

SEEPAGE PITS _____ ABSORBENT SIDE-WALL AREA _____ SQ. FT.

INLET PIPE _____ FT. BELOW ORIGINAL GRADE, MAXIMUM DEPTH _____ FT. BELOW ORIGINAL GRADE

EFFECTIVE DEPTH AT _____ FT. BELOW ORIGINAL GRADE.

LOCATE DISPOSAL AREA _____ FT. FROM _____ LOT LINE AND _____ FT. FROM _____ LOT LINE AS SEEN WHEN FACING LOT FROM

REPAIR CALL FOR INSPECTION WHEN GROUND IS OPENED UP SO SANITARIAN CAN RECOMMEND REPAIR.

Dug 15 ft hole - clay down to 5 ft, then sandy loam.
Recommends at least 60 ft long trenches, 12 1/2' to 13 ft deep with 6 1/2 ft of stone. Also manhole cleanouts replaced.

PLANS APPROVED BY Palmer F. Wino DATE September 16, 1982

COVER NO WORK UNTIL INSPECTED AND APPROVED.

NEITHER THE HOWARD COUNTY COUNCIL NOR THE HEALTH DEPARTMENT IS RESPONSIBLE FOR THE SUCCESSFUL OPERATION OF ANY SYSTEM.

NOTE: IF TRENCH IS USED CALL FOR INSPECTION BEFORE PLACING GRAVEL IN TRENCH.

NOTE: NO DRY WELL SHALL EXCEED 15 FOOT IN DIAMETER.


NOTE: ALL PIPE FROM HOUSE TO DISPOSAL AREA MUST BE CAST IRON.

PERMIT VOID AFTER THREE YEARS.

NOTE: INSTALL STAND PIPE ON SEPTIC TANK AND DRY WELL. STAND PIPES MUST BE 6 INCHES IN DIAMETER. CAST IRON, CONCRETE OR TERRA COTTA ACCEPTED.

*INSTALLER IS RESPONSIBLE FOR OBTAINING FINAL APPROVAL ON THIS PERMIT.

* 32175

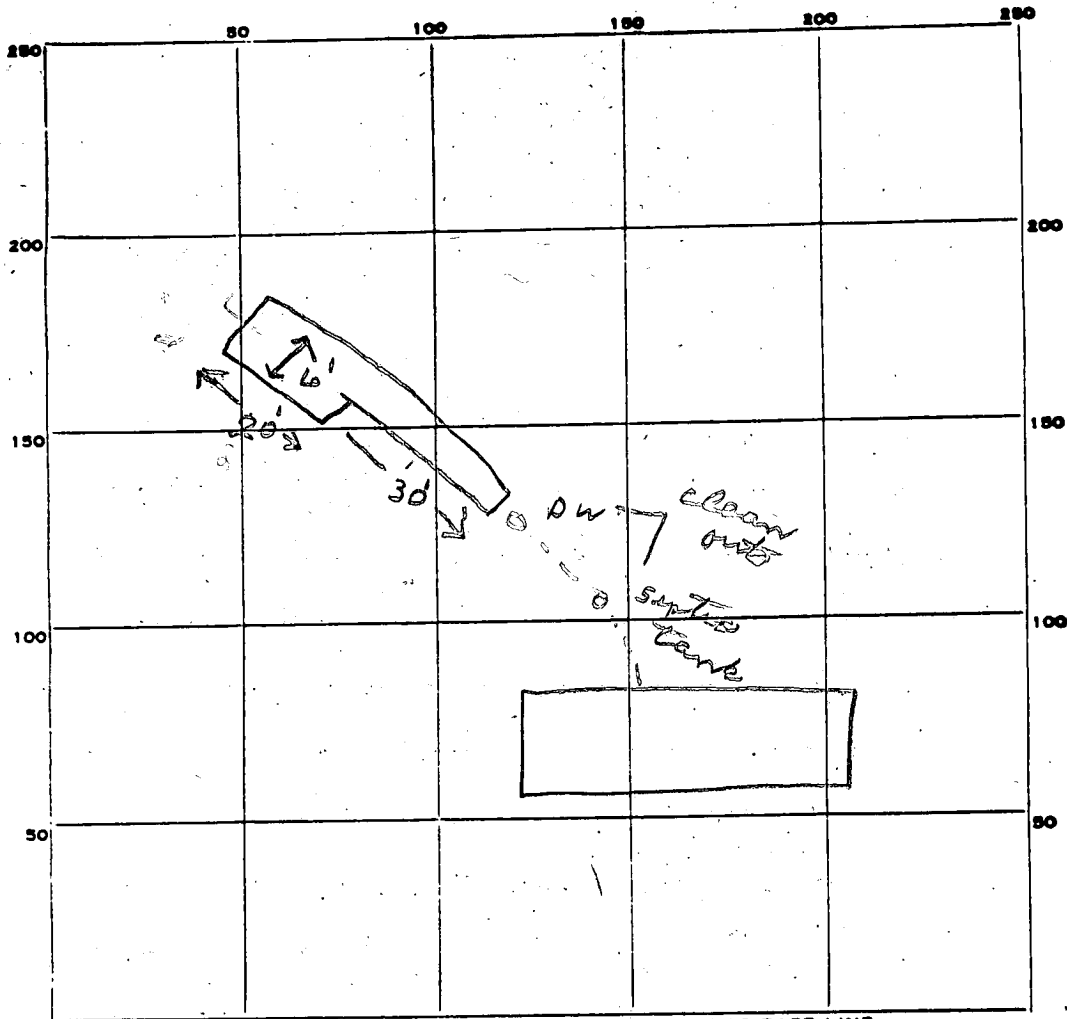

INDICATE NORTH. - NAME ADJOINING ROADWAY AS BASE LINE.

Loebridge Rd

PERMIT CARD _____

SEPTIC TANK, LEVEL _____

CLEANOUTS _____

DISTRIBUTION BOX, LEVEL _____

TILE FIELD, DEPTH 12 1/2 FT. TRENCH WIDTH 2 FT.

GRAVEL DEPTH 6 1/2 IN. TOTAL LENGTH 60' FT.

$$\begin{array}{r} 65 \\ \times 60 \\ \hline 3900 \end{array}$$

NUMBER OF TRENCHES 1 TOTAL BOTTOM AREA 390+

SEEPAGE PITS, INSIDE DIAMETER _____ FT. DEPTH BELOW INLET _____ FT.

ABSORBENT AREA 390+ SQ. FT.

REMARKS 9/21/82 OK to add stone in trench. fl
9/21/82 Trench side collapsed - siding to left side
OK to cover all work

DATE SYSTEM APPROVED 9/21/82 INSPECTOR Stayer