

PERMIT

SEWAGE DISPOSAL SYSTEM

DEPARTMENT OF HEALTH AND MENTAL HYGIENE

P 47708

A 31901

DISTRICT 5th

DATE 4/3/92

DATE SYSTEM APPROVED 12/13/91

INSPECTOR RH

HOWARD COUNTY HEALTH DEPARTMENT
BUREAU OF ENVIRONMENTAL HEALTH
461-9933

INDEXED

05-393573

Jack Fyock IS PERMITTED TO INSTALL ALTER

ADDRESS _____ PHONE 988-9270

SUBDIVISION Jocelyn Acres LOT 2 ROAD 6656 Luster Drive

PROPERTY OWNER Wayne Greenfield

ADDRESS _____

SEPTIC TANK CAPACITY 1250 GALLONS

NUMBER OF BEDROOMS 4

CHECK # OF BEDROOMS 4

200 SQUARE FEET PER BEDROOM

LINEAR FEET OF TRENCH REQUIRED 200

CAN GO 9 FT DEEP WITH 5 FT STONE - IF NECESSARY

TRENCHES - Trench to be 2 feet wide. Inlet 4 feet below original grade. Bottom maximum depth 8 feet below original grade. Effective area begins at 4 feet below original grade. 4 feet of stone below distribution pipe. 5

LOCATION - Place the distribution box 80 feet from the left rear (fenced) lot line and 15 feet from the right rear (304') lot line. Run trenches along contour toward left rear lot line.

NOTE - No trench to exceed 100 feet in length. Provide 6" - 8" diameter cleanout and cap to grade or above on septic tank.. OK/cw REVISED RH 9/19/91

DISCUSSED WITH JF AT SITE. RW

PLANS APPROVED BY C. Williams jr DATE REVISD 4/10/91

COVER NO WORK UNTIL INSPECTED AND APPROVED

NEITHER THE HOWARD COUNTY COUNCIL NOR THE HEALTH DEPARTMENT IS RESPONSIBLE FOR THE SUCCESSFUL OPERATION OF ANY SYSTEM

NOTE: CLEANOUT REQUIRED EVERY 70 FEET OF SEWER LINE AND/OR AT 90° SWEEPS IN LINES FROM HOUSE TO DRAIN FIELDS, 90° ELBOWS NOT ACCEPTABLE.

NOTE: ALL PARTS OF SEPTIC SYSTEMS (I.E. TANK, DISTRIBUTION BOX TRENCHES) TO BE 100 FEET FROM WELL (UNLESS OTHERWISE SPECIFICALLY AUTHORIZED)

NOTE: IF DEEP TRENCH(ES) ARE USED CALL FOR INSPECTION BEFORE AND AFTER PLACING GRAVEL IN TRENCH(ES)

NOTE: NO DRY WELL SHALL EXCEED 15 FOOT IN DIAMETER NO ABSORPTION TRENCH TO EXCEED 100 FEET IN LENGTH

NOTE: ALL PIPE FROM HOUSE TO SEPTIC TANK MUST BE CAST IRON OR SCHEDULE 35/40 PVC OR ABS

BLDG. PERMIT SIGNED

AND RETURNED 4/18/92

Serial # 53538 - prod

PERMIT VOID AFTER TWO YEARS


NOTE: INSTALL STAND PIPE ON SEPTIC TANK AND DRY WELL STAND PIPES MUST BE 6 INCHES IN DIAMETER CAST IRON. CONCRETE OR TERRA COTTA OR PVA OR ABS ACCEPTED. IF TOP OF SEPTIC TANK IS DEEPER THAN 3 FEET. MANHOLE TO GRADE REQUIRED.

NOTE: DISTRIBUTION BOXES MUST HAVE BAFFLES

***INSTALLER IS RESPONSIBLE FOR OBTAINING FINAL APPROVAL ON THIS PERMIT**

A 31901

LAKE

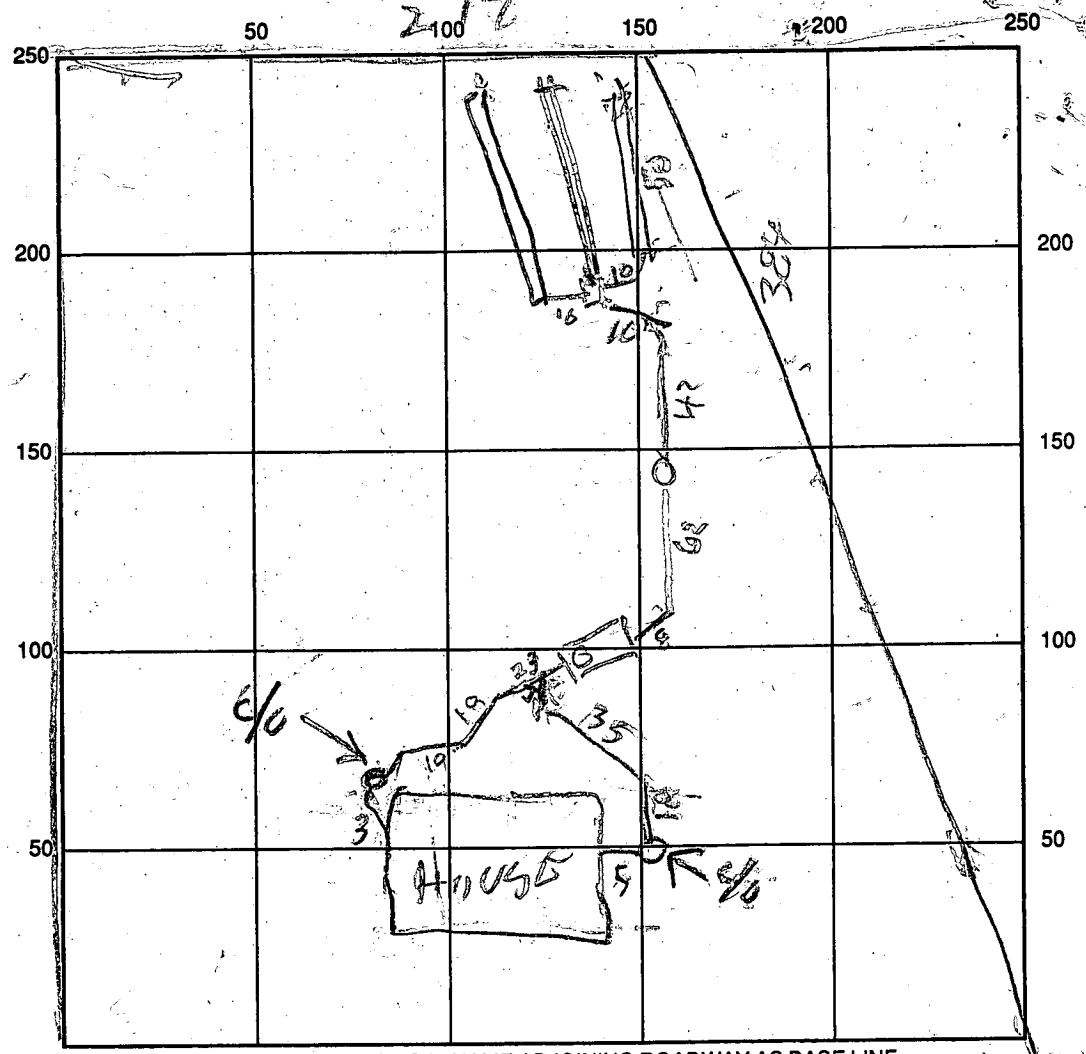

INDICATE NORTH - NAME ADJOINING ROADWAY AS BASE LINE

ST HOOPER SEWER

SEPTIC TANK LEVEL OK 1250 CLEANOUTS OK OK OK

DISTRIBUTION BOX LEVEL OK

DRAIN FIELD/TITLE DEPTH 9 FT. TRENCH WIDTH 2 FT. INLET DEPTH 4-4 FT.

EFFECTIVE GRAVEL DEPTH 5 FT. TOTAL LENGTH 50 | 41 | 3 | 47 138

NUMBER OF TRENCHES 3 ONE SIDEWALL/BOTTOM AREA 250 | 235 3 TOTAL SQ. FT.

DRYWALL INSIDE DIAMETER _____ FT. EFFECTIVE DEPTH BELOW INLET _____ FT.

ABSORBENT AREA _____ SQ. FT.

REMARKS: 9/19/91 MET WITH JF & DISCUSSED TRENCH LOCATION. IT LOOKS OK BUT JF
TO CHECK TO SEE WHERE SEWER LINES COME OUT OF HOUSE RE 10/4/91 10AM -
TRENCH #1 DUG. TANK SET 10/4/91 1PM - TRENCH #1 OK TRENCH
#2 DUG 35 FT RA 10/4/91 3PM - TRENCH #2 OK
TRENCH #3 ALMOST FINISHED. TANK OUT OF GROUND
MARK ENDS OF TRENCH #3 & COVER ALL TRENCHES
COVER 11/4/91 EVERYTHING COVERED 12/13/91 OK TO SIGN. RYOCK
 DATE SYSTEM APPROVED 12/13/91 INSPECTOR R. Hodge
JUST PROBABLY FINISHED TRENCH #3
WELL ON ENTIRELY DIFFERENT PART OF LOT

JOCELYN ACRES
SECTION IV

A 31901

SUBDIVISION:

LOT NUMBER: 2

DRY WELL OR DRY WELL AND TRENCH

_____ sq. ft./bedroom

	<u>Septic Tank</u>	<u>Minimum Total Square Feet</u>
3 bedroom	1000 gallon	_____
4 bedroom	1250 gallon	_____
5 bedroom	1500 gallon	_____

Inlet _____ feet below original grade.

Bottom maximum depth _____ feet below original grade.

Effective area begins at _____ feet below original grade.

NOTE: If trench is used to make up absorbent area, run the trench on level ground and leave a 5-foot earth buffer between dry well and trench. No trench is to exceed 100 feet in length. Trench inlet to be same as dry well, with _____ feet of stone below distribution pipe.

TRENCHES

200 sq. ft./bedroom

Trench to be 2 wide.

Inlet 4 feet below original grade.

Bottom maximum depth 8 9 feet below original grade.

Effective area begins at 4 feet below original grade.

4 feet of stone below distribution pipe.

40 LINER 20' / 1' WITH 5 FT STONE








- NOTE:
- (1) No trench to exceed 100 feet in length.
 - (2) If more than one trench used, a distribution box is required.
 - (3) Trenches to be installed on level ground.
 - (4) Call for inspection of trench before gravel is installed.
 - (5) Provide 6" - 8" diameter cleanout and cap to grade or above on septic tank and drywell.
 - (6) If a garbage disposal is used, increase septic tank capacity by 50% and increase absorbent sidewall area by 22%.

LOCATION: PLACE THE DISTRIBUTION BOX
80' FROM THE LEFT REAR (FENCED) LOT LINE AND 25' FROM
THE RIGHT REAR (384') LOT LINE, RUN TRENCHES ALONG CONTOUR
TOWARD LEFT REAR LOT LINE.

REVISED 4/10/91 CW/RH
REVISED 10/1/91 RH

A 31901
RETEST

Jocelyn Owen Lot 2 Set 4
Retest of 4/19/91
QUARRY LAKE

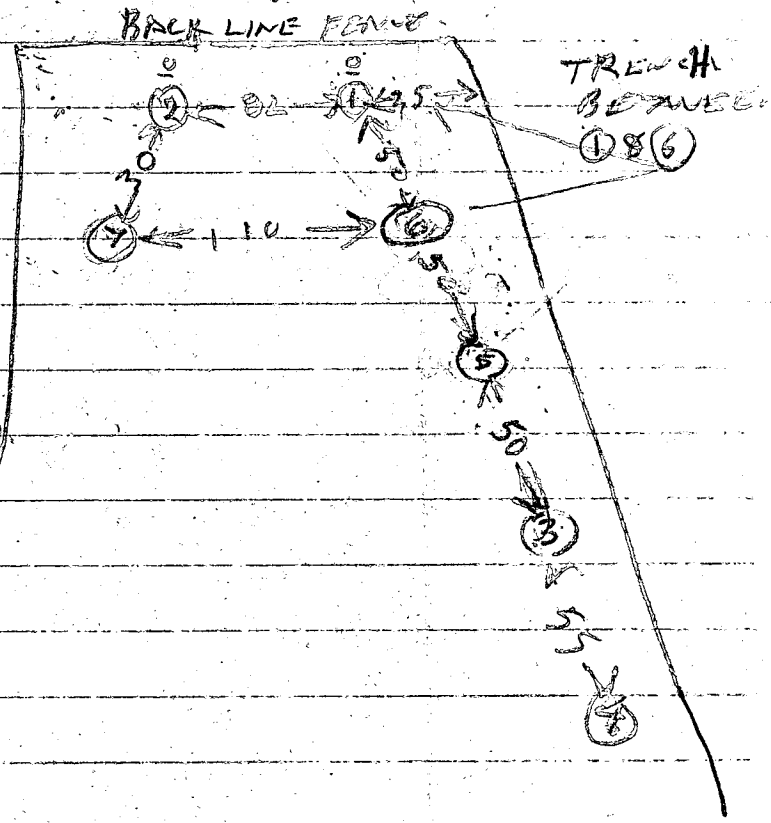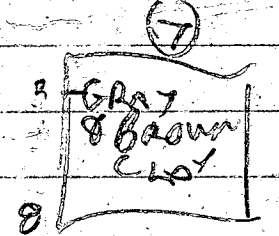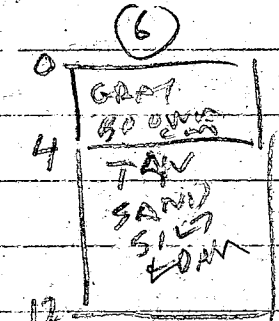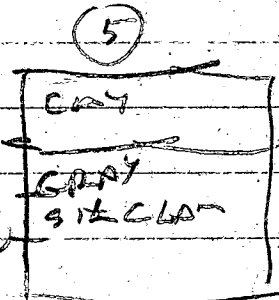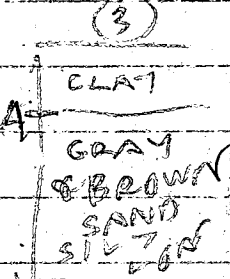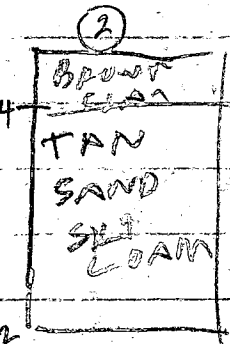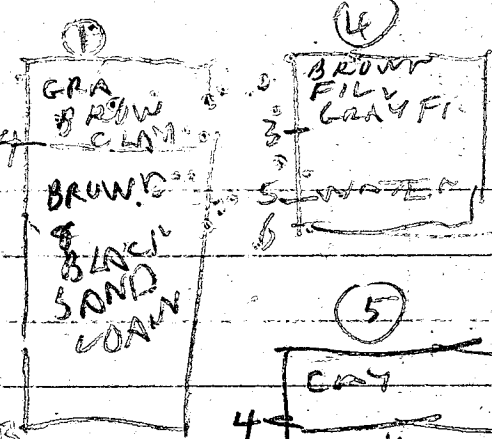

4/9/91	13A	3 1/2	123	125	125	132
	1V	13	OK			
	2S	4	140	148	146	153
	2V	12	OK			7
	3S	4	215	250	little per	
	3V	11 1/2	clayish sand			
	4V	9	FAIL CLAY WATER COMES IN TOP FROM SATURATED SOIL			
	5S	3 1/4	250	250	little per	
	5V	11 1/2	CLAYISH			
	6V	12	OK			
	7V	8	CLAYISH			

Test by BH & DB

ALSO PRESENT

GREENFIELD OWNER
KENNY BRICK
OF FLOCK

APPLICATION

SEWAGE DISPOSAL TESTING

STATE OF MARYLAND - DEPARTMENT OF HEALTH AND MENTAL HYGIENE

A 31901

P _____

HOWARD COUNTY HEALTH DEPARTMENT
ENVIRONMENTAL HEALTH SERVICES

P. O. BOX 473 ELLICOTT CITY, MARYLAND 21043
TELEPHONE: 992-2330

DISTRICT FIRTH

DATE APRIL 27, 1982

TO: THE COUNTY HEALTH OFFICER
ELLICOTT CITY, MARYLAND

I, HEREBY, APPLY FOR THE NECESSARY TEST IN ORDER TO CONSTRUCT (OR RECONSTRUCT) A SEWAGE DISPOSAL SYSTEM.

PROPERTY OWNER HIGHLAND DEVELOPMENT CORPORATION Wayne Greenfield

ADDRESS 9966 Mo. Route 99 PHONE 465-0842 995-6753

PROPERTY LOCATION:

SUBDIVISION Jocelyn Acres Sec 3 SEC 4 LOT NO. 2

ROAD AND DESCRIPTION PIPE STEM FROM LUSTER DRIVE AT END OF CULDESAC
(6656 Luster Drive)

SIZE OF LOT 4.3Ac ± TYPE BLDG. SINGLE FAMILY
(NUMBER OF BEDROOMS)

THE SYSTEM INSTALLED UNDER THIS APPLICATION IS ACCEPTABLE ONLY UNTIL PUBLIC FACILITIES BECOME AVAILABLE. I FULLY UNDERSTAND THE FEE CONNECTED WITH THE FILING OF THIS PERC TEST APPLICATION IS NON-REFUNDABLE UNDER ANY CIRCUMSTANCES. I ALSO AGREE TO COMPLY WITH ALL M.O.S.H.A. REQUIREMENTS IN TESTING THIS LOT.

Charles J. Cross
(SIGNATURE OF APPLICANT)

APPROVED BY _____ FOR _____ DATE _____

REJECTED BY _____ FOR _____ DATE _____

HOLD PENDING FURTHER TESTS _____ DATE _____

REASONS FOR REJECTION OR HOLDING _____

BLDG. PERMIT SIGNED

AND RECEIVED 3/15/91

Serial # 36399-SFD.

4 Bedrooms




THIS IS NOT A PERMIT

PERC HOLE
 [] = TESTED

10/29/82

SEE EXTRA
 SHEET

MUST
 MAKE
 SCALE
 DRAWING
 AT OFFICE

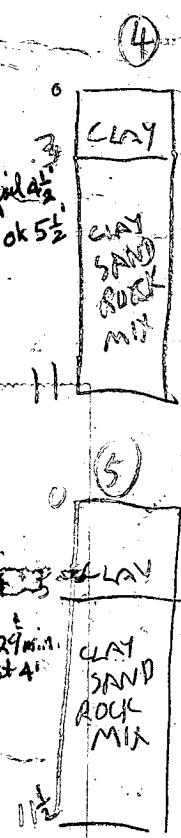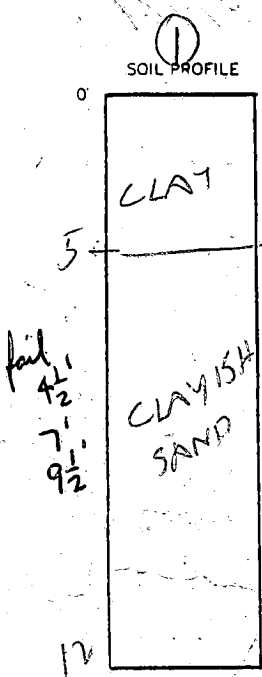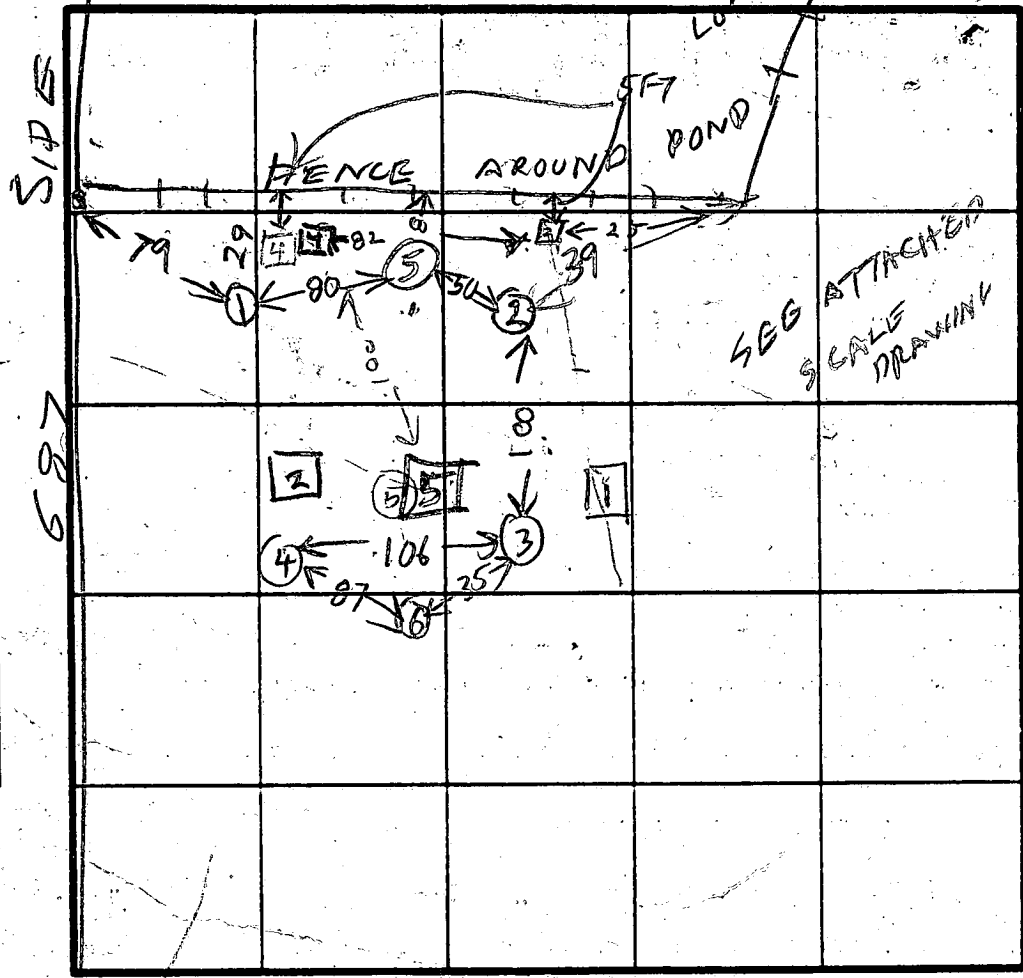


INDICATE NORTH - NAME ADJOINING ROADWAY AS BASE LINE.

DATE	TEST NO.	DEPTH	PRE-WET		TEST - 1' DROP		TIME	
			START	STOP	START	STOP		
10/18/82	1 S	4 1/2	1037	1037	little perc	FAIL	SLOW	
10/18/82	1 D	9 1/2	1110	1134	1134	1150	little perc	SLOW
	2 V	12	TOP	5 FT	CLAY			
	3 S	3	1032	1121	little perc	FAIL	SLOW	
	3 V	11	ALL	CLAY	CLAY			
	4 S	4 1/2	1043	1132	little perc	FAIL	SLOW	
	4 M	5 1/2	1145	1150	1150	1200	10	
	5 S	4	1102	1122	1122	1151	29	
	1 M	7	1110	1140	little perc		SLOW	
	6 S	12	SEE	SOIL	PROFILE			
	6 S	5	1120	1155	little perc		SLOW	
5/4/82	4 V	11	SEE	SOIL	PROFILE			

10/21/82 F-58 RH noted a water at 10 ft. Visual Hole
 100 ft from Berm & near stream on the lot
 TESTED BY B. HODGES ALSO PRESENT IVAN SLITZ

1079

KAPLAN
1087/097

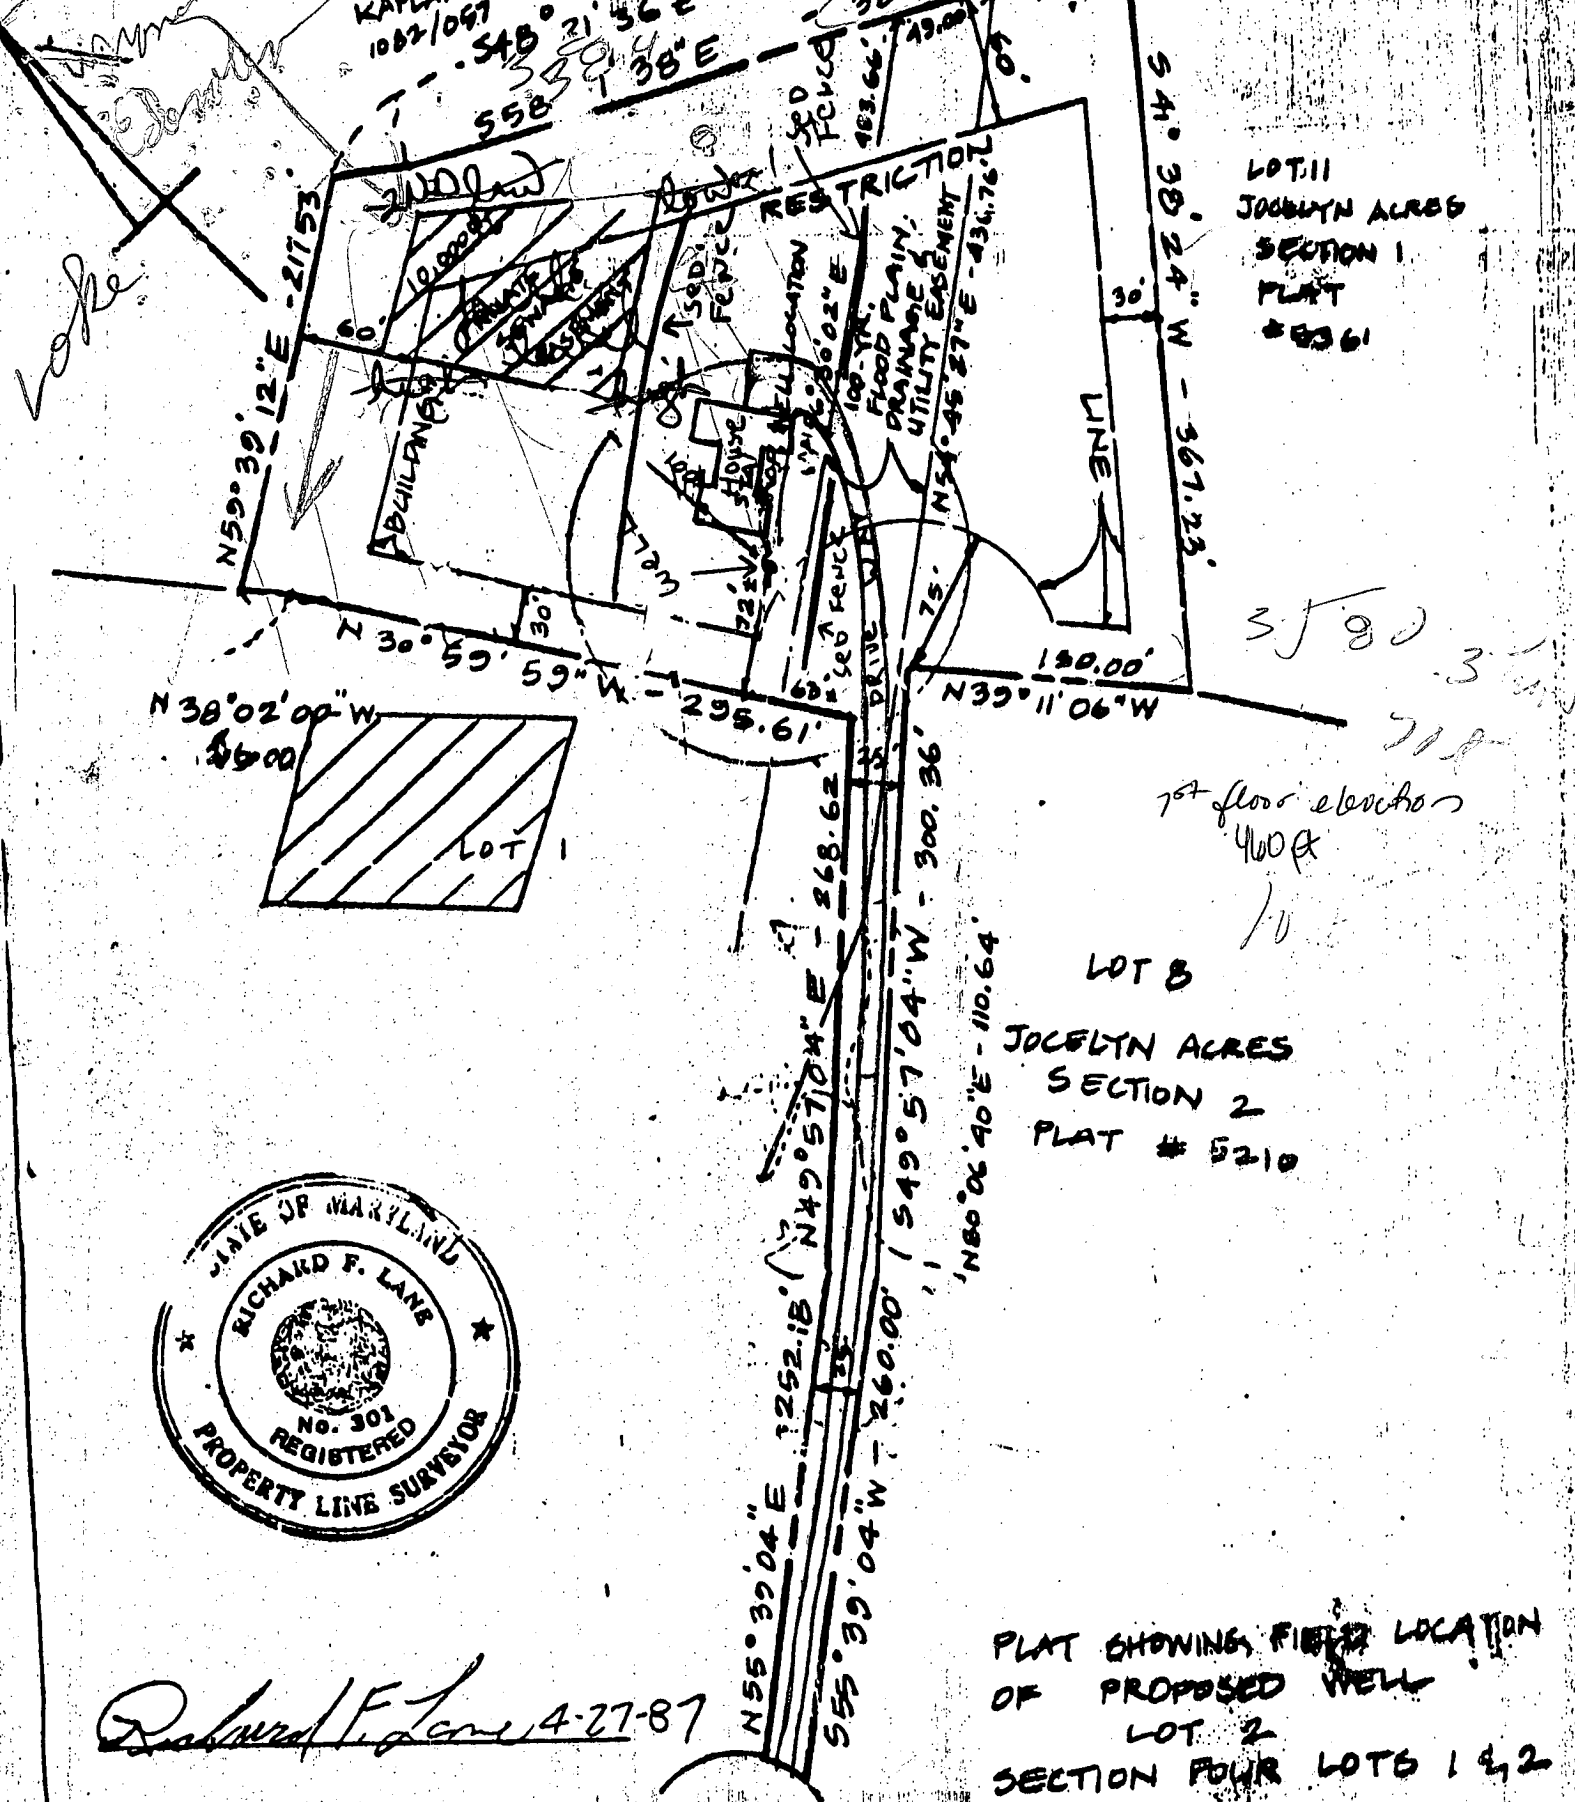

LOT 11
JOCELYN ACRES
SECTION 1
PLAT
#5561

3580
350
7th floor elevation
400 ft

LOT 3
JOCELYN ACRES
SECTION 2
PLAT # 5210




Richard F. Lane 4-27-87

PLAT SHOWING FIELD LOCATION
OF PROPOSED WELL
LOT 2
SECTION FOUR LOTS 1 & 2
JOCELYN ACRES
5TH ELEC. DIST. HOWARD CO. MD
SCALE 1" = 100' DATE 4/27 ' 7
PLAT # 5584

LUSTER
DRIVE
(50' RAW)
SHANABERGER & LANE
8726 TOWN & COUNTRY BLVD. STE. 203
ELLCOTT CITY, MD. 21043 461-2563

Lot 2 Sect 3 SECT 4
 SECTION 4
 astron plot of May 82
 Figures around JOCELYN ACRES

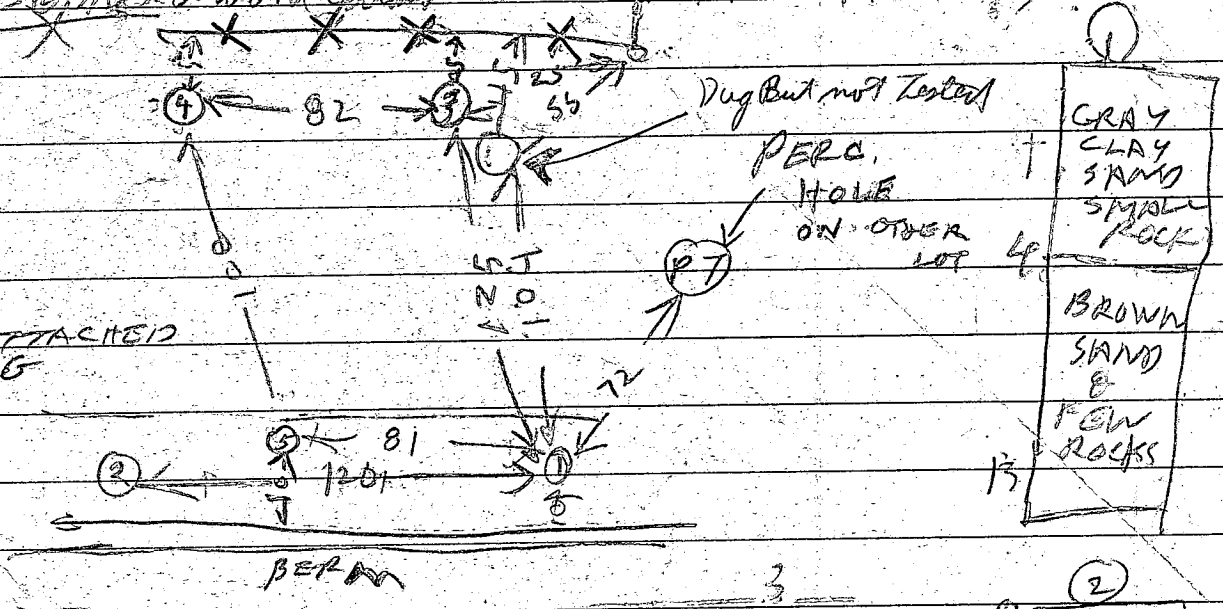

SEE ATTACHED SCALE DRAWING OF HOLES

OPHD observed pot hole digging

10/19/82	1D	9	1226	1229	1229	1236	7	
	1S	5	1236	1239	1239	148	9	
			LOOKS OK SEE SOIL PROFILE					
	2D	13	149	257	little perc FAIL			
	2S	4 1/2	203	229	229	302	little perc FAIL	
			LOOKS GOOD FULL					
10/18/82	2V	12	SEE SOIL PROFILE					
10/28/82	3D	8	1055	1st inch 45 sec.	2nd inch 125 sec.			OK
	3S	4 1/2	1056	1st inch 10 sec	2nd inch 30 sec			TOO FAST
			SEE SOIL PROFILE					
	3V	12	LOOKS OK					
	4D	8	1117	1119	1119	1122	3	OPHD
	4S	4 1/2	1120	1131	1131	1154	13	
			SEE SOIL PROFILE					
	4V	12	LOOKS OK					
	4M	5 1/2	1139	1141	1141	1144	3	
			OVER					

3

4

BROWN FILL
SMALL ROCKS

GRAY FILL

GRAY &
BROWN SAND

POSSIBLE FILL

BROWN
& GRAY
SAND
CLAY SILT
MIX

BLACK
SAND LINE

LIGHT
GRAY
SAND SILT
CLAY MIX

NATURAL
SOIL

WITH
SOME
BROWN
SOIL

BROWN
SAND
SILT
MIX

5

GRAY
SAND
SILT
SMALL
ROCKS

CLAY SAND
SILT MIX

BROWN &
GRAY SAND

10/28/02

5D

8

1221

1229

1229

1232

28

OPHJ

5S

4 1/2

1226

1235

1235

1248

13

OPHJ

5V

12

SEE

LOOK OK

SEE

PROFILL

A 31901

○ = OK


○ = BAD

○ = NOT ENOUGH INFORMATION TO DECIDE IF GOOD OR BAD

OCELANI ACERS SECTION 4

SCALE DRAWING OF HOLES 1" = 50'

FENCE AROUND QUARRY

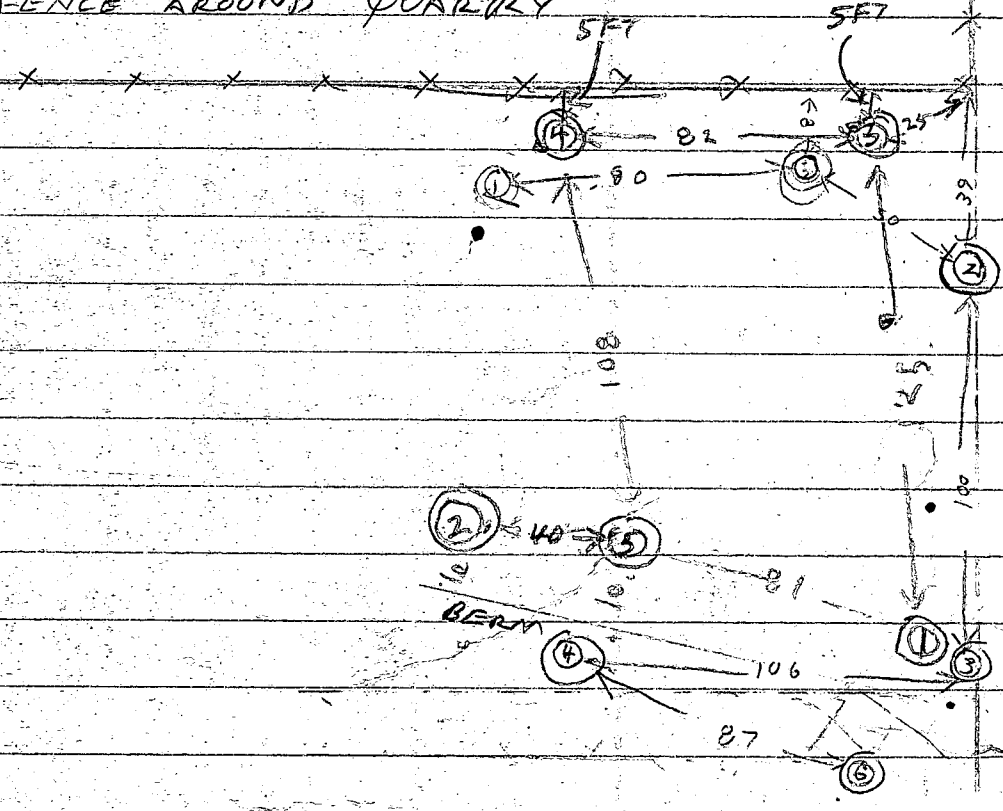

HOLES 3 4 6 DO NOT SCALE OFF PROPERLY IN RELATION TO BERM

GRAY ○ = HOLES DUG MAY 82

BLUE ○ = HOLES DUG OCT 84

† TEST OF 4/9/91

GRAY DOT ○ = GOOD HOLE

RED DOT ○ = BAD HOLE

NOTIFY HEALTH DEPT. AT TIME OF FOOTING INSPECTION
 HOWARD COUNTY

APPLICATION

PERMIT APPLICATION

SERIAL NUMBER
 36399

DEPARTMENT OF PUBLIC WORKS
 BUREAU OF INSPECTIONS LICENSES & PERMITS
 3430 COURT HOUSE DRIVE, ELLICOTT CITY, MARYLAND 21043

BUILDING ADDRESS (HOUSE NO., STREET, TOWN OR AREA)

6656 Luster Drive

20777

LOT NO.	PARCEL NO.	SEC.	AREA	BLOCK NO.	LIBER	FOLIO
2	3911	4		20		

SUB DIVISION	ZONE	ZONE MAP	ELEC. DIST.	CENSUS TR.
Jocelyn Acres	R-1	34	5"	651

OWNER'S NAME AND ADDRESS
 Wayne Greenfield
 21044

PHONE NO.
 995-6753

OCCUPANT'S NAME AND ADDRESS
 MA

PHONE NO.

ARCHITECT OR ENGINEER'S NAME AND ADDRESS
 Donald J. Thornton
 1200 Howard Parkway
 30338

PHONE NO.
 404-671-7100

CONTRACTOR'S NAME AND ADDRESS
 Greenfield Home Insul
 21044

PHONE NO.
 544-7557

EXISTING USE	PROPOSED USE
vacant land	Single Family Dwellings

EST. CONSTRUCTION COST	LICENSE NUMBER	PERMIT FEE
205,000		

I/V/S CODE

FOR OFFICE USE ONLY

INSTANCE IN FEET FROM R/W LINE TO FRONT BUILDING LINE _____

SIDE YARD _____
 (DISTANCE IN FEET FROM SIDE BLDG. LINE TO SIDE PROPERTY LINE)

DISTANCE IN FEET FROM SIDE STREET R/W LINE _____

TO SIDE BUILDING LINE _____

DISTANCE IN FEET, REAR YD. REQUIRING SET _____

BACK _____ (CORNER LOT ONLY)

CONDITIONS (IF ANY) _____

SDP # _____

Checks payable to DIRECTOR OF FINANCE OF HOWARD COUNTY

CAUTION

to begin construction before a permit placard has been issued and displayed on the job is a violation of the law. Use and occupancy permit must be applied for two weeks before it will be issued.

IMPORTANT: PLEASE SHOW ZIP CODES AND AREA CODES WHEREVER REQUIRED.

LP-69
 Revised

GRADING/SEDIMENT CONTROL YES NO

DESCRIPTION OF WORK AUTHORIZED
 Block level on the building foundation
 were stake roof attached

SIZE OF BLDG.	FRONT	DEPTH	HEIGHT
71' 8" x 34'			

TYPE OF BLDG.	AREA	VOLUME	ROOF
B. ROOMS 4 ROOMS BATHS 4 FIREPLACES			

FOOTINGS	FOUNDATION	S. WALLS

UTILITIES			
WATER/WELL	SEWER/SEPTIC	GAS	ELECTRICITY

I have carefully examined and read this application and know the same to be true and correct, and that in doing this work, all provisions of Howard County Ordinances and the State Laws of Maryland will be complied with, whether specified or not; and I will notify the Bureau of Inspections, and Permits twenty-four hours in advance when I am ready for the inspections called for elsewhere in this application; and that no work will be covered up until such inspections have been completed with.

Signature: Eric Greenfield
 Title: Contractor
 Date: 1-28

FUNCTION	DATE	SIGNATURE APPROVAL
ZONING/PLANNING		
SHA		
SEDIMENT/GRADING		
BUILDING OFFICIAL		
WATER & SEWER		
HEALTH DEPT.	3/15/91	R. Hodger
FIRE PROTECTION		
STORM WATER MGMT.		

APPROVED

Distribution of Copies:
 White - Building Official
 Green - Planning & Zoning

Yellow - Engineering
 Pink - Health Dept.
 Gold - S.H.A.


Luster Drive

JOCelyn ALRES
Lot 2

WAYNE GREENFIELD
6656 LUSTER DRIVE
CLARKSVILLE MD

PERMIT
36399

Hulmeconcrete
Locals
by DB

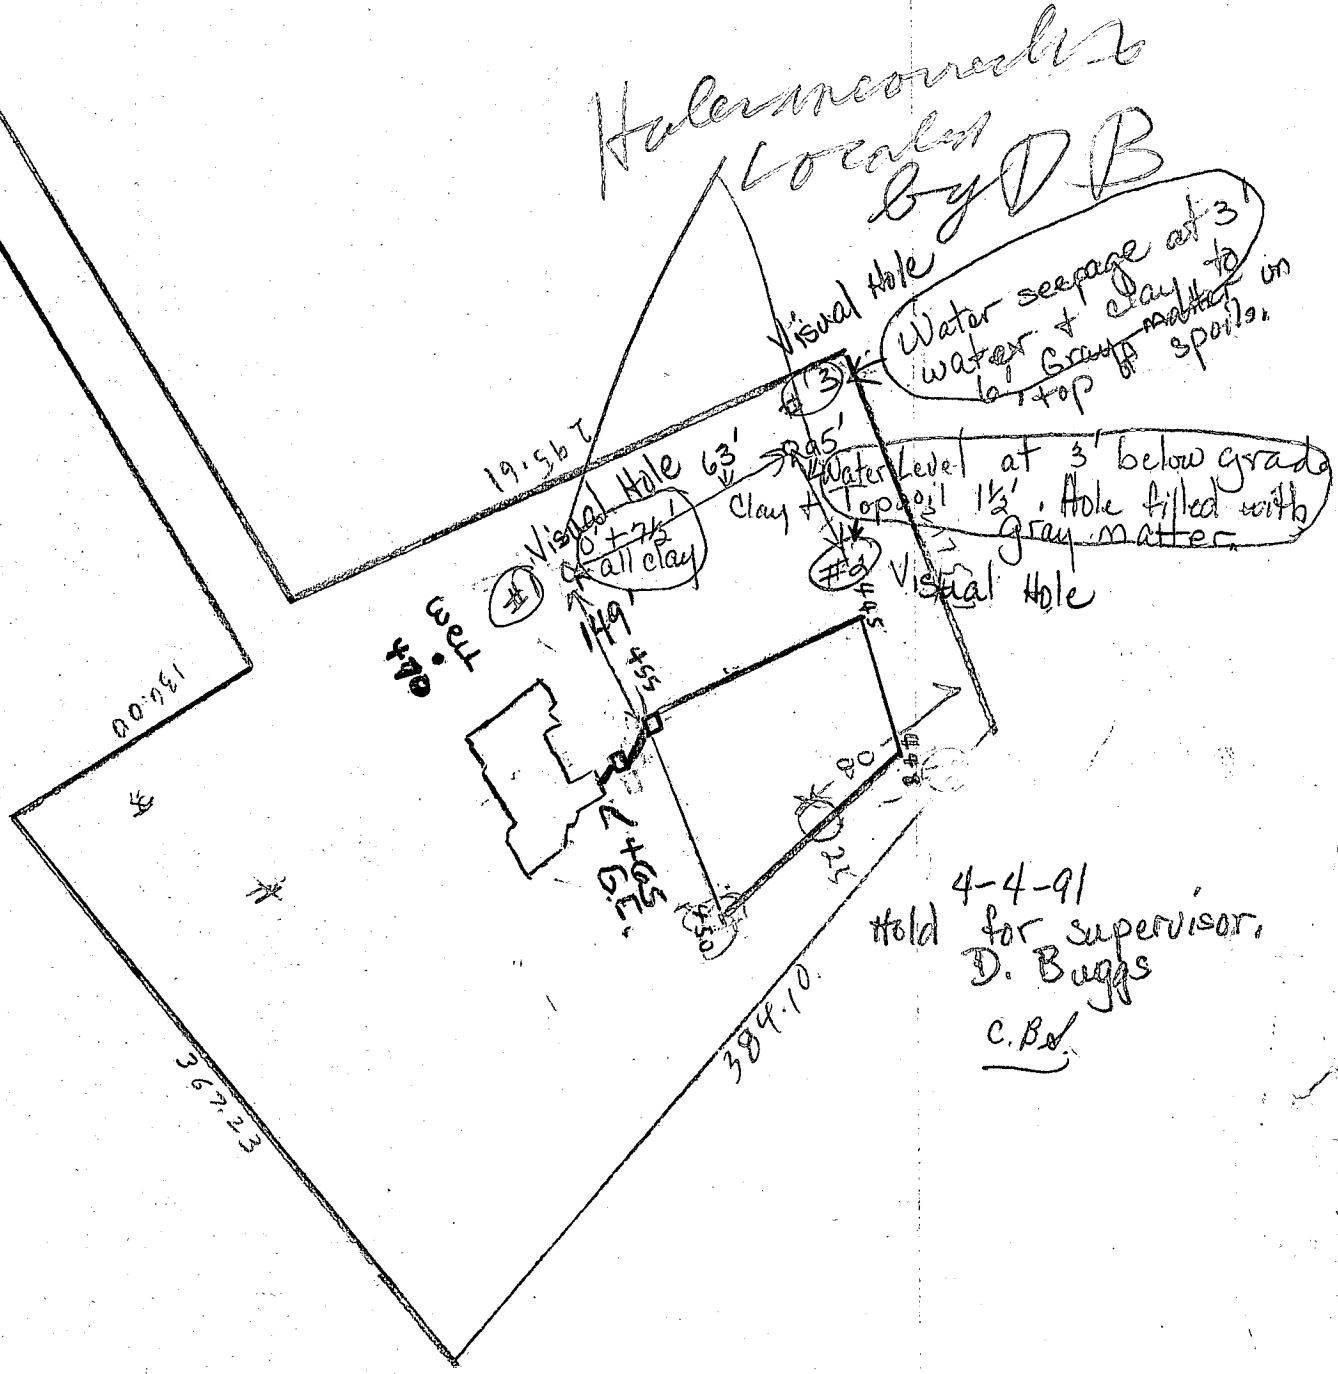


4-4-91
Hold for supervisor,
D. Buggs
C.B.A.

3/15/91
SPECIAL INSPECTION
OF SITE AT TIME
FOOTING INSPECTION
NEEDED

WAYNE GREENFIELD
7549 RED CRAWFET CT
COLUMBIA MD 21046

1" = 100

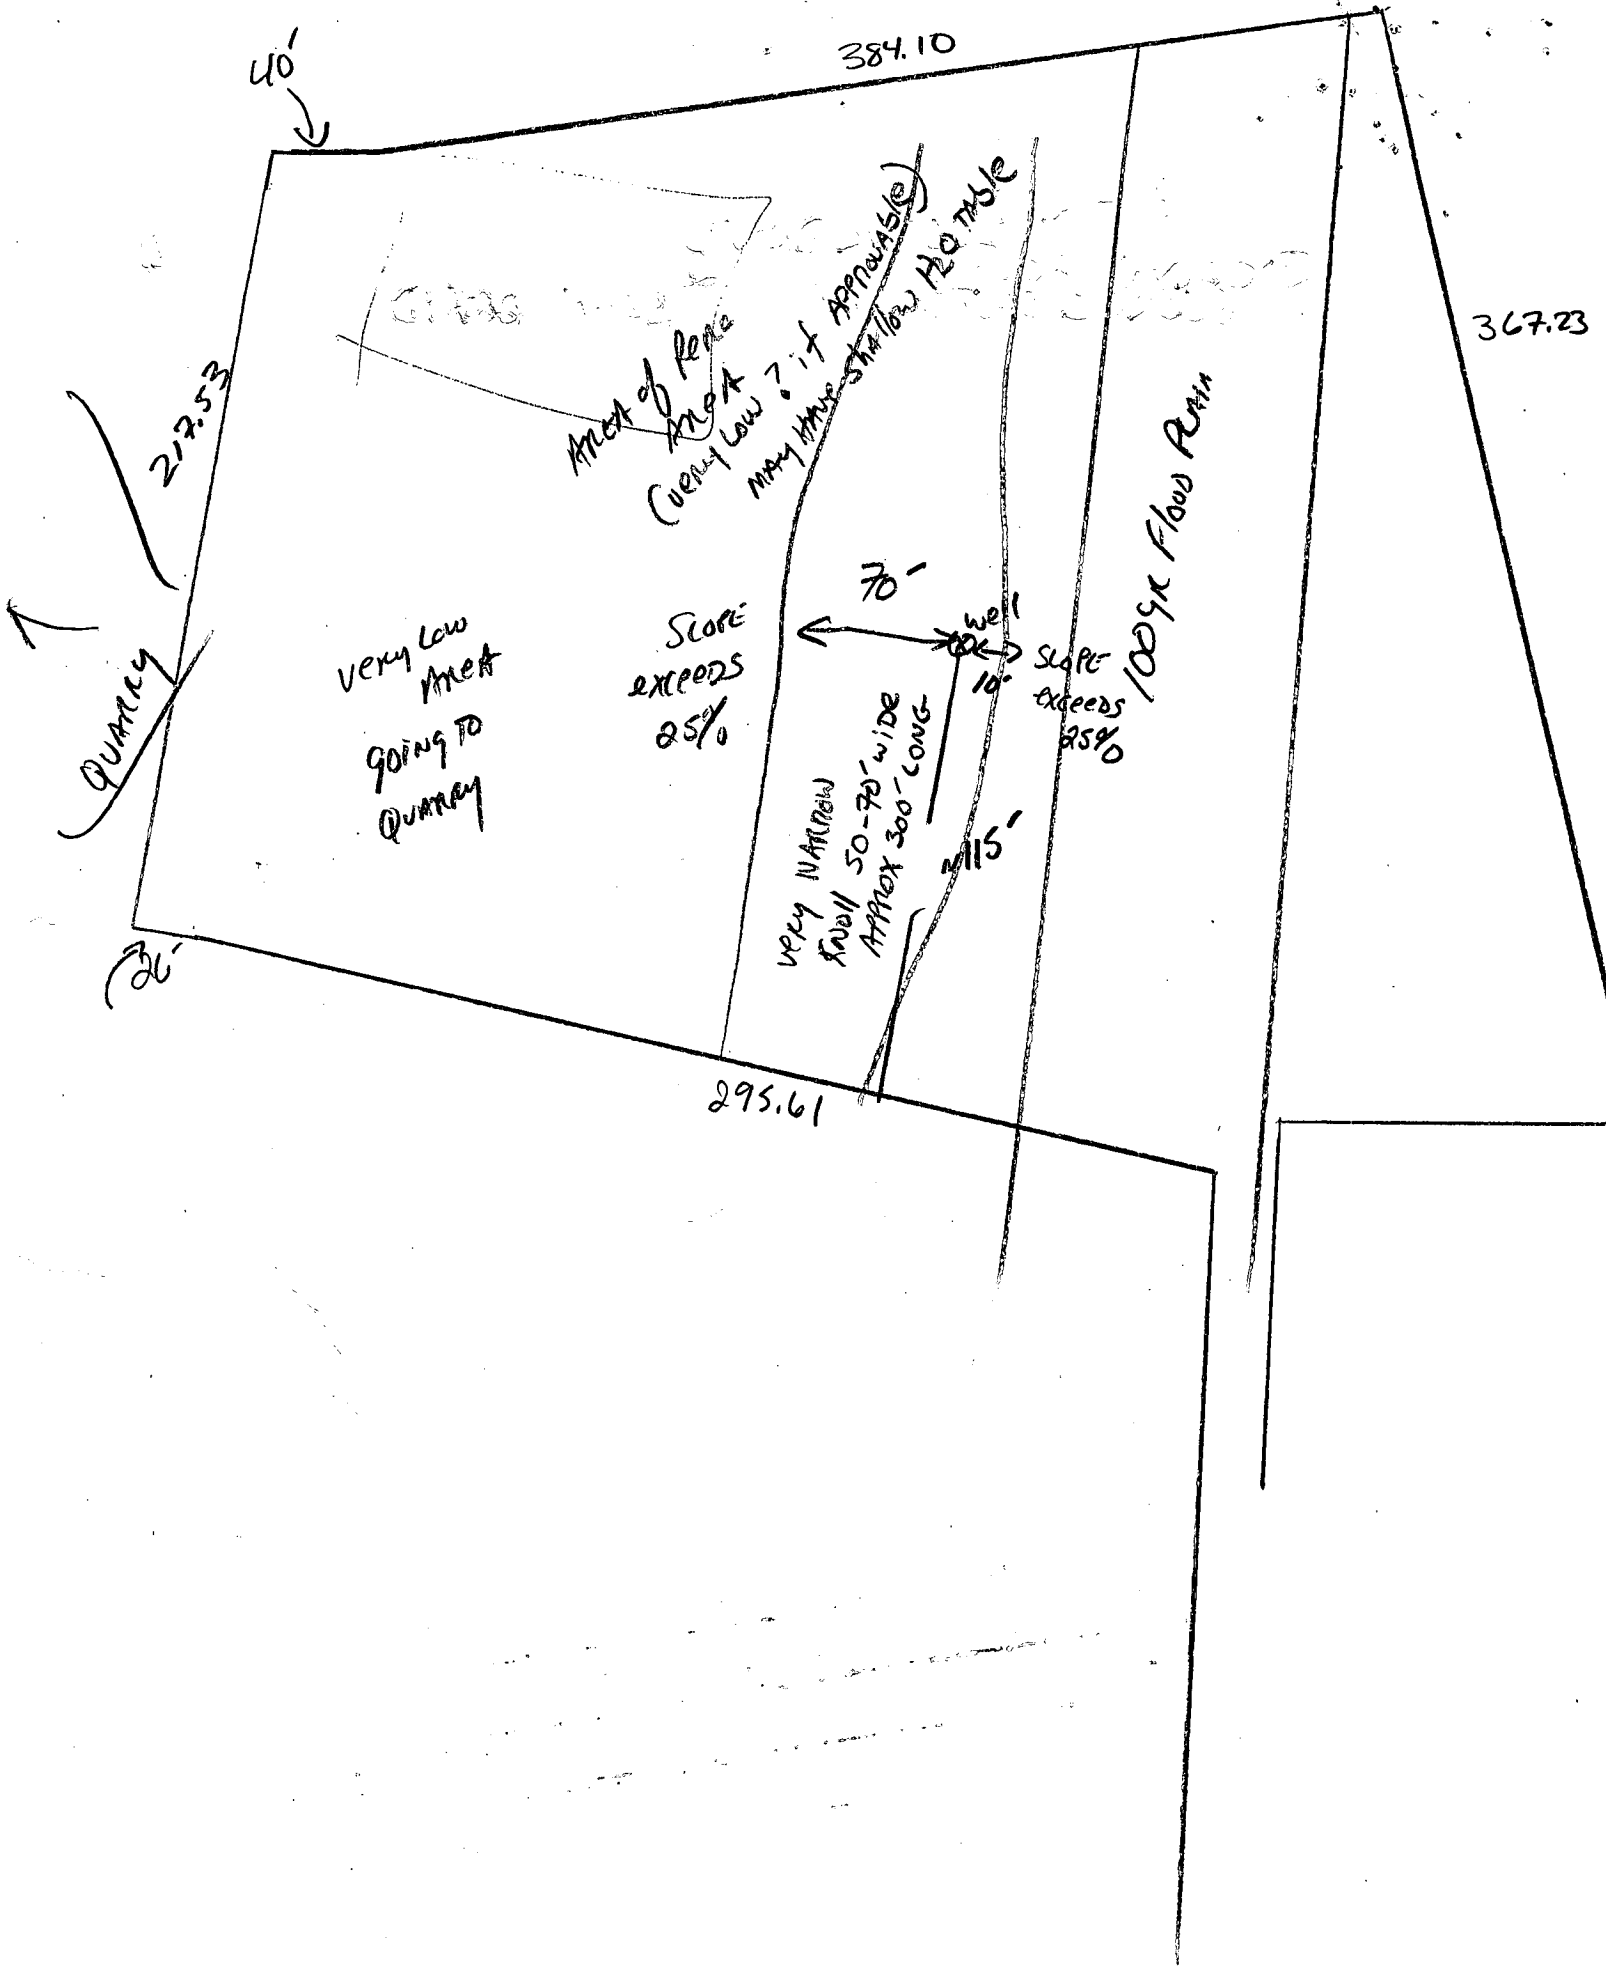

384.10

40'

367.23

212.53

QUARRY

VERY LOW AREA
GOING TO
QUARRY

Area of Pond
Area
(Very Low?) if Approx 100'
MAY HAVE SHALLOW HEAD TABLE

SCORE
EXCEEDS
25%

70'

VERY NARROW
TUNNEL 50-70' WIDE
APPROX 300' LONG

WELL
10'
SLOPE
EXCEEDS
25%

100% FLOOD RAIN

115'

295.61

36'

HOWARD COUNTY HEALTH DEPARTMENT
Bureau of Environmental Health
3525-H Ellicott Mills Drive
Ellicott City, MD 21043
461-9933

APPLICATION FOR PITLESS ADAPTER, WELL PUMP AND PRESSURE TANK INSTALLATION

New Installation X
Replacement _____

Receipt # 47148
Date 3/28/91

Name of Installer Van Sant Plumbing & Heating

Telephone 829-0444

License Number 1467

Certified Well Pump Installer _____ Well Driller _____ Registered Plumber X

Name of Property Owner Greenfield Homes

Telephone 549-7558

Subdivision Jocelyn Acres Lot # _____

Well Tag # HD - 81 - 2119

Site Address 6656 Luster Drive Highland, MD

Pump

- Type
 - Deep well jet _____
 - Shallow well jet _____
 - Submersible _____
- Make _____
- Model # _____
- Capacity _____ GPM
- Pump exceeds well capacity Yes _____ No _____
- If Yes, is low pressure cutoff switch installed? Yes _____ No _____
- What methods are used to protect the pump and electrical wiring from vibrations? Torque arrestors _____ Cable guards _____ Other _____

Motor

- Horsepower _____
- RPM _____
- Voltage
 - 110 _____
 - 220 _____

Pitless Adapter

- Make _____
- Model # _____
- Depth _____

Tank

- Capacity _____
- Pressure relief valve? _____

Piping

- Type _____
- Size _____
- NSF and/or BOCA Code approved _____
- Depth of supply line _____

Well data

- Depth 140 ft.
- Yield 15 GPM
- Static water level 46 ft.
- Will water supply be disinfected by installer? _____

I understand that it is my responsibility to notify the Howard County Health Department when the installation is ready for inspection (otherwise this permit is null and void).

All information given above is true to the best of my knowledge.


Signature of Applicant: Stanford A. Van Sant

Date: 3/28/91

Note: A sticker indicating approval/status of the installation will be placed on the well casing at the time of the inspection.


JOCELYN ACRES
SECT. 3

JOCELYN ACRES HOMEOWNERS
1237/211
Δ 5585
LOT 12

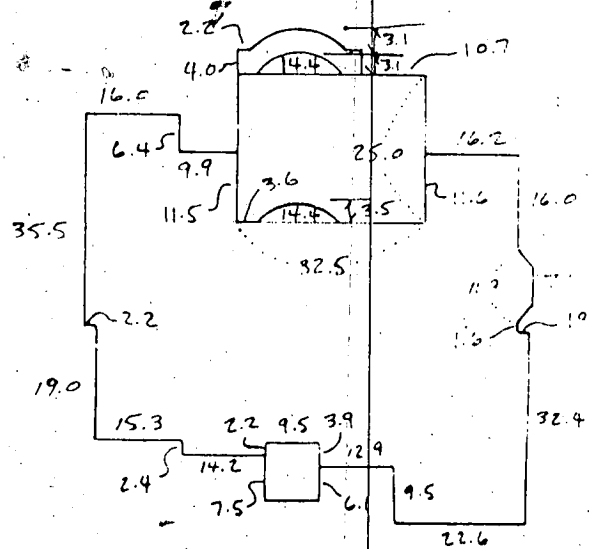

HOUSE DETAIL
(NO SCALE)

MARCHESIELLO
1234/352
Δ 5585
LOT 6
475.6

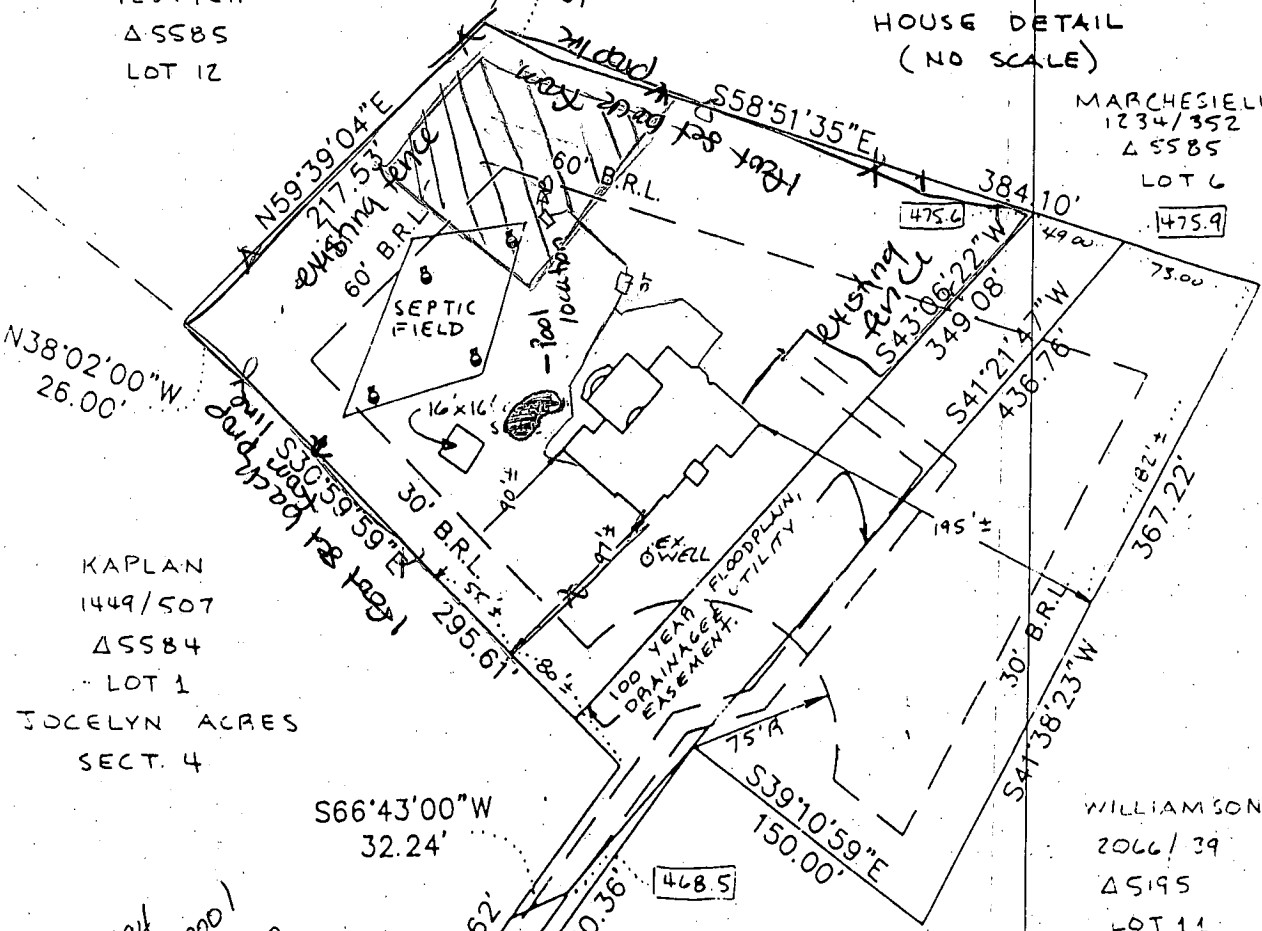

KAPLAN
1449/507
Δ 5584
LOT 1

JOCELYN ACRES
SECT. 4

WILLIAMSON
2066/39
Δ 5195
LOT 11

JOCELYN ACRES
SECT. 1

SURRETTE
1383/378
Δ 5210
LOT 8

4/18/94
Proposed pool
location has no
impact to existing
well or septic
Amy McMillan

NOTES:

- HIGHEST FLOOD PLAIN ELEV. OPP. HOUSE: +72±
PER PROFILE DRAINAGE EASMT. PLAN F-83-72.
- BASEMENT ELEV. = 476.9
- F.F. ELEV. = 487.6
- DESIGNATED AS LOT NO. 2 OF
"JOCELYN ACRES SECT. 4" AS SHOWN
ON HOWARD COUNTY RECORDED PLAT 5584
- SCALE: 1"=100'
- HOUSE TO BE 2-STORY: (STILL UNDER
CONSTRUCTION; EXTERIOR NOT YET
DETERMINED.)

JOCELYN ACRES
SECT. 2

7-7-91
[Signature]

LUSTER
DRIVE
50' R/W

PREPARED BY:


HOUSE LOCATION: LOT 2 SECT. 4 "JOCELYN ACRES"

TAX MAP: 34 PARCEL: 391 PLAT: 5584

SCALE: 1"=100' DATE: 6-11-91

LIBER: 2256 FOLIO: 326

KAPLAN & DEM...
1082/097

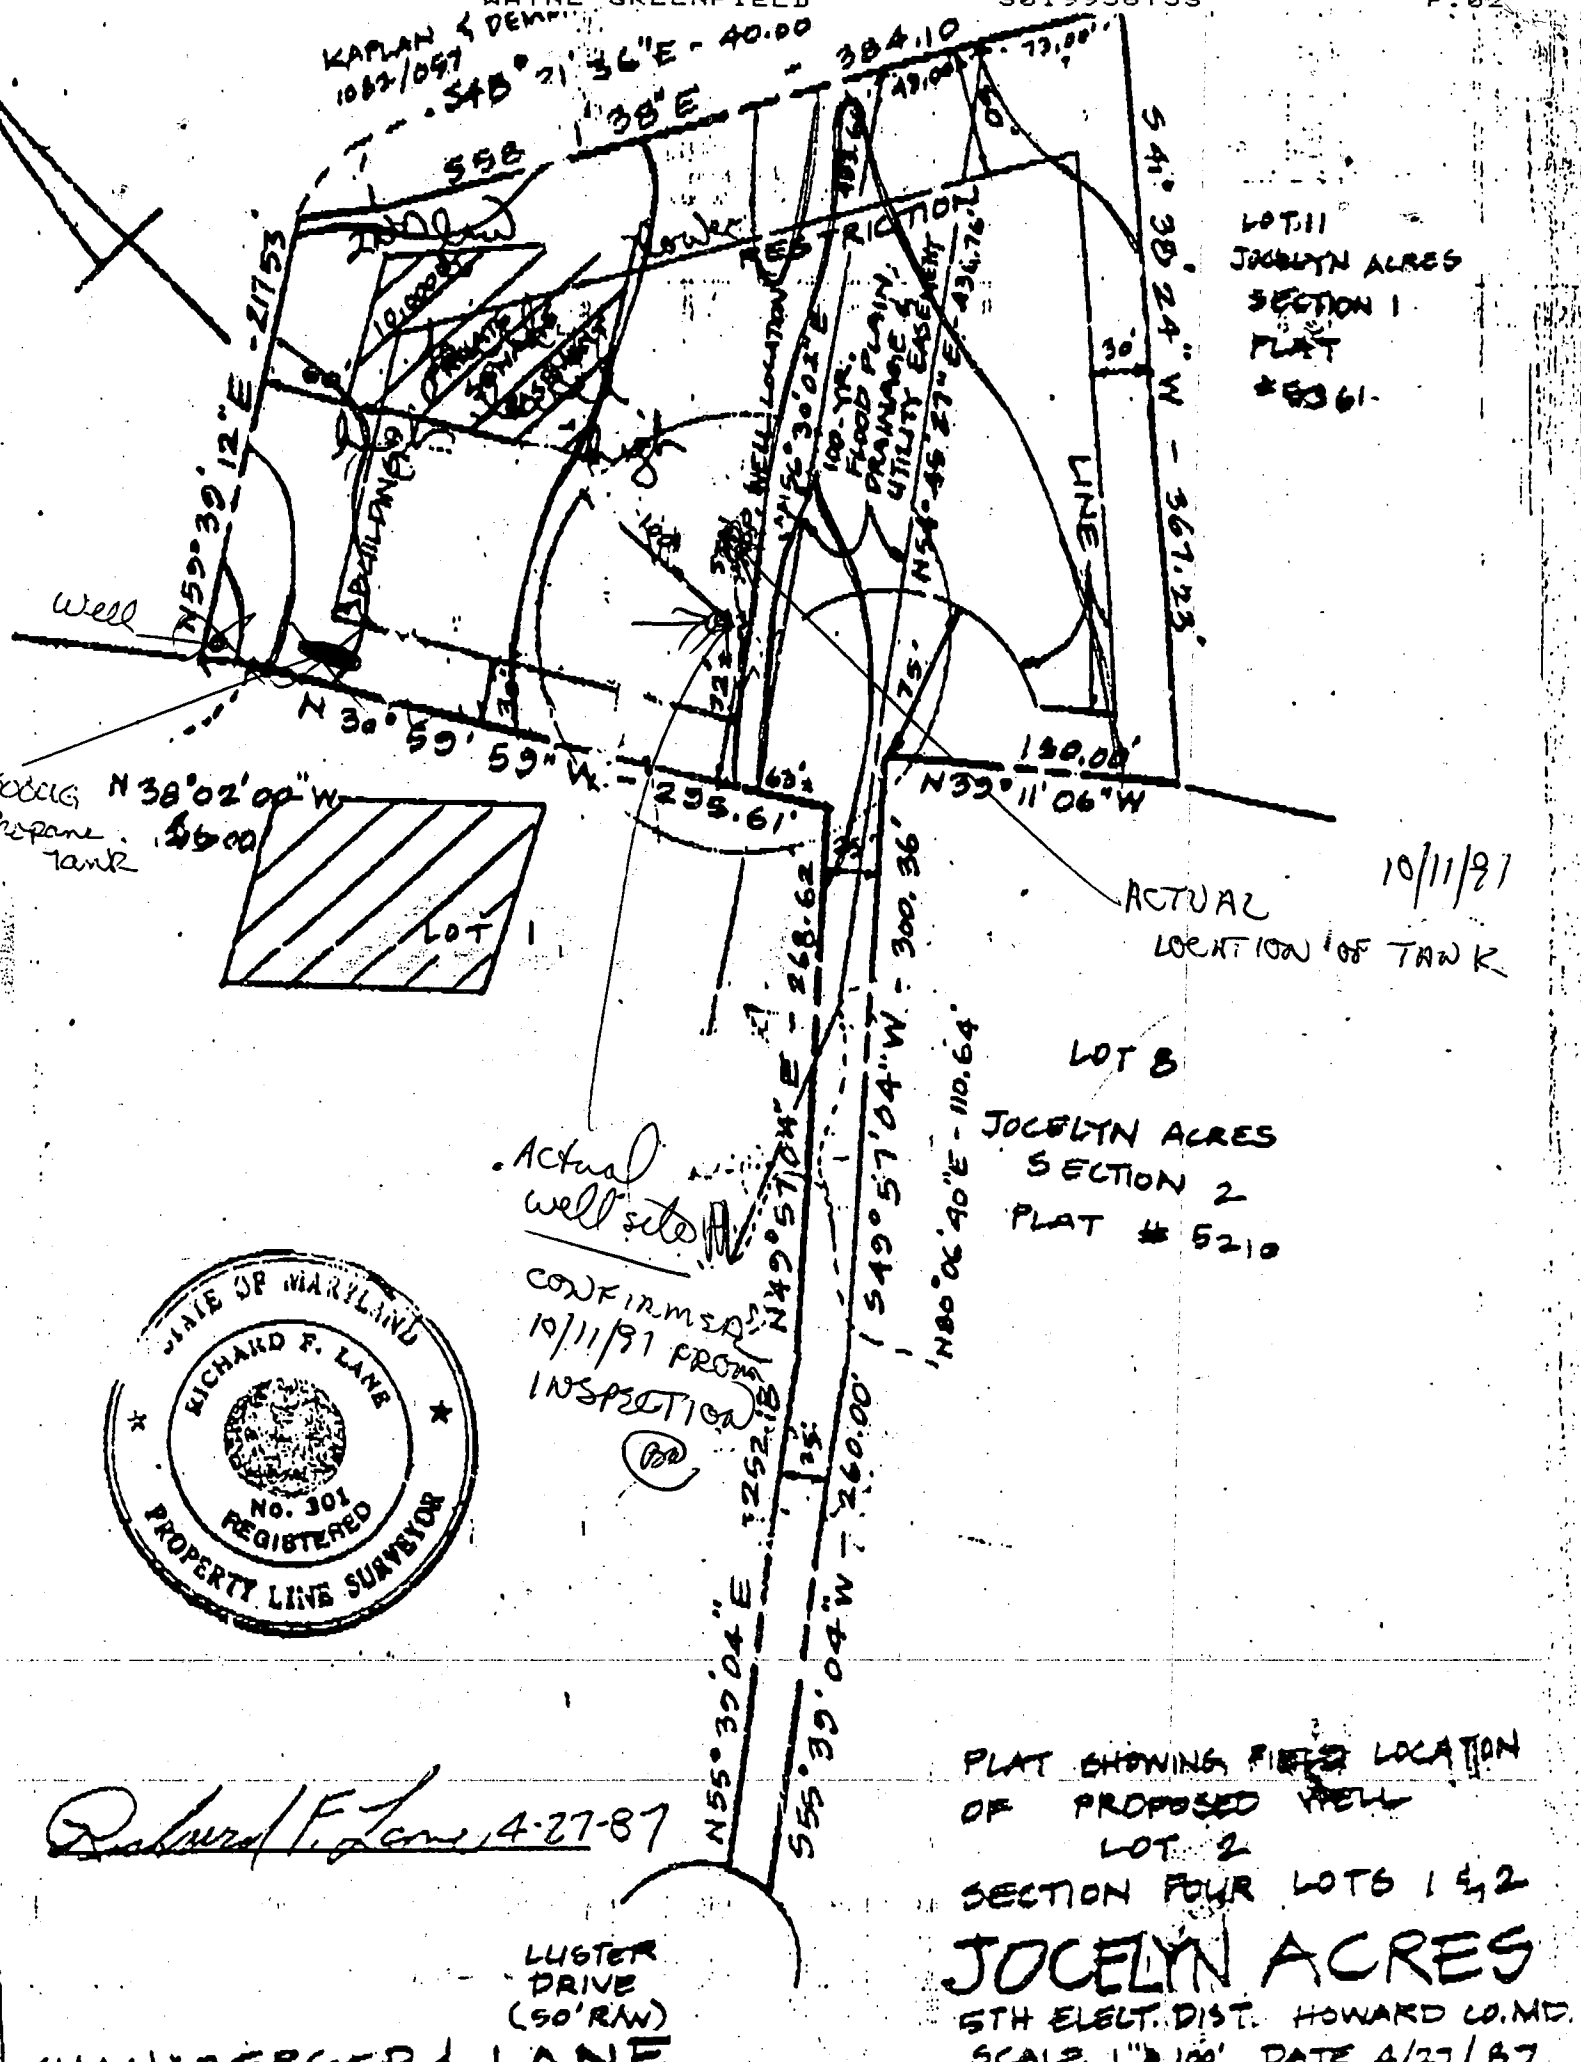

LOT 11
JOCELYN ACRES
SECTION 1
PLAT
5361

5000G
Propane
tank
N 38° 02' 00" W
56.00
LOT 1

10/11/91
ACTUAL
LOCATION OF TANK

LOT 3
JOCELYN ACRES
SECTION 2
PLAT # 5210

Actual
well site
CONFIRMED
10/11/91 FROM
INSPECTION



Richard F. Lane 4-27-87

LUSTER
DRIVE
(50' RAW)

SHANABERGER & LANE

PLAT SHOWING FIELD LOCATION
OF PROPOSED WELL

LOT 2
SECTION FOUR LOTS 1 & 2


JOCELYN ACRES

5TH ELECT. DIST. HOWARD CO. MD.

SCALE 1" = 100' DATE 4/27/87

PLAT # 5584

10/11/91

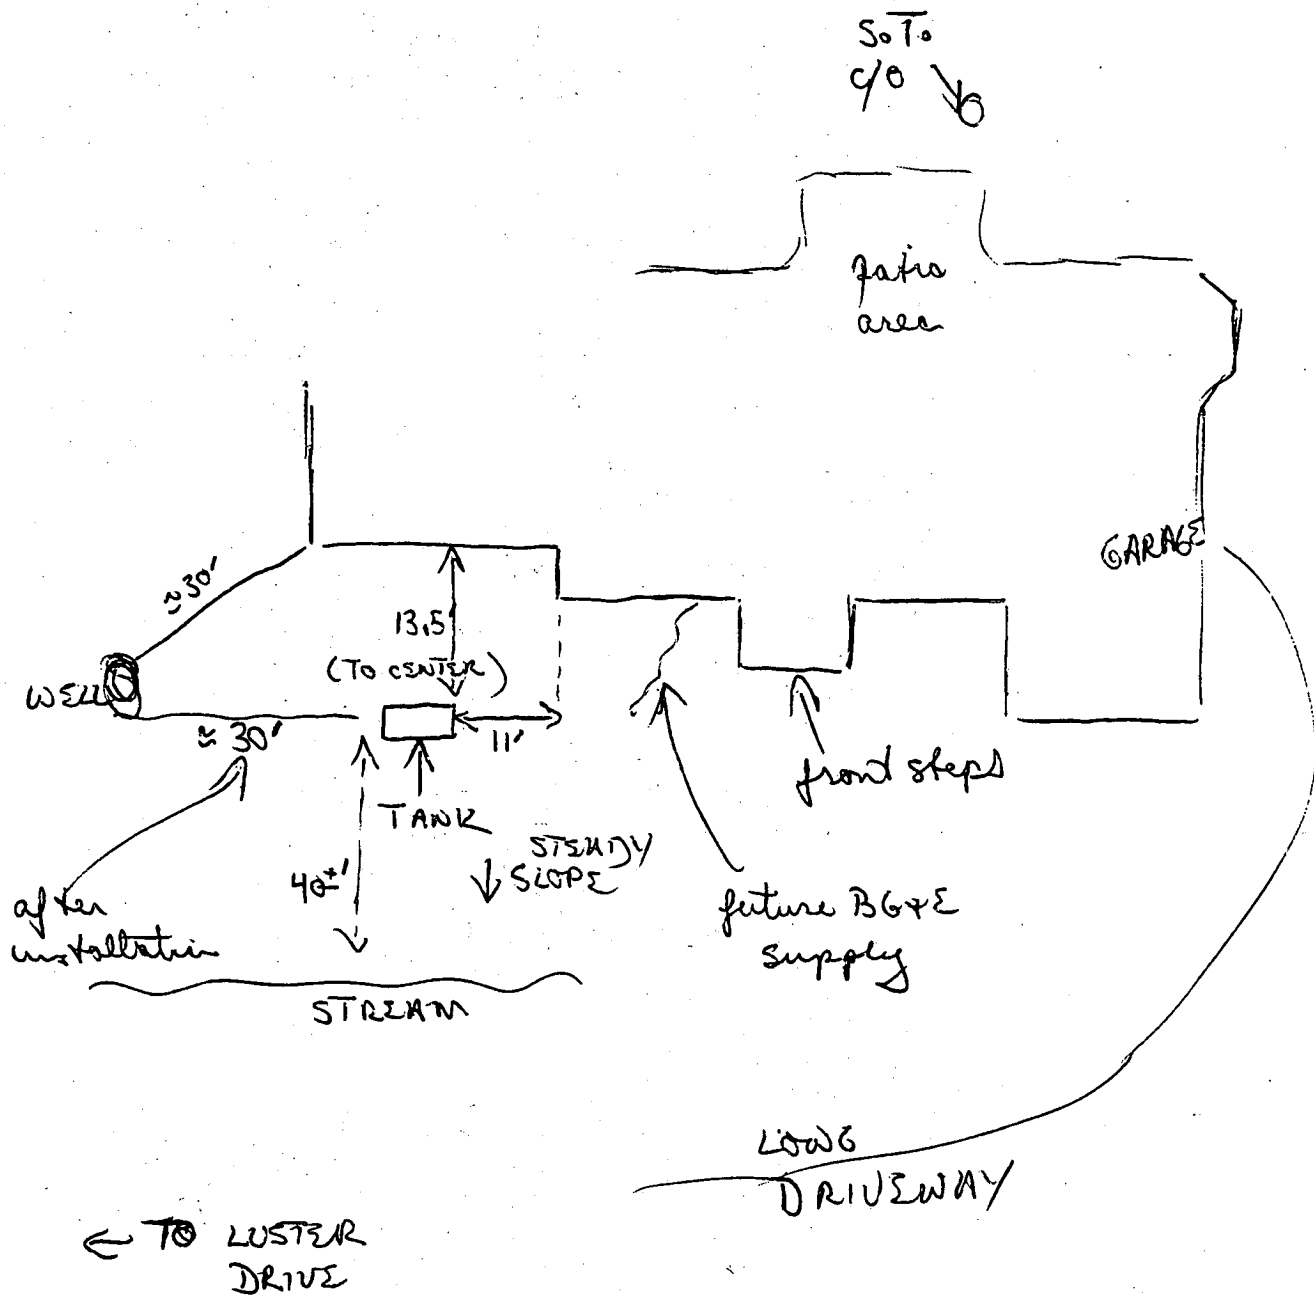

planned tank location would have been $< 10'$ from well casing. owner agreed to shift location further from the well to site referenced above. This site is more acceptable. OK to process permit.

APPLICATION

HOWARD COUNTY
PERMIT APPLICATION

SERIAL NUMBER
39935

DEPARTMENT OF INSPECTIONS, LICENSES & PERMITS
3430 COURT HOUSE DRIVE, ELICOTT CITY, MARYLAND 21043

BUILDING ADDRESS (HOUSE NO., STREET, TOWN OR AREA)
6656 Luster Dr Highland MD 20777

GRADING/SEDIMENT CONTROL YES NO

DESCRIPTION OF WORK AUTHORIZED
Buy 1-500 gallon tank propane

LOT NO.	PARCEL NO.	SEC.	AREA	BLOCK NO.	LIBER	FOLIO
2	391	4		20		

SUB DIVISION	ZONE	ZONE MAP	ELEC. DIST.	CENSUS TR.
Jacelyn Acres	R	34		6051

OWNER'S NAME AND ADDRESS
7549 Red Crest Columbia
M.D. 21046
PHONE NO. 995-6753

OCCUPANT'S NAME AND ADDRESS
Same as Owner
PHONE NO.

ARCHITECT OR ENGINEER'S NAME AND ADDRESS
PHONE NO.

SIZE OF BLDG.	FRONT	DEPTH	HEIGHT
TYPE OF BLDG.	AREA	VOLUME	ROOF
B. ROOMS ROOMS BATHS FIREPLACES			
FOOTINGS		FOUNDATION	S. WALLS

CONTRACTOR'S NAME AND ADDRESS
Petrolone Gas Service
10097 Balto. Nat'l Pike
Ellicott City MD 21043
PHONE NO. 465-0800

UTILITIES				
WATER/WELL	SEWER/SEPTIC	GAS	ELECTRICITY	TYPE OF HEAT
				AC

I have carefully examined and read this application and know the same is true and correct, and that in doing this work, all provisions of Howard County Ordinances and the State Laws of Maryland will be complied with, whether specified or not; and I will notify the Bureau of Inspections, and Permit twenty-four hours in advance when I am ready for the inspections called for elsewhere in this application; and that no work will be covered up until such inspections have been completed with.

White Livingston
Retail Sales Rep.
SIGNATURE
10/4/91
DATE

EXISTING USE SFH
PROPOSED USE Same w/ tank

EST. CONSTRUCTION COST \$7300.00
LICENSE NUMBER
PERMIT FEE

W/S CODE
FOR OFFICE USE ONLY
DISTANCE IN FEET FROM R/W LINE TO FRONT BUILDING LINE
SIDE YARD
(DISTANCE IN FEET FROM SIDE BLDG. LINE TO SIDE PROPERTY LINE)
DISTANCE IN FEET FROM SIDE STREET R/W LINE
TO SIDE BUILDING LINE
DISTANCE IN FEET, REAR YD. REQUIRING SET
BACK
CONDITIONS (IF ANY) (CORNER LOT ONLY)
SDP #

FUNCTION	DATE	SIGNATURE APPROVAL
ZONING/PLANNING		
SHA		
SEDIMENT/GRADING		
BUILDING OFFICIAL		
WATER & SEWER		
HEALTH DEPT.	10/11/91	B. W. Nye
FIRE PROTECTION		
STORM WATER MGM.		

Checks payable to DIRECTOR OF FINANCE OF HOWARD COUNTY

CAUTION
To begin construction before a permit placard has been issued and displayed on the job is a violation of the law.
Use and occupancy permit must be applied for two weeks before it will be issued.

IMPORTANT: PLEASE SHOW ZIP CODES AND AREA CODES WHEREVER REQUIRED.

LP-69
Revised

Distribution of Copies:
White - Building Official
Green - Planning & Zoning

Yellow - Engineering
Pink - Health Dept
Gold - S.H.A.

APPROVED

DATE