

4/16/81
11
A.M.

02-214369

APPROVED
4/16/81 RH
P 31326

PERMIT

SEWAGE DISPOSAL SYSTEM

A Repair

MARYLAND STATE DEPARTMENT OF HEALTH

HOWARD COUNTY

ELLICOTT CITY

DISTRICT 2nd

INDEXED

DATE 4/15/81

Jack Fyock IS PERMITTED TO INSTALL ALTER X

ADDRESS 13775 Triadelphia Rd PHONE 988-9270

SUBDIVISION _____ ROAD 2533 Mckenzie Rd LOT _____

PROPERTY OWNER Mr. Randolph Broske
Off Route 99
Abn Dist West 57 Johns Lane

ADDRESS 2533 Mckenzie Rd , Ellicott City, Md. 21043

SPECIFICATIONS

SEPTIC TANK CAPACITY _____ GALLONS
DRAIN FIELD _____ DEPTH _____ FEET, BOTTOM AREA _____ SQ. FT.
DEEP TRENCH _____ DEPTH _____ FEET, BOTTOM AREA _____ SQ. FT.
SEEPAGE PITS _____ ABSORBENT SIDE-WALL AREA _____ SQ. FT.
INLET PIPE _____ FT. BELOW ORIGINAL GRADE; MAXIMUM DEPTH _____ FT. BELOW ORIGINAL GRADE
EFFECTIVE DEPTH AT _____ FT. BELOW ORIGINAL GRADE.
LOCATE DISPOSAL AREA _____ FT. FROM _____ LOT LINE AND _____ FT. FROM _____ LOT LINE AS SEEN WHEN
FACING LOT FROM

REPAIR-CALL FOR INSPECTION WHEN GROUND IS OPENED UP SO SANITARIAN

CAN RECOMMEND REPAIR 4/16/81


DITCH 360 SQ FT - 10 FT DEEP 8 FT STONE
2 FT WIDE 45 FT LONG

PLANS APPROVED BY Palmer F. Wine DATE 4/15/81

- COVER NO WORK UNTIL INSPECTED AND APPROVED.
- NEITHER THE HOWARD COUNTY COUNCIL NOR THE HEALTH DEPARTMENT IS RESPONSIBLE FOR THE SUCCESSFUL OPERATION OF ANY SYSTEM.
- NOTE: IF TRENCH IS USED CALL FOR INSPECTION BEFORE PLACING GRAVEL IN TRENCH.
- NOTE: NO DRY WELL SHALL EXCEED .15 FOOT IN DIAMETER.
- NOTE: ALL PIPE FROM HOUSE TO DISPOSAL AREA MUST BE CAST IRON.
- PERMIT VOID AFTER THREE YEARS.
- NOTE: INSTALL STAND PIPE ON SEPTIC TANK AND DRY WELL. STAND PIPES MUST BE 6 INCHES IN DIAMETER. CAST IRON, CONCRETE OR TERRA COTTA ACCEPTED.

***INSTALLER IS RESPONSIBLE FOR OBTAINING FINAL APPROVAL ON THIS PERMIT.**

P
A 31326

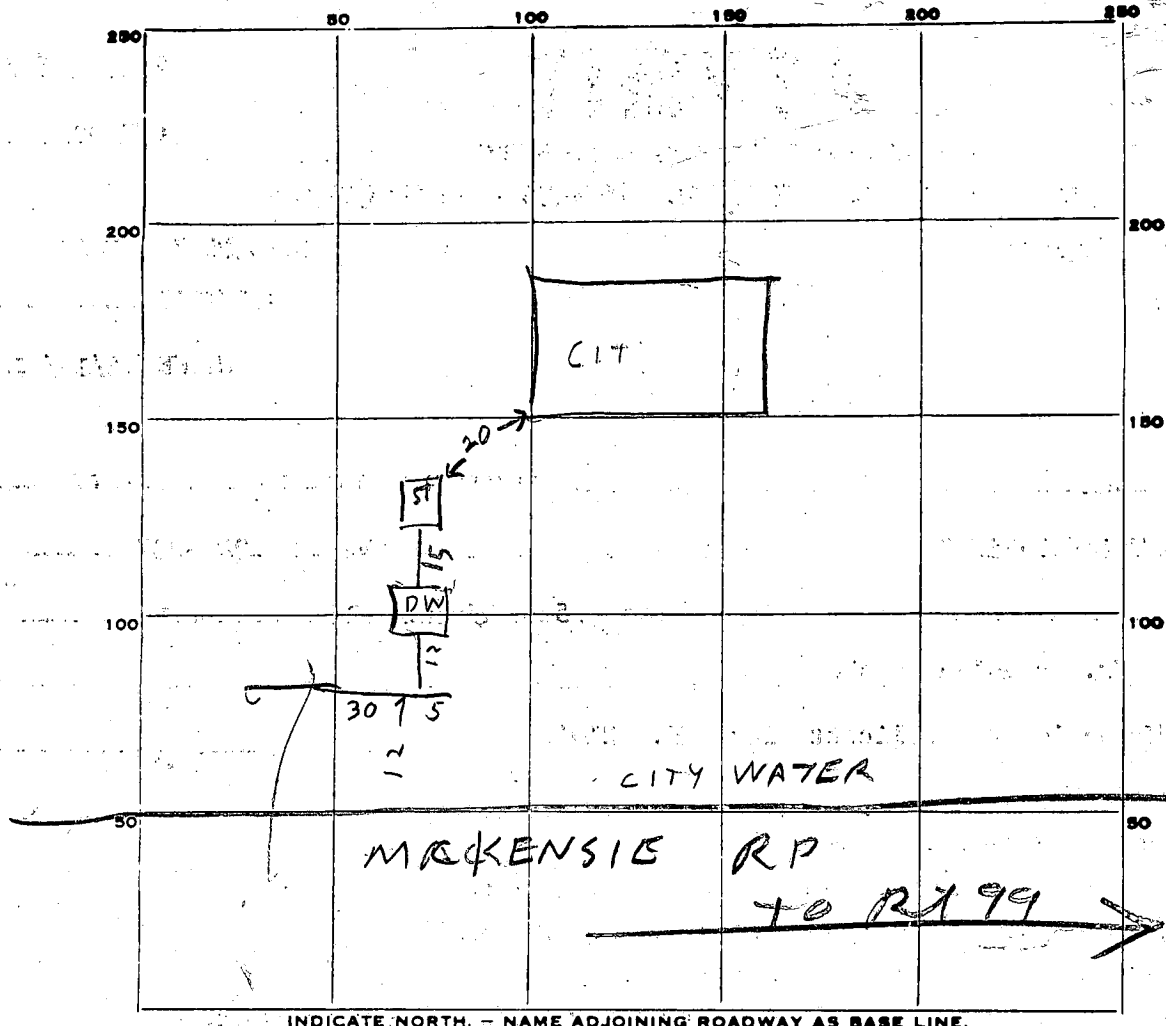

46
 360
 370

PERMIT CARD _____

SEPTIC TANK, LEVEL N/A CLEANOUTS _____

DISTRIBUTION BOX, LEVEL _____

TILE FIELD, DEPTH 10 FT. TRENCH WIDTH 2 FT.

GRAVEL DEPTH 8 FT IN. TOTAL LENGTH 46 FT. 4637

NUMBER OF TRENCHES 1 TOTAL BOTTOM AREA 368

SEEPAGE PITS, INSIDE DIAMETER _____ FT. DEPTH BELOW INLET _____ FT.

ABSORBENT AREA _____ SQ. FT.

REMARKS 4/16/81 DITCH INLET LEFT BELOW GRADE
DITCH IS ALL SAND & MAKE DITCH 10 FT DEEP
45 FT LONG 8 FT STONE OLD DW IN USE
20 YEARS & IS 12 FT DEEP, ADD STONE & PIPE
4/16/81 STONE ADDED

DATE SYSTEM APPROVED 4/16/81 INSPECTOR Raymond Hodge