

7/2/81
as soon as possible

approved 7/2/81
stayed
P 31435

PERMIT

SEWAGE DISPOSAL SYSTEM

A Repair

MARYLAND STATE DEPARTMENT OF HEALTH

HOWARD COUNTY

ELLICOTT CITY

DISTRICT 5th

Indexed

DATE 6/16/81

Jack Fyock IS PERMITTED TO INSTALL ALTER X

ADDRESS 13775 Triadelphia Road, Glenelg, Md. 21737 n PHONE 988-9270

SUBDIVISION Holiday Hills ROAD 7013 Long View Rd. LOT 3 Sec. 1

PROPERTY OWNER Robert Thomas Jr.

ADDRESS 7013 Long View Road,

SPECIFICATIONS

SEPTIC TANK CAPACITY _____ GALLONS

DRAIN FIELD _____ DEPTH _____ FEET, BOTTOM AREA _____ SQ. FT.

DEEP TRENCH _____ DEPTH _____ FEET, BOTTOM AREA _____ SQ. FT.

SEEPAGE PITS _____ ABSORBENT SIDE-WALL AREA _____ SQ. FT.

INLET PIPE _____ FT. BELOW ORIGINAL GRADE. MAXIMUM DEPTH _____ FT. BELOW ORIGINAL GRADE

EFFECTIVE DEPTH AT _____ FT. BELOW ORIGINAL GRADE.

LOCATE DISPOSAL AREA _____ FT. FROM _____ LOT LINE AND _____ FT. FROM _____ LOT LINE AS SEEN WHEN FACING LOT FROM

REPAIR-CALL FOR INSPECTION WHEN GROUND IS OPENED UP SO SANITARIAN CAN RECOMMEND REPAIR.

60 ft trenches, 8 ft deep with 6 ft of stone. Trenches to start 12 ft from septic tank and run toward right property line

PLANS APPROVED BY Palmer F. Wine DATE June 16, 1981

COVER NO WORK UNTIL INSPECTED AND APPROVED.

NEITHER THE HOWARD COUNTY COUNCIL NOR THE HEALTH DEPARTMENT IS RESPONSIBLE FOR THE SUCCESSFUL OPERATION OF ANY SYSTEM.

NOTE: IF TRENCH IS USED CALL FOR INSPECTION BEFORE PLACING GRAVEL IN TRENCH.

NOTE: NO DRY WELL SHALL EXCEED 15 FOOT IN DIAMETER.


NOTE: ALL PIPE FROM HOUSE TO DISPOSAL AREA MUST BE CAST IRON.

PERMIT VOID AFTER THREE YEARS.

NOTE: INSTALL STAND PIPE ON SEPTIC TANK AND DRY WELL. STAND PIPES MUST BE 6 INCHES IN DIAMETER. CAST IRON, CONCRETE OR TERRA COTTA ACCEPTED.

*INSTALLER IS RESPONSIBLE FOR OBTAINING FINAL APPROVAL ON THIS PERMIT.

P 31435

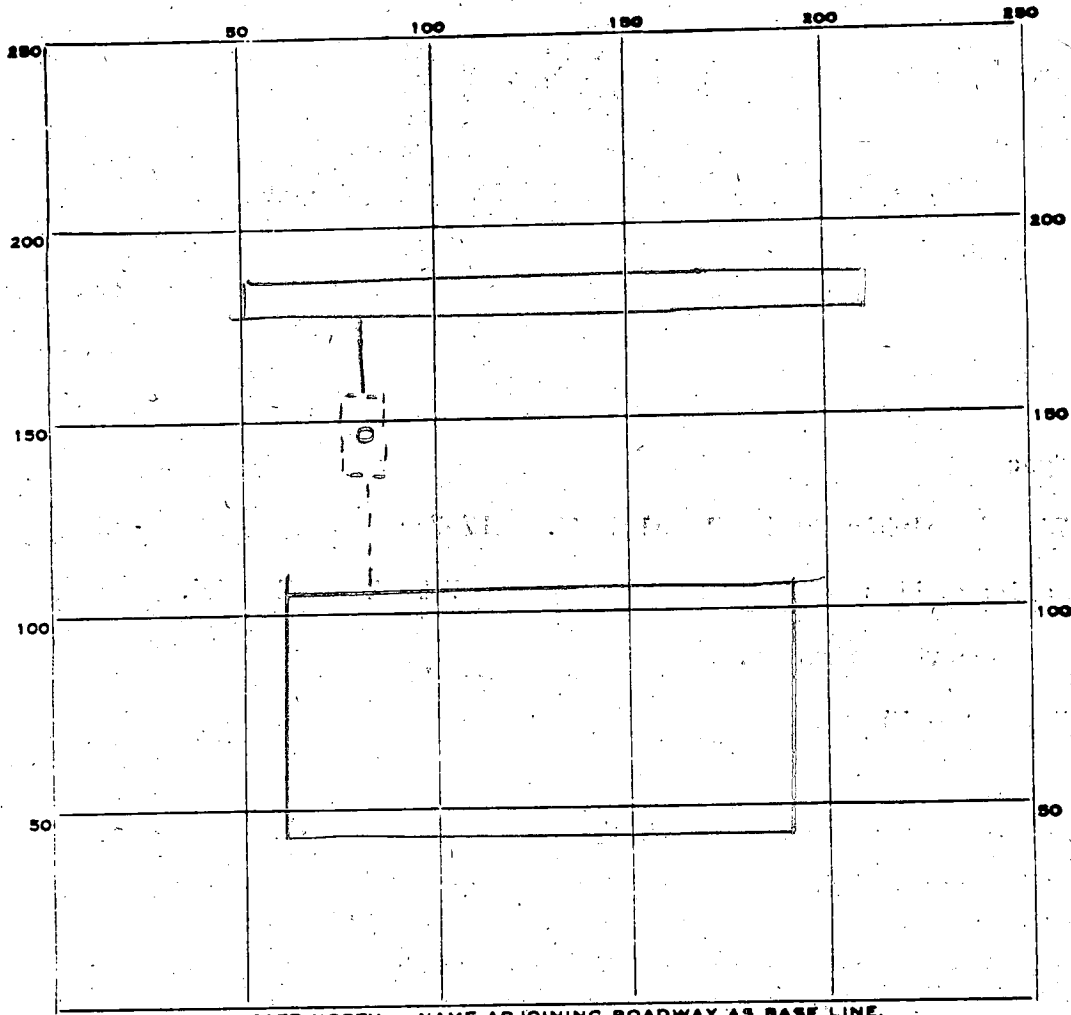

INDICATE NORTH. - NAME ADJOINING ROADWAY AS BASE LINE.

PERMIT CARD _____

SEPTIC TANK, LEVEL _____

CLEANOUTS _____

DISTRIBUTION BOX, LEVEL _____

TILE FIELD, DEPTH 8 FT. TRENCH WIDTH 2 FT.

GRAVEL DEPTH 6 IN. TOTAL LENGTH 70 FT.

NUMBER OF TRENCHES 1 TOTAL BOTTOM AREA 420

SEEPAGE PITS, INSIDE DIAMETER _____ FT. DEPTH BELOW INLET _____ FT.

ABSORBENT AREA 420 SQ. FT.

REMARKS 7/2/81 OK to add gravel in trench. JF
7/2/81 OK to cover all work. JF

DATE SYSTEM APPROVED 7/2/81

INSPECTOR Stanger

APPLICATION

PERMIT APPLICATION

SERIAL NUMBER

39237

DEPARTMENT OF INSPECTIONS, LICENSES & PERMITS
3430 COURT HOUSE DRIVE, ELLICOTT CITY, MARYLAND 21043

HEALTH DEPT

BUILDING ADDRESS (ROUTE NO., STREET, TOWN OR AREA)

7013 Longview Rd
Columbia, MD 21044

LOT NO. PARCEL NO. SEC. AREA BLOCK NO. LIBER FOLIO

3 174

SUB DIVISION ZONE ZONE MAP ELEC. DIST. CENSUS TR.

Holiday Hills 411

OWNER'S NAME AND ADDRESS PHONE NO.

Robert Thomas 531-5531
7013 Longview Rd
Columbia MD 21044

OCCUPANT'S NAME AND ADDRESS PHONE NO.

same

ARCHITECT OR ENGINEER'S NAME AND ADDRESS PHONE NO.

CONTRACTOR'S NAME AND ADDRESS PHONE NO.

Starcopa Design Build 997-7700
9123 OLD ANNAPOLIS RD
COLUMBIA MD 21045

EXISTING USE PROPOSED USE

single family dwelling Garage

EST. CONSTRUCTION COST LICENSE NUMBER PERMIT FEE

15,000 2124701

W/S CODE FOR OFFICE USE ONLY

DISTANCE IN FEET FROM R/W LINE TO FRONT BUILDING LINE

SIDE YARD

(DISTANCE IN FEET FROM SIDE BLDG. LINE TO SIDE PROPERTY LINE)

DISTANCE IN FEET FROM SIDE STREET R/W LINE

TO SIDE BUILDING LINE

DISTANCE IN FEET, REAR YD. REQUIRING SET

BACK (CORNER LOT ONLY)

CONDITIONS (IF ANY) SOP

Checks payable to DIRECTOR OF FINANCE OF HOWARD COUNTY

CAUTION

To begin construction before a permit placard has been issued and displayed on the job is a violation of the law. Use and occupancy permit must be applied for two weeks before it will be issued.

IMPORTANT: PLEASE SHOW ZIP CODES AND AREA CODES WHEREVER REQUIRED.

LP-69 Revised

GRADING/SEDIMENT CONTROL YES NO

DESCRIPTION OF WORK AUTHORIZED

1 story Detached Garage
2 car

SIZE OF BLDG. FRONT DEPTH HEIGHT

22 20 13

TYPE OF BLDG. AREA VOLUME ROOF

B. ROOMS 440 Cebe
ROOMS
BATHS
FIREPLACES

FOOTINGS FOUNDATION S. WALLS

concrete block LYOOFRAVE
SOWE

UTILITIES WATER WELL SEWER ELECTRIC TYPE OF HEAT AC

WATER WELL SEWER ELECTRIC GAS ELECTRICITY TYPE OF HEAT AC

I have carefully examined and read this application and know the same is true and correct, and that in doing this work, all provisions of Howard County Ordinances and the State Laws of Maryland will be complied with, whether specified or not; and I will notify the Bureau of Inspections, and Permits twenty-four hours in advance when I am ready for the inspections called for elsewhere in this application; and that no work will be covered up until such inspections have been completed with.

Robert E. Weickgenannt

PROV. SIGNATURE DATE 8-8-91

TITLE DATE

FOR OFFICE USE ONLY

FUNCTION DATE SIGNATURE APPROVAL

ZONING/PLANNING

SHA

SEDIMENT/GRADING

BUILDING OFFICIAL

WATER & SEWER

HEALTH DEPT. 8/21/91 Mark E. Hoffman

FIRE PROTECTION

STORM WATER MGM 8-20-91 Jean Reed

APPROVED DATE


Distribution of Copies: White - Building Official Yellow - Engineering Green - Planning & Zoning Pink - Health Dept Gold - S.H.A.

OF MY ABILITY THOSE IMPROVEMENTS ARE SHOWN HERE ON. THIS PLAT IS NOT INTENDED TO BE USED IN ESTABLISHMENT OF PROPERTY LINES. THIS IS NOT A BOUNDARY SURVEY.

Robert E. Weickgenannt
Robert E. Weickgenannt
SUTA 101W
9123 OLD ANNAPOLIS RD
Columbia, Md 21045

SCALE: 1" = 30'

BUILDING LOCATION PLAT
7013 LONGVIEW RD
LOT 3 DIST. NO. 174 T.M. 41
HOLIDAY HILLS

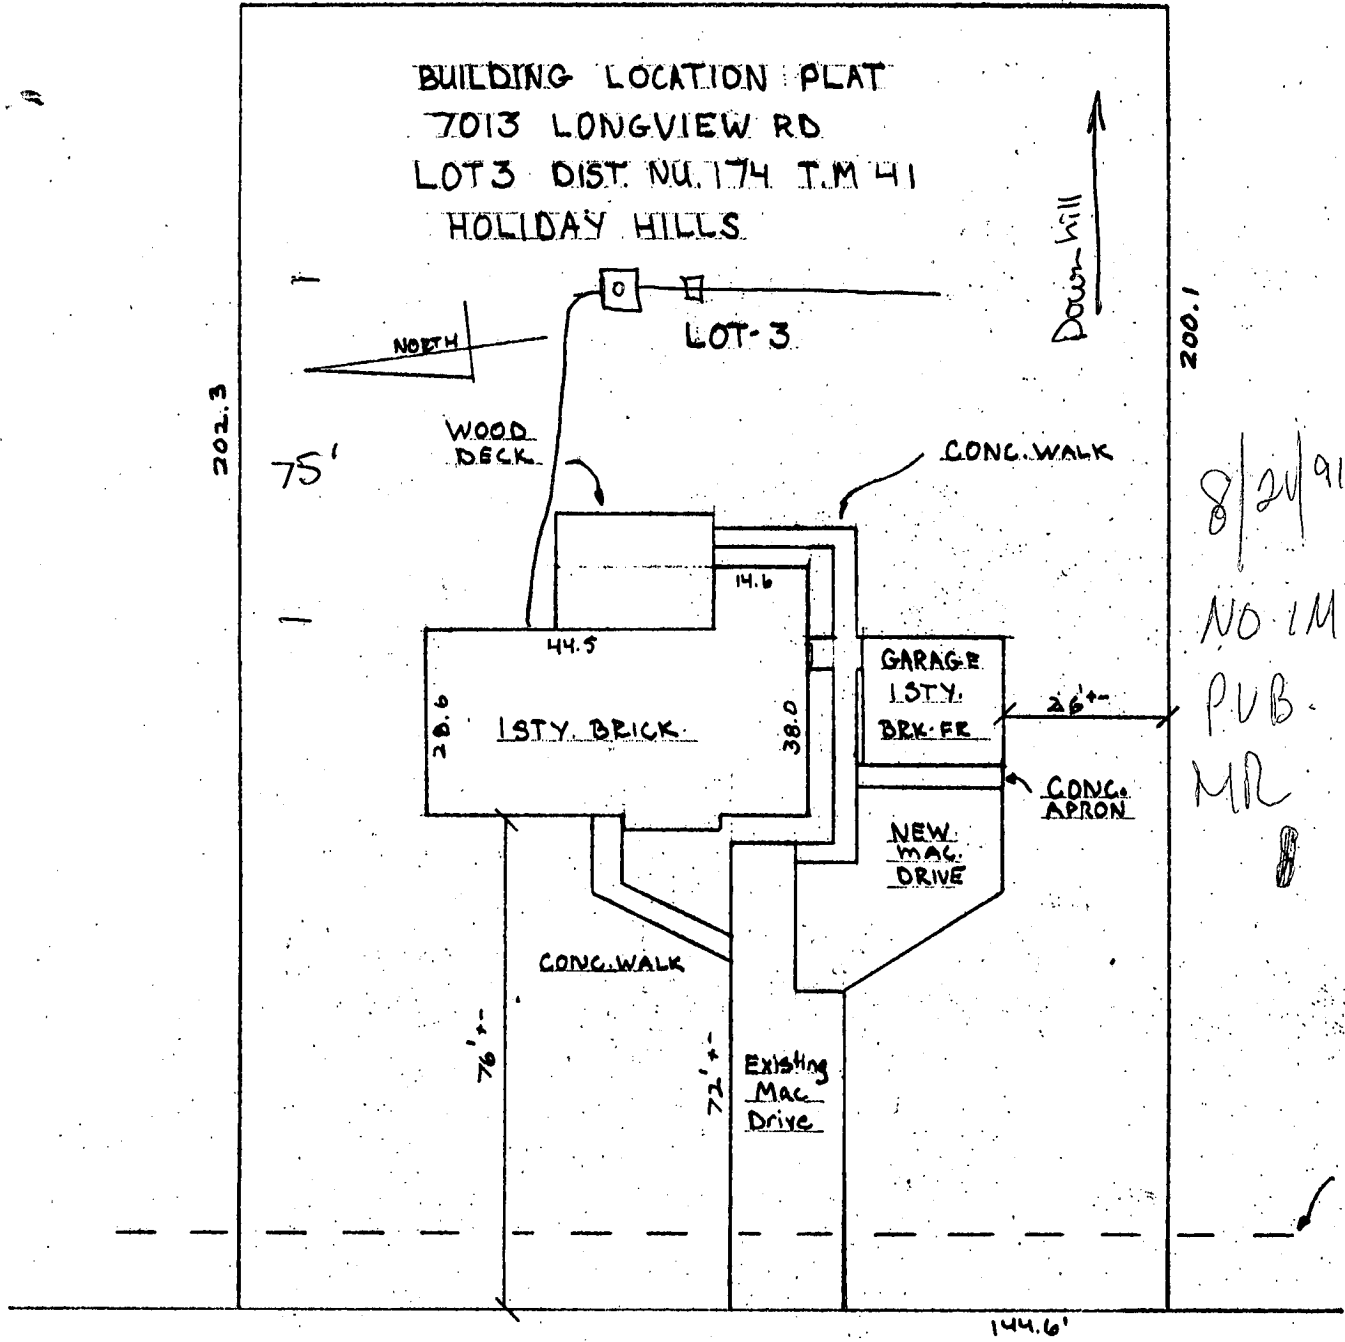

8/24/91
NO IMPACT
PUB. WATER
MR

LONG VIEW ROAD

I CERTIFY TO THE BEST OF MY KNOWLEDGE AND ABILITY THAT ON OR ABOUT AUGUST 6, 1991 A TAPE LOCATION OF IMPROVEMENTS TO THAT PROPERTY SHOWN HERE ON AND RECORDED AMONG THE LAND RECORDS OF HOWARD COUNTY, MARYLAND, AND TO THE BEST OF MY ABILITY THOSE IMPROVEMENTS ARE SHOWN HERE ON. THIS PLAT IS NOT INTENDED TO BE USED IN ESTABLISHMENT OF PROPERTY LINES, THIS IS NOT A BOUNDARY SURVEY.

Robert E. Weickgenant

Robert E. Weickgenant
SUITE 101W
91230 OLD ANNAPOLIS RD
Columbia, Md. 21045

SCALE: 1" = 30'