

# PERMIT

SEWAGE DISPOSAL SYSTEM

MARYLAND STATE DEPARTMENT OF HEALTH

HOWARD COUNTY

01-178121

ELLICOTT CITY

DISTRICT 1st

DATE 4/5/82

## INDEX

APPROVED  
P 31860  
4/16/82  
A Repair

#10/82  
4/11/82  
4/15/82  
p.m. please  
4/16/82  
p.m. please

Charles Schilling

IS PERMITTED TO INSTALL ALTER X

ADDRESS 5029 Landing Road, Elkridge, Md. 21227 PHONE 747-8490

SUBDIVISION \_\_\_\_\_ ROAD 5029 Landing Road LOT \_\_\_\_\_

PROPERTY OWNER Mr. Rose

ADDRESS 5029 Landing Road, Elkridge, Md. 21227 Phone: 744-4471

### SPECIFICATIONS

SEPTIC TANK CAPACITY \_\_\_\_\_ GALLONS

DRAIN FIELD \_\_\_\_\_ DEPTH \_\_\_\_\_ FEET, BOTTOM AREA \_\_\_\_\_ SQ. FT.

DEEP TRENCH 4 DEPTH 2 FEET, <sup>ONE SIDE</sup> BOTTOM AREA 360 SQ. FT.

SEEPAGE PITS \_\_\_\_\_ ABSORBENT SIDE-WALL AREA \_\_\_\_\_ SQ. FT.

INLET PIPE \_\_\_\_\_ FT. BELOW ORIGINAL GRADE. MAXIMUM DEPTH \_\_\_\_\_ FT. BELOW ORIGINAL GRADE

EFFECTIVE DEPTH AT \_\_\_\_\_ FT. BELOW ORIGINAL GRADE.

LOCATE DISPOSAL AREA \_\_\_\_\_ FT. FROM \_\_\_\_\_ LOT LINE AND \_\_\_\_\_ FT. FROM \_\_\_\_\_ LOT LINE AS SEEN WHEN

FACING LOT FROM

REPAIR = Call for an appointment when ground is opened up and Sanitarian will

recommend the repair system. DITCH 9 FT DEEP

60 FT LONG, 2 FT WIDE, 6 FT STONE INLET 3 FT BOG

RUNDITCH OFF OLD DW TOWARD VISUAL HOLE #1

PLANS APPROVED BY Palmer F. Wine DATE 4/5/82

COVER NO. WORK UNTIL INSPECTED AND APPROVED. LOCATED 108 FROM THE GARGE

NEITHER THE HOWARD COUNTY COUNCIL NOR THE HEALTH DEPARTMENT IS RESPONSIBLE FOR THE SUCCESSFUL OPERATION OF ANY SYSTEM. 80 FT FROM THE OLD TANK

NOTE: IF TRENCH IS USED CALL FOR INSPECTION BEFORE PLACING GRAVEL IN TRENCH.

NOTE: NO DRY WELL SHALL EXCEED 15 FOOT IN DIAMETER.

NOTE: ALL PIPE FROM HOUSE TO DISPOSAL AREA MUST BE CAST IRON.




PERMIT VOID AFTER THREE YEARS.

NOTE: INSTALL STAND PIPE ON SEPTIC TANK AND DRY WELL. STAND PIPES MUST BE 6 INCHES IN DIAMETER. CAST IRON, CONCRETE OR TERRA COTTA ACCEPTED.

\*INSTALLER IS RESPONSIBLE FOR OBTAINING FINAL APPROVAL ON THIS PERMIT.

BLDG. PERMIT SIGNED  
AND RETURNED 4/5/82  
Serial #50401  
Addition - Bedroom  
Bedroom Living room  
EH-2-1079

P 31860

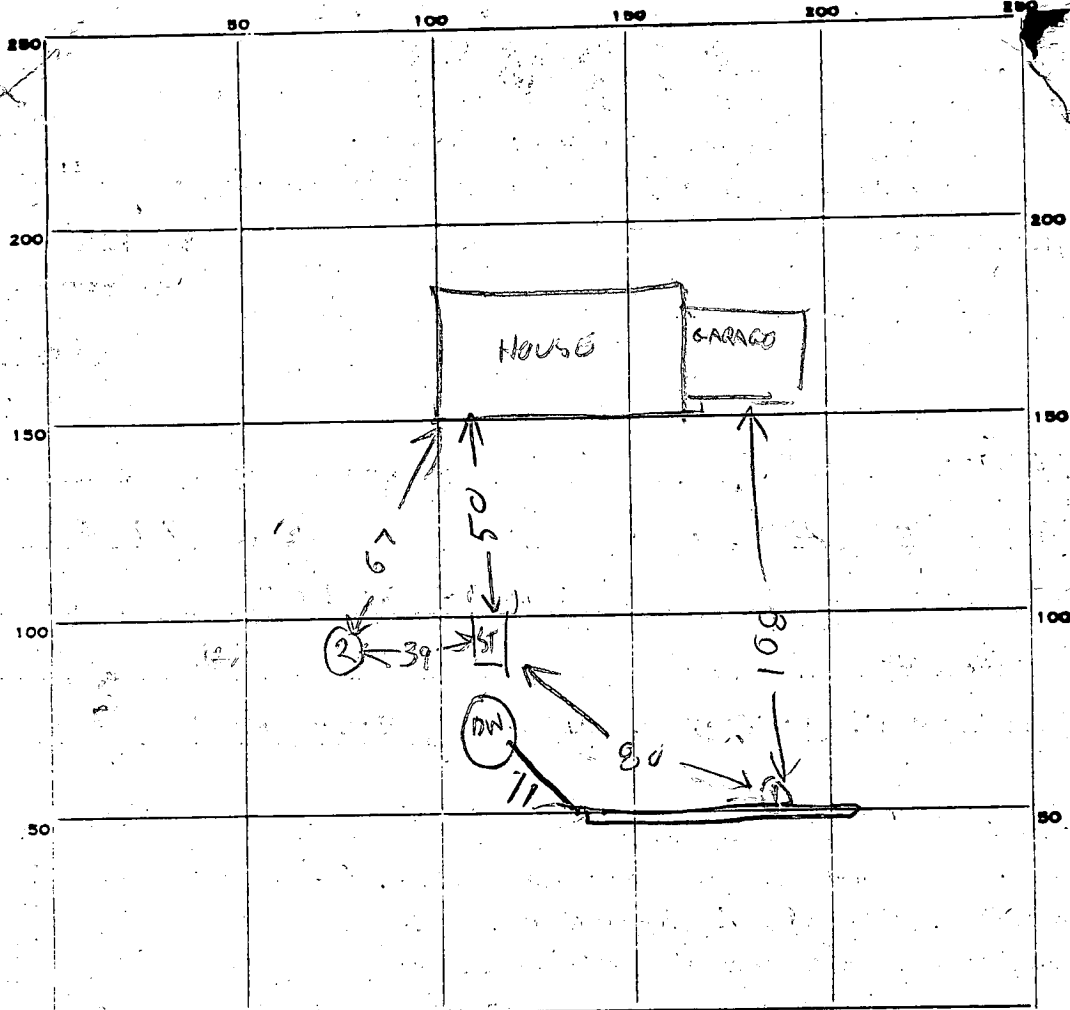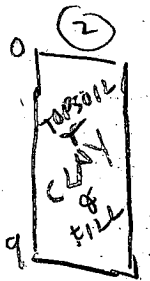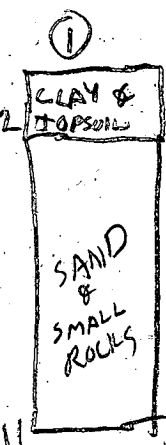

INDICATE NORTH. - NAME ADJOINING ROADWAY AS BASE LINE.

PERMIT CARD \_\_\_\_\_

SEPTIC TANK, LEVEL \_\_\_\_\_ CLEANOUTS \_\_\_\_\_

DISTRIBUTION BOX, LEVEL \_\_\_\_\_

TILE FIELD, DEPTH 9 FT. TRENCH WIDTH 2 FT.

GRAVEL DEPTH 6 FT IN. TOTAL LENGTH 63 FT.

NUMBER OF TRENCHES 1 TOTAL BOTTOM AREA 37.8

SEEPAGE PITS, INSIDE DIAMETER \_\_\_\_\_ FT. DEPTH BELOW INLET \_\_\_\_\_ FT.

ABSORBENT AREA \_\_\_\_\_ SQ. FT.

REMARKS 4/15/82 - TOLD MR ROSE TO HAVE 2 HOLE DUG 50 FT APART & 12 FT DEEP & RESCHEDULE AN APPOINTMENT PM

4/14/82 TWO VISUAL HOLES DUG (1) & (2) INSTALL DITCH PER SPECS ON OTHER SIDE PM

4/15/82 - DITCH DUG. ADD STONE & PIPE & CONNECT TO OLD DW. RH

4/16/82 STONE & PIPE ADDED & CONNECTED TO OLD DW

DATE SYSTEM APPROVED 4/16/82 INSPECTOR Raymond Hodge

(Recall 4/5/82)

Complaint # 2084

Assigned C.B. 9:20

FILE Raw Sewerage Complaint

DATE REPORTED April 2, 1982

PROPERTY OWNER Mr. Rose

↓ *Written on see  
see below!!*


P.O. ADDRESS 5029 Landing Road, Elkridge, Md

TELEPHONE

DIRECTIONS TO PROPERTY

INFORMANT Mrs. Johnson

Mrs. Johnson is complaining about the raw sewerage that is laying on top of the ground, also the odor is unbearable.

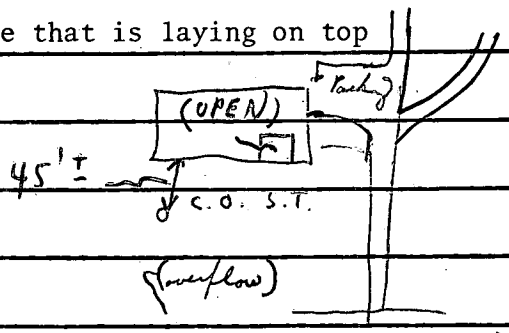

1:00 - 1:30

CONDITION FOUND ↓ 4/2/82 ✓ ed. found - overflowing septic system. Spoke to Mr. Rose - he is to get a septic permit for a repair as soon as possible; Wrote bill 33 4/5/82 P.M. - after ✓ with Mr. Skinner - Note left personal card with <sup>C.B.</sup> Mr. Skinner or Mr. Frommel's name back my card's information. C.B. Wrote Bill "33" 4/5/82

Mr. Rose is @ 8:43 Referred <sup>Not written</sup> him to Mr. Skinner C.B.

ACTION TAKEN Mr. Skinner referred me <sup>+ Mrs. Rose</sup> to Mrs. Smart - C.B.

[ Permit taken out on 4/5/82 P 31860 A-Repair ]

FINAL DISPOSITION