

PERMIT

Approved 6/11/82
Stayer P 31932

SEWAGE DISPOSAL SYSTEM

A Repair

MARYLAND STATE DEPARTMENT OF HEALTH

HOWARD COUNTY

05-371937

6/11/82
Att. Please

ELLICOTT CITY

DISTRICT _____

DATE 5th

INDEX

Jack Fyock IS PERMITTED TO INSTALL _____ ALTER X

ADDRESS 13775 Triadelphia Road, Glenelg, Md. 21737 PHONE 988-9270

SUBDIVISION _____ ROAD 3949 Linthicum Road LOT _____

PROPERTY OWNER Charles White

ADDRESS 3949 Linthicum Road, Glenelg, Md. 21737 Phone: 489-4713

SPECIFICATIONS

SEPTIC TANK CAPACITY _____ GALLONS

DRAIN FIELD _____ DEPTH _____ FEET. BOTTOM AREA _____ SQ. FT.

DEEP TRENCH _____ DEPTH _____ FEET. BOTTOM AREA _____ SQ. FT.

SEEPAGE PITS _____ ABSORBENT SIDE-WALL AREA _____ SQ. FT.

INLET PIPE _____ FT. BELOW ORIGINAL GRADE. MAXIMUM DEPTH _____ FT. BELOW ORIGINAL GRADE

EFFECTIVE DEPTH AT _____ FT. BELOW ORIGINAL GRADE.

LOCATE DISPOSAL AREA _____ FT. FROM _____ LOT LINE AND _____ FT. FROM _____ LOT LINE AS SEEN WHEN FACING LOT FROM

REPAIR - Call for an appointment when ground is opened up and Sanitarian will recommend the repair system.

Trenches 4 to 6 ft deep, 6 ft wide with 3 ft of stone. Add man hole on septic tank.

PLANS APPROVED BY Palmer F. Wine DATE 5/11/82

COVER NO WORK UNTIL INSPECTED AND APPROVED.

NEITHER THE HOWARD COUNTY COUNCIL NOR THE HEALTH DEPARTMENT IS RESPONSIBLE FOR THE SUCCESSFUL OPERATION OF ANY SYSTEM.

NOTE: IF TRENCH IS USED CALL FOR INSPECTION BEFORE PLACING GRAVEL IN TRENCH.

NOTE: NO DRY WELL SHALL EXCEED 15 FOOT IN DIAMETER.


NOTE: ALL PIPE FROM HOUSE TO DISPOSAL AREA MUST BE CAST IRON.

PERMIT VOID AFTER THREE YEARS:

NOTE: INSTALL STAND PIPE ON SEPTIC TANK AND DRY WELL. STAND PIPES MUST BE 6 INCHES IN DIAMETER. CAST IRON, CONCRETE OR TERRA COTTA ACCEPTED.

*INSTALLER IS RESPONSIBLE FOR OBTAINING FINAL APPROVAL ON THIS PERMIT.

K1231932

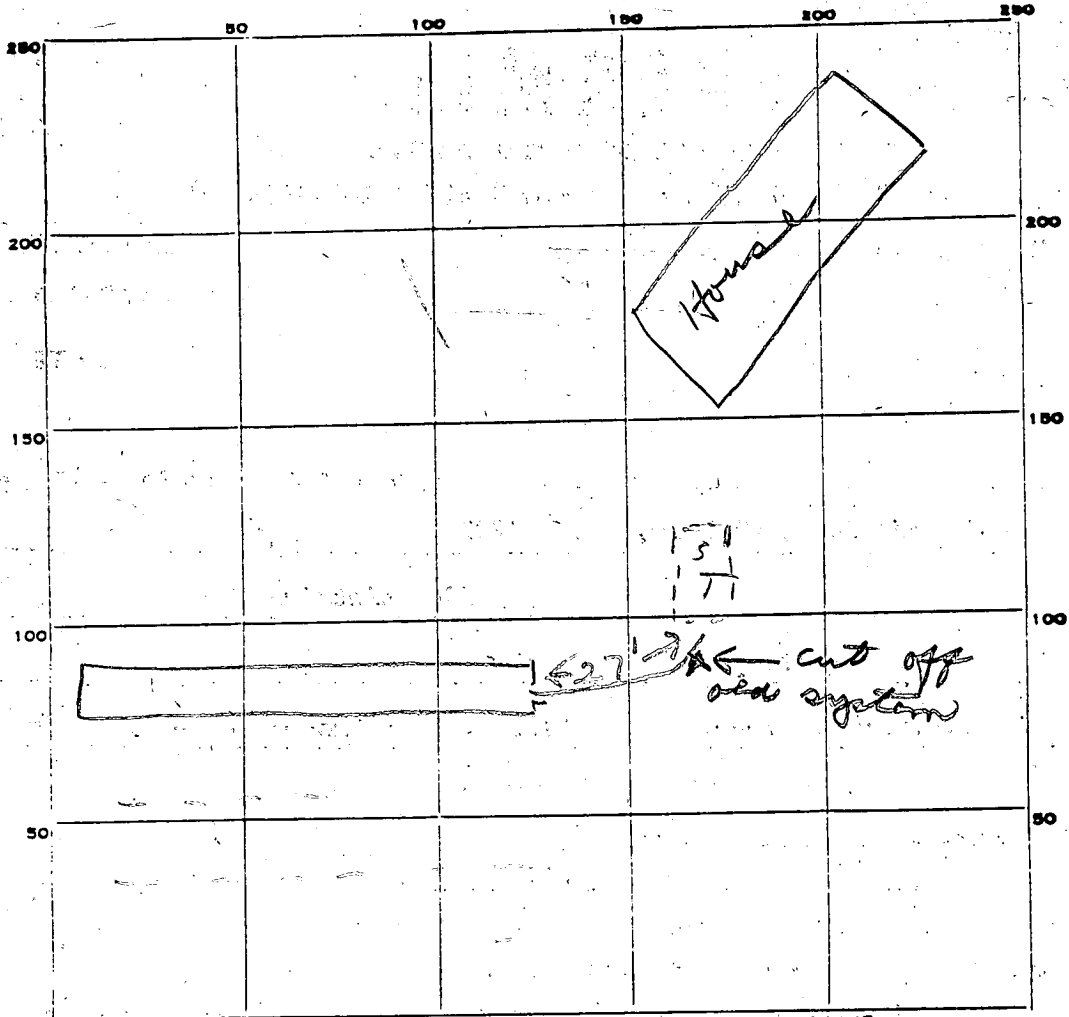

INDICATE-NORTH. - NAME ADJOINING ROADWAY AS BASE LINE.

Penhryn Rd

PERMIT CARD _____

SEPTIC TANK, LEVEL _____

CLEANOUTS ✓

DISTRIBUTION BOX, LEVEL _____

Man hole

TILE FIELD, DEPTH 4' to 6' FT. TRENCH WIDTH 6' FT.

72
6

GRAVEL DEPTH 3 IN. TOTAL LENGTH 72 FT.

NUMBER OF TRENCHES 1 TOTAL BOTTOM AREA 432

SEEPAGE PITS, INSIDE DIAMETER _____ FT. DEPTH BELOW INLET _____ FT.

ABSORBENT AREA 432 SQ. FT.

REMARKS 6/1/82 OK to cover all work. JS & CW

DATE SYSTEM APPROVED 6/1/82

INSPECTOR Stayer