

4/15/66
Leady

PERMIT

SEWAGE DISPOSAL SYSTEM

MARYLAND STATE DEPARTMENT OF HEALTH

HOWARD COUNTY

1166
A 4998-1
1166

ELICOTT CITY

DISTRICT 5

INDEXED

DATE 4/15/66

RPS?

REMOVING EXISTING, 2 IS PERMITTED TO INSTALL 2 ALTER

ADDRESS 10 HENDS DRIVE, ELICOTT CITY, MD. PHONE 88-5-4488

A SEWAGE DISPOSAL SYSTEM LOCATED AT _____

SUBDIVISION Harold ROAD Jerry's Drive LOT 8

PROPERTY OWNER George E. & E. Marie Miller (Mar 5-66)

ADDRESS John Garbart

SPECIFICATIONS 3 bedrooms

DRAIN FIELD _____ DEPTH _____ FEET, BOTTOM AREA _____ SQ. FT.

SEEPAGE PITS _____ ABSORBENT SIDE-WALL AREA _____ SQ. FT.

SEPTIC TANK CAPACITY 775 GALLONS

FOR GARBAGE GRINDER, INCREASE DISPOSAL AREA AND TANK CAPACITY ONE

OTHER THIS TANK WITH 775 sq. ft. of bottom area located 10 ft. from

front property line 10 ft. off the left side, property line on left side

along the 125 foot Jerry's Drive. locate 2-1/2 to 3-00 side portion of lot

as soon as facing Jerry's Drive.

PLANS APPROVED BY JAMES SCHLIGER DATE 4/15/66

FILL SEPTIC TANK AND DISTRIBUTION BOX WITH WATER BEFORE CALLING FOR AN INSPECTION. COVER NO WORK UNTIL INSPECTED AND APPROVED.


NEITHER THE HOWARD COUNTY COMMISSIONERS NOR THE HEALTH DEPARTMENT IS RESPONSIBLE FOR THE SUCCESSFUL OPERATION OF ANY SYSTEM.

BLDG. PERMIT SIGNED
AND RETURNED 4/15/66
Serial # 43883

BLDG. PERMIT SIGNED
AND RETURNED 9/21/66
Serial # 500 102435
additional volume page

1166

A50718B

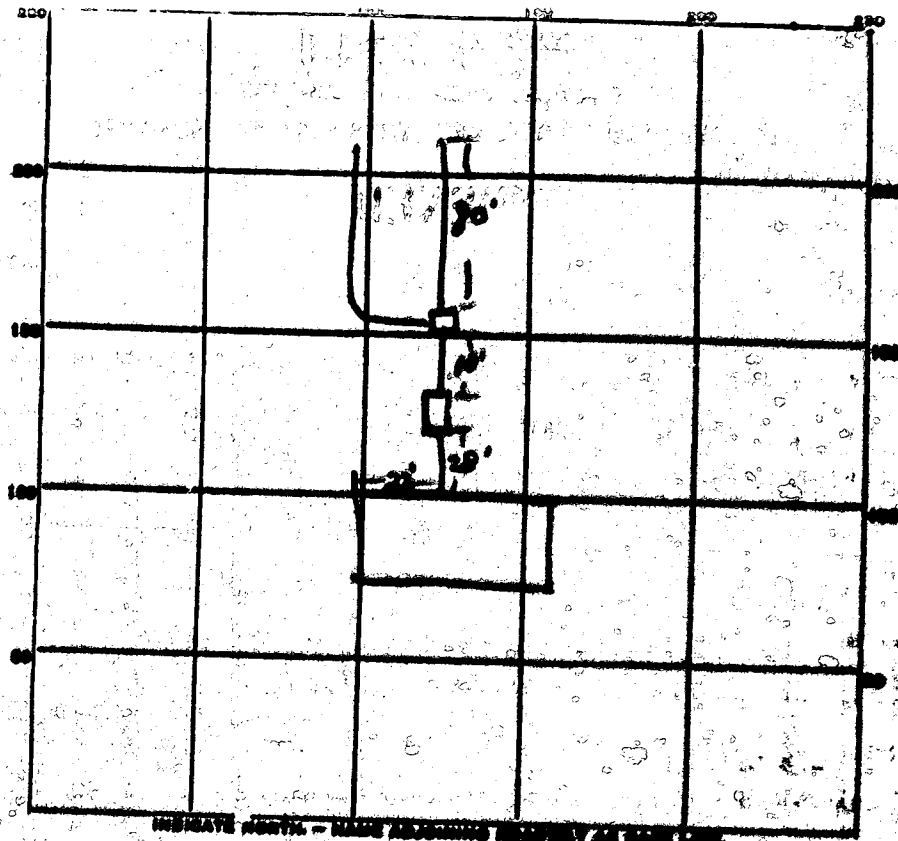

INDICATE NORTH - MAKE ABSORBING READILY AS SHOWN

PERMIT CARD OK

SEPTIC TANK, LEVEL OK CLEANOUTS OK

DISTRIBUTION BOX, LEVEL OK

TILE FIELD, DEPTH 2 FT. TRENCH WIDTH 4 FT.

GRAVEL DEPTH 12 IN. TOTAL LENGTH 155 FT.

NUMBER OF TRENCHES 2 TOTAL BOTTOM AREA 620 sq ft

SERPENTINE PITS, INSIDE DIAMETER _____ FT. DEPTH BELOW INLET _____ FT.

ABSORBENT AREA _____ SQ. FT.

REMARKS _____

DATE SYSTEM APPROVED 4/15/68 INSPECTOR JH Kilmer

APPLICATION

SEWAGE DISPOSAL TESTING

A 09327

P _____

MARYLAND STATE DEPARTMENT OF HEALTH

HOWARD COUNTY

ELLICOTT CITY

DISTRICT 5

DATE 10/28/64

*Take field with 375 sq. ft. of lot area
exp. limited 195 ft. from the front property
line and 80 ft. from left side of lot. This is
area where facing the lot from Jerry's Drive. Front
field on left side of lot of lot to be seen when facing
Jerry's Drive.*

750 gal. system tank

TO: THE COUNTY HEALTH OFFICER
ELLICOTT CITY, MARYLAND

I, HEREBY, APPLY FOR THE NECESSARY TESTS IN ORDER TO CONSTRUCT (OR RECONSTRUCT) A SEWAGE DISPOSAL SYSTEM.

PROPERTY OWNER George H. & E. Marie Miller

ADDRESS _____ PHONE _____

PROPERTY LOCATION:

SUBDIVISION Basilar LOT NO. B. Sec. 2

ROAD AND DESCRIPTION Jerry's Drive

OCCUPANT _____ PHONE _____

PERSON TO CONSTRUCT SYSTEM _____

ADDRESS _____ PHONE _____

SIZE OF LOT 1.6289 acres TYPE BLDG. 1

IF NOT SINGLE RESIDENCE DESCRIBE _____

SIGNATURE OF APPLICANT Ronald J. York agent for James E. Duff


APPROVED BY James Horgan FOR Take field DATE 11-6-64

REJECTED BY _____ FOR _____ DATE _____

HOLD PENDING FURTHER TESTS _____ DATE _____

REASONS FOR REJECTION OR HOLDING _____

THIS IS NOT A PERMIT

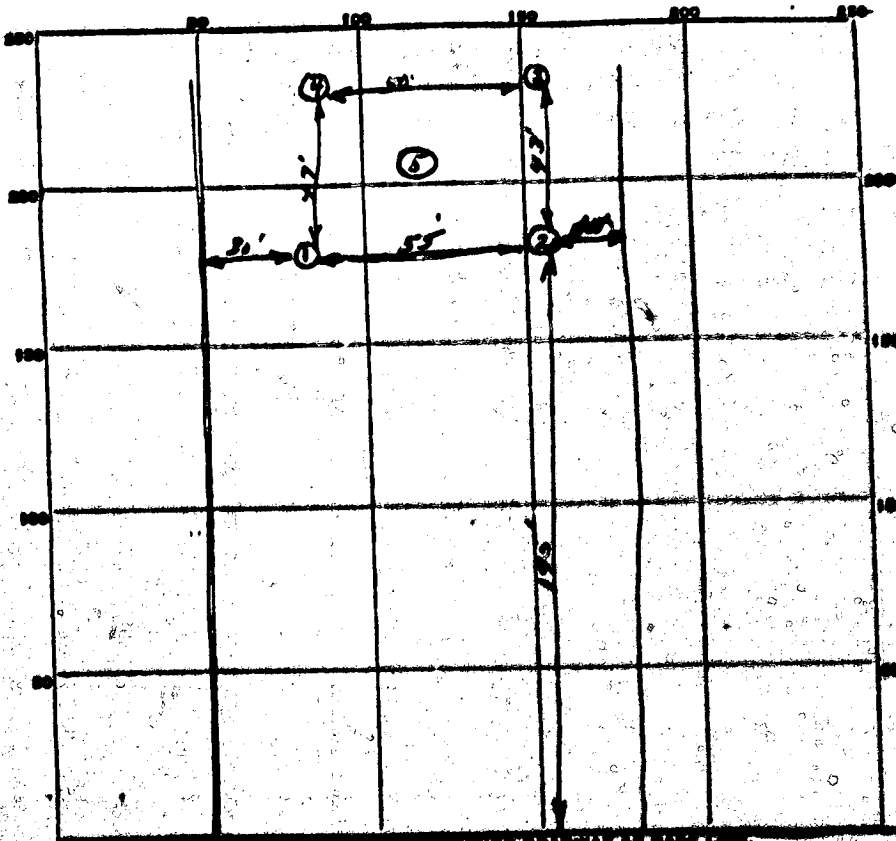

INDICATE NORTH - WITH MEASURING ARROW AT EACH END.

Jerry's Drive

DATE	TEST NO.	DEPTH	PRE-WET		TEST + 1" DROP		TIME
			START	STOP	START	STOP	
11-6-64	1	3	9:57	9:55	9:55	10:01	6 3/4 min.
	2		10:05	10:49	overline		
	3		10:10	10:18	10:18	10:43	25 min.
	4		10:23	10:31	10:31	10:46	14 min.
	5	9	10:34	10:39	10:39	10:46	7 min.

SOIL AUGER FINDING _____

TESTED BY AH

REMARKS Signatures on left side 195' from front.

11-6-64
ALSO PRESENT [Signature] LOT NO. 8 1/2

THIS REPORT
MUST BE SUBMITTED
WITHIN 30 DAYS
AFTER COMPLETION
OF THE WELL

WELL COMPLETION REPORT

WELL DESCRIPTION

WELL LOG
State the kind of formations penetrated, their color, their depth, their thickness, and if water-bearing

CASING AND SCREEN RECORD
State the kind and size and position of casing, liner, shoe, screen, and other accessories (if no casing used, give diameter of well).

Sand & Clay 0-12
Granit. 12-30

Black Steel 5 9/8 00 1/8

15700...
Address
Subdivision
Section


PUMPING TEST
Hours Pumped
Type of Pump Used
Pumping Rate
Gallons per Minute

WATER LEVEL
Distance from land surface to water:
Before Pumping
When Pumping

APPEARANCE OF WATER
Clear Cloudy
Taste
Odor

Height of Casing Above Land Surface
PUMP INSTALLED
Type
Capacity
Gallons per Minute
Gallons per Hour
Pump Column Length


LOCATION OF WELL ON LOT
Show permanent structures such as building(s), septic tank, and/or other landmarks and indicate not less than 2 distances (measurements) to well

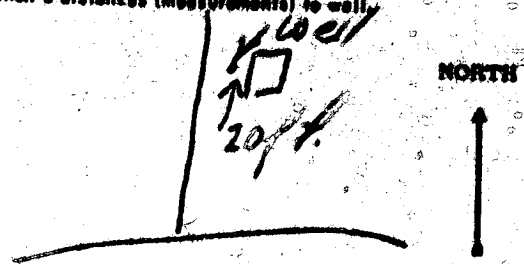

Date Well Was Completed April 1966

Well Driller Ernest H. Hockley
Signature

JERRY'S DRIVE

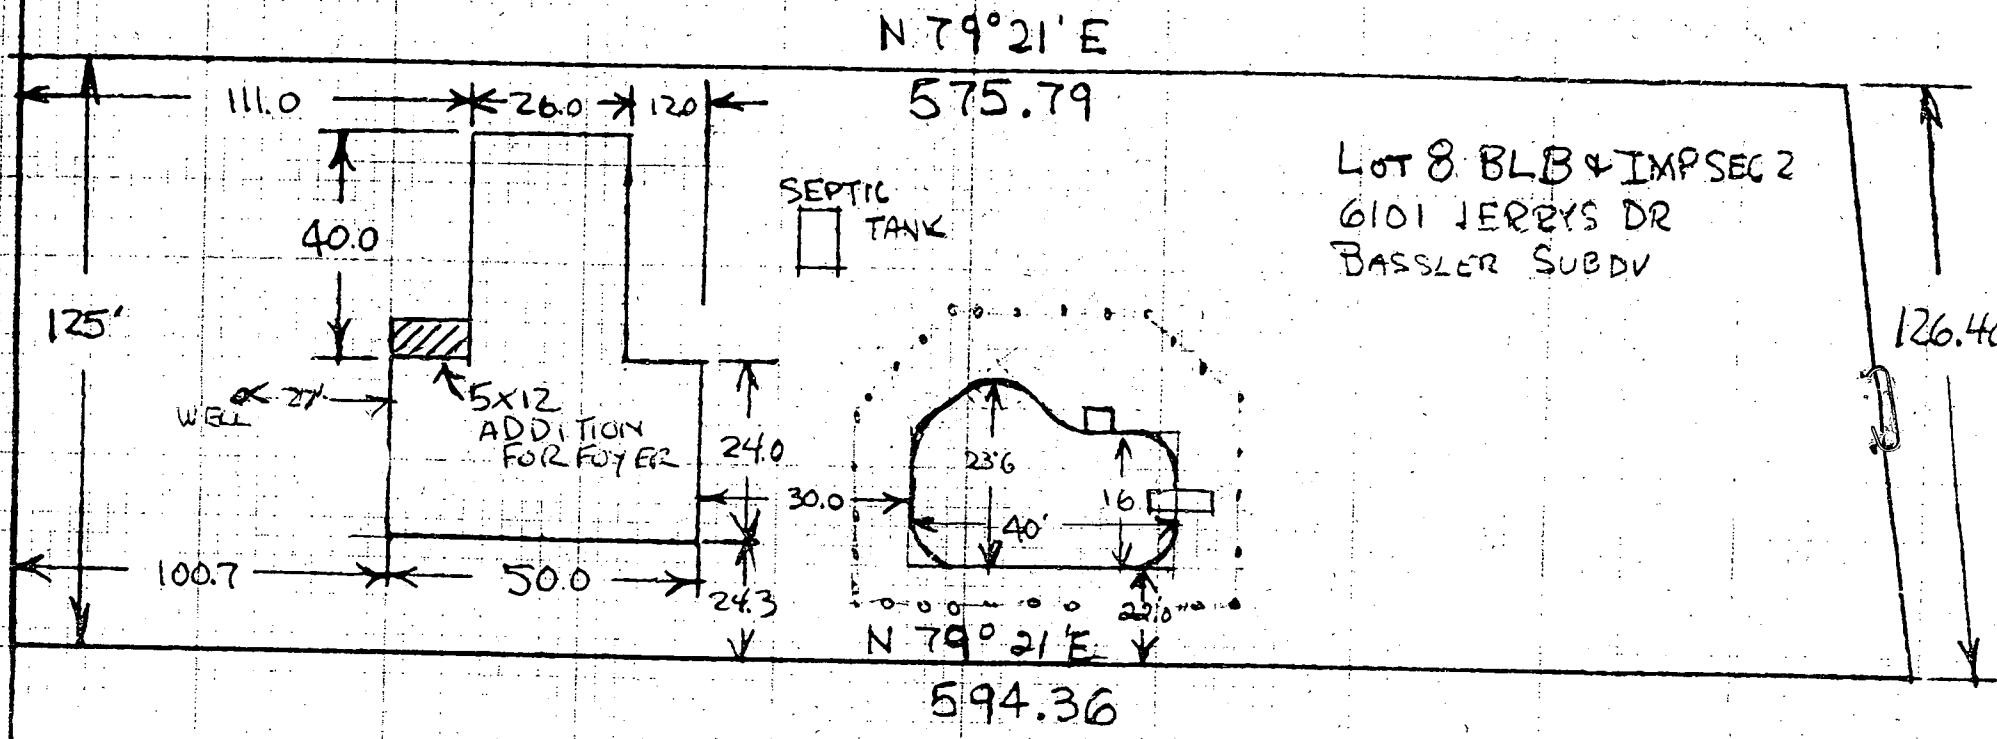


$N 79^{\circ} 21' E$

575.79

LOT 8 BLB & IMP SEC 2
6101 JERRY'S DR
BASSLER SUBDV

126.40

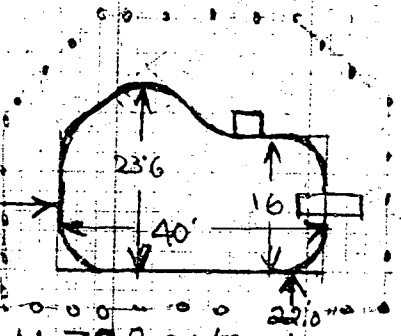

$N 79^{\circ} 21' E$

594.36