

FUTURE IMPROVEMENTS TO MD 32, IVORY EAST RD AND INTERCHANGE BASED ON S.H.A. PLANS DATED 4/6/98

PROPERTY OF VICHITH LONG L.3301 F.52 P.37 RR-DEO

458

OF FUTURE ROW DATED FROM

FUTURE SHA R.O.W.

FUTURE SHA R.O.W.

RESERVATION PARCEL "A" FOR FUTURE S.H.A. ROAD RIGHT-OF-WAY AREA 35,745 sq. ft. (0.82 ac. ±)

PC Sta. 0+48.82

PT Sta. 1+04.03


E 1,316,500

N 588,500

PO-04 signed 7/31/02

EXISTING BARN TO BE REMOVED

TRAFFIC CALMING SHEET DEVICE SEE FOR DETAIL

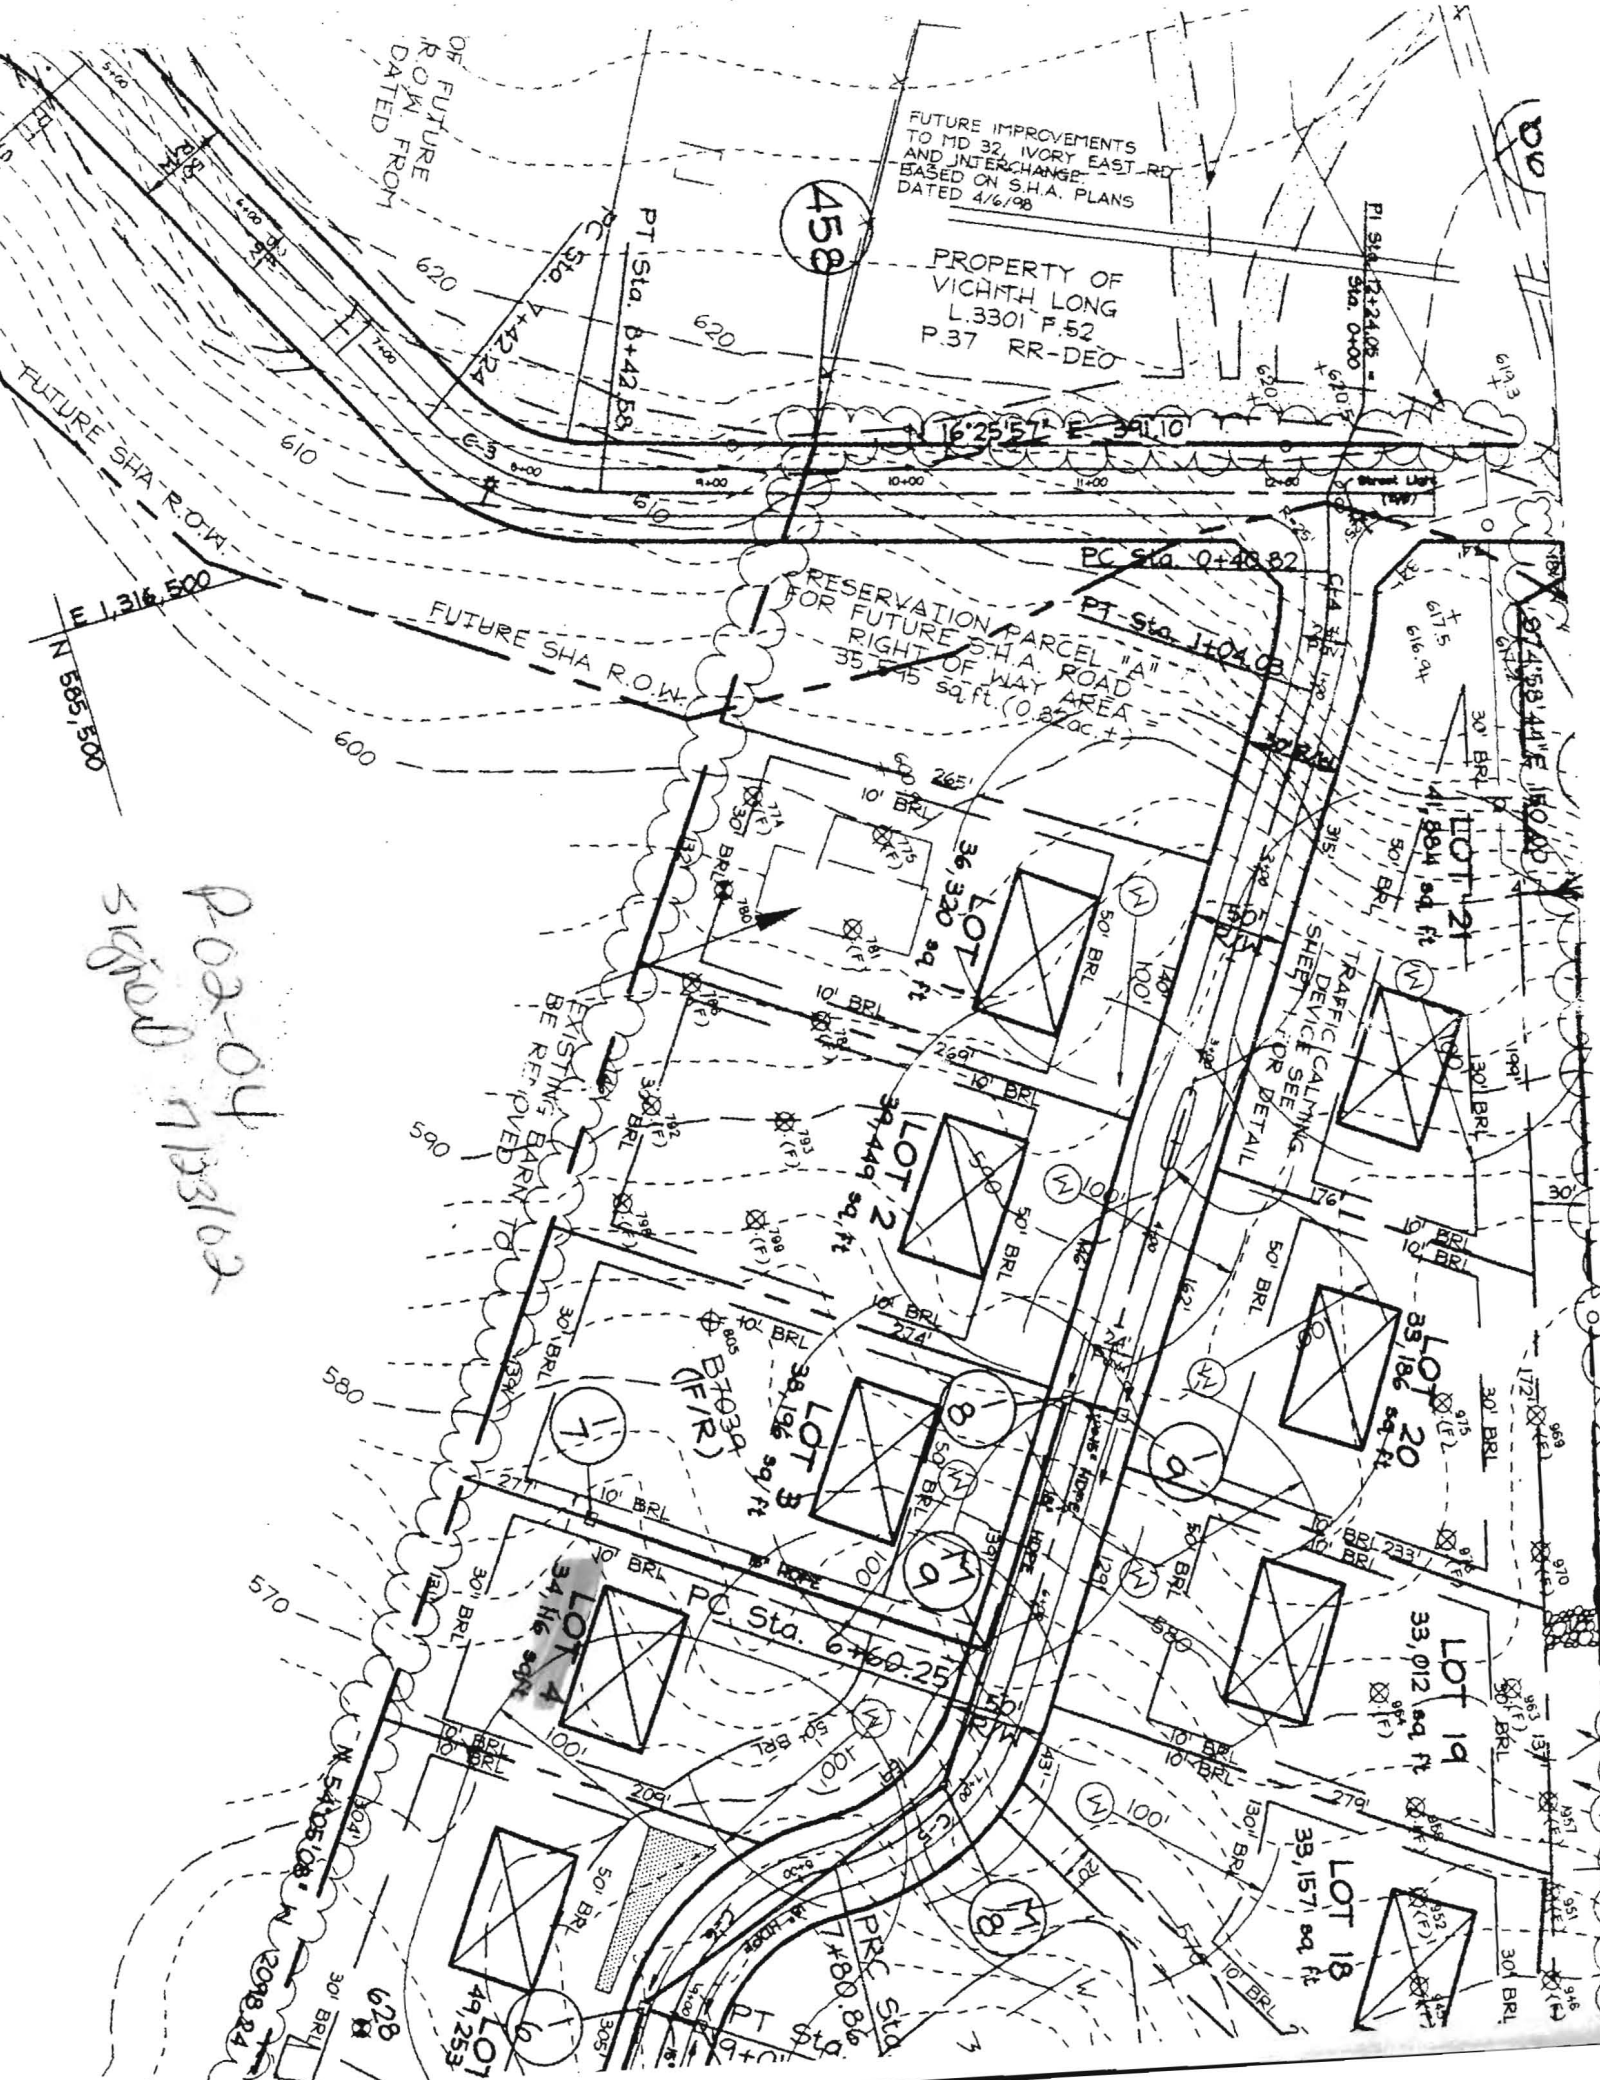

620

610

600

590

580

570

628

PT Sta. 8+42.58

36,320 sq. ft.

39,449 sq. ft.

38,196 sq. ft.

34,116 sq. ft.

49,253

PI Sta. 12+24.05

Sta. 0+00

617.5

50' BRL































































































































































































































































































