

515227A

COUNTY #

SOIL PROFILE  
616/616A


0'  
orange-brown clay loam  
3'  
tan-fine sandy loam  
5-10% ROCK FRAGS  
13'

618

4'  
orange-brown clay loam  
tan fine-sandy loam  
5-10% ROCK FRAGS  
13'

615

5'  
orange-brown clay loam  
tan fine-sandy loam  
5-10% ROCK FRAGS  
13'

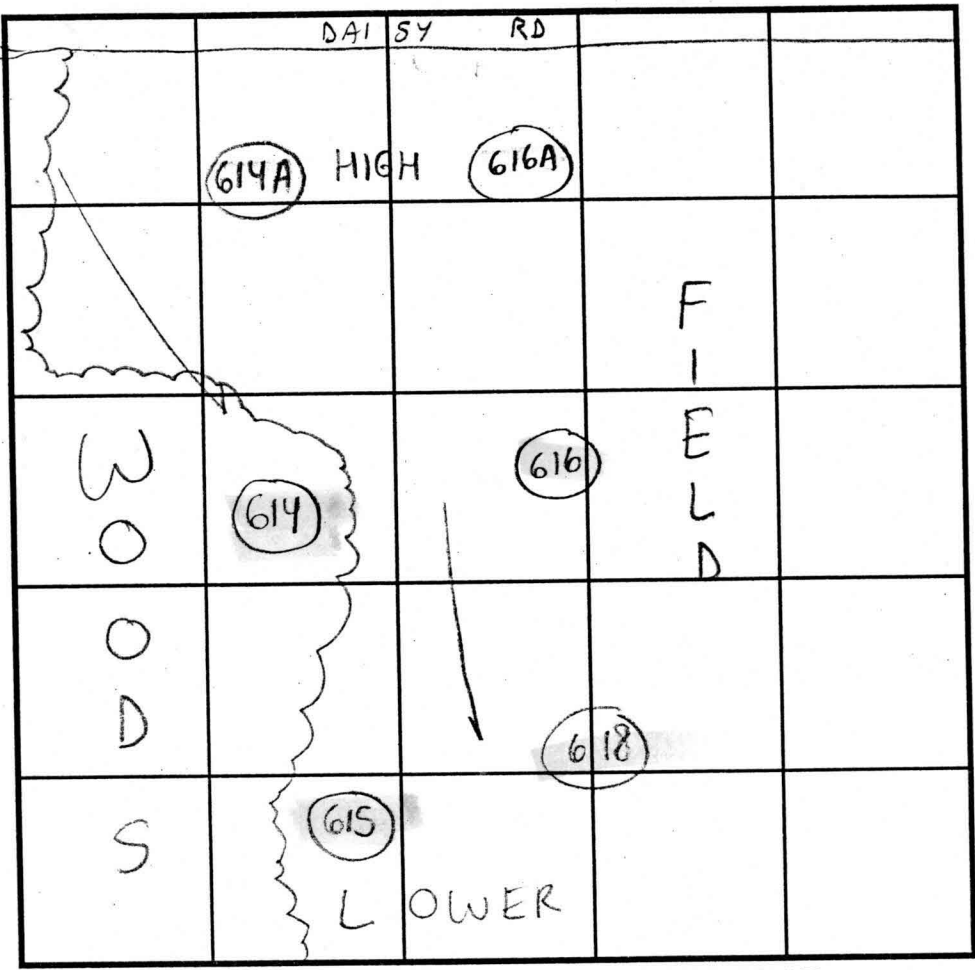

INDICATE NORTH - NAME ADJOINING ROADWAY AS BASE LINE.

SOIL PROFILE  
614/614A

0'  
Orange-brown clay loam  
5'  
tan-fine-sandy loam  
10-20% ROCK FRAGS  
13'

DATE	TEST NO.	DEPTH	PRE-WET		TEST - 1" DROP		TIME	
			START	STOP	START	STOP		
7/27/01	616	3' <sup>T</sup> / 13' <sup>V</sup>	4:30pm	4:32pm	4:32pm	4:34pm	2min	OK
	618	13' <sup>V</sup>	(VISUAL OK SEE SOIL PROFILE)					OK
	615	6' <sup>T</sup> / 13' <sup>V</sup>	4:34pm	4:37pm	4:37pm	4:40pm	3min	OK
	614	13' <sup>V</sup>	(VISUAL OK SEE SOIL PROFILE)					OK
8/6/01	614A	13' <sup>V</sup>	"	"	"	"	"	OK
	616A	5' <sup>T</sup> / 13' <sup>V</sup>	12:12pm	12:14pm	12:14pm	12:17pm	3min	OK

REMARKS \_\_\_\_\_  
 TYPE OF SOIL Chester  
 TESTED BY SRU ALSO PRESENT Chuck Sharp  
 TRENCH DESIGN DATA: AVERAGE PERCOLATION TIME 3min TRENCH WIDTH 3'  
 INLET DEPTH 3' MAXIMUM BOTTOM DEPTH 5' SQ. FT./BEDROOM 180



N 05°37'00" E  
N 02°41'39" E  
N 01°36'51" E  
171.74  
3/4" = 10'  
(NEEDS FOR LINE)

RECTED

1  
47,710sf  
75'BRL

614A  
Proposed Septic Easement  
10,073sf  
30'BRL

3  
CHA  
44,378sf  
75'BRL

4  
53,112sf  
75'BRL

SIGNED  
GIB2 PERC  
CRAJ

EKB2

2  
42,019sf  
50'BRL  












MID2  
671A  

G1C3  
672  
673  
6  
MID3  
42,276sf  
100'BRL



SWM NON-BUILDABLE  
PRESERVATION  
PARCEL  
2.250ac HOA OWNED  
AND MAINTAINED

SWM A POND  
1" CLASS

20  
58,578sf  
100'BRL

7  
43,057sf  
100'BRL

8  
43,196sf  
100'BRL











F-02-122

SIGNED 8/26/03

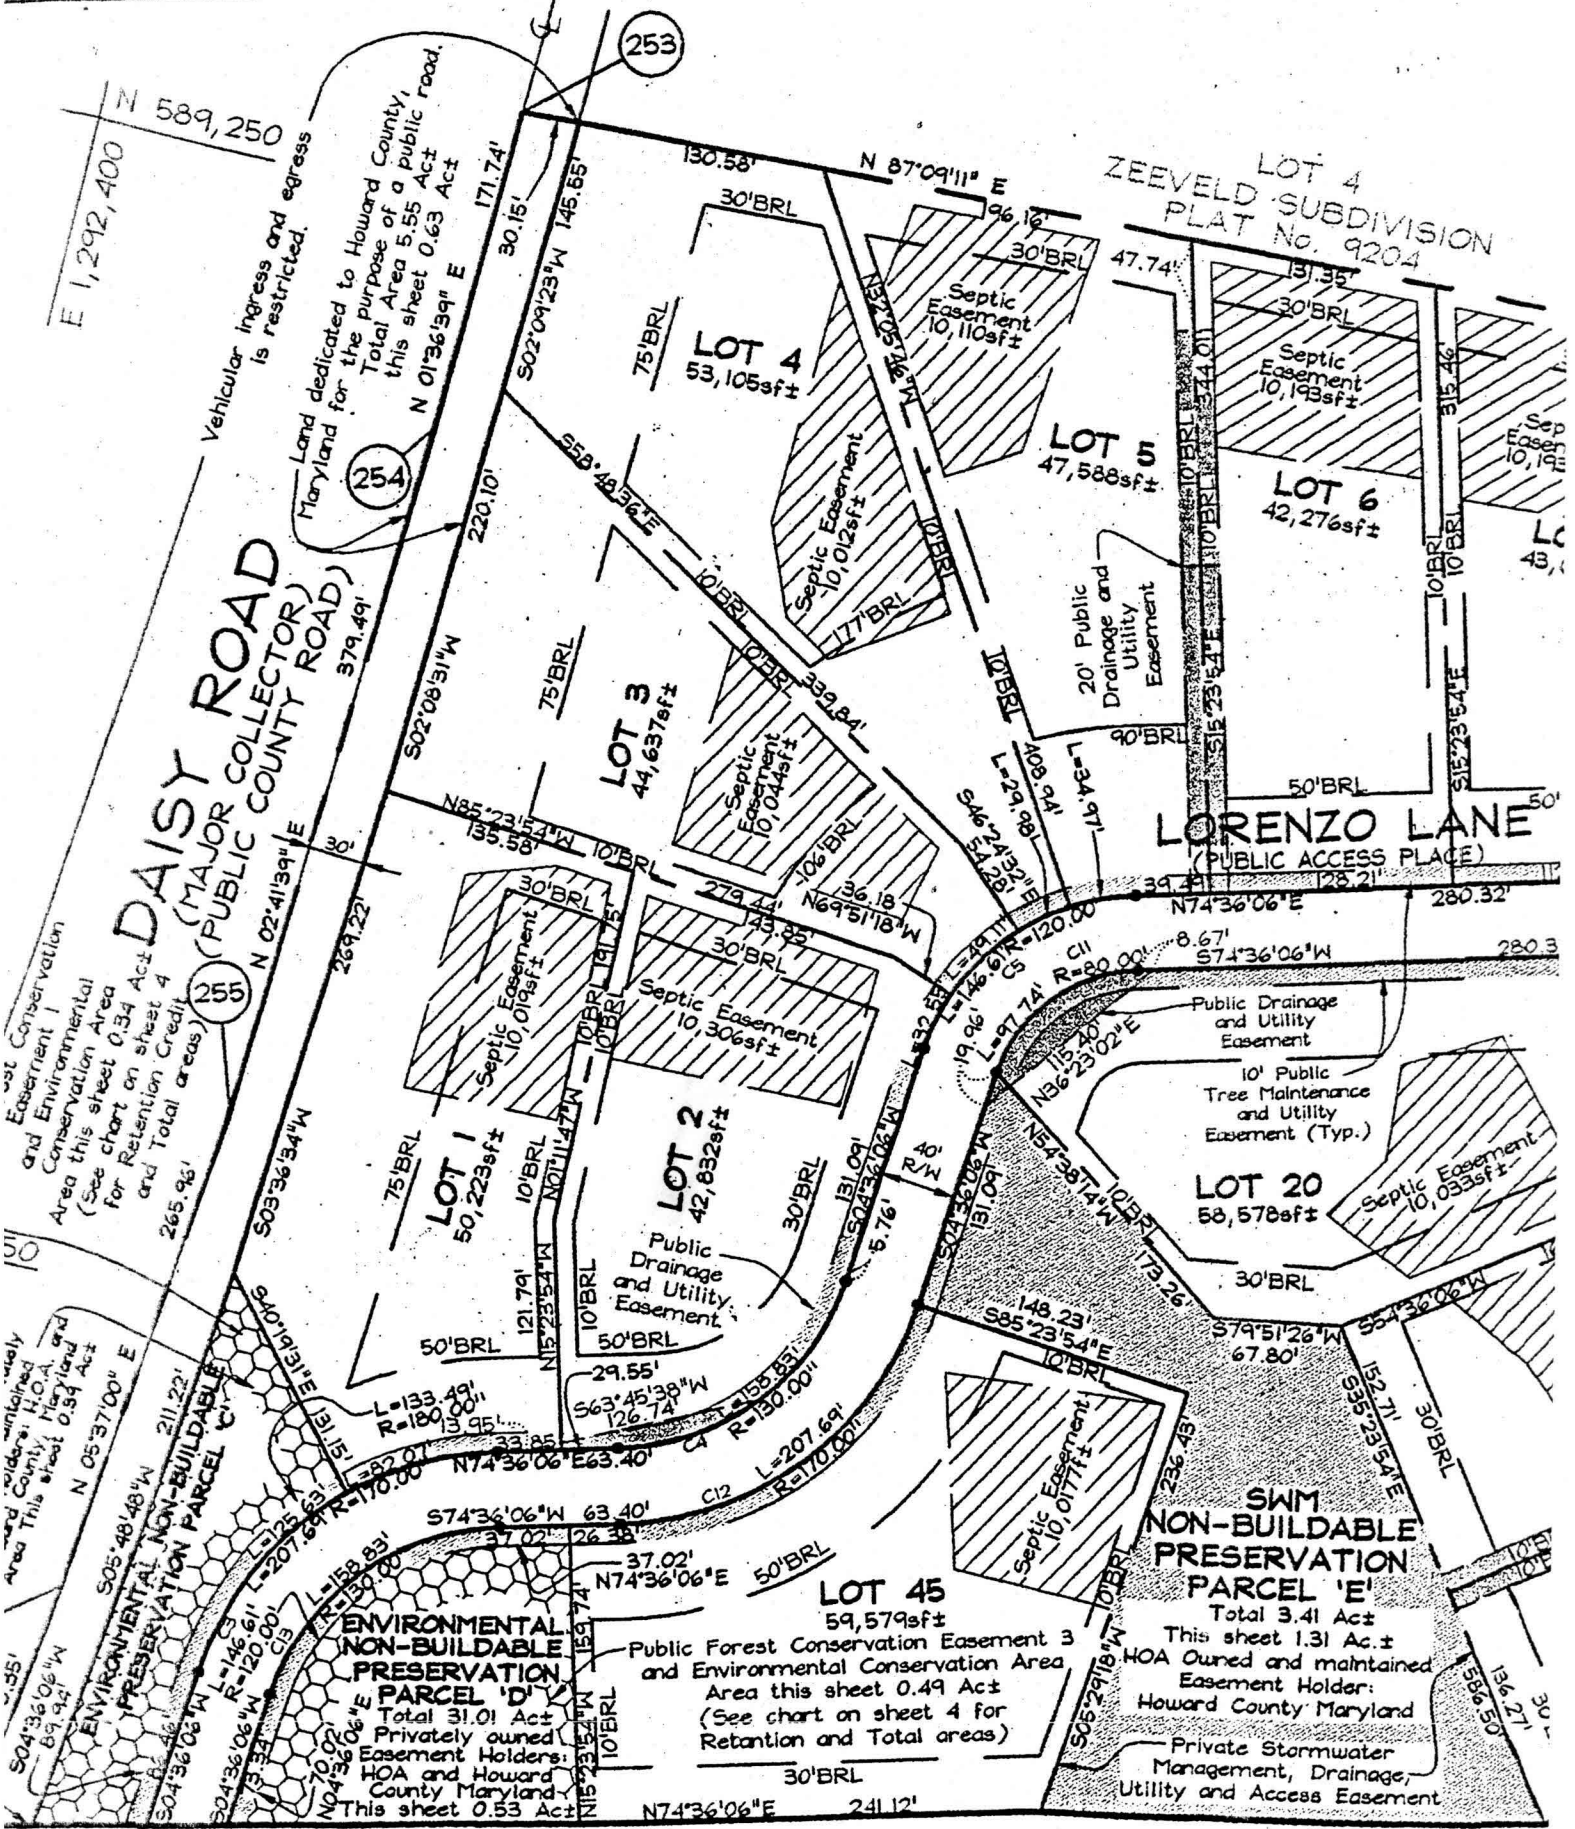

Conservation  
Easement 1  
and Environmental  
Conservation Area  
(See chart on sheet 4  
for Retention Credit  
and Total areas)

Area this sheet 0.54 Act  
and Total areas

Environmental Non-Buildable  
Preservation Parcel 'D'  
Total 31.01 Act  
Privately owned  
Easement Holders:  
HOA and Howard  
County Maryland  
This sheet 0.53 Act

Vehicular ingress and egress  
is restricted.

Land dedicated to Howard County,  
Total Area 5.55 Act  
this sheet 0.63 Act

DAISY ROAD  
(MAJOR COLLECTOR)  
(PUBLIC COUNTY ROAD)

LOT 1  
50,223sf±

LOT 2  
42,832sf±

LOT 3  
44,637sf±

LOT 4  
53,105sf±

LOT 5  
47,588sf±

LOT 6  
42,276sf±

ENVIRONMENTAL  
NON-BUILDABLE  
PRESERVATION  
PARCEL 'D'





LOT 20  
58,578sf±

LOT 45  
59,579sf±

Septic Easement  
10,110sf±

Septic Easement  
10,012sf±

Septic Easement  
10,193sf±

Septic Easement  
10,044sf±

Septic Easement  
10,019sf±

Septic Easement  
10,306sf±

Septic Easement  
10,033sf±

Septic Easement  
10,017sf±

20' Public  
Drainage and  
Utility  
Easement

10' Public  
Tree Maintenance  
and Utility  
Easement (Typ.)

Public Forest Conservation Easement 3  
and Environmental Conservation Area  
Area this sheet 0.49 Act  
(See chart on sheet 4 for  
Retention and Total areas)

Private Stormwater  
Management, Drainage,  
Utility and Access Easement

ZEEVELD SUBDIVISION  
PLAT No. 9204





















