

AMB119

October 7, 1985

Mr. Pat Kearney  
14577 MacClintock Drive  
Glenwood, Maryland 21738

Dear Mr. Kearney:

The water sample recently submitted for testing was free of coliform and fecal coliform bacteria at the time of sampling and is bacteriologically safe for drinking.

FINAL CERTIFICATE OF POTABILITY

This certifies that all sampling requirements of COMAR 10.17.23 "Well Regulations" have been met for the water supply system installed under permit(s) HO-81-0161.


September 23, 1985  
Date of Final Sampling

September 27, 1985  
Date of Acceptance

Craig Williams  
Craig Williams, Director  
Water and Sewerage Program

CW/JS:JR

Well Approved: 9/19/85  
Septic Approved: 7/30/85  
Water Sample Dates: 7/25/85  
9/23/85

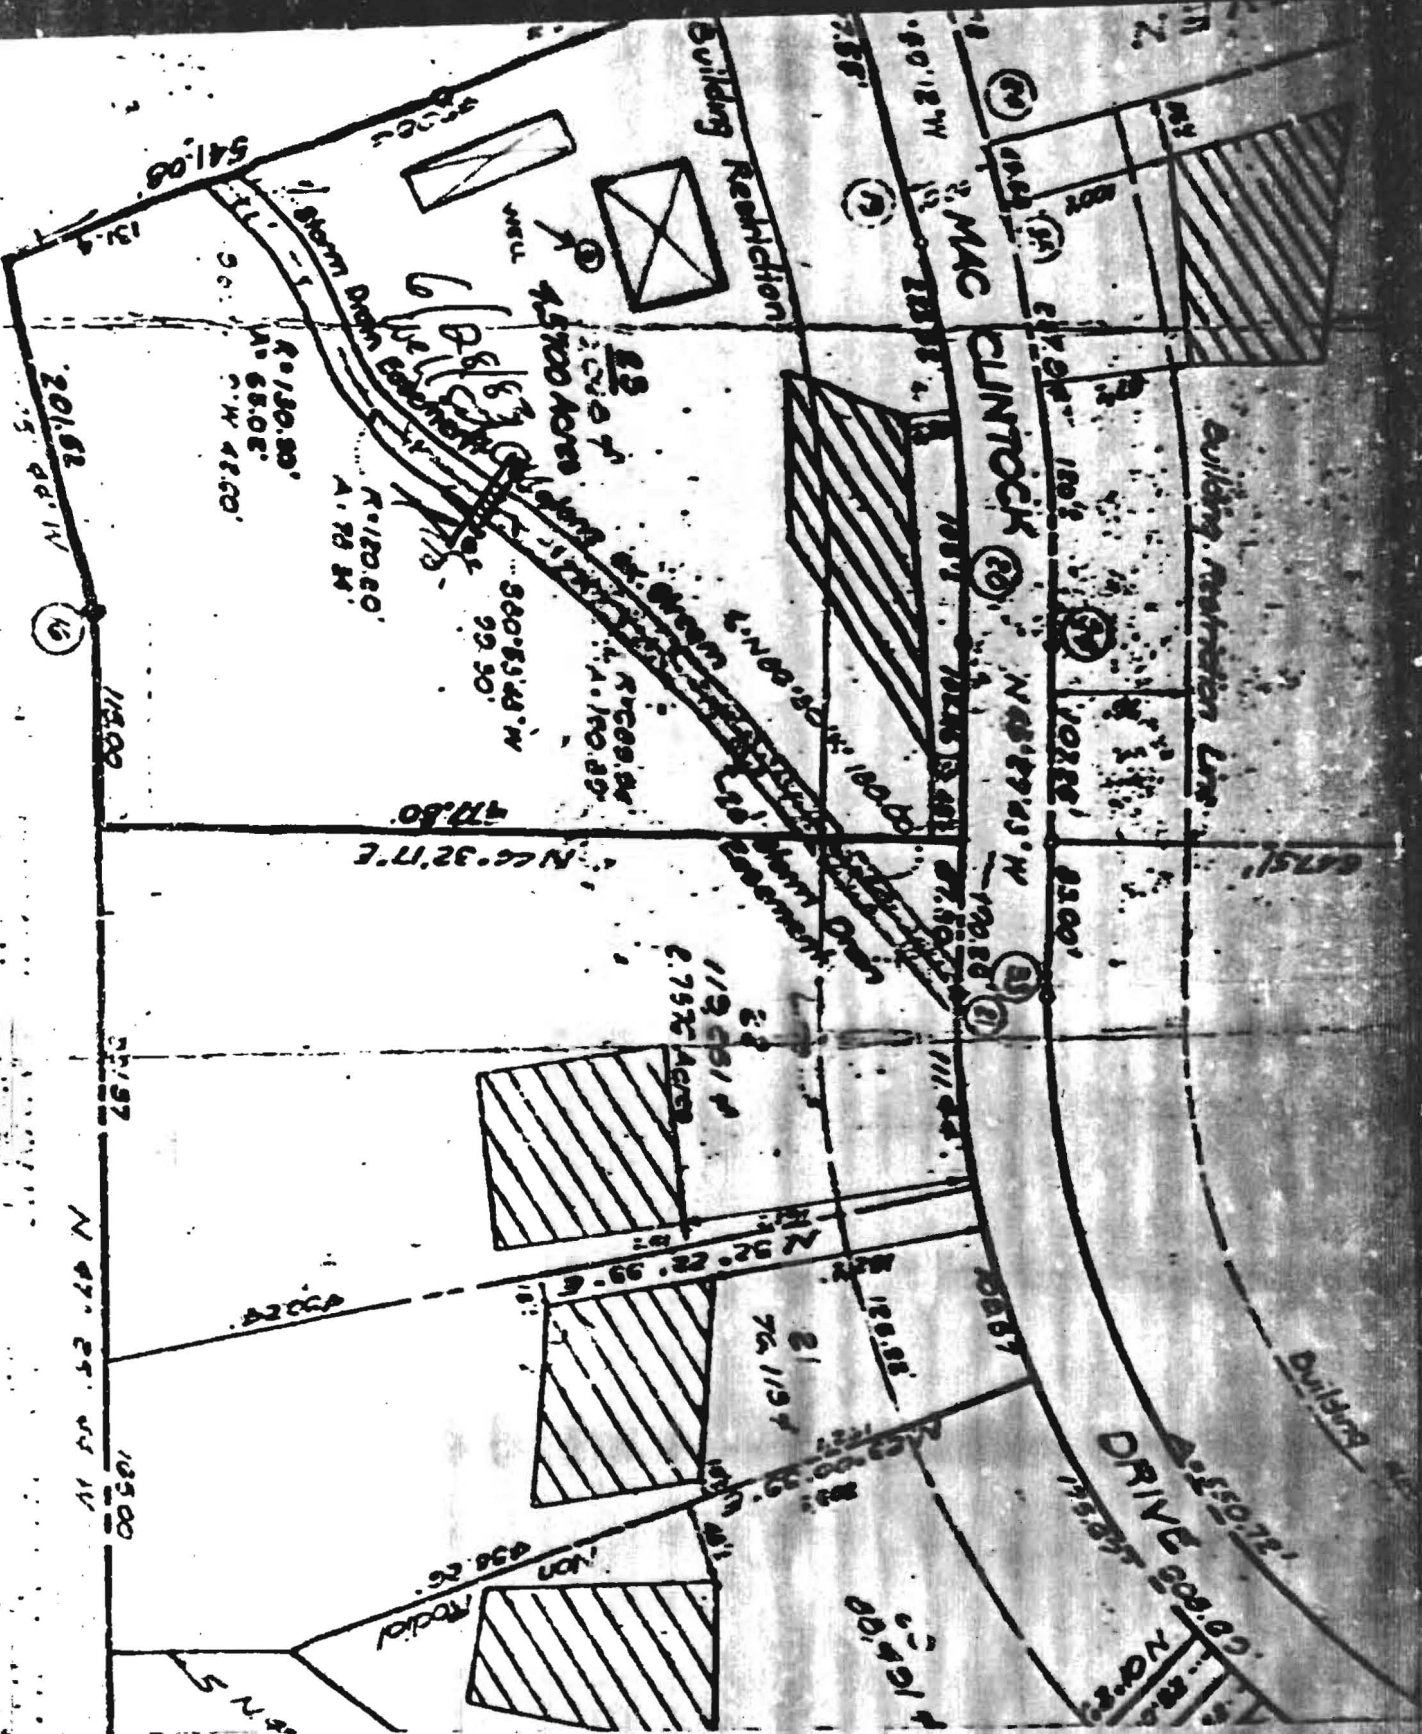

201.51

118.00

37.97

105.00

541.06

R.130.80'  
A. 58.02'  
S.W. 42.00'

R.120.60'  
A. 78 M'

N 46° 32' 17" E  
471.80'

119.51 ft  
6.7576 Acres

76.11 ft

938.26'

MAC CLINTOCK

N 48° 27' 43" W  
100.80'

100.80'

100.80'

DRIVE 209.00'

209.00'

A15119

DATE RECEIVED [ ] [ ] [ ] [ ] [ ] [ ] DATE WELL COMPLETED **07/17/99** PERMIT NO. **HO-87-0727**

OWNER **Kearney**  
STREET OR RFD **MacArthur & Deane**  
SUBDIVISION **Warfield Estate** SECTION **C3** LOT **235**

**WELL LOG**  
Not required for driven wells

STATE THE KIND OF FORMATIONS PENETRATED, THEIR COLOR, DEPTH THICKNESS AND IF WATER BEARING

DESCRIPTION (use additional sheets if needed)	FEET		Cases of open boring
	FROM	TO	
Top soil	0	2	
Dark silty	2	11	
Reddish silty	11	16	
Black silty	16	75	
Dark silty	75	90	
Black silty	90	145	

**WELL HAS BEEN DRILLED**  
Circles appropriate size

TYPE OF GROUTING MATERIAL  
CEMENT  PORTLAND CEMENT  OTHER

NO. OF BAGS **3** NO. OF BUCKETS **11**

GALLONS OF WATER **11**

DEPTH OF GROUT SEALING **11**

WATER TABLE SURFACE

SCREEN TYPE:  ST  BC  OTHER

