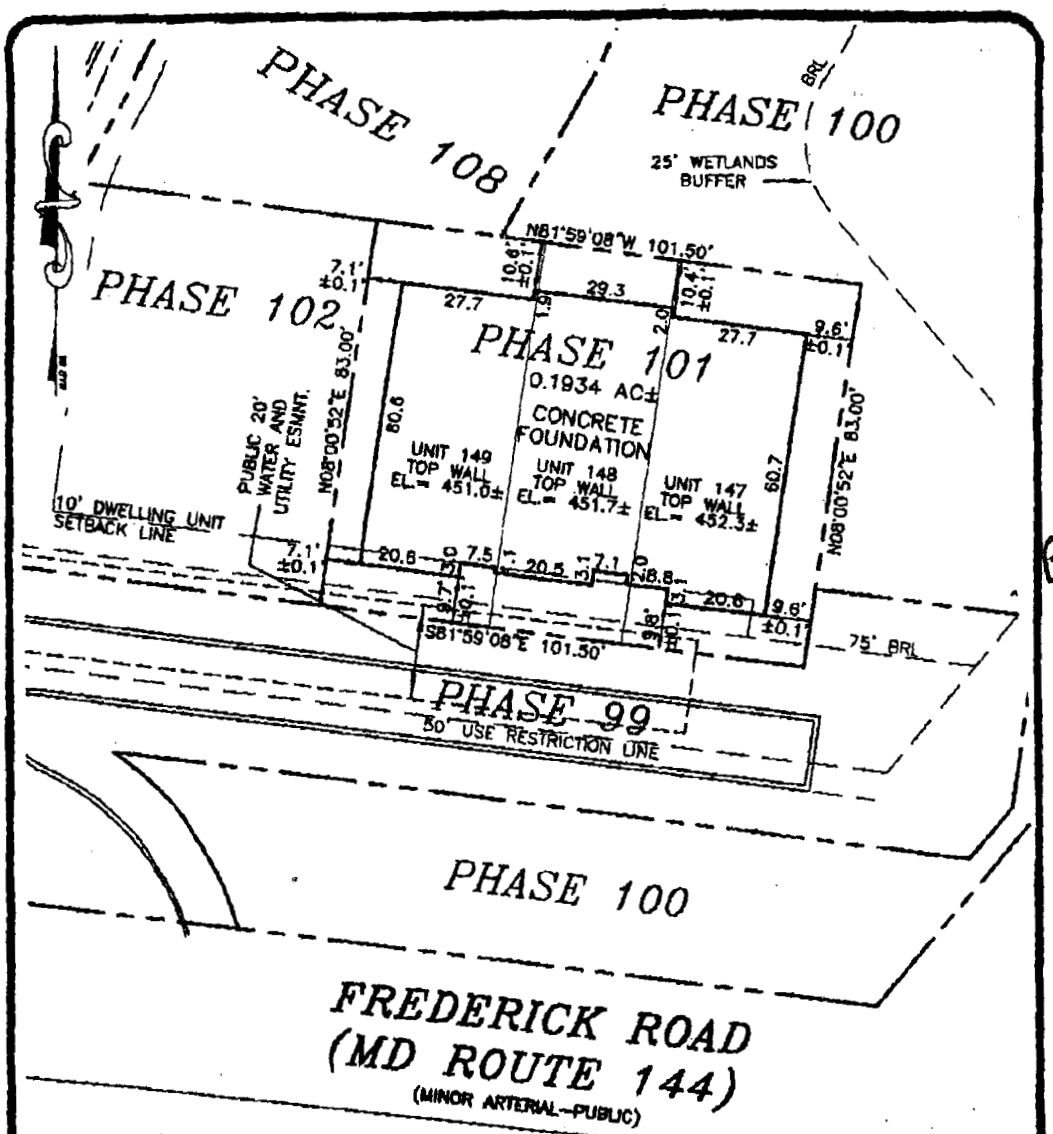

ADDRESS No. Unit 147: 3014 JOHN BERNARD DRIVE
ADDRESS No. Unit 148: 3012 JOHN BERNARD DRIVE
ADDRESS No. Unit 149: 3010 JOHN BERNARD DRIVE

ELLICOTT MEADOWS CONDOMINIUM ASSOCIATION, INC.

RECORD PLATS 18496-18500
CONDOMINIUM PLATS 17688-17690
UNITS 147-149
ELECTION DISTRICT No. 3
HOWARD COUNTY, MARYLAND

THE INFORMATION SHOWN HAS BEEN ESTABLISHED BY CURRENT ACCEPTABLE SURVEY PROCEDURES AND FROM AVAILABLE RECORD INFORMATION. THIS DRAWING IS TO BE USED FOR TITLE TRANSFER FINANCING, OR REFINANCING ONLY AND IS NOT TO BE USED FOR THE ESTABLISHMENT OF PROPERTY LINES, LOCATION OF FENCES, GARAGES, BUILDINGS, OR OTHER EXISTING OR FUTURE IMPROVEMENTS.

MILDENBERG BOENDER, & ASSOC., INC.
Engineers Planners Surveyors
5072 Dorsey Hall Drive, Suite 203, Ellicott City, Maryland 21042
(410) 997-0296 Balt. (301) 621-5521 Wash. (410) 997-0298 Fax.

STATE OF MARYLAND GREGORY SCOTT SHANABERGER PROFESSIONAL LAND SURVEYOR No. 10849

G. SCOTT SHANABERGER
PROF. LAND SURVEYOR
MARYLAND No. 10849

FOUNDATION	DATE: 06/02/08	FINAL	DATE:
DRAWN BY: MES	CHECKED BY: GSS	SCALE: 1" = 30'	
PROJECT NO.: 07-014	LOCATION DRAWING		

H:\04-085\DWG\85-WALLCHECKS.DWG

B07 002639
40
41

3010 John Bernard Drive
12 "
14 "

3123-7A
25-B
25-9A
31-B

ok
6/12/08