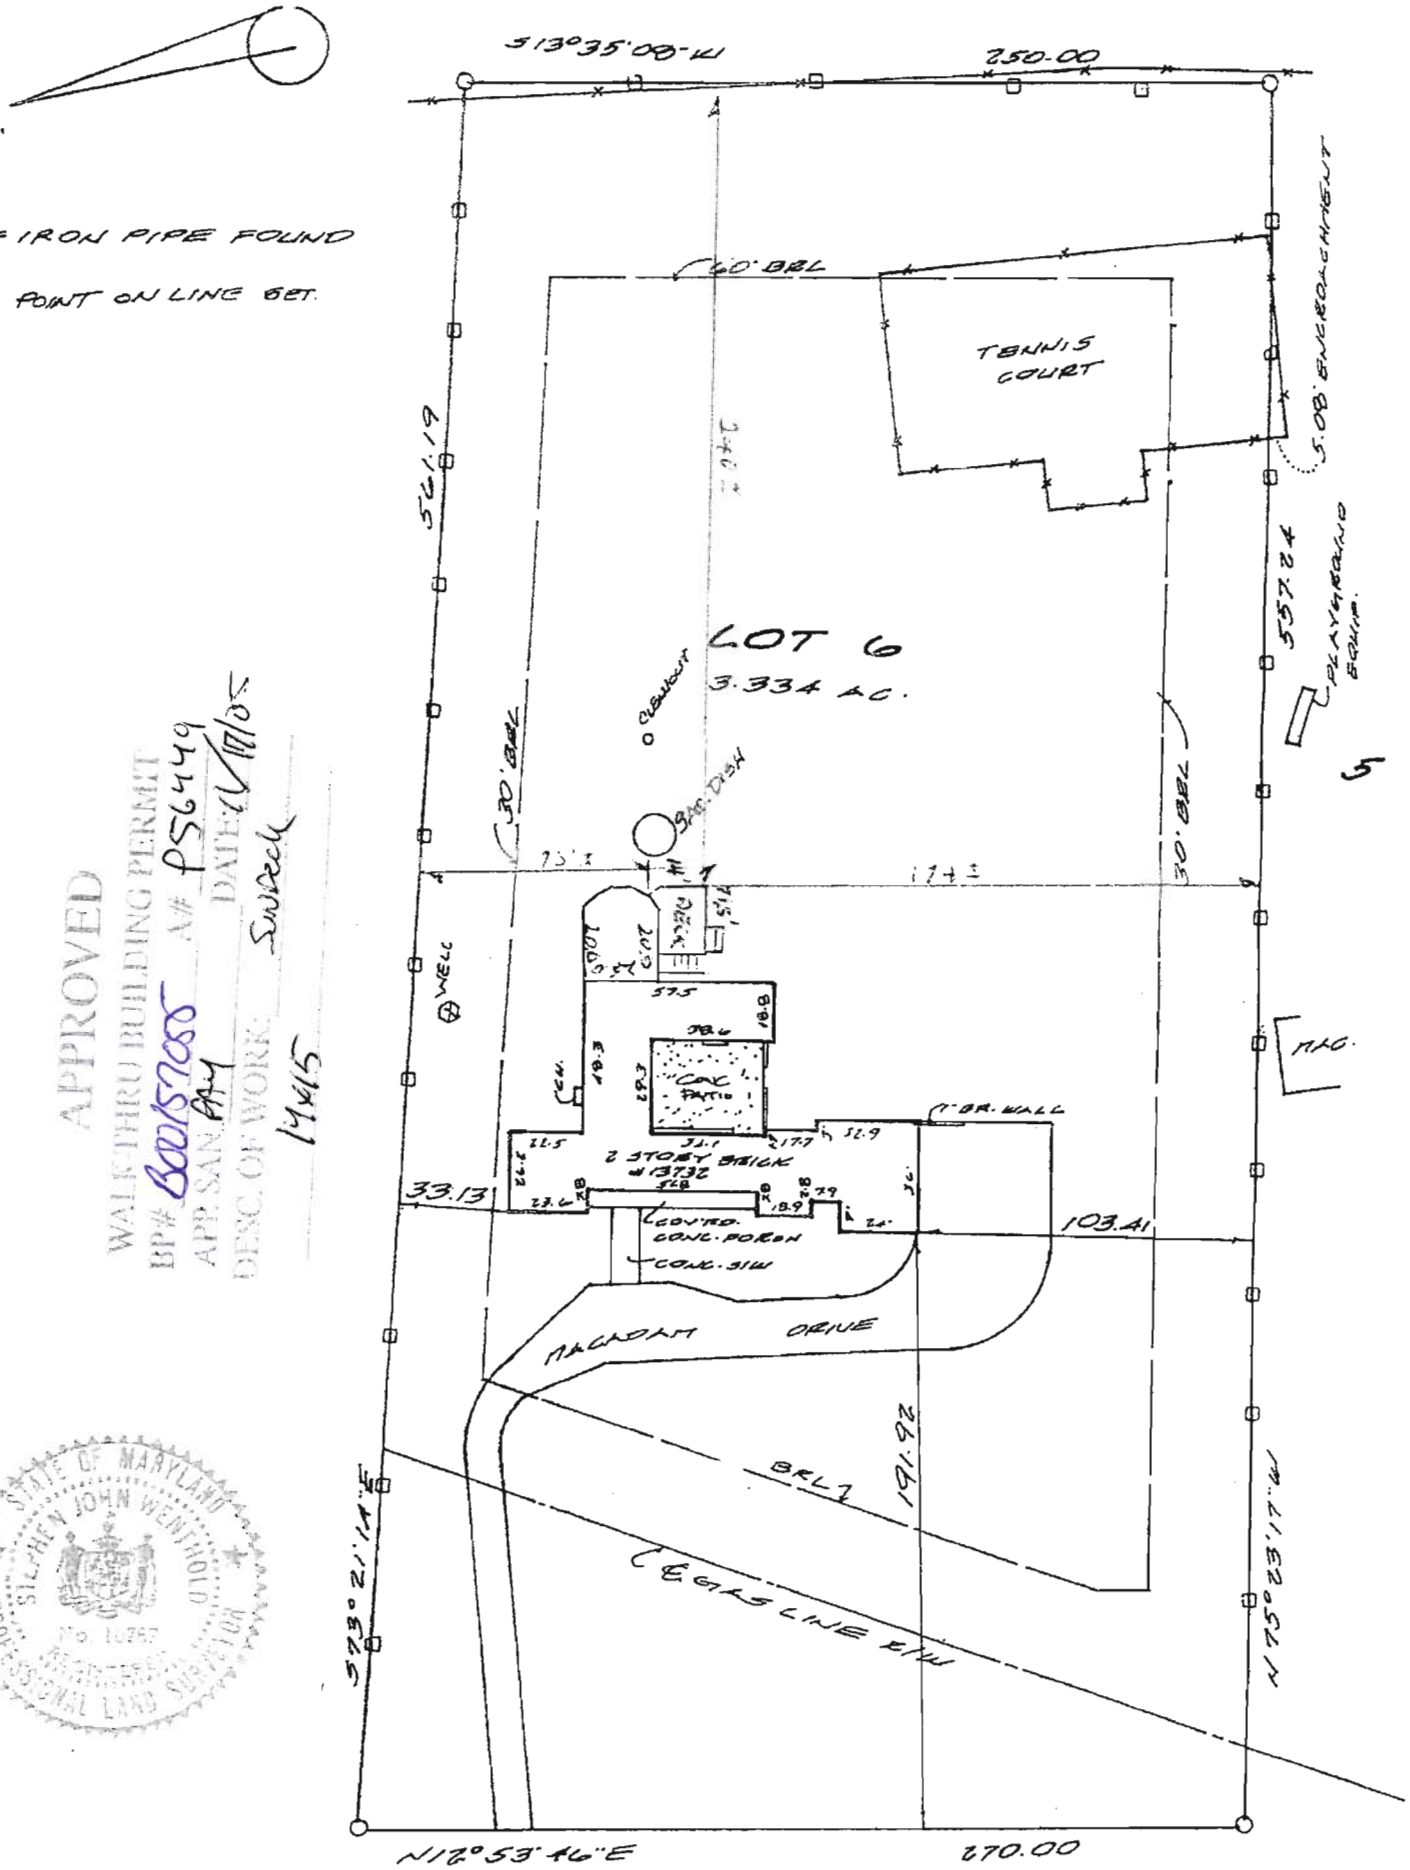
S13°35'08"W
250.00
O = IRON PIPE FOUND
□ = POINT ON LINE SET.
60' BRL
TENNIS COURT
5.08' ENCROACHMENT
561.19
557.24
PLAYGROUND SCHM.
LOT 6
3.334 AC.
CLEANOUT
SAN. DISH
30' BRL
30' BRL
WELL
CONC PATIO
2 STORY BRICK
#13732
1' BR. WALL
33.13
103.41
CONTRO. CONC. PORCH
CONC. SIW
BRL
191.92
S73°21'14"E
N75°23'17"W
N12°53'46"E
270.00
APPROVED
WALK THRU BUILDING PERMIT
BP# 800157008 A/# P56449
APP. SAN. AY DATE: 1/11/05
DESC. OF WORK: Sunroom
14415
STATE OF MARYLAND
STEPHEN JOHN WENTHOLD
No. 10281
PROFESSIONAL LAND SURVEYOR