MARYLAND DEPARTMENT OF THE ENVIRONMENT, WATER MANAGEMENT ADMINISTRATION
1800 Washington Blvd., Baltimore, Maryland 21230 (410) 537-3784

****

WATER WELL ABANDONMENT - SEALING REPORT FORM

****

SUBMIT COPIES OF COMPLETED FORM TO:

* COUNTY ENVIRONMENT AGENCY (contact MDE, WMA if address needed)
* WELL OWNER
* MDE, WATER MANAGEMENT ADMINISTRATION, WELL PROGRAM

OK 7/25/16 SC

DATE WELL ABANDONED: 9-23-11 (month/day/year)

* PERMIT NUMBER OF ABANDONED WELL (if any) ________
* PERMIT NUMBER OF REPLACEMENT WELL ________
* PERSON ABANDONING WELL: Allen Corrigan

WELL DRILLERS LICENSE NUMBER: 009
CIRCLE: MWD/(MSD)/MGD

* OWNER'S NAME: Catonsville Homes
* WELL LOCATION:
  COUNTY: Howard
  NEAREST TOWN: Woodbine
  TAX MAP 0013 BLOCK 0020 PARCEL 0119
  SUBDIVISION: ________
  SECTION: ________ LOT: ________
  NEAREST ROAD: 2728 Jennings Chapel Rd

SITE LOCATION MAP

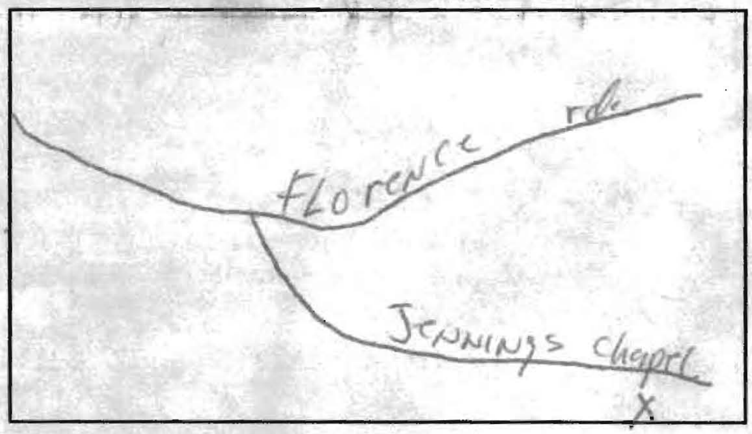

* TYPE OF WELL BEING ABANDONED:
  ✓ DRILLED ____ JETTED
  ____ BORED/AUGERED ____ HAND DUG
  ____ OTHER (specify) ________
* USE CODE:
  X DOMESTIC ____ MUNICIPAL/PUBLIC
  ____ IRRIGATION ____ INDUSTRIAL
  ____ TEST/OBSERVATION ____ GEOTHERMAL
* TYPE OF CASING:
  ____ STEEL ____ PLASTIC
  ____ CONCRETE ____ OTHER (specify) NO CASING
* SIZE OF CASING: ________ INCHES IN DIAMETER
* DEPTH OF WELL: ________ FEET DEEP
* WAS ANY CASING REMOVED? ____ YES ✓ NO
  if yes, length removed, in feet: ________
* WAS CASING RIPPED OR PERFORATED? ____ YES ✓ NO

LOG OF SEALING MATERIAL

MATERIAL	FEET FROM	FEET TO
		44

VOLUME OF MATERIAL USED: 18 bags

Allen Corrigan ________ (MWD)/MSD/MGD 9-27-11
SIGNATURE-MASTER WELL DRILLER OR SUPERVISING SANITARIAN LICENSE # CIRCLE ONE DATE

DENV 828 JULY 1997

2) COUNTY ENVIRONMENTAL AGENCY