


MANOR LANE

JOSEPH MICHAEL KNECHT JR.  
4411 MANOR LANE  
TAX-MAP 29 PARCEL 2

HERBERT M. COLBURN &  
MANOR LANE  
29 PARCEL 7

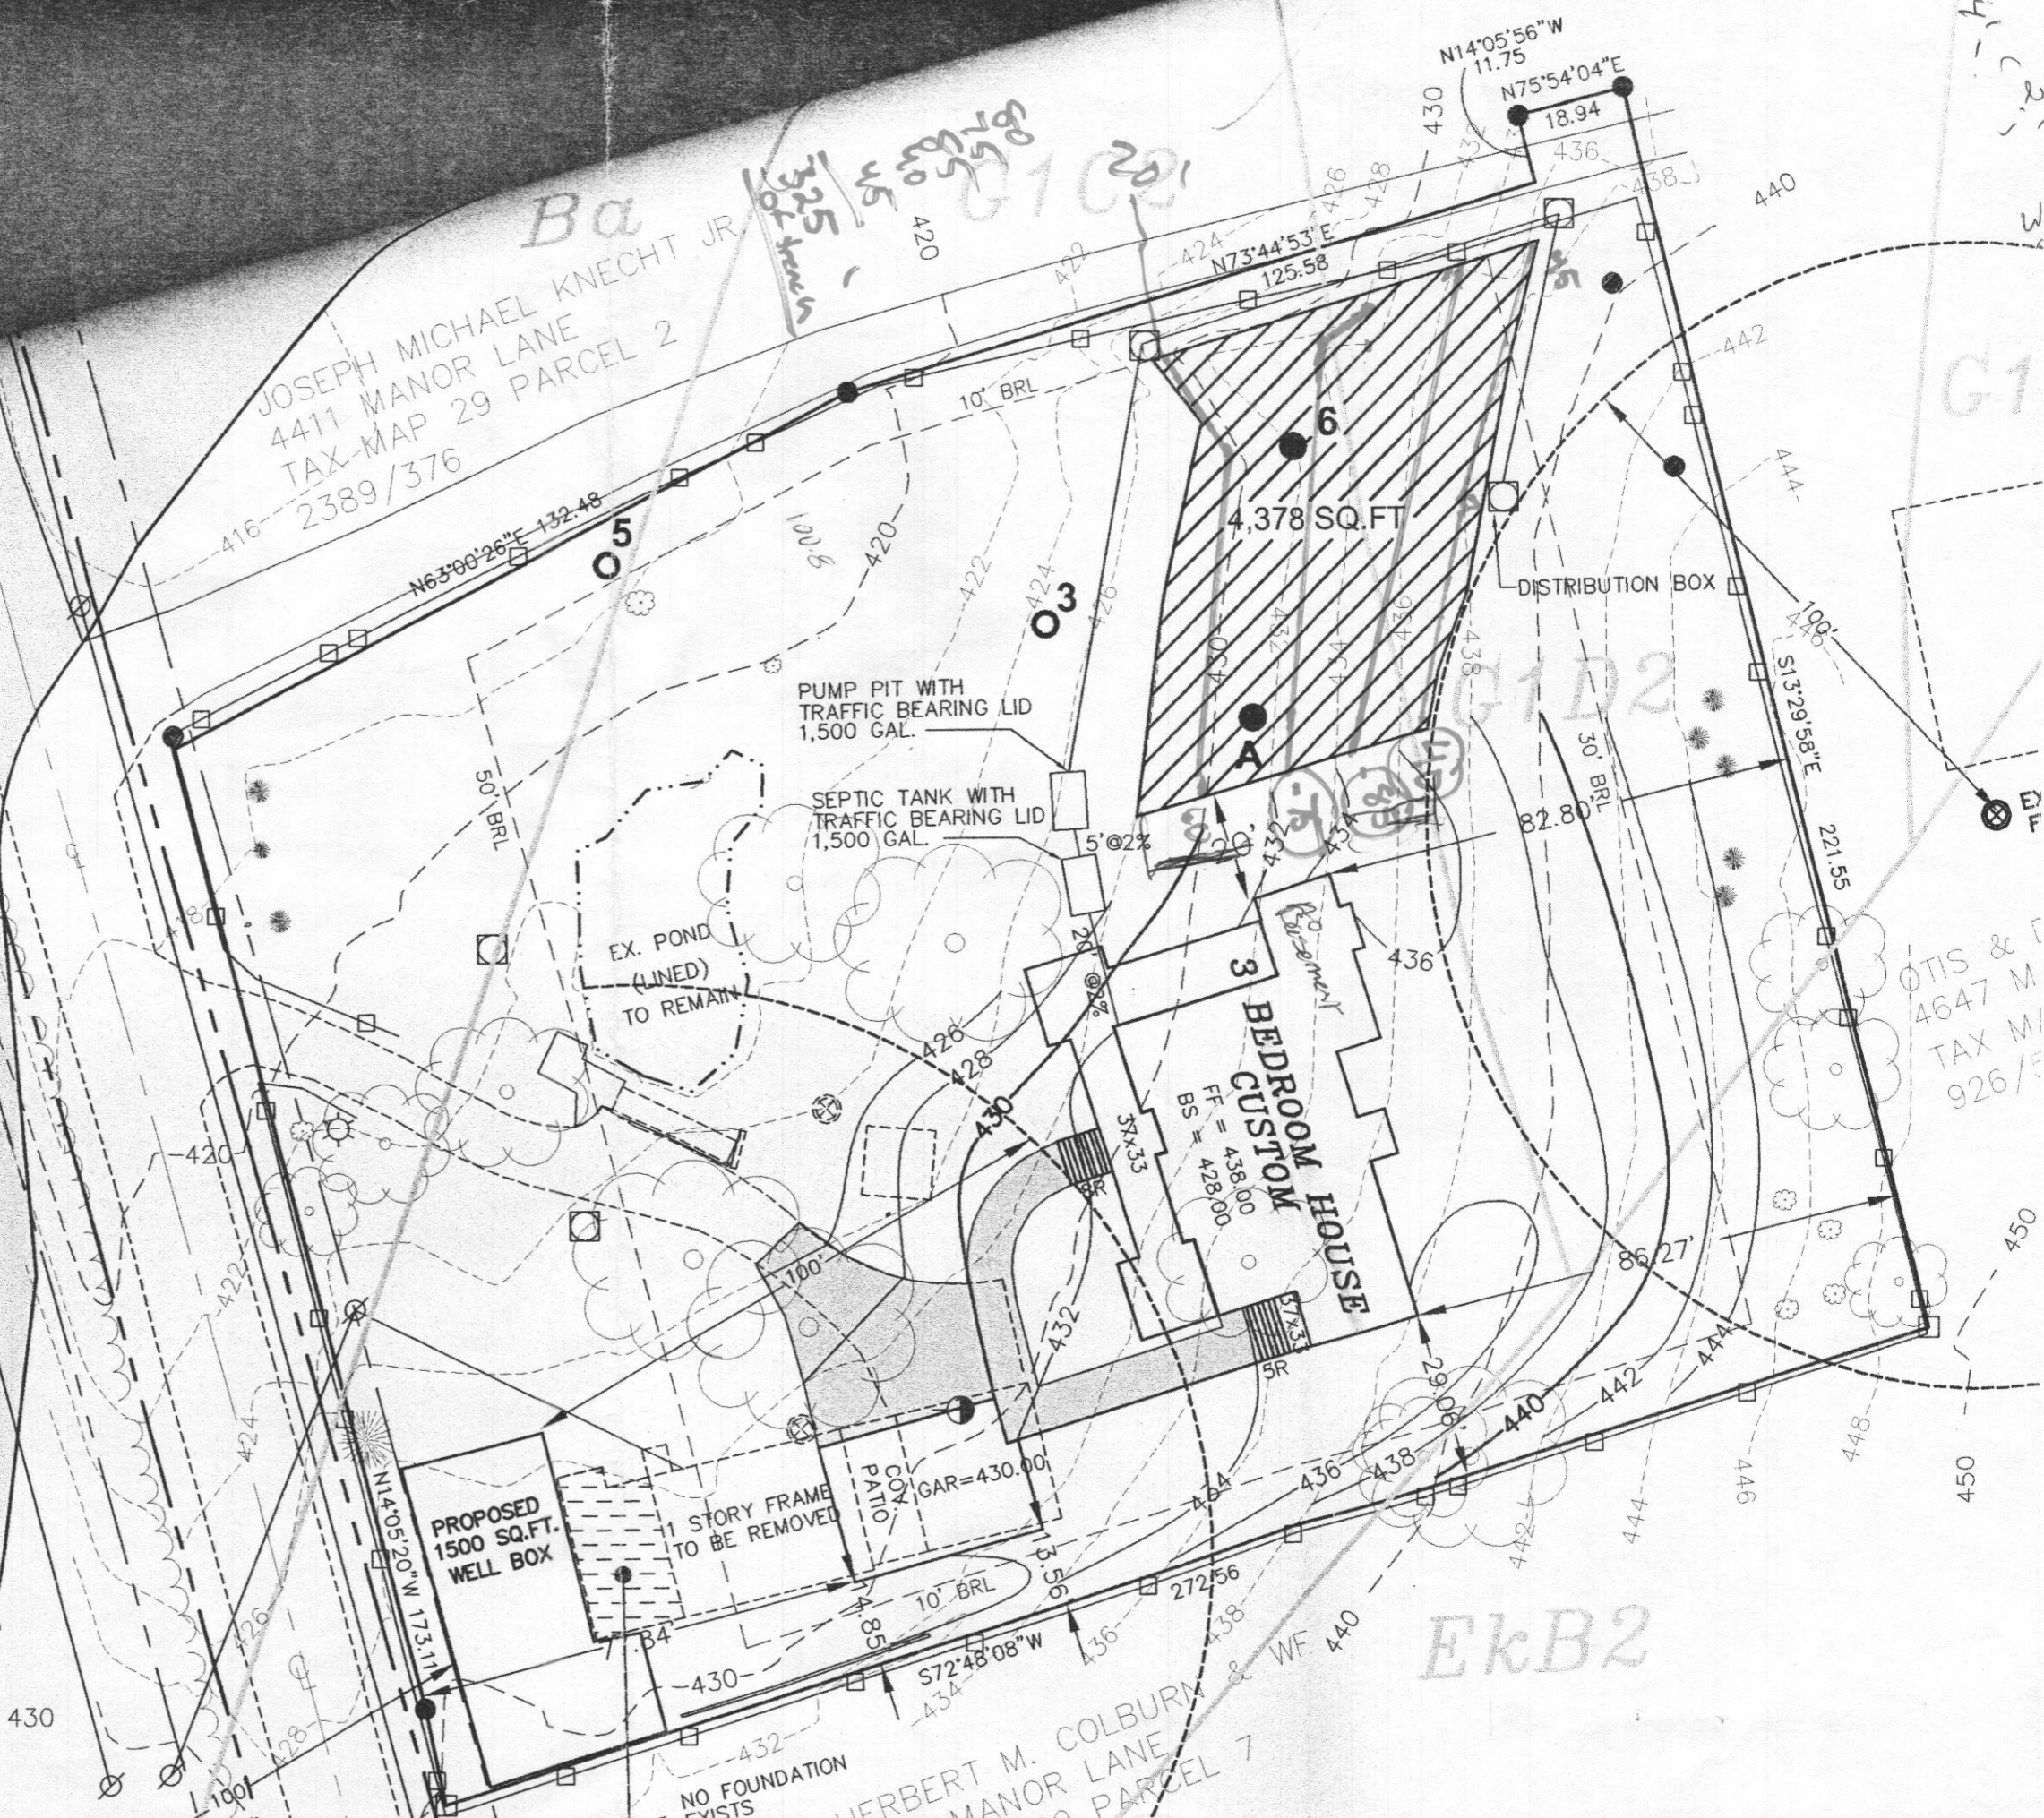

Ba

EKB2

OTIS &  
4647 M  
TAX M  
926/E