RECEIVED

MAY 28 2020

LICENSES & PERMITS DIVISION

PERMIT NUMBER: B 20001031 DATE ACCEPTED:

RESIDENTIAL BUILDING PERMIT APPLICATION

HOWARD COUNTY DEPARTMENT OF INSPECTIONS, LICENSES, AND PERMITS

3430 COURT HOUSE DRIVE, ELLICOTT CITY, MD 21043 - PHONE: (410) 313-2455 OPTION #4

www.howardcountymd.gov

BUILDING SITE ADDRESS *REQUIRED*

Street Address: **13905 Kennard Drive**			Unit: **N/A**
City: **Glenelg**		State: **MD**	Zip Code: **21737**
Subdivision/Village/Complex Name: **Crystal Clear**			SDP/WP/BA #:
Lot: **19**	Tax Map:	Parcel: **0533**	Grading Permit #:

DESCRIPTION OF WORK *REQUIRED*

Existing Use: **Low density residential**	Proposed Use: **Low density residential**	Estimated Cost: $**9,000.00**

Trade Work to Be Completed *(Separate Permits Required)*: ☐ Mechanical (HVACR) ■ Electrical ☐ Plumbing ☐ None

SED/INSTALL 24 ft diameter above ground swimming pool, 52 inches deep, with two ladders that fold up and lock with fence to code (i.e. a fence kit will be attached to the top rail of the pool which will prevent entry.)

PROPERTY OWNER INFORMATION *REQUIRED*

Owner(s) Name(s) *(As it appears on tax records)*: **Burns, Anna L, and Fine, Steven L.**		Primary Residence: ■ Yes ☐ No
Owner's Street Address: **13905 Kennard Drive**		
City: **Glenelg**	State: **MD**	Zip Code: **21737**
Phone: **(443) 983-4417**	Email: **annaburns@hotmail.com**	

APPLICANT NAME *REQUIRED - INDIVIDUAL WHO SIGNS THIS APPLICATION*

Business Name: **Homeowner**	Contact Name: **Anna L. Burns**	
Street Address: **13905 Kennard Dr**		
City: **Glenelg**	State: **MD**	Zip Code: **21737**
Phone: **(443) 983-4417**	Email: **annaburns@hotmail.com**	

CONTRACTOR INFORMATION *REQUIRED*

Business Name: **Floyd Contracting, Inc,**		
Licensee's Name:	**License #: 87516**	
Street Address: **4366 Norrisville Rd.**		
City: **White Hall**	State: **MD**	Zip Code: **21161**
Phone: **(877) 794-7665**	Email: **office@floydcontracting.com**	

ARCHITECT/ENGINEER INFORMATION *INDIVIDUAL WHO SIGNED PLANS, IF APPLICABLE*

Business Name: **N/A**	Name:	
Street Address:		
City:	State:	Zip Code:
Phone:	Email:	

BUILDING CHARACTERISTICS *REQUIRED*

Primary Structure: ■ SF Dwelling ☐ SF Townhouse ☐ SF Duplex ☐ Mobile Home ☐ Multi-Family Dwelling (MF*)			Condo: ☐ Yes ■ No
Utilities: ■ Electric ☐ Gas	Water Supply: ☐ Public ■ Private (Well)	Sewage Disposal: ☐ Public ■ Private (Septic)	
Heating System: ■ Electric ☐ Natural Gas ☐ Propane ☐ Other:		Roadside Tree Project: ■ No ☐ Yes: #	
Sprinkler System: ☐ NFPA 13 ☐ NFPA 13R ☐ NFPA 13D ■ None		Fire Alarm System: ☐ Yes ■ No ☐ Voice Evac	

ADDITIONAL RESIDENTIAL INFORMATION *(PLEASE SELECT/COMPLETE ALL THAT APPLY)*

Model Name & Options:				
# of Bedrooms (SF):	# of efficiency units (MF*):	# of 1 BR (MF*):	# of 2 BR (MF*):	# of 3 BR (MF*):
# Rooms:	# Full Baths:	# Half Baths:	# Fireplaces:	
Garage/Carport Info: ☐ Attached Garage ☐ Detached Garage ☐ Integral Garage ☐ Carport ☐ None				
Basement/Foundation Info: ☐ Slab on Grade ☐ Post & Pier ☐ Unfinished Basement ☐ Finished Basement: ☐ Full or ☐ Partial				
1st Fl Width:	1st Fl Depth:	2nd Fl Width:	2nd Fl Depth:	Bsmt Width: / Bsmt Depth:
Energy Method: ☐ Prescriptive ☐ Performance ☐ UA Alternative ☐ ERI	Gross Area: sq ft	Occupiable Area: sq ft		

AGREEMENT/ DISCLAIMER *REQUIRED*

THE UNDERSIGNED HEREBY CERTIFIES AND AGREES AS FOLLOWS: (1) THAT HE/SHE IS AUTHORIZED TO MAKE THIS APPLICATION; (2) THAT THE INFORMATION IS CORRECT; (3) THAT HE/SHE WILL COMPLY WITH ALL REGULATIONS OF HOWARD COUNTY WHICH ARE APPLICABLE THERETO; (4) THAT HE/SHE WILL PERFORM NO WORK ON THE ABOVE REFERENCED PROPERTY NOT SPECIFICALLY DESCRIBED IN THIS APPLICATION; (5) THAT HE/SHE GRANTS COUNTY OFFICIALS THE RIGHT TO ENTER ONTO THIS PROPERTY FOR THE PURPOSE OF INSPECTING THE WORK PERMITTED AND POSTING NOTICES.

Anna L. Burns — APPLICANT'S ORIGINAL SIGNATURE

May 24, 2020 — DATE SIGNED

FOR OFFICE USE ONLY

CHECKS PAYABLE TO: DIRECTOR OF FINANCE OF HOWARD COUNTY

AGENCIES REQUIRED/APPROVALS:

☐ DPR	☑ DPZ	☐ DED	☑ Health DBurns	☐ DHA	☐ CID

SUBMITTAL FEE: $110.00	PAYMENT: CK#4314	ACCEPTED BY: MAIL	

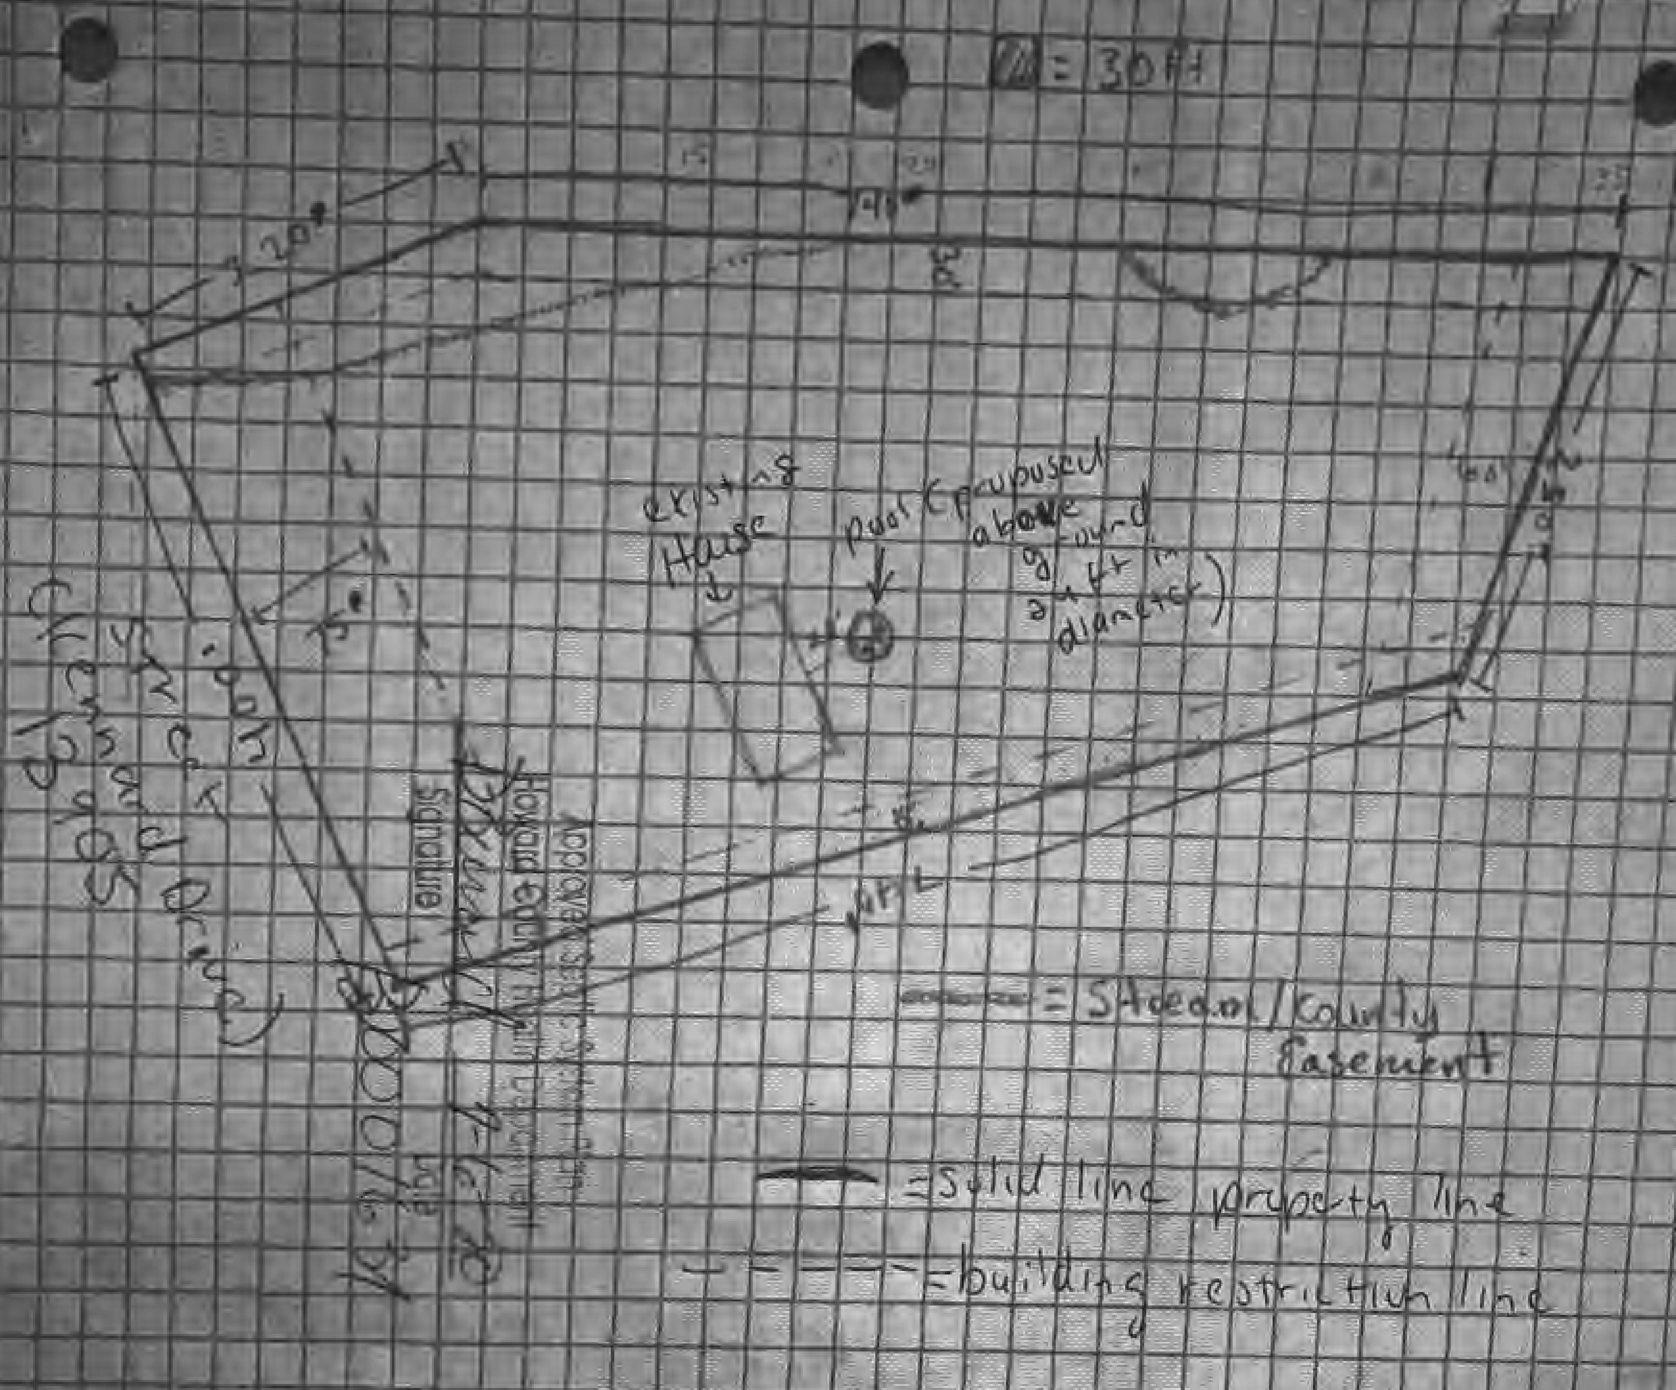
= 30 ft
20'
40'
30'
existing House
pool (purposed above ground 24 ft in diameter)
400' Street
13905 Glennard Drive
= Stream/County Easement
= solid line property line
= building restriction line
Approved Septic System Plan
Howard County Health Department
Signature
Date