


MEMORANDUM

sent via email to sardarji211@gmail.com

TO: Harpeet Suri

FROM: Susan Thomas
Licensed Environmental Health Specialist II
Howard County Health Department
Well & Septic Program

RE: Out of use well on 1490 Marriottsville Rd must be abandoned, stormwater must be routed away from septic area

DATE: April 21, 2022 

The out of use well (tag HO-73-1186) at 1490 Marriottsville Rd must be sealed by a licensed well driller in accordance with COMAR 26.04.04.34A and COMAR 26.04.04.34C, which states:

A. Any well shall be considered abandoned when:

- (1) The well is in such a state of disrepair that continued use for its intended purpose is impractical;
- (2) The well has been permanently disconnected from any water supply system or irrigation system; or
- (3) The well is unsuccessful, that is, it does not meet the requirements of this chapter.

C. An abandoned well shall be filled and sealed in accordance with this regulation.

An out of use well is a potential channel for contamination to groundwater and must be sealed. If you do not seal the well, you will be in violation of the law as stated in the Code of Maryland Regulations.



Bureau of Environmental Health
8930 Stanford Blvd | Columbia, MD 21045
410.313.2640 - Voice/Relay
410.313.2648 - Fax
1.866.313.6300 - Toll Free

Maura J. Rossman, M.D., Health Officer

The 1" PVC pipe draining stormwater from your crawl space must be routed so that it does not empty onto your septic field. The puddle created by this pipe is located near the end of your septic trenches. Excess water draining onto a septic field can cause the septic system to fail at an accelerated rate. Howard County has a setback of 25 feet for storm water management systems to Sewage Disposal Areas. Please re-route the stormwater so that it is at least 25 feet further away from the septic field. Once this has been completed, please call us to reinspect.

Once we have reinspected the stormwater drain and received the abandonment report for out of use well HO-73-1186, you will receive Well & Septic Program approval for your daycare permit.

 WATER WELL ABANDONMENT-SEALING REPORT FORM

OK
 8/11/22

SUBMIT COPIES OF COMPLETED FORM TO:

- * COUNTY ENVIRONMENTAL AGENCY (contact MDE, WMA if address needed)
- * WELL OWNER
- * MDE, WATER MANAGEMENT ADMINISTRATION, WELL PROGRAM

DATE WELL ABANDONED: 8-21-2022 (month/day/year)

* PERMIT NUMBER OF ABANDONED WELL (if any) HD-73-1186

* PERMIT NUMBER OF REPLACEMENT WELL: HO-18-0101


* PERSON ABANDONING WELL: Honey Maun WELL DRILLER'S LICENSE NUMBER: MSD027

CIRCLE: MWD / MSD / MGD

* OWNER'S NAME: DARINDER SURI

SITE LOCATION MAP

* WELL LOCATION:
 COUNTY: Howard
 NEAREST TOWN: Mariottsville Md, 21109
 TAX MAP _____ BLOCK _____ PARCEL _____
 SUBDIVISION: _____
 SECTION: _____ LOT: _____
 STREET ADDRESS: 1490 Mariottsville

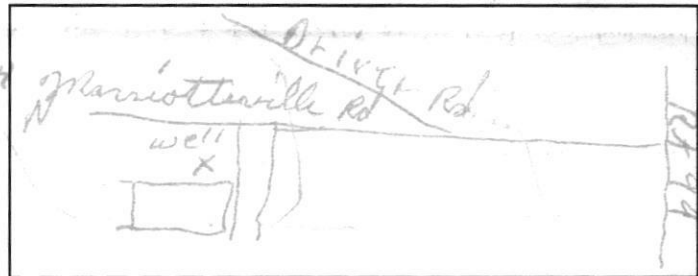

LATITUDE 3 9.33000

LONGITUDE 7 6.90093

LOG OF SEALING MATERIAL

MATERIAL	FEET	
	FROM	TO
<u>Cement</u>	<u>0</u>	<u>80</u>
<u>The well is cased in</u>		
VOLUME OF MATERIAL USED		
<u>17 Bag cement 1,598 pounds</u>		
<u>WATER 102 gallons</u>		

* TYPE OF WELL BEING ABANDONED:
 DRILLED JETTED
 BORED HAND DUG
 OTHER (specify) _____

* USE CODE:
 DOMESTIC MUNICIPAL/PUBLIC
 IRRIGATION INDUSTRIAL
 TEST/OBSERVATION GEOTHERMAL

* TYPE OF CASING:
 STEEL PLASTIC
 CONCRETE OTHER (specify) _____

SIZE OF CASING: 6 INCHES IN DIAMETER

DEPTH OF WELL: 174 FEET DEEP

WAS ANY CASING REMOVED? YES NO
 If yes, length removed, in feet: _____

WAS CASING RIPPED OR PERFORATED? YES NO

SIGNATURE-MASTER WELL DRILLER OR SUPERVISING SANITARIAN Honey Maun LICENSE# MSD027

MWD / MSD / MGS
 CIRCLE ONE

7-21-2022
 DATE

Pursuant to § 10-624 of the State Govt. Article of the Maryland Code, personal info requested on this form is used in processing this form pursuant to COMAR 26.04.04. Failure to provide the info may result in this form not being processed. You have the right to inspect, amend, or correct this form. The Maryland Department of the Environment is subject to the Maryland Public Information Act. This form may be made available on the Internet via MDE's website and is subject to inspection or copying, in whole or in part, by the public and other governmental agencies, if not protected by federal or State Law.