




STAIR SECTION W/ OPT. 10' 1ST FLR. CLG.
SCALE: 1/4" = 1'-0"

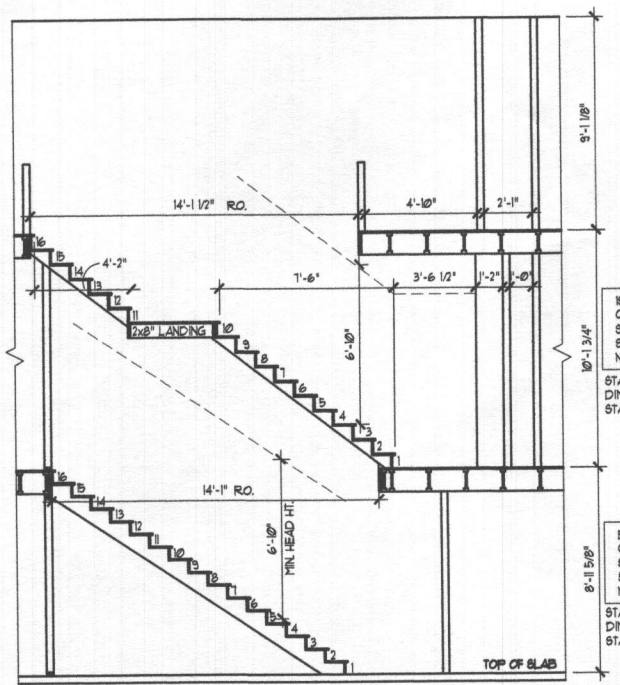


STAIR SECTION
SCALE: 1/4" = 1'-0"

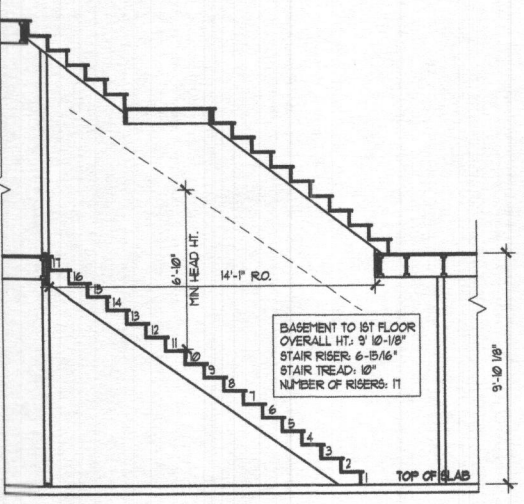


STAIR SECTION W/ OPT. 9'-0" FDTN. HGT.
SCALE: 1/4" = 1'-0"

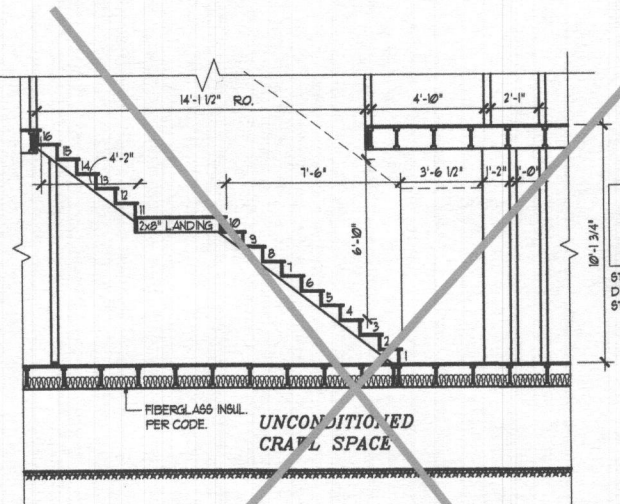

STAIR SECTION w/ CRAWL SPACE
SCALE: 1/4" = 1'-0"

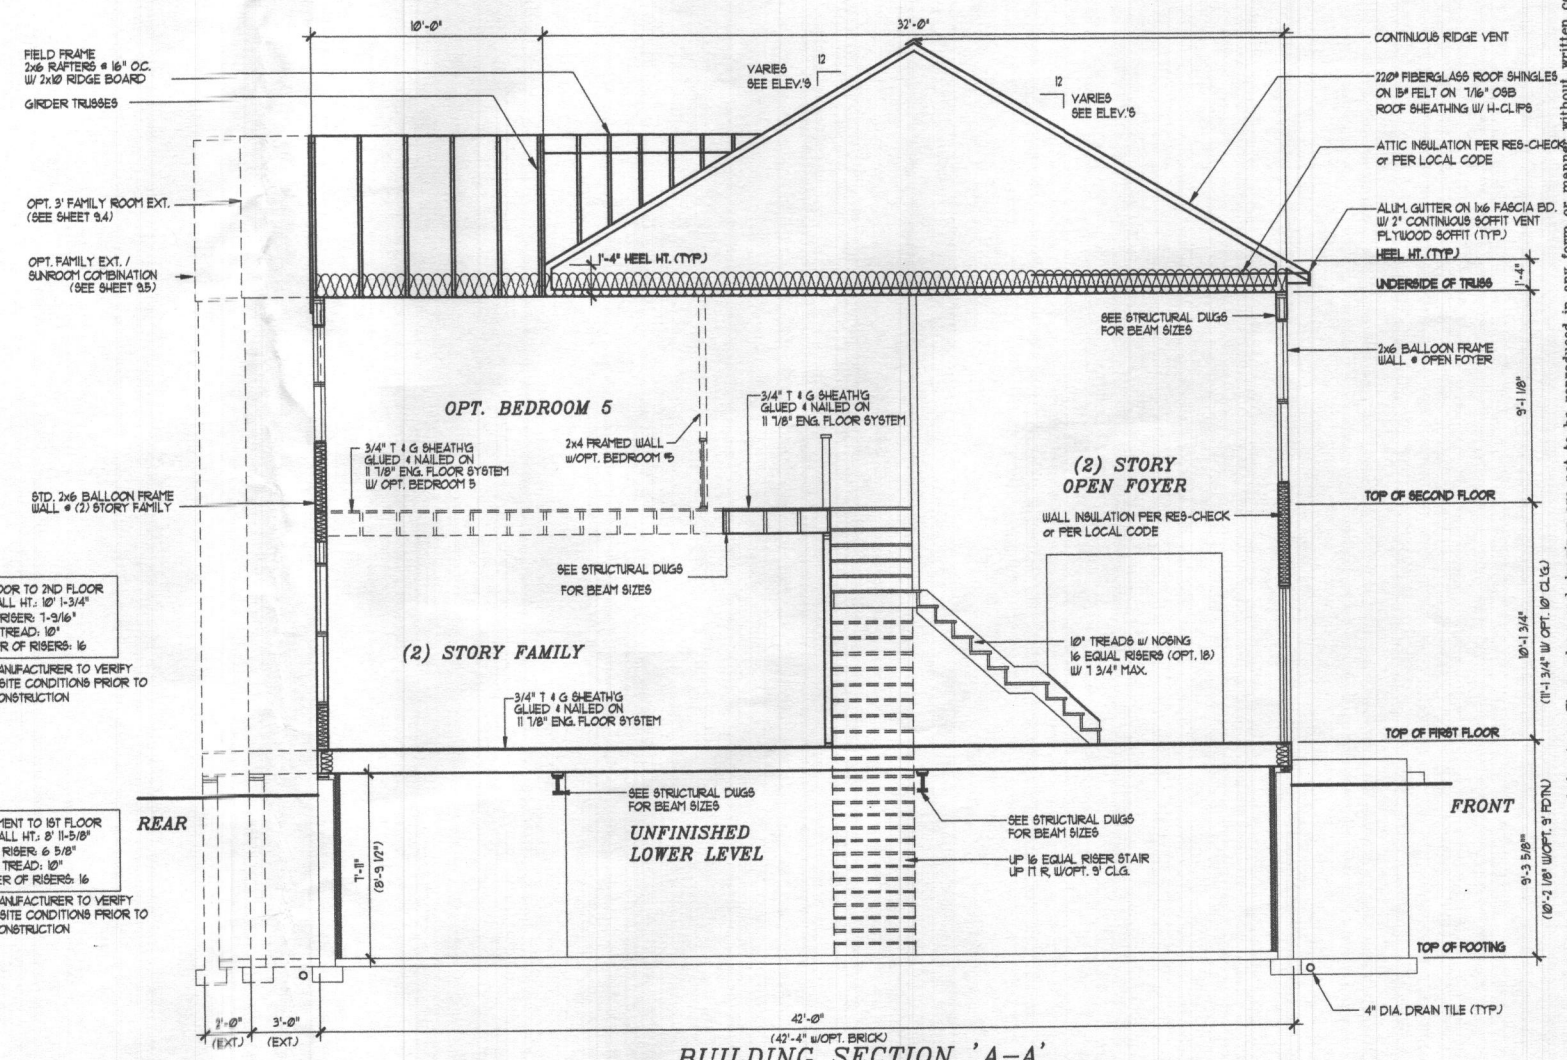

BUILDING SECTION 'A-A'
SCALE: 1/4" = 1'-0"

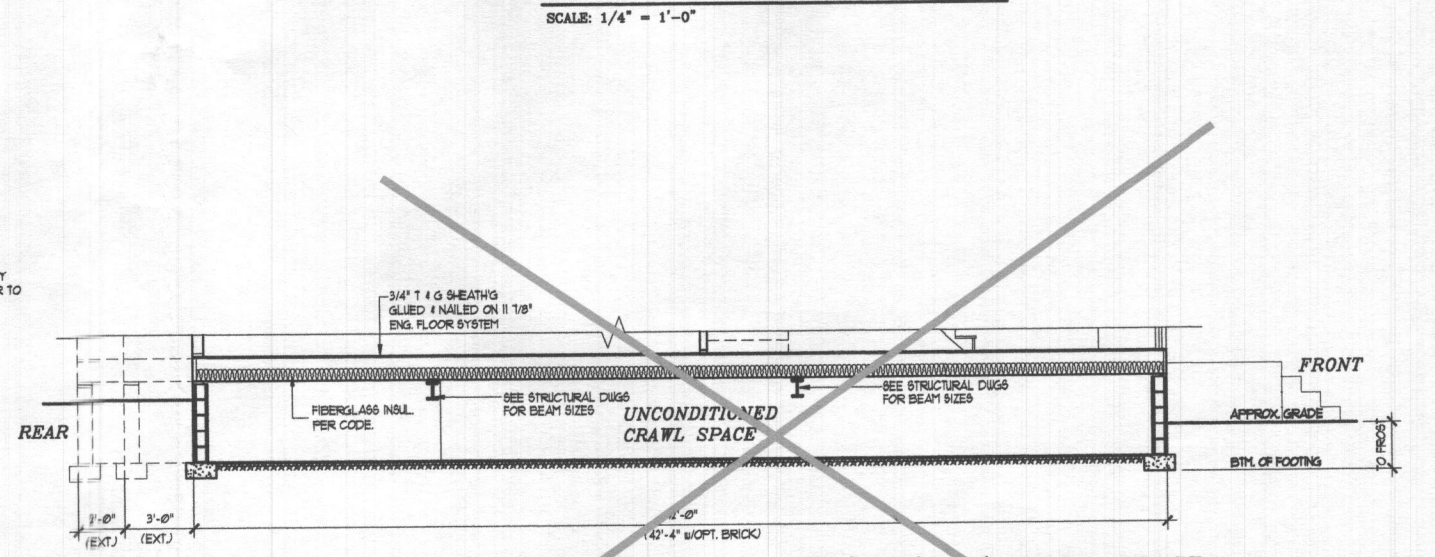


BUILDING SECTION 'A-A' w/ CRAWL SPACE
SCALE: 1/4" = 1'-0"

Architecture Collaborative, Inc.
Ellicott City, MD 21043
8834 Main Street
www.archcol.com
Tel.: (410) 465-7500 Fax: (410) 465-0903


content: BUILDING SECTION A-A
date: 06-10-21
drawn: ACI
scale: 1/4" = 1'-0" (94222)
U.N.O. 1'-8" (17271) 7:1
title: CARUSO HOMES
KINGSPORT

revision	date	by


SHEET # 7.1
Professional Certification
I hereby certify that these documents were prepared or approved by me, and that I am a duly licensed architect for the State of Maryland.
license number: 5621
expiration date: 04-09-2022

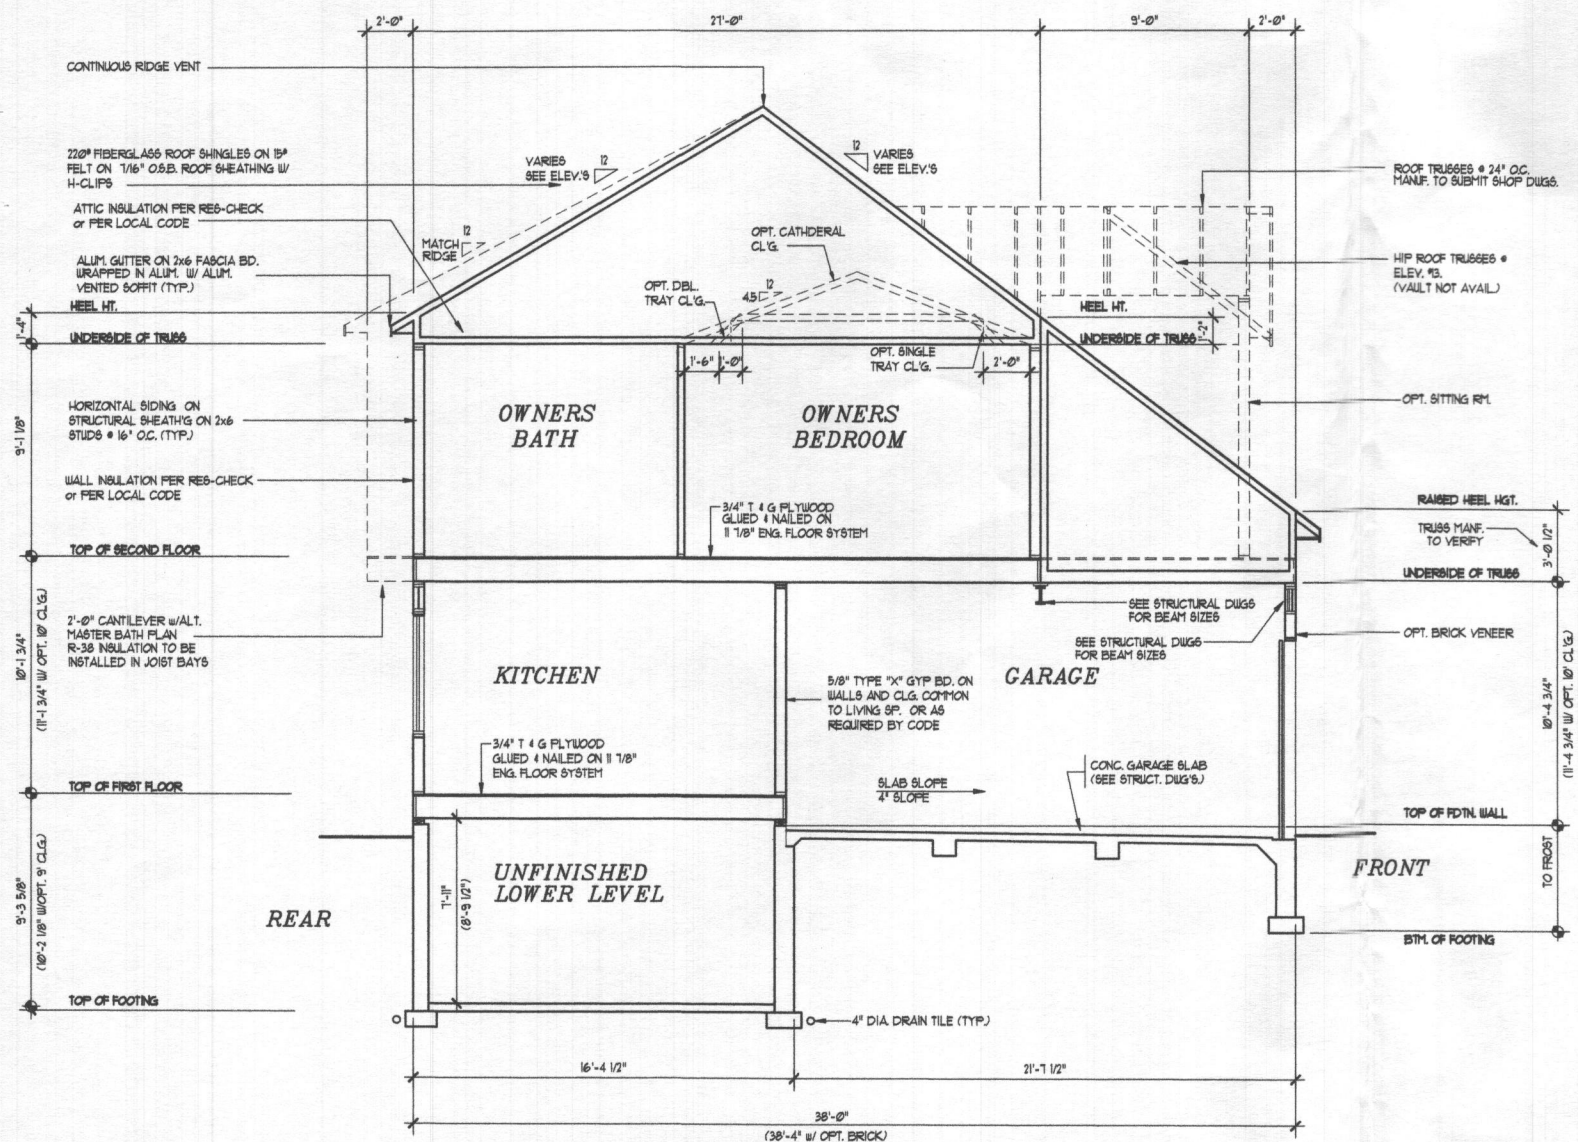


BUILDING SECTION 'B-B'
SCALE: 1/4" = 1'-0"

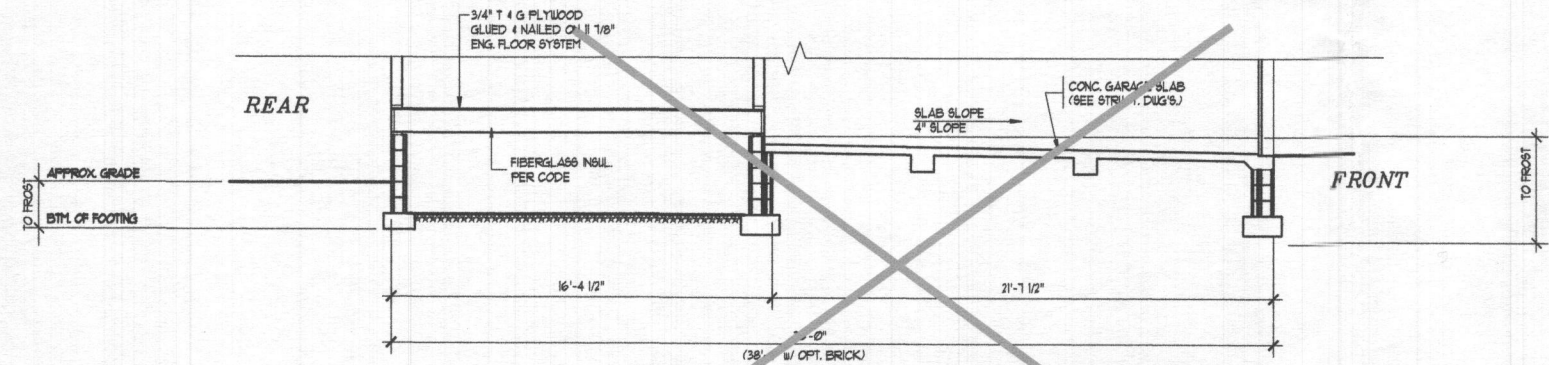

BUILDING SECTION 'B-B' w/ CRAWL SPACE
SCALE: 1/4" = 1'-0"

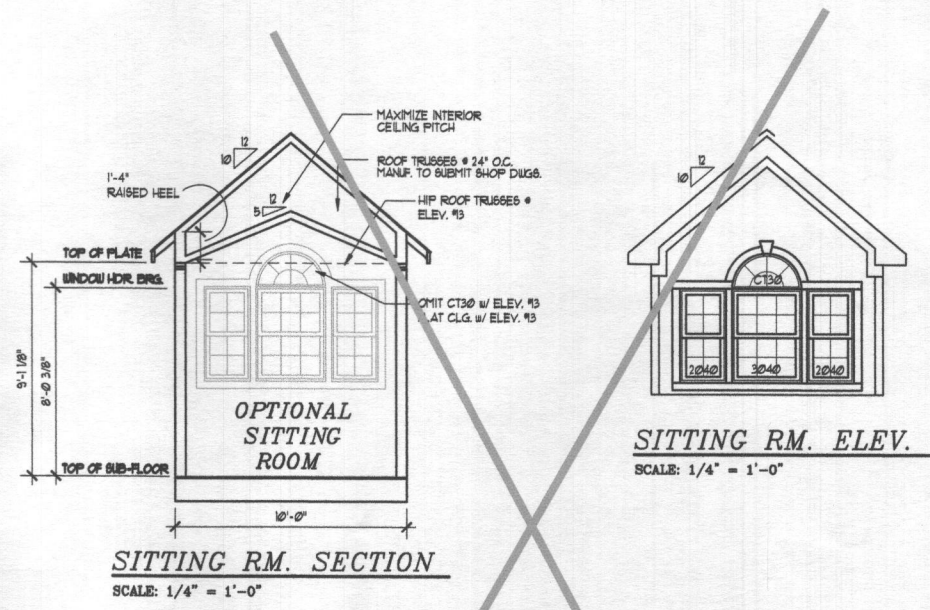

SITTING RM. SECTION
SCALE: 1/4" = 1'-0"

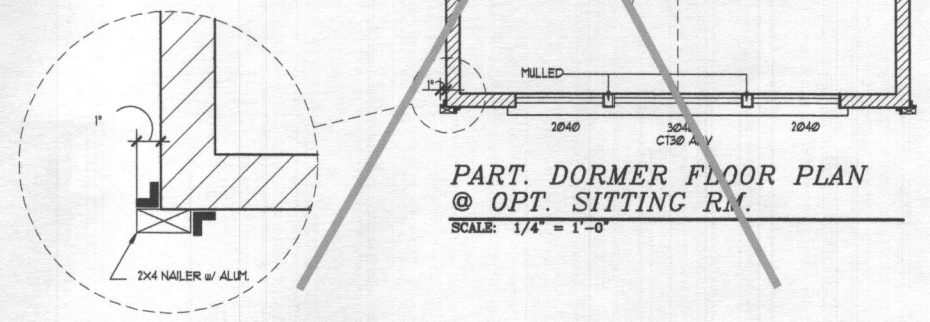

DORMER CORNER SECTION
SCALE: 1" = 1'-0"

PART. DORMER FLOOR PLAN @ OPT. SITTING RM.
SCALE: 1/4" = 1'-0"

SITTING RM. ELEV.
SCALE: 1/4" = 1'-0"


Architecture Collaborative, Inc.
Ellicott City, MD 21043
8334 Main Street
www.archcol.com
Tel.: (410) 465-7500 Fax: (410) 465-0903

content	BUILDING SECTION B-B	date	06-10-21
scale:	1" = 4' (34x22)	drawn:	ACI
U.N.O.:	1" = 8' (17x11)	title	CARUSO HOMES KINGSPOINT

date	revision


SHEET #
7.2

Professional Certification
I hereby certify that these documents were prepared or approved by me, and that I am a duly licensed architect of the State of Maryland.
license number 6621
expiration date 04-09-2022

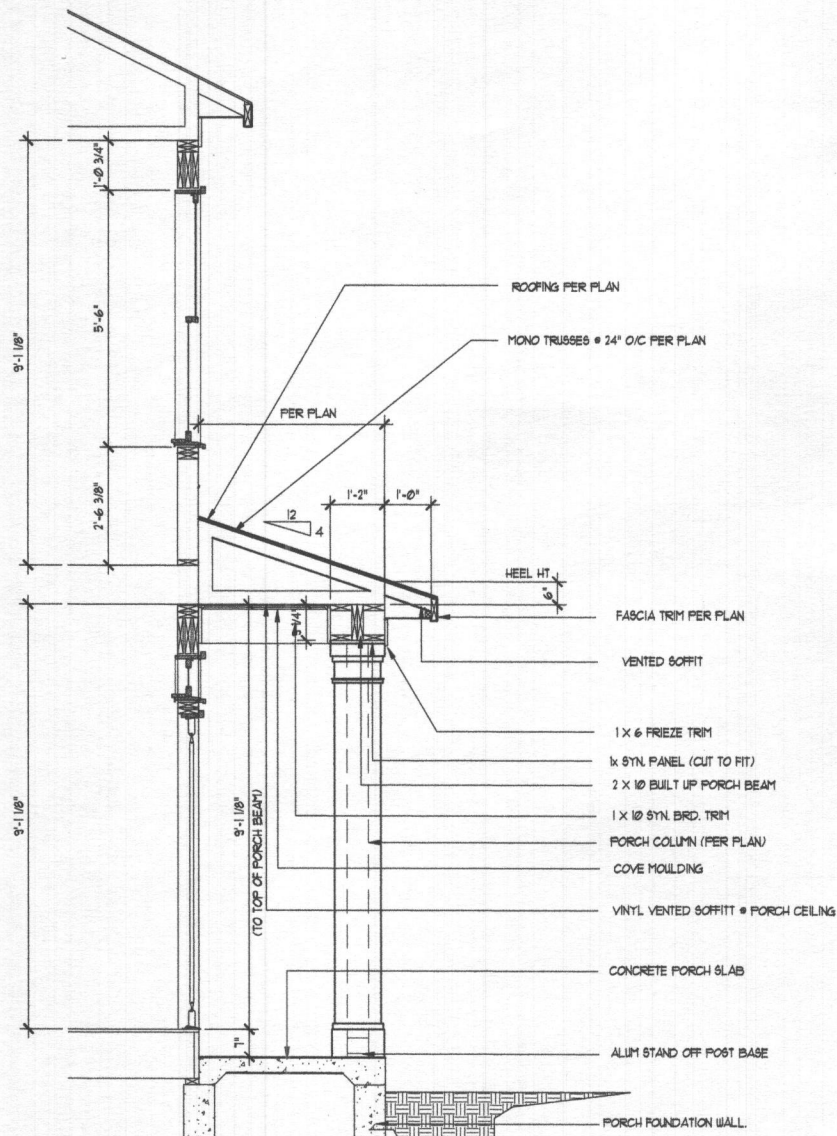


SECTION @ PORCH

SCALE (17x11): 1/4" = 1'-0"
 SCALE (34x22): 1/2" = 1'-0"

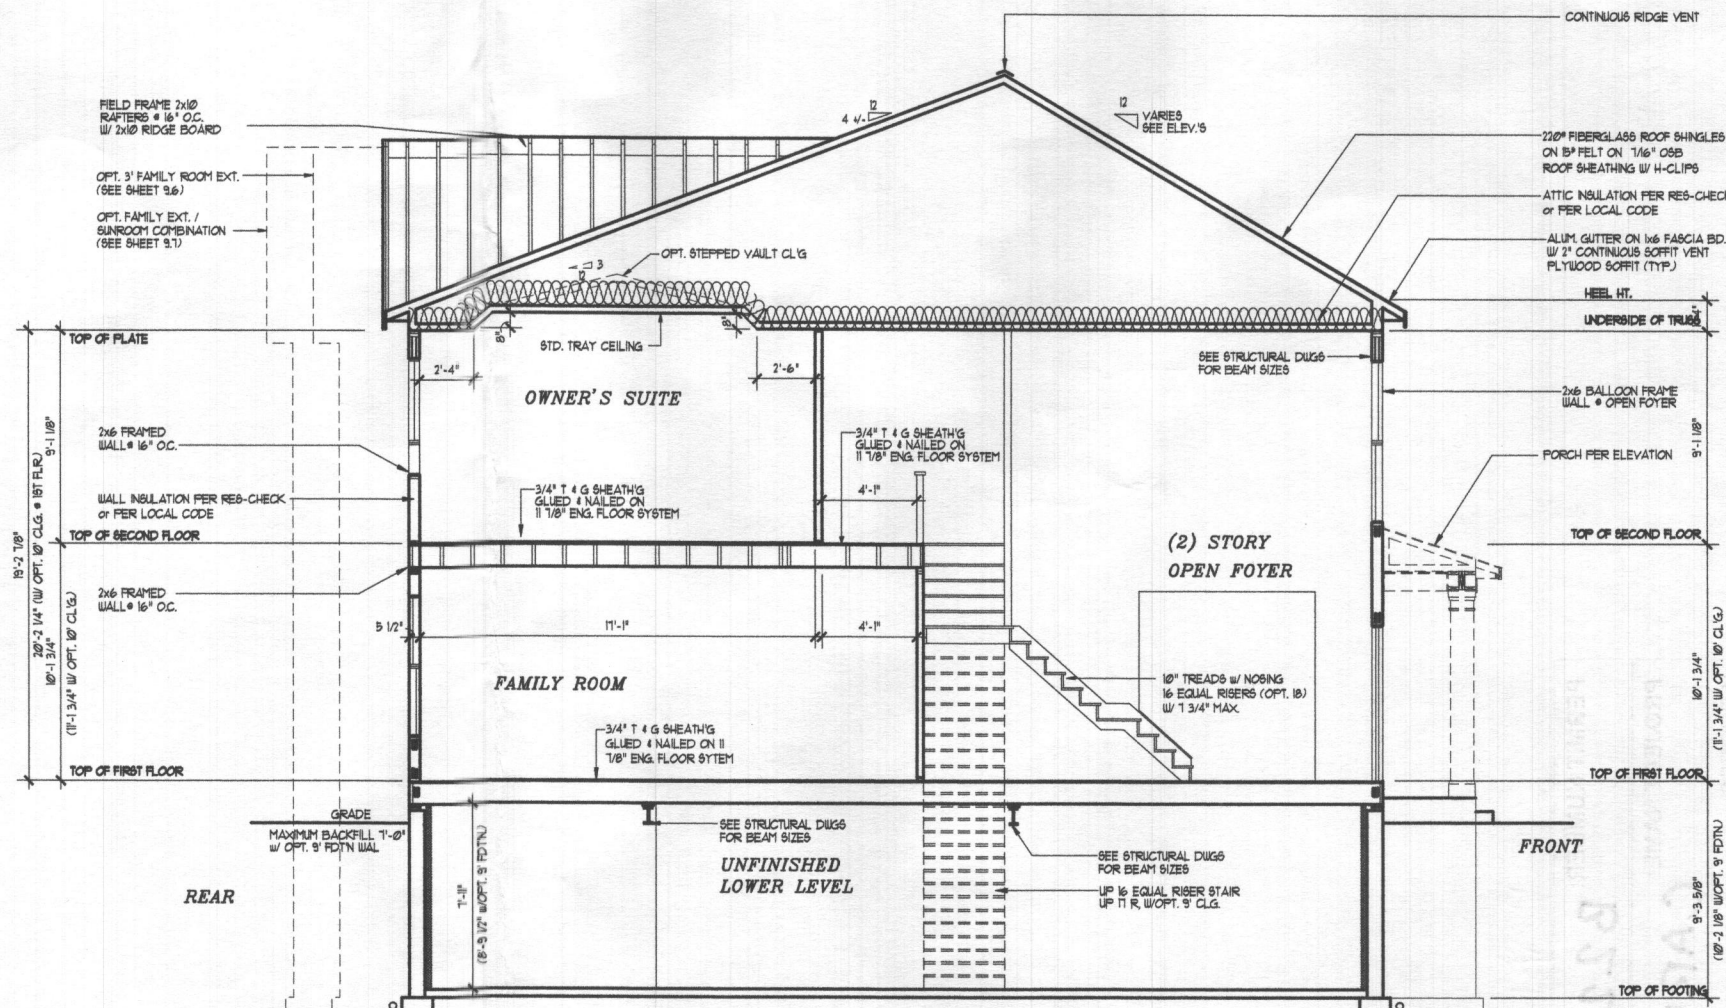

BUILDING SECTION 'C-C'

SCALE: 1/4" = 1'-0"

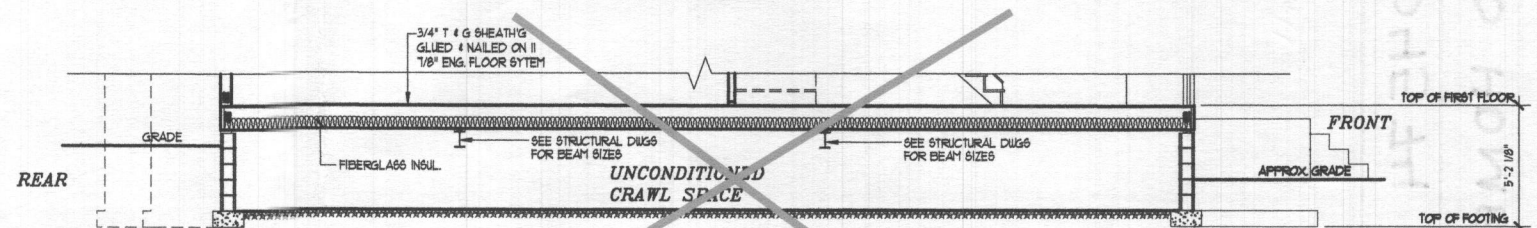

BUILDING SECTION 'C-C w/ CRAWL SPACE'

SCALE: 1/4" = 1'-0"

Architecture Collaborative, Inc.
 8334 Main Street
 Ellicott City, MD 21043
 www.archcol.com
 Tel.: (410) 465-7500 Fax: (410) 465-0903

content: BUILDING SECTION C-C
 scale: 1"=4' (34x22) file: U.N.O. 1'-8' (17x11) 7.3
 date: 06-10-21
 drawn: ACI
 title: CARUSO HOMES
 KINGSPORT

date	revision	by

Professional Certification
 I hereby certify that these documents were prepared by me, and that I am a duly licensed architect under the laws of the State of Maryland.
 license number: 5626
 expiration date: 04-03-2022

SHEET # 7.3

© David R. Robbins expressly reserves his copyright and other property rights in these plans and drawings. These plans and drawings are not to be reproduced in any form or manner without written consent.