


[Well's Septic Complaint Investigation] EH-25-00497 in EH Accela

SITE INSPECTION SHEET

Daughter - Carrie Becker

OWNER: Andrew & Joy Mihn PHONE #: 443-942-5458 / carriebec35@gmail.com
 ADDRESS: 1420 Marriottsville Rd. CONTRACTOR: ? T → tag rusted
Marriottsville, MD, 21104 WELL TAG #: HO-73-3438
 SUBDIVISION: — LOT: — COUNTY #: 03282-538
 PROPOSAL: Complaint called in by estranged son Andrew Mihn Junior
- alleged there was sewage over-flow in the back yard.

LOCATION DIAGRAM

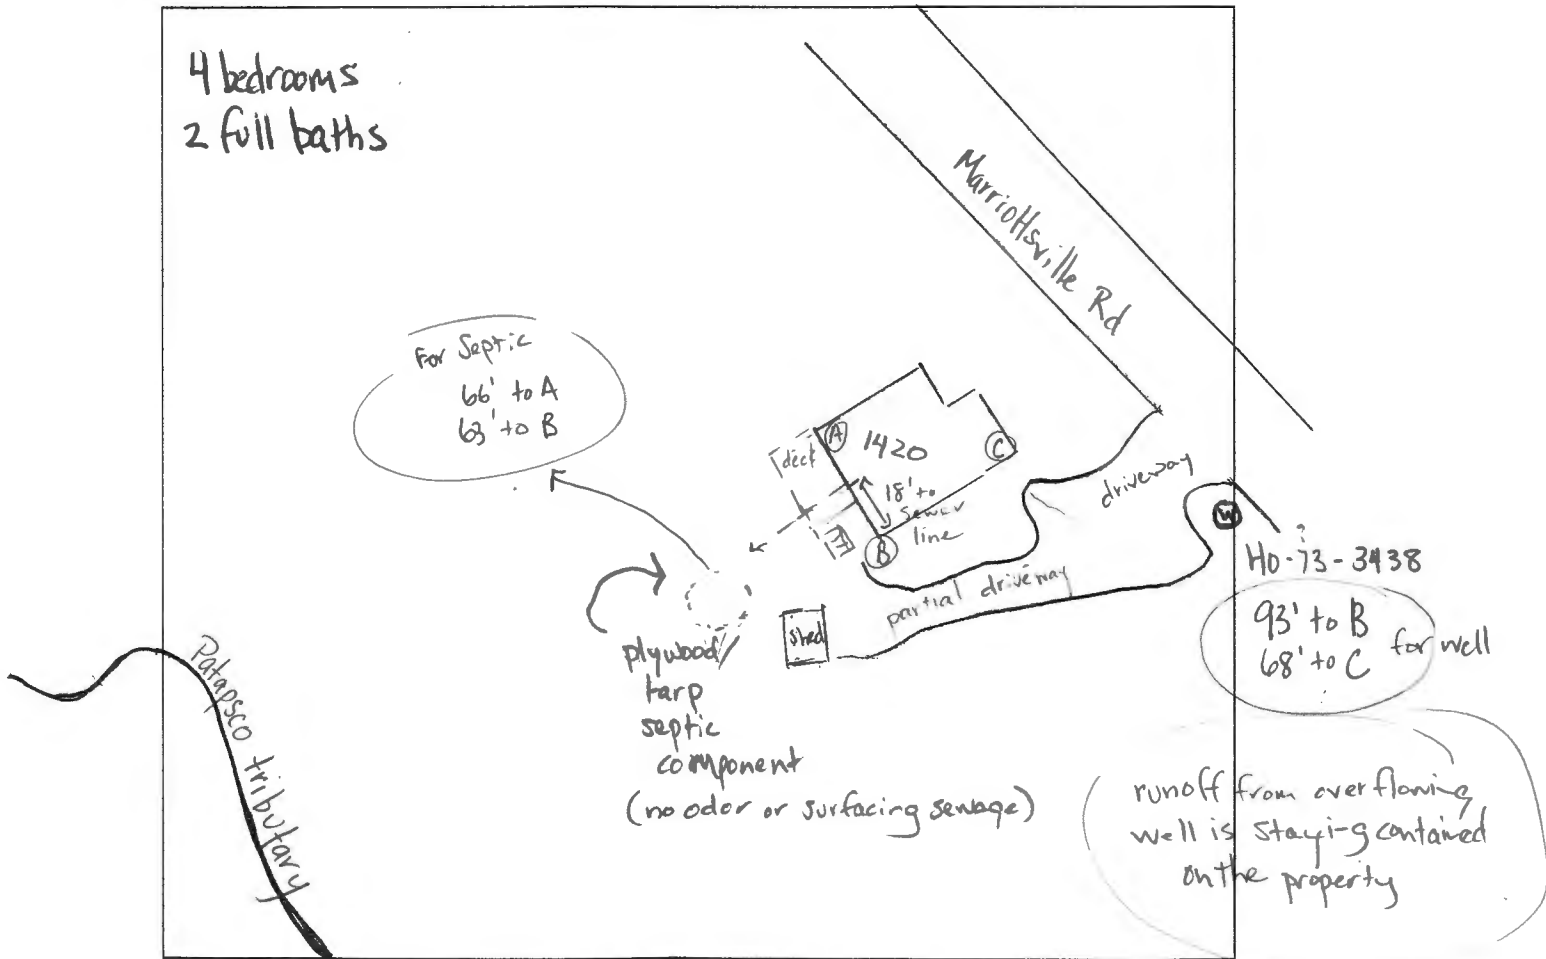

COMMENTS: Site inspection on 7/2/25 - left card in the door requesting a plc to discuss the allegations. Since it was possible sewage overflow near MD State waters, I did an investigation in the yard. Septic area/component had plywood & tarp over it but there was no overflow observed and no odor. The well was in disrepair overflowing, rusted & covered in bugs.

DATE: 7/2/25 INSPECTOR: R. Rappaport

SITE PICS & HO Emails in Accela Record
EH-25-00497

FILE INQUIRY NOTES

page 1

DATE	RESULTS OF REVIEW FOR FILE
7/2/25	<p>- 1st field visit - well overflowing over well cap and completely rusted out from being covered w/ a plastic fake rock; it was also covered in Ants & slugs. The steady overflow had created a trench w/ running water down to the back of the property. Water was staying contained on the property. There appeared to be a broken lid on top of a drywell (maybe) - covered w/ wood & blue tarp. There was no sewage overflow and no odor. No c/o for a septic tank was observed. No archive file could be found for the property except a very faded well permit (no completion report). I left my business card @ the front door with a note to reach out. (P)</p>
7/3/25	<p>- Spoke to homeowner's daughter Carrie Becker @ 413-942-5458 carriebec35@gmail.com. She explained the whole situation. It's her parent's house - father recently passed (Andrew Mihm Senior), her mother has moved in w/ her in Connecticut and her niece is staying @ 1420 Marriottsville Rd until the house can get cleaned out and sold. She has a realtor who will be selling it as is. I explained the issue w/ the overflowing well and she said she'd have a well driller (Harley Well Drilling) address the problem with the well. She said the ROTO ROOTER^(RE) recently did a sewer repair @ the house (backing up in the basement laundry sink). I researched the repair and found that they only pulled a plumbing repair from DLP and did not consult with the HD to repair the septic system. Unpermitted septic repair work was completed by the contractor. (P)</p>
7/3/25	<p>- called Roto Rooter Contact - Douglas Pope @ 667-274-9823 - left VM (P)</p>

FILE INQUIRY NOTES

page 2

DATE	RESULTS OF REVIEW FOR FILE
7/7/25	- emailed DILP plumbing and they said they don't research if a property is on well or septic before issuing a plumbing permit so they didn't know to send Roto Rooter to the HO. (RR)
7/7thru 7/8 2025	- emails with Carrie Becker. she sent the Roto Rooter invoices and other info about the house & the sewer repair - emails will be in ACCELA Record # EH-25-00497 as well as the RR receipts/invoices. The site inspection photos will also be available to see in that accelera record (site inspections 7/2, 7/9, 7/11, 7/18)
7/9/25	- site inspection to see the rest of the property (w/ HO permission) saw the backfill of the work (RR) under the back deck but they did not investigate the line to the tank/dry well - grass not disturbed. (RR) ^{also} - Set appt to meet Carrie Becker @ the property. (over the phone) (RR)
7/11/25	- met w/ HO's daughter Carrie Becker @ the property and showed her the issue with the well and she showed me the inside of the basement and the sewer pipe repair. She agreed to fix the well but since there was no sewage overflow to the surface, none anywhere in the yard. She said she's selling the house as is so she wouldn't be moving forward w/ any more septic investigation and/or repair. (RR)
7/11/25	email saying she'd let me know when the well was repaired. (RR)
7/11/25	- spoke to the complainant Andrew Mihm Junior @ 410-984-5409 - he's the son/brother who's angry about not having any interest in the sale of the property and lives here in MD. (1 mile down Marriottsville Rd) He explained what he saw w/ the bubbling liquid at the septic area - he was concerned about an active sewage leak but I told him there wasn't one as of today. (RR)

Real Property Data Search ()
 Search Result for HOWARD COUNTY

View Map No Ground Rent Redemption on File No Ground Rent Registration on File

Special Tax Recapture: None

Account Number: District - 03 Account Identifier - 282538

Owner Information

Owner Name: MIHM ANDREW C Use: RESIDENTIAL
 MIHM JOY E Principal Residence: YES
 Mailing Address: 1420 MARRIOTTSVILLE RD Deed Reference: /01891/ 00081
 MARRIOTTSVILLE MD 21104-1333

Location & Structure Information

Premises Address: 1420 MARRIOTTSVILLE RD Legal Description: 1.01 A
 MARRIOTTSVILLE 21104-0000 1420 MARRIOTTSVILLE RD
 MARRIOTTSVILLE

Map: Grid: Parcel: Neighborhood: Subdivision: Section: Block: Lot: Assessment Year: Plat No:
 0010 0016 0132 3010103.14 0002 2025 Plat Ref:

Town: None

Primary Structure Built Above Grade Living Area Finished Basement Area Property Land Area County Use
 1945 2,112 SF 1.0100 AC

Stories Basement Type Exterior Quality Full/Half Bath Garage Last Notice of Major Improvements
 2 YES STANDARD UNIT SIDING/ 3 1 full

Value Information

	Base Value	Value		
		As of 01/01/2025	Phase-in Assessments As of 07/01/2024	As of 07/01/2025
Land:	221,300	271,300		
Improvements	141,200	165,500		
Total:	362,500	436,800	362,500	387,267
Preferential Land:	0	0		

Transfer Information

Seller: BASSLER HUNT PARTNERSHIP Date: 09/28/1988 Price: \$113,000
 Type: ARMS LENGTH IMPROVED Deed1: /01891/ 00081 Deed2:
 Seller: AUVIL RICHARD Date: 09/28/1988 Price: \$113,000
 Type: ARMS LENGTH IMPROVED Deed1: /00000/ 00000 Deed2:
 Seller: Date: Price:
 Type: Deed1: Deed2:

Exemption Information

Partial Exempt Assessments: Class 07/01/2024 07/01/2025
 County: 000 0.00
 State: 000 0.00
 Municipal: 000 0.00|0.00 0.00|0.00

Special Tax Recapture: None

Homestead Application Information

Homestead Application Status: No Application

Homeowners' Tax Credit Application Information

Homeowners' Tax Credit Application Status: No Application Date:



1420
Marriottsville Rd
Complaint
Case
July 2025
alleged sewer
overflow

Well Ho-73-3438

→ #'s rusted
out and
permit
hard to
read.

1420

Septic []



EXCAVATION PROPOSAL

Roto-Rooter Services Company
 For Service Please Call 1-800-GET-ROTO (438-7686)
 6500 KANE WAY SUITE B
 ELKRIDGE MD 21075

Date 06/06/2025

Ticket No. 24492172

Proposal Submitted To	Work To Be Performed At
Name CARRIE BECKER	Name CARRIE BECKER
Street 1420 MARRIOTTSVILLE RD	Street 1420 MARRIOTTSVILLE RD
City MARRIOTTSVILLE	City MARRIOTTSVILLE
State MD ZIP 21104	State MD ZIP 21104
Telephone Number 4439425458	Telephone Number 4439425458
Email Address carriebec35@gmail.com	Email Address carriebec35@gmail.com
<p>Roto-Rooter hereby proposes to furnish all the materials and to perform all the labor necessary for the completion of: (Include make and model of materials and necessary labor, and state anticipated contingencies that would materially alter the estimated completion date.)</p> <p>Roto Rooter will jackhammer hand dig and repair septic line from stack 8n basement outside to PVC. Roto Rooter will use all SCH PVC. Roto Rooter will backfill and concrete floor in basement. Roto Rooter not responsible for remaining pipe inside basement. Any questions Call Doug 667-274-9823. 11786.00-10%</p>	

1. Roto-Rooter will perform the work described above and supply all required materials for the sum of \$ 10,608.00. Customer will make payment as follows:
 - 50% % of the cost (\$ 5,304.00) upon execution of this Agreement.
 - 50% % of the cost (\$ 5,304.00) upon the start of the work.
 - Balance of the cost upon completion of the job.
 - Financing available to residential customers. Visit rotorooter.com/financing for more details and to apply.
2. If we cannot video or inspect the complete sewer line, we will give you a price to repair the section that we believe is causing the restriction. After we have uncovered that area, we will attempt to inspect the rest of the sewer line. If additional work needs to be done, or a complete sewer line replacement is required, we will propose a price to properly complete the work. The price for the additional work may be significantly higher than the original proposal. If you decide not to proceed with additional work we propose, you will permit us to complete our work and back fill any excavation.
3. If material deviation from the work described above is required or customer requests additional or different work be performed, the parties will agree on an additional charge and sign a new written work description before Roto-Rooter begins the new work.
4. The approximate starting date is 6/9/2025, and the approximate substantial completion date is 6/9/2025. Neither date is guaranteed. Unexpected conditions or problems could cause delays. A definite completion date is not of the essence.
5. Roto-Rooter guarantees that all materials will be as specified above and that all work will be completed according to standard practice and in a good, workmanlike manner.
6. Customer will provide all necessary easements and rights of way. Unless specifically stated otherwise above, (a) Roto-Rooter is not responsible for the removal of trees, sprinkler systems, underground and above ground fencing, rocks, sidewalks or driveways; unforeseen underground conditions like high water table or poor soil conditions; damage to unmarked public or private utilities; or the repair of streets, sidewalks, damaged sprinkler systems, unmarked public or private utilities, and the like, (b) Roto-Rooter will back fill and grade the excavated area to ground level and mound it to allow for settlement, and (c) Customer is responsible for all landscaping repairs or replacements required following completion of the job. Roto-Rooter is not responsible for damage resulting from poor weather.
7. THE TERMS AND CONDITIONS ON THE REVERSE SIDE OF THIS PROPOSAL WILL BE BINDING ON THE PARTIES.
8. This proposal may be withdrawn by Roto-Rooter if not accepted within 5 days. This proposal constitutes the entire agreement between the parties, and no modifications will be valid unless in writing and signed by both parties.

Customer Initials

Jay m

Customer Initials

Jay m

Respectfully submitted:

Douglas Pope
 Representative Signature

Douglas Pope
 Printed Name

06/06/2025
 Date

ACCEPTANCE OF PROPOSAL

I authorize the services indicated and agree to pay the amounts specified. I have read and agree to the terms, including the limits of Roto-Rooter's responsibility specified in those terms. I acknowledge that under paragraph 2(b) of those terms, if Roto-Rooter equipment gets stuck in a pipe, I may be responsible for the cost of removing that equipment, including any required excavation.

Carrie Becker
 Customer Signature

CARRIE BECKER
 Printed Name

06/06/2025
 Date



VIDEO INSPECTION OF SEWER LINE AND RECOMMENDED SERVICE OR REPAIR

Date 06/06/2025

Ticket No. 24492172

Roto-Rooter Services Company
For Service Please Call 1-800-GET-ROTO (438-7686)
6500 KANE WAY SUITE B
ELKRIDGE MD 21075

Customer CARRIE BECKER

Address 1420 MARRIOTTSVILLE RD
MARRIOTTSVILLE, MD 21104

Roto-Rooter has attempted to inspect your sewer line with a video camera, and you acknowledge the following (please initial the box that applies):

- Roto-Rooter was able to inspect the pipe by camera, and showed you a video feed evidencing the problem(s) noted below.
- Roto-Rooter attempted to camera inspect the pipe, but encountered an obstruction, sewage, water, or blockage in the pipe that made a complete inspection impossible.
- Roto-Rooter did not perform a video inspection. Explanation:

REVIEW

- Complete Collapse - The pipe has collapsed and cannot be cleaned or opened through mechanical methods.
- Broken, Cracked or Corroded - The pipe has deteriorated and/or broken, causing partial collapse(s) in the line and restricting flow.
- Bellied Pipe - A section of pipe has sunk due to ground or soil conditions, creating a valley or dip in the pipe that restricts flow and collects paper and waste.
- Leaking Joints - The seals between pipes have broken, disconnected or corroded, allowing waste water to escape into the areas surrounding the pipe.
- Blockages - Grease buildup or a foreign object is restricting or prohibiting proper flow and/or performance of the line.
- Punctured Pipe - A foreign object has perforated the sewer line.
- Root Infiltration - Tree or shrub roots have invaded the sewer line.

Comments: Looks like roots and heavy grease

SOLUTION

- Cable, Descale or Jet Sewer Line - Roto-Rooter will clean the line either with a mechanical blade and cable or a high-pressure water jet. **PLEASE NOTE:** This is a temporary solution and will not address the underlying problem with the pipe. There is high likelihood that the line will back up again in the future. When that will happen cannot be determined at this time.
- Spot Repair - Roto-Rooter will repair or replace a section of the sewer line. We will jet clean (when appropriate) and video the remainder of the line. If we discover problems in other parts of the line during this work, we will notify you, and at your request, provide a proposal and cost estimate for any additional required work.
- Full Line Replacement - Roto-Rooter will replace the sewer line between two (2) agreed-upon points using one of the following methods:

Comments:

METHOD

- Open Trench - The existing line will be excavated, removed and replaced with new pipe and clean-out. The trench will be backfilled above grade to allow for settling.
- Pipe Lining (if permitted by local authority) - A new pipe sleeve will be installed inside the problem line. Minimal excavation may be required for this method.
- Pipe Bursting (if permitted by local authority) - A new pipe will be pulled through the existing pipe. Some excavation may be necessary for this method.

Comments:

DocuSigned by:

Representative Signature

Douglas Pope
Printed Name

06/06/2025
Date

I have discussed all solution options with Roto-Rooter. I have initialed the solution above for addressing this problem.

Signed by:

Customer Signature

CARRIE BECKER
Printed Name

06/06/2025
Date

SAVE THIS INVOICE FOR YOUR GUARANTEE



EXCAVATION INVOICE

Roto-Rooter Services Company

Remit to: 5672 Collections Center Drive, Chicago IL 60693-0056
For Service Please Call 1-800-GET-ROTO (438-7686)

6500 KANE WAY SUITE B
ELKRIDGE MD 21075

DATE OF SERVICE 06/09/2025	LOCATION Baltimore
Adebayo Adeomi # 5606	
REPRESENTATIVE NAME	
INVOICE NO. 24492172	

CUSTOMER CLASS
 RESIDENTIAL COMMERCIAL

CUSTOMER NAME CARRIE BECKER		CUSTOMER NO. 177654233	EMAIL ADDRESS carribec35@gmail.com
BILLING ADDRESS 1420 MARRIOTTSVILLE RD		APT. NUMBER	FEDERAL I.D. # 42-0499300
CITY MARRIOTTSVILLE	STATE/PROVINCE MD	ZIP/POSTAL 21104	CUSTOMER PHONE NO. 4439425458
SERVICE ADDRESS (IF DIFFERENT THAN BILLING ADDRESS) 1420 MARRIOTTSVILLE RD		CITY MARRIOTTSVILLE	STATE/PROVINCE MD
		ZIP/POSTAL 21104	

Roto roter replace sewage line from inside to outside 6 feet length and replace with the pvc pipe

GUARANTEE	PAYMENT	
1 Year	<input type="checkbox"/> CASH <input type="checkbox"/> CHECK NO. _____ <input checked="" type="checkbox"/> CREDIT CARD <input type="checkbox"/> NET 10 DAYS OVER 30 DAYS = LATE CHARGE OF 1 1/2% PER MONTH * In the event check is returned, the CUSTOMER is responsible for all related bank fees.	LABOR \$ 0.00 LABOR TAX \$ 0.00 PARTS \$ 0.00 DISCOUNT \$ 0.00 PRODUCTS \$ 0.00 OTHER \$ 0.00 TAX \$ 0.00 TOTAL \$ 10,608.00
REASON FOR NO GUARANTEE		

COMPLETION I acknowledge completion of the above described work.

Signed by: Joy Mishra
 (SIGNATURE) _____
83A75808199E459
 (PRINT NAME) CARRIE BECKER

SEE BINDING TERMS

Rely on the experts at Roto-Rooter for professional pipe restoration, cleaning services and excavation. Call **1-800-GET-ROTO**. Visit us at **rotorooter.com** for coupons, helpful hints and more. Complete our customer survey at: **rotorooter.com/feedback**.

And, follow us online for news, timely updates, and other plumbing, drain and water cleanup information.

- twitter.com/rotorooter
- facebook.com/rotorooter
- rotorooter.com/blog
- [YouTube youtube.com/rotorootertv](https://youtube.com/rotorootertv)

Signed by: _____
 Representative Signature

Adebayo Adeomi

Printed Name

WASHINGTON DC: PC1000420, MD STATE 19631, ANNE ARUNDEL COUNTY A2 000384, DC: PGM1002148, WSSC PFG-82685, Harford County: 000247-2021, Baltimore County: MPG-0009799



**ROTO-ROOTER SERVICES COMPANY
EXCAVATION RELEASE AND HOLD HARMLESS AGREEMENT**

I acknowledge the Roto Rooter employee named below has advised me Roto-Rooter is **NOT RESPONSIBLE** for personal injury, property damage or other damage or loss to me or others arising out of the work, except to the extent a claim is caused solely by Roto-Rooter's gross negligence or failure to perform the work in accordance with the contract between us.

Unless explicitly stated in writing, any damage necessary to complete our work, including damage to landscaping, walls, painting, tile or concrete, or similar items or tasks we perform in accordance with your specific instructions will not be the responsibility of Roto-Rooter to repair or replace.


I hereby release and discharge Roto-Rooter Services Company, its parent company, affiliates, officers, employees, agents, and contractors (collectively referred to as "Roto-Rooter"), from any claim for personal injury, property damage or other damage, including consequential damages, in connection with those services. I further agree to hold harmless and indemnify Roto-Rooter against any such claim made by a third party.

I represent that I am the owner or duly authorized agent of the owner(s) of the premises and accept full responsibility for this agreement.

Roto-Rooter invoice: 24492172

Property address: 1420 MARRIOTTSVILLE RD MARRIOTTSVILLE, MD 21104

Owner's Name: CARRIE BECKER

Owner's Signature: Signed by:

83A75B0810RE459

Date: 06/06/2025

Roto-Rooter employee: Douglas Pope




**ROTO-ROOTER
LANDSCAPE & UNDERGROUND UTILITIES & OBSTRUCTIONS
WAIVER**

Dear Valued Customer,

Thank you for the opportunity to service your excavation needs. We appreciate you choosing Roto-Rooter to complete the excavation repair/replacement. The project you are undertaking has a significant impact on your landscape. During the excavation process, finished landscape outside the area of the excavation may be disturbed due to equipment mobilization and/or use, and would not be the responsibility of Roto-Rooter to repair unless stated in the contract. The excavated area will be backfilled to rough grade and slightly mounded to allow for natural settlement. Occasionally after an excavation, settlement of asphalt, concrete, and soil can occur, even weeks after an excavation. Settlement happens from rain washout drainage pipes and other environmental factors. You may need additional soil placed in these areas from the settlement. Roto-Rooter or its excavators are not responsible for returning to any excavation site to add any soil unless it is otherwise stated and paid for as part of the original job. It is the sole responsibility of the customer to have any soils brought to their site at the customer's expense.

Also, your property may contain unmarked and unforeseen obstacles such as utility lines, sprinkler lines, lighting lines, dry wells, water table issues or any other obstacles that are not listed above. In addition, most water companies only mark out their lines at the curb. The company does its best to avoid hitting the unmarked lines or other obstacles, which can be in very close proximity to your sewer/water line. Should the company hit such a line or other obstacle, if repair or replacement is needed, you will incur the cost of time, labor, equipment, and material to do so. On occasion, some municipalities require certain types of fill dirt to be brought to your site to backfill trenching such as gravel or crushed stone. Any cost incurred related to such requirements shall be borne by the customer. Should any contaminated soils need to be removed from the site, the company will let you know the cost of any of these items at the end of the job as needed.

HAVING READ THIS IMPORTANT INFORMATION, YOU UNDERSTAND THE ABOVE, ACKNOWLEDGE THAT IT WAS EXPLAINED TO YOU AND THAT ALL OF YOUR QUESTIONS WERE ANSWERED, AND YOU AGREE TO NOT HOLD ROTO-ROOTER OR ITS EMPLOYEES OR SUBCONTRACTORS RESPONSIBLE FOR ANY NATURAL SETTLEMENT AFTER THE EXCAVATION PROCESS IS COMPLETED OR ANY OTHER DAMAGE OR CONDITION AS SPECIFIED ABOVE.

Customer's Signature & Date:  06/06/2025
Signed by: 83A75808199E459

Service Technician's Signature & Date:  06/06/2025
DocuSigned by: F08FA3281A50411

Notes:

The following terms apply to all work performed by Roto-Rooter Services Company or its affiliates ("us") for the customer indicated on the front of this form ("you").

1. Your Responsibilities. You agree to (a) remove any hazards, obstructions or dangerous conditions around the job site not caused by our work, (b) limit access to the job site so that people not working on our job are not exposed to dangerous conditions relating to our job, (c) place appropriate warnings to warn of dangerous conditions when we are not on the job site, and (d) provide us with adequate access.

2. Exceptions to Our Responsibilities. WE ARE NOT RESPONSIBLE FOR (a) personal injury, property damage or other damage or loss to you or others arising out of our work, except to the extent caused by our negligence or failure to perform the work in accordance with the contract between us; (b) DEFECTIVE, DAMAGED, OR DETERIORATED LINES, MOLD, LEAD PIPING, OR OTHER UNEXPECTED OR UNDISCLOSED CONDITIONS, AND THE CONSEQUENCES OF SUCH CONDITIONS, INCLUDING DELAYS, BROKEN FIXTURES OR LINES, AND LODGED EQUIPMENT (if we encounter such a condition, we may stop work, and you will pay us a reasonable charge for the work performed); (c) the time required to complete our work with reasonable diligence; (d) unless explicitly stated in writing, any damage necessary to complete our work, including damage to landscaping, walls, painting, tile or concrete or similar items; (e) damage caused by the removal of any clean out, drain cover or cap; or (f) tasks we perform in accordance with your specific instructions.

3. Release and Hold Harmless. You release us from (and if you are a commercial customer, you will defend and indemnify us and hold us harmless against) all damages, claims, demands, settlements, judgments, liabilities, costs and expenses, including reasonable attorneys' fees, allegedly arising out of (a) breach of your responsibilities under paragraph 1, or (b) matters for which we disclaim responsibility under paragraph 2.

4. Our Guarantee. If we provide a parts or equipment guarantee, as your exclusive remedy, we will give you the benefit we receive, if any, under the manufacturer's warranty. If we provide a service guarantee, it covers only drainage failure in the line serviced, and defective plumbing workmanship, during the guarantee term. As your exclusive remedy under our service guarantee, we will, at our option, either do the work again at no labor cost or refund your payment. Guarantees do not apply to problems arising out of main sewer line backup or improper, abnormal or unanticipated use or conditions. Except as explicitly stated in writing, we are not giving any guarantees or making any warranties. TO THE EXTENT PERMITTED BY LAW, WE DISCLAIM ANY IMPLIED WARRANTIES OF MERCHANTABILITY OR FITNESS FOR A PARTICULAR PURPOSE. You may transfer a guarantee of plumbing repair or replacement to a person who purchases the property, but you may not transfer a drain cleaning or toilet auger guarantee. Your transferee must present the warranty claim to Roto-Rooter at the time we perform our work. We do not guarantee that our site inspection will identify all existing or potential problems. Any damages or necessary repairs arising from plumbing problems, either identified or unidentified, are the sole responsibility of the customer.

5. Limitation of Damages. Our liability to you for any claim arising out of our work on any job (other than a claim permitted by these terms for personal or bodily injury) will in no event exceed three times the amount you actually pay us for the work on that job. EXCEPT FOR A CLAIM PERMITTED BY THESE TERMS FOR PERSONAL OR BODILY INJURY OR PROPERTY DAMAGE, YOU WAIVE ANY RIGHT TO RECOVER INCIDENTAL DAMAGES, CONSEQUENTIAL DAMAGES, OR DELAY DAMAGES.

6. Payment Terms. When you provide a check as payment, you authorize us either to use information from your check to make a one-time electronic fund transfer from your account or to process the payment as a check transaction. In the event check is returned, you are responsible for all related bank fees. If you fail to pay us any amount when due, we will charge you interest on the amount due at the rate of 1.5% per month (but not exceeding the highest rate legally permissible). You will reimburse us for the reasonable attorneys' fees we incur in all stages of collection.

7. General. These terms are part of our contractual agreement and will prevail over any inconsistent terms in any other agreement between us, including the terms of any purchase order, and may be modified only in a written instrument signed by both of us which specifically refers to the provisions to be modified. If any of these terms is held invalid or unenforceable, the remaining provisions will not be affected and will continue to apply.

8. Nondiscrimination. We will abide by the requirements of 41 CFR SS 60-1.4(a) and 60-741.5(a). These regulations prohibit discrimination against qualified individuals with disabilities, and prohibit discrimination against all individuals based on their race, color, religion, sex or national origin. Moreover, these regulations require that we take affirmative action to employ and advance in employment individuals without regard to race, color, religion, sex, national origin or disability.

HOW TO RESOLVE A PROBLEM

- Contact the manager at your Roto-Rooter office. Everything will be done to resolve your problem at the local level.
- If your problem cannot be resolved locally, please contact Pat Swanson, Customer Service Coordinator, in our national headquarters:

Roto-Rooter Services Company or email pswanson@rrsc.com
Suite 2500
255 East Fifth Street
Cincinnati, OH 45202

DATE RECEIVED (WRA USE ONLY) **7/10/79**

OWNER **Rudel Richard**

STREET OR RFD **1420 MARRIOTTSVILLE ROAD**

POST OFFICE **MARRIOTTSVILLE, MARYLAND 2104**

DRILLER INFORMATION

DATE **9/8/79** LICENSE NUMBER **221**

Jack C. Harley & Son

SIGNATURE **Jack C. Harley**

WELL INFORMATION

MAXIMUM PUMPING RATE (GALLONS PER MINUTE) **3**

AVERAGE DAILY QUANTITY NEEDED (GALLONS PER DAY) **750**

USE FOR WATER (CIRCLE APPROPRIATE BOX)

HOME (SINGLE OR DOUBLE HOUSEHOLD UNIT ONLY)

FARMING, AGRICULTURE, IRRIGATION

INDUSTRIAL, COMMERCIAL, STATE AND FEDERAL GOVERNMENT.

MUNICIPAL WATER SUPPLY

PRIVATE WATER COMPANY } MUST HAVE STATE HEALTH DEPT. APPROVAL

TEST

APPROXIMATE DEPTH OF WELL **300** FEET

APPROXIMATE DIAMETER OF WELL **6** (NEAREST INCH)

METHOD OF DRILLING USED (CIRCLE APPROPRIATE METHOD)

AIR-ROTARY

CABLE

OTHER (DESCRIBE)

REPLACEMENT OR DEEPEMED WELLS (CIRCLE APPROPRIATE BOX)

THIS WELL WILL REPLACE A WELL THAT WILL BE ABANDONED AND SEALED

THIS WELL WILL REPLACE A WELL THAT WILL BE USED AS A STANDBY

THIS WELL WILL DEEPM AN EXISTING WELL PERMIT NUMBER OF WELL TO BE REPLACED OR DEEPEMED (IF AVAILABLE)

NOT TO BE FILLED IN BY DRILLER (WRA USE ONLY)

APPROPRIATION PERMIT NUMBER

ENGINEER REVIEW DISTRICT NO.

FORCE

CONDITIONS

HEALTH DEPARTMENT APPROVAL

HOWARD COUNTY

DATE **09/10/79**

APPROVED BY **Fred Frommelt, Sanitarian**

SPECIAL CONDITIONS 8-63 (WRA USE ONLY)

LOCATION OF WELL

COUNTY **Howard**

SUBDIVISION

SECTION **MARRIOTTSVILLE**

NEAREST TOWN **MARRIOTTSVILLE**

MILES FROM TOWN (ENTER 0 IF IN TOWN)


DIRECTION FROM TOWN (CIRCLE APPROPRIATE BOX)

SOUTH

NEAR WHAT ROAD **MARRIOTTSVILLE ROAD**

ON WHICH SIDE OF ROAD (CIRCLE APPROPRIATE BOX) **WEST**

DISTANCE FROM ROAD (ENTER DISTANCE AND CIRCLE APPROPRIATE BOX) **75**

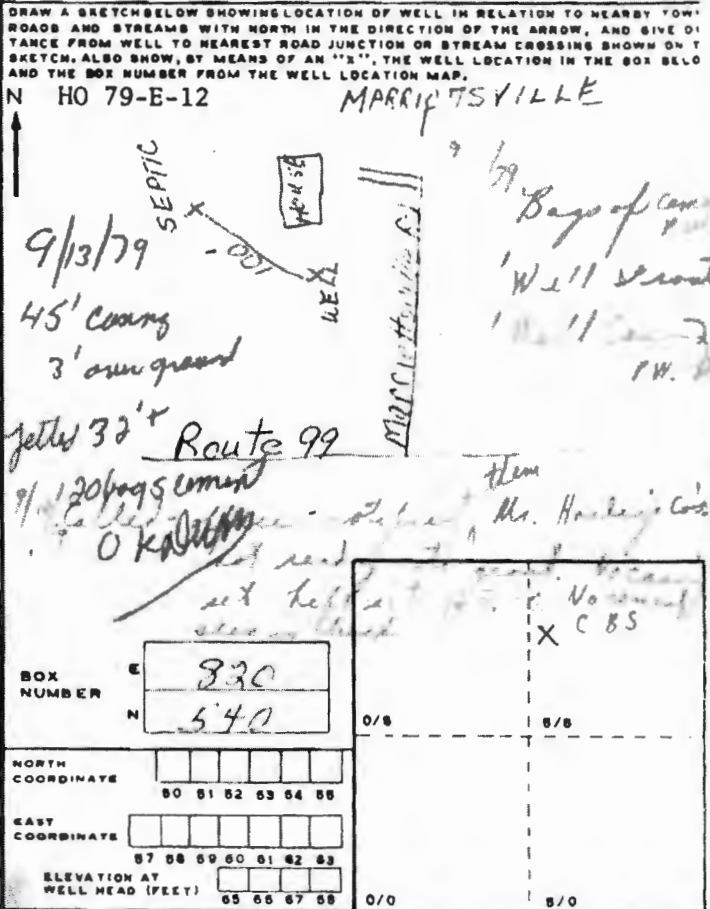

BOX NUMBER

330

540

NORTH COORDINATE

EAST COORDINATE

ELEVATION AT WELL HEAD (FEET)

B 1 2024 SEQUENCE NO. (WRA USE ONLY)

STATE OF MARYLAND
WATER RESOURCES ADMINISTRATION
TAWES STATE OFFICE BLDG., ANNAPOLIS, MARYLAND 21401
APPLICATION FOR PERMIT TO DRILL WELL

WRA PERMIT NUMBER
 10-75-3408

FILL IN THIS FORM COMPLETELY

DATE RECEIVED (WRA USE ONLY)

OWNER Andel Richard
COL 15 LAST NAME FIRST NAME COL 34

STREET OR RFD 1430 MURKINVILLE ROAD
COL 36 COL 58

POST OFFICE MURKINVILLE MARYLAND 21081
COL 57 COL 76

B 1 CONTINUED **DRILLER INFORMATION**

DATE 9/8/79 **LICENSE NUMBER** 371
77 80

FIRST NAME Jack C. Harley & Son **DRILLER** **LAST NAME**

SIGNATURE

B 3 **LOCATION OF WELL**

COUNTY HOWARD
(DO NOT ABBREVIATE COUNTY NAME) 21

SUBDIVISION 28 **42**

SECTION 44 45 **LOT** 48 **50**

NEAREST TOWN MURKINVILLE **71**

MILES FROM TOWN (ENTER 0 IF IN TOWN) 7.5 **76 77 78**

B 2 **WELL INFORMATION**

MAXIMUM PUMPING RATE (GALLONS PER MINUTE) 9 **12**

AVERAGE DAILY QUANTITY NEEDED (GALLONS PER DAY) 270 **20**

USE FOR WATER (CIRCLE APPROPRIATE BOX)

HOME (SINGLE OR DOUBLE HOUSEHOLD UNIT ONLY)

FARMING, AGRICULTURE, IRRIGATION

INDUSTRIAL, COMMERCIAL, STATE AND FEDERAL GOVERNMENT.

MUNICIPAL WATER SUPPLY } **MUST HAVE STATE HEALTH DEPT. APPROVAL**

PRIVATE WATER COMPANY

TEST

B 4 **DIRECTION FROM TOWN (CIRCLE APPROPRIATE BOX)**

NORTH EAST NE NORTHEAST SE SOUTHEAST

SOUTH WEST NW NORTHWEST SW SOUTHWEST

NEAR WHAT ROAD MURKINVILLE ROAD

ON WHICH SIDE OF ROAD (CIRCLE APPROPRIATE BOX) NORTH SOUTH EAST WEST

DISTANCE FROM ROAD (ENTER DISTANCE AND CIRCLE APPROPRIATE BOX) 47 **34 37 38 39**

APPROXIMATE DEPTH OF WELL 300 **24 26 FEET**

APPROXIMATE DIAMETER OF WELL 6 **(NEAREST INCH)**


METHOD OF DRILLING USED (CIRCLE APPROPRIATE METHOD)

BORED (OR AUGERED) **JETTED** **DRIVEN**

AIR-ROTARY AIR-PERCUSSION ROTARY (HYDRAULIC ROTARY)

CABLE REVERSE-ROTARY DRIVE-POINT

OTHER (DESCRIBE)

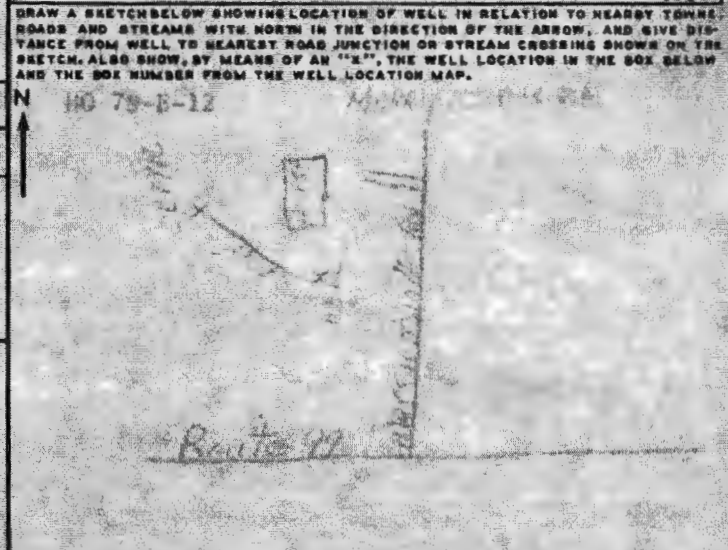

REPLACEMENT OR DEEPEINED WELLS (CIRCLE APPROPRIATE BOX)

THIS WELL WILL NOT REPLACE AN EXISTING WELL

THIS WELL WILL REPLACE A WELL THAT WILL BE ABANDONED AND SEALED

THIS WELL WILL REPLACE A WELL THAT WILL BE USED AS A STANDBY

THIS WELL WILL DEEPEN AN EXISTING WELL PERMIT NUMBER OF WELL TO BE REPLACED OR DEEPEINED (IF AVAILABLE)

NOT TO BE FILLED IN BY DRILLER (WRA USE ONLY)

APPROPRIATION PERMIT NUMBER 54 **56**

ENGINEER REVIEW DISTRICT NO. 43 **45**

FORCE 67 **68**

WRITE INITIALS IN BOX **CONDITIONS** 70 71 72 73 74 75 76 77 78 79

BOX NUMBER 547

NORTH COORDINATE 50 51 52 53 54 55

EAST COORDINATE 57 58 59 60 61 62 63

ELEVATION AT WELL HEAD (FEET) 0/0 **45 46 47 48**

B 4 CONTINUED **HEALTH DEPARTMENT APPROVAL**

STATE HEALTH (CIRCLE BOX) HOWARD **150167**

COUNTY NAME **COUNTY NO.**

DATE 9/8/79 **APPROVED BY** Paul Primm

B 5 **SPECIAL CONDITIONS 5-53 (WRA USE ONLY)**

1 2 3 (SEQ. NO.) 6