MARYLAND DEPARTMENT OF THE ENVIRONMENT, WATER MANAGEMENT ADMINISTRATION
1800 Washington Blvd., Baltimore, Maryland 21230 (410) 537-3784

****

WATER WELL ABANDONMENT-SEALING REPORT FORM

****

OK 6/17/24

SUBMIT COPIES OF COMPLETED FORM TO:

* COUNTY ENVIRONMENTAL AGENCY (contact MDE, WMA if address needed)
* WELL OWNER
* MDE, WATER MANAGEMENT ADMINISTRATION, WELL PROGRAM

DATE WELL ABANDONED: 11-1-2023 (month/day/year)

* PERMIT NUMBER OF ABANDONED WELL (if any) None — —
* PERMIT NUMBER OF REPLACEMENT WELL: — —
* PERSON ABANDONING WELL: Tony Mayer WELL DRILLER'S LICENSE NUMBER: 027
  CIRCLE: MWD / MSD / MGD
* OWNER'S NAME: Fuentes Alvelar
* WELL LOCATION:
  COUNTY: Howard
  NEAREST TOWN: Elkridge MD. 21075
  TAX MAP ____ BLOCK ____ PARCEL ____
  SUBDIVISION: ____
  SECTION: ____ LOT: ____
  STREET ADDRESS: 6944 Linden Ave

  LATITUDE 39.17864
  LONGITUDE 76.75084

SITE LOCATION MAP

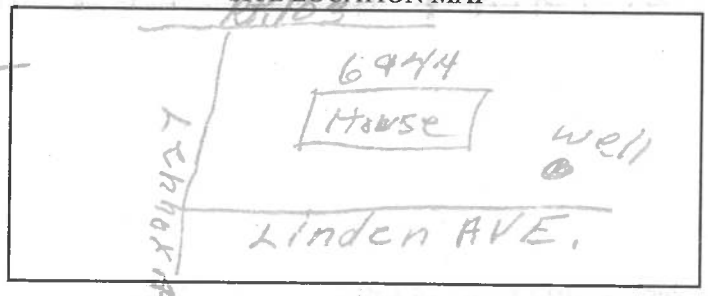

LOG OF SEALING MATERIAL

MATERIAL	FEET	
	FROM	TO
gravel	5	21
cement	3	5
Topsoil	0	2

VOLUME OF MATERIAL USED: gravel 10 yard. cement 2 yard

* TYPE OF WELL BEING ABANDONED:
  ____DRILLED ____JETTED
  ____BORED ✓ HAND DUG
  ____OTHER (specify) ____

* USE CODE:
  ✓ DOMESTIC ____MUNICIPAL/PUBLIC
  ____IRRIGATION ____INDUSTRIAL
  ____TEST/OBSERVATION ____GEOTHERMAL

* TYPE OF CASING:
  ____STEEL ____PLASTIC
  ____CONCRETE ✓ OTHER (specify) Cement rings

SIZE OF CASING: 3 ft INCHES IN DIAMETER

DEPTH OF WELL: 21 FEET DEEP

WAS ANY CASING REMOVED? ____YES ✓ NO
If yes, length removed, in feet: ____

WAS CASING RIPPED OR PERFORATED? ____ YES ✓ NO

Pursuant to § 10-624 of the State Govt. Article of the Maryland Code, personal info requested on this form is used in processing this form pursuant to COMAR 26.04.04. Failure to provide the info may result in this form not being processed. You have the right to inspect, amend, or correct this form. The Maryland Department of the Environment is subject to the Maryland Public Information Act. This form may be made available on the Internet via MDE's website and is subject to inspection or copying, in whole or in part, by the public and other governmental agencies, if not protected by federal or State Law.

Tony Mayer 027 MWD / MSD / MGS 11-1-2023

SIGNATURE-MASTER WELL DRILLER OR SUPERVISING SANITARIAN LICENSE# CIRCLE ONE DATE

COUNTY